

6700 CABRA ST.

LOT 1 BLK 1 CHARLESTON RAINBOW 5-A ZONE R-1

L. Gatewood 25-79

CITY OF LAS VEGAS, NEVADA
DEPARTMENT OF BUILDING & SAFETY

SEWER CONNECTION FEE: \$ 150.00

RECEIPT
for
SEWER CONNECTION FEE

JOB ADDRESS: 6700 Cabra Street OWNER'S NAME: SPROUL HOMES, INC.

LOT 1 BLOCK 1 SUBDIVISION Charleston Rainbow 5-A

QUANTITY	OCCUPANCY	UNIT FEE	AMOUNT
1	SEWER CONNECTION FEE FOR S.F. D.		150.00

TOTAL
Less Credit
TOTAL FEE \$ 150.00

Credit for existing sewer is applied to the new sewer connection fee based on previous type of occupancy and only when the new occupancy requires an additional fee.
This receipt does not authorize the owner or his representative to start any work without obtaining a plumbing permit.

DEPARTMENT OF BUILDING & SAFETY

DATE

73102

RECEIPT NO. 24257 SEWER FEE 150

Receipt

CITY OF LAS VEGAS
DEPT. OF
BUILDING & SAFETY

Must be within validity

Gatewood 2-5-79

LOG NO. & AREA

I-11/4

CITY OF LAS VEGAS, NEVADA

CONST. VAL. \$

13,685⁰⁰

DEPARTMENT OF BUILDING & SAFETY

APPLICATION & BUILDING PERMIT — for:

Dwellings, Duplexes, Misc. Residential Const.

ADDRESS OF CONSTRUCTION:

6700 Cabra Street

OWNER: SPROUL HOMES, INC.

LOT(s)

1

BLOCK

1

SUBDIVISION

Charleston Rainbow 5

ZONE:

R-1

Existing structure on lot: Dwelling ☐ Accessory bldg. ☐ Vacant lot ☒ Other ☐

PROPOSED CONSTRUCTION: Single Family Dwelling

USE: Same

MATERIALS OF CONSTRUCTION: Wood Frame ☒ Concrete Block ☐ Reinforced Concrete ☐ Steel Frame ☐

SQUARE FEET OF FLOOR AREAS: 1st ☒ 2nd ☐ 3rd ☐ Other ☐ TOTAL SQ. FT. 1158

FIRE ZONE: 1 2 3

Occupancy Group A B C D E F G H I J 1-2-3-4-5

CONST. TYPE: I II III IV V

ARCHITECT:

ENGINEER:

NO. of UNITS

NO. of STORIES

Plans Submitted: Yes ☒ No ☐

Calculations Submitted: Yes ☐ No ☐

Sewer Fee Req'd. Yes ☐ No ☐

CONTRACTOR: Sproul Homes, Inc.

STATE LICENSE #

6011 B

CITY LICENSE #

6427

ADD'L. PERMITS REQ'D: Air Cond. ☐ Elec. ☐ Plumbing ☒ Signs ☐ Paving ☐ Fence ☐ Public Walks ☐ Curb-gutters ☐ Incinerators ☐ Fire Sprinkling System ☐

CONDITIONS OF THE PERMIT:

- I agree to call the City Building Department for inspections before concrete is poured, before rough wiring, electrical, plumbing, framing is covered. Also for Air conditioning, sheet-rock and sheathing inspection.
- I agree that when the job is completed that I will call for final inspection before occupancy.
- I agree to perform all construction in accordance with City Ordinances and Building Codes.
- The Contractor's signature below denotes authority from the owner to sign in his behalf and that the owner is aware of all requirements of this application and permit. Separate permits must be taken out for work outlined above this agreement.
- I have read and understand the contents of this application and permit; I hereby state that the information I have supplied on this application is true and correct.

SIGNED: SPROUL HOMES, INC. Contractor

BY: John K. Simpson Agent or Owner

CLARK COUNTY HEALTH DEPT.

LAS VEGAS FIRE DEPARTMENT

SEE PLOT PLAN
(#15 A(R))

Front sidewalk

PLANNING DEPT:

Date: 6-27-68

ENGINEERING DEPT:

Date: 6-27-68

BUILDING DEPT:

Date: 6-27-68

#1235

PERMIT NO: 43374

PERMIT FEE \$

48⁰⁰

RECEIPT

1420 3048.00

CITY OF LAS VEGAS
DEPT. OF
BUILDING & SAFETY

MUST BE MACHINE VALIDATED

28 JUN 68

L. Gatewood 2-5-79

CITY OF LAS VEGAS, NEVADA
DEPARTMENT OF BUILDING & SAFETY

PERMIT FEE \$ 20.00
APPLICATION & PERMIT FOR
PLUMBING

JOB ADDRESS: 6700 CABRA ST OWNER'S NAME: STROU HOMES INC

LOT 1 BLOCK 1 SUBDIVISION CEN#5 Bldg. type: SFD APT. COMM

Circle: New bldg; Old bldg; Add'n; Remodel; Pool; Wtr. Sftner; Lawn Sprkr; Other

CONTRACTOR: LOTTED PLUMBING

State Lic. # 1295 City Lic. # 904

QUANTITY	FIXTURE OR INSTALLATION	Unit Price	AMOUNT
	Bathtub	1.00	1-
	Clothes dryer (gas)	1.00	
	Clothes washer	1.00	1-
	Dental unit	1.00	
	Dishwasher	1.00	1-
	Drinking fountain	1.00	
	Fire sprinkling - underground piping	5.00	
	Fire sprinkling - distribution piping per each foot	.01	
	Fire sprinkling heads - per each head	.10	
	Floor drain \$1.00 Floor sink	1.00	
	Gas appliance (any type)	1.00	
1	Gas piping system - single family dwelling	3.00	3-
	Gas piping system - multiple family \$3 per each unit plus	1.00	
	Gas piping system - commercial bldg. per each floor	3.00	
	Grease trap	1.00	
	Irrigation system	4.00	
1	Lavatory	1.00	2-
	Minimum fee for any permit	4.00	
1	Piping, Drainage	4.00	4-
	Sewer replacement	4.00	
	Septic disposal system - Health Dept. approval required	4.00	
1	Shower	1.00	1-
1	Sink - kitchen type	1.00	1-
	Swimming pool - private - wading pool	8.00	
	Swimming pool - public - semi-public	12.00	
2	Toilet	1.00	2-
	Urinal	1.00	
1	Water distribution system, single family dwelling	4.00	4-
	Water distribution system multiple dwg. \$4 + each unit	1.00	
	Water distribution system, Group "A" thru "G" per each floor	4.00	
	Water distribution system, Group "H" (hotel) \$4 + per bath	.50	
1	Water heater (gas) (electric)	1.00	1-
	Water using equipment	1.00	
	Water softener nonpermanent type	4.00	
	Water softener permanent (connected to drainage)	5.00	
	Wash tray	1.00	

I hereby certify that I have carefully examined & read the above application; that the same is true & correct; and the work herein described is to be done in accordance with the provisions of City of Las Vegas Ordinances & State Laws, whether herein specified or not. As defined in City Code and Ordinances.

TOTAL FEE \$ 20.00

SIGNED: [Signature] Date: 7-1-68
Registered Plumber Spec. Cont'g Owner

Engineering Dept. Date Building Department Date

Sewer Conn. Fees

Paid in Engr. Dept.

23.10

#12870

PERMIT NO. 29312 PERMIT FEE \$ 20.00

RECEIPT

1968 - \$020.00 - 7

CITY OF LAS VEGAS

DEPT. OF
BUILDING & SAFETY

Must be machine validated

- 3 JUL 68

L. Gatewood 2-5-79

CITY OF LAS VEGAS, NEVADA

DEPARTMENT OF BUILDING & SAFETY ELECTRICAL APPLICATION & PERMIT

 Check Proper Construction: New Bldg. ☒ Addn. ☒ Remodel ☐ Temporary Pole ☐ Old Bldg. ☐
 CONTRACTOR'S NAME: Robert J. Galt STATE LICENSE # 5144 CITY LICENSE # 3392

NUMBER	FIXTURE OR INSTALLATION	UNIT PRICE	
14	Fixture or sockets	.15	210
51	Light receptacle or switch outlet	.20	1020
	Wall or ceiling space heater	.35	
	Blast coil heater per kilowatt	.35	
1	Garbage grinder outlet	.35	35
	Dishwasher outlet	.35	
	Clothes dryer outlet	.35	
	Automatic clothes washer	.35	
1	Electric range outlet	.35	35
	Electric water heater outlet	.35	
	Mercury arc lamp and equipment	.35	
	Special purpose outlet	.35	
	X-ray unit and its appurtenances	5.00	
	Watts of festoon lighting (Watts) First 3,000 watts	4.00	
	for each additional thousand watts	1.50	
	Horsepower - all motors first horsepower or less	1.75	
	for each additional horsepower	.35	
	Temporary power and lights (temporary pole)	4.00	
1	Electric service (including any single meter socket)	3.00	300
	for each additional socket	.35	
1	Air conditioning service	1.50	150
	Each KW (KVA) Generator (Transformer) (Welder) KW (KVA)	2.00	
	First 100 KVA - For each additional KW (KVA)	.01	
	Special inspection per hour	4.00	
	Speaker outlets	.15	
	Signal or Alarm outlets	.15	
	Amplifiers	.50	
	Control panels	.25	
	T. V. outlets - master system only	.15	
	Radio outlets	.15	
	Main control racks	1.00	
	T. V. and Radio antennas - master system only	.75	
	Minimum fee for any permit	4.00	
	Total fee		1715

I hereby certify that I have carefully examined and read the above application; that the same is true and correct; and that the work herein described is to be done in accordance with all the provisions of the applicable Ordinances of the City of Las Vegas, Nevada and State laws whether herein specified or not.

SIGNED Robert J. Galt Date 7/9/68
 MASTER (ELECTRICIAN) (TECHNICIAN) (OWNER)
 BUILDING DEPARTMENT J. W. Ward Date 7-12-68
 PERMIT NO. 25746 PERMIT FEE 12.00

RECEIPT

2574 501215
 CITY OF LAS VEGAS
 DEPARTMENT OF BUILDING & SAFETY

L. Gatewood 2-5-79

CITY OF LAS VEGAS, NEVADA
DEPARTMENT OF BUILDING & SAFETY - AIR CONDITIONING APPLICATION & PERMIT

ADDRESS OF CONSTRUCTION: 6700 CABRA ST OWNER'S NAME: SPROUL
 CIRCLE: New bldg. Old bldg. Add'n Remodel TYPE OF BLDG: RES APT. COMM.
 CONTRACTOR'S NAME: GEARING AC STATE LICENSE # 6058 LICENSE #

UNITS	HEATERS	PRICE	FEE	UNITS	GAS	PRICE	FEE
	Unit Heaters (floor, suspended & wall)	\$2.00			Gas piping system 1 to 5 outlets	\$3.00	
	Floor Furnace	\$3.00			Gas piping system over 5 outlets (per outlet)	.20	
	Forced Air or Gravity Type under 100,000 BTU's	\$7.00			Swimming pool heater	\$4.00	
	Steam or hot water heating system under 15 outlets (Boiler Excluded)	\$8.00		VENTS			
	Steam or hot water heating system 15 to 30 outlets (Boiler Excluded)	\$10.00			Combustion products vent other than a chimney	\$1.00	
	Each outlet over 30	.50			Residential kitchen or bathroom vent each	.25	50
	Radiant type heating system under 1000 sq. ft. to be heated	\$8.00			Commercial Hood	\$4.00	
	Radiant type heating system 1000 to 2000 sq. ft. to be heated	\$10.00			Ventilation system not a portion of any heating or air conditioning system up to \$1,000 valuation	\$5.00	
	Each additional 500 sq. ft. over 2000 sq. ft.	.50		BOILER			
AIR CONDITIONING					Boiler installation 15 H.P. and under	\$5.00	
	Heat pump or refrigerant 3 tons or less.	\$4.00			Boiler installation over 15 H.P.	\$10.00	
	Heat pump or refrigerant 3 tons to 10 tons	\$6.00	6.00	REPAIR			
	Each addn. ton over 10 ton	.50			Inspection of alteration or replacement of any mechanical cooling equipment which is a portion of any air conditioning system	\$3.00	
	Refrigeration system 3 ton or less	\$5.00			DUCT WORK ONLY (each opening)	.25	
	Refrigeration system 3 to 10 ton	\$7.00			WATER TOWER	\$4.00	
	Each addn. ton over 10 ton	.50			MINIMUM PERMIT FEE	\$4.00	
	Evaporative cooler 5 outlets and under	\$3.00		TOTAL PERMIT FEE			
	Evaporative cooler 5 to 10 outlets	\$5.00					
	Each addn. outlet over 10	.25					

I hereby certify that I have carefully examined and read the above application; that the same is true and correct; and that the work herein described is to be done in accordance with all the provisions of the applicable Ordinances of the City of Las Vegas, Nevada and the State laws, whether herein specified or not.

SIGNED: [Signature] AIR CONDITIONING CONTRACTOR - OWNER

Date: 7-24-68

BUILDING DEPARTMENT: [Signature]

Date: 7-30-68

#1289

PERMIT NO: 16418 PERMIT FEE: 6.50

RECEIPT

\$066 \$006.50 - 4-

CITY OF LAS VEGAS

DEPT. OF BUILDING & SAFETY

MUST BE MACHINE VALIDATED

31-10-68

G. Gatewood 2-5-79

CITY OF LAS VEGAS, NEVADA

LOG NO. & AREA

DEPARTMENT OF BUILDING & SAFETY

CONST. VAL. \$ 60.00

APPLICATION & BUILDING PERMIT — for:
Fence, Wall, Retaining Wall.

ADDRESS OF
CONSTRUCTION: 6700 Gabra Street

OWNER: SPROUL HOMES, INC.

LOT(s) 1 BLOCK 1 SUBDIVISION Charleston Rainbow 5-A

ZONE: R-1

Materials of Construction: Block ☒ Concrete ☐ Wire ☐ Wood ☐ Other ☐

Yes No

PLANS: ☐ ☒

ARCHITECT:

ENGINEER:

CALCS: ☐ ☒

CONTRACTOR: SPROUL HOMES, INC.

STATE
LICENSE # 60118


CITY
LICENSE # 6427

TOTAL SQUARE FEET: TOTAL LINEAL FEET: 10 ft.

Remarks:

CONDITIONS OF THE PERMIT:

1. Any type of retaining wall must be engineered by a Civil or Structural Engineer.
2. If a home owner takes out the Building Permit and if the owner sublets the work to a Contractor, then the Contractor must take out the permit and pay for it.
3. No fence or wall can be built on City property or rights-of-way, but this is not intended to preclude construction within utility easements if utilities will not be damaged or made inaccessible.
4. The fence or wall shall not enclose any water meter, light standard, or fire alarm box and shall not come closer than 24" from the nearest fire hydrant outlet.
5. Department Inspectors must approve footings before concrete is poured and block wall reinforcing before grouting is done.
6. Maximum height of any wall or fence is 6' side and rear yards; 4' maximum in front yard with the vertical surface above the height of 2' — 50% open and further that fencing within 25' of the intersection of curb faces on corner and through lots is limited to a maximum height of 30".
7. I must not obstruct required onsite parking space (1 space for each dwelling unit) by the erection of this fence or wall.
8. By the signing of this application I herewith agree to the requirements outlined above.

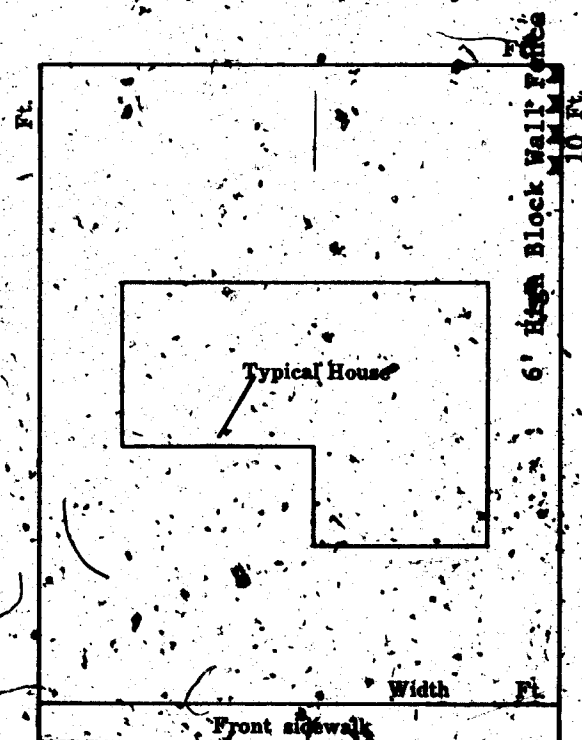

SPROUL HOMES, INC.

SIGNED BY: *[Signature]*

DATE: 10/10/68

CONTRACTOR ☐ AGENT ☐ OWNER ☒

PLANNING DEPT:

ENGINEERING DEPT:

BUILDING DEPT:

#12850

PERMIT NO. 44734

PERMIT FEE \$

RECEIPT

6439 \$003.00 - 8

CITY OF LAS VEGAS
DEPT. OF
BUILDING & SAFETY

MUST BE MACHINE VALIDATED

1-5 OCT 68

G. Gatewood 2-5-79

CITY OF LAS VEGAS, NEVADA

LOG NO. & AREA

CONST. VAL: 368

DEPARTMENT OF BUILDING & SAFETY

APPLICATION & BUILDING PERMIT for:
Fence, Wall, Retaining Wall.

ADDRESS OF CONSTRUCTION: 6700 Cabra

OWNER: O. W. Schoppe

LOT(s) 1 BLOCK 1 SUBDIVISION

Chaparral 5-A

ZONE: R-1

Materials of Construction: Block ☐ Concrete ☐ Wire ☐ Wood ☐ Other ☐

PLANS: ☐ Yes ☐ No

ARCHITECT:

ENGINEER:

CALCS: ☐ Yes ☐ No

CONTRACTOR: McKinley Enterprises

STATE LICENSE # 7263B


CITY LICENSE # 240-2

TOTAL SQUARE FEET: TOTAL LINEAL FEET: 184'

Remarks:

CONDITIONS OF THE PERMIT:

1. Any type of retaining wall must be engineered by a Civil or Structural Engineer.
2. If a home owner takes out the Building Permit and if the owner sublets the work to a Contractor, then the Contractor must take out the permit and pay for it.
3. No fence or wall can be built on City property or rights-of-way, but this is not intended to preclude construction within utility easements if utilities will not be damaged or made inaccessible.
4. The fence or wall shall not enclose any water meter, light standard, or fire alarm box and shall not come closer than 24" from the nearest fire hydrant outlet.
5. Department Inspectors must approve footings before concrete is poured and block wall reinforcing before grouting is done.
6. Maximum height of any wall or fence is 6', side and rear yards; 4' maximum in front yard with the vertical surface above the height of 2' - 50% open and further that fencing within 25' of the intersection of curb faces on corner and through lots is limited to a maximum height of 30".
7. I must not construct required onsite parking space (1 space for each dwelling unit) by the erection of this fence or wall.
8. By the signing of this application I herewith agree to the requirements outlined above.

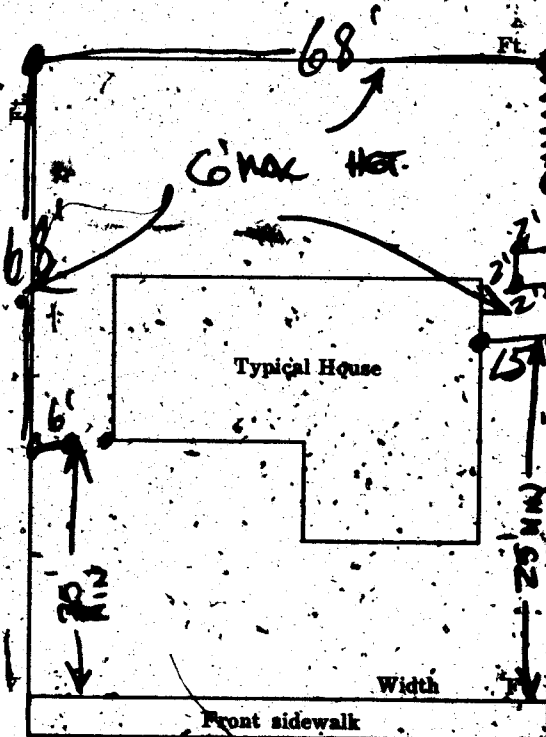

SIGNED: M. C. McKinley DATE: 12-2-68

CONTRACTOR ☐ AGENT ☐ OWNER ☐

PLANNING DEPT:

Date: 12-2-68

ENGINEERING DEPT:

Date:

BUILDING DEPT:

Date: 12-2-68

#123

PERMIT NO:

45332 PERMIT FEE:

RECEIPT

8575 \$005.00

CITY OF LAS VEGAS

DEPT. OF BUILDING & SAFETY

MUST BE MACHINE VALIDATED

L. Gatewood 2-5-79

CITY OF LAS VEGAS, NEVADA

LOG NO. & AREA

DEPARTMENT OF BUILDING & SAFETY

CONST. VAL. \$

116,800

APPLICATION & BUILDING PERMIT - for:
Dwellings, Duplexes, Misc. Residential Const.

ADDRESS OF
CONSTRUCTION:

6700 CABRA

OWNER:

C. W. SHOPPE

LOT(s)

BLOCK

SUBDIVISION

CHARLESTON RAINBOW COUNTRY ZONE: B-1

Existing structure on lot:

Dwelling

Accessory bldgs.

Vacant lot

Other

PROPOSED CONSTRUCTION:

RATIO COVER

USE:

SALE

MATERIALS OF CONSTRUCTION:

Wood Frame

Concrete Block

Reinforced Concrete

Steel Frame

SQUARE FEET OF FLOOR AREAS:

1st

2nd

3rd

Other

TOTAL SQ. FT.

93

FIRE ZONE:

1 2 3

Occupancy Group

A

B

C

D

E

F

G

H

I

J











CONST. TYPE:

I

II

III

IV

V

ARCHITECT:

ENGINEER:

NO. of UNITS

NO. of STORIES

Plans Submitted:

Yes

No

Calculations Submitted

Yes

No

Sewer Fee Req'd.

Yes

No

CONTRACTOR

Roof Metal & Roofing DBA Duralum

STATE

LICENSE #

10555

CITY

LICENSE #

10254

ADD'L. PERMITS REQ'D:

Air Cond.

Elec.

Plumbing

Signs

Paving


Fence

Public Walks

Curb-gutters

Incinerators

Fire Sprinkling System

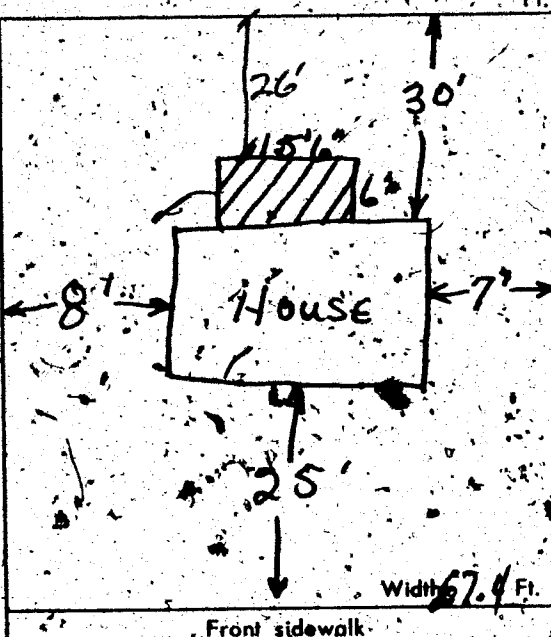

CONDITIONS OF THE PERMIT

- I agree to call the City Building Department for inspections before concrete is poured, before rough wiring, electrical, plumbing, framing is covered. Also for Air conditioning, sheetrock and sheathing inspection.
- I agree that when the job is completed that I will call for final inspection before occupancy.
- I agree to perform all construction in accordance with City Ordinances and Building Codes.
- The Contractor's signature below denotes authority from the owner to sign in his behalf and that the owner is aware of all requirements of this application and permit. Separate permits must be taken out for work outlined above this agreement.
- I have read and understand the contents of this application and permit; I hereby state that the information I have supplied on this application is true and correct.

SIGNED: Roof Metal & Roofing DBA Duralum Contractor

BY: Donald Schramberg Agent or Owner

CLARK COUNTY HEALTH DEPT.

Date

LAS VEGAS FIRE DEPARTMENT

Date

PLANNING DEPT:

RA

Date:

12-6-79

PUBLIC WORKS DEPT:

W. J. McCall

Date:

12-2-79

BUILDING DEPT:

W. J. McCall

Date:

12-2-79

*12850

PERMIT NO:

1796

PERMIT FEE \$

5.00

RECEIPT

7746 \$005.00

CITY OF LAS VEGAS
DEPT. OF
BUILDING & SAFETY

I MUST BE MACHINE VALIDATED
DEC 7 1979

L. Gatewood 2-5-79

CITY OF LAS VEGAS, NEVADA

LOG NO. & AREA

DEPARTMENT OF BUILDING & SAFETY

CONST. VAL

APPLICATION & BUILDING PERMIT for:

Fence, Wall, Retaining Wall.

ADDRESS OF CONSTRUCTION:

6700 Cabra

OWNER:

M. F. Schipper

LOT(s)

BLOCK

SUBDIVISION

ZONE:

Materials of Construction:

Block ☒

Concrete ☐

Wire ☐

Wood ☐

Other ☐

Yes

No

PLANS:

☐

☒

ARCHITECT:

ENGINEER:

CALCS:

☐

☐

CONTRACTOR:

M. F. Schipper

STATE

LICENSE #

3819

CITY

LICENSE #

TOTAL SQUARE FEET:

852


TOTAL LINEAL FEET:

142'

Remarks:

CONDITIONS OF THE PERMIT:

1. Any type of retaining wall must be engineered by a Civil or Structural Engineer.
2. If a home owner takes out the Building Permit and if the owner sublets the work to a Contractor, then the Contractor must take out the permit and pay for it.
3. No fence or wall can be built on City property or rights-of-way, but this is not intended to preclude construction within utility easements if utilities will not be damaged or made inaccessible.
4. The fence or wall shall not enclose any water meter, light standard, or fire alarm box and shall not come closer than 24" from the nearest fire hydrant outlet.
5. Department inspectors must approve footings before concrete is poured and block wall reinforcing before grouting is done.
6. Maximum height of any wall or fence is 6' side and rear yards 4' maximum in front yard with the vertical surface above the height of 2' - 50% open.
7. I must not obstruct required on-site parking space (2 spaces for each dwelling unit) by the erection of this fence or wall.
8. By the signing of this application I herewith agree to the requirements outlined above.

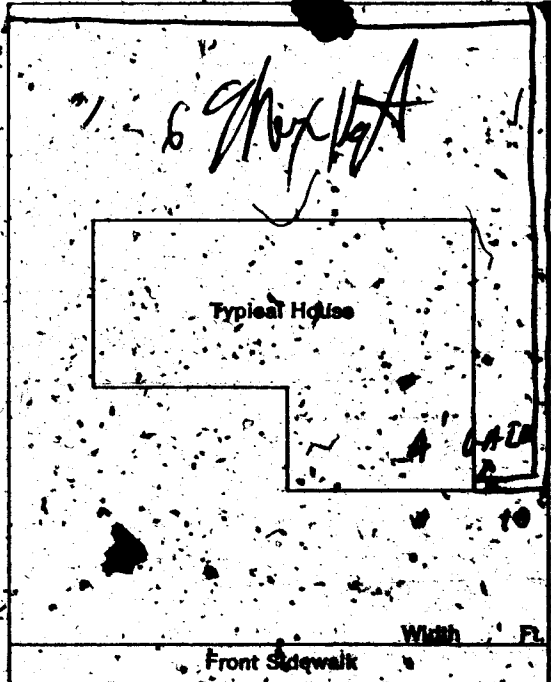

SIGNED:

[Signature]

DATE:

CONTRACTOR ☐ AGENT ☐ OWNER ☒

PLANNING DEPT:

Date:

5-3-76

PUBLIC WORKS DEPT:

Date:

5/3/76

BUILDING DEPT:

Date:

5-3-76

#12850

PERMIT NO:

2237

PERMIT FEE:

15.00

RECEIPT

1981 3045.00 - 8

CITY OF LAS VEGAS

MUST BE MACHINE VALIDATED

Theresa Kynakes 3.2.81

DEPARTMENT OF BUILDING & SAFETY
CITY OF LAS VEGAS, NEVADA

KARDEX CARD
FENCE & RETAINING WALLS

OWNER C. W. Shoppe ADDRESS 6700 Cabra DATE 12/2/68

CONTRACTOR McKinley PERMIT NO. 45332

LOT 1 BLOCK 1 SUBDIVISION Charleston Rainbow 5-A
Wire

Fence (wire, wood, etc.)	Walls (masonry, rock, etc.)
Location _____	Location _____
Final Inspection <u>P.S. 2-6-69</u>	Footings _____
	Wall Steel 1st _____ 2d _____ 3d _____
	Final Inspection _____
Retaining Wall (masonry)	Retaining Wall (concrete)
Location _____	Location _____
Footings _____	Footings _____
Wall Steel 1st _____ 2d _____ 3d _____	Wall Steel 1st _____ 2d _____ 3d _____
Bond Beam 1st _____ 2d _____ 3d _____	Final Inspection _____
Final Inspection _____	

23.14 B ADDRESS 6700 Cabra LOG NO. _____ AREA _____

DEPT. of BLDG & SAFETY—CITY of LAS VEGAS, NEVADA

OWNER C. W. Shoppe ADDRESS 6700 Cabra DATE 12-2-71

GEN. CONT. Kool Metal of Nevada TYPE OF STRUCTURE patio cover

PERMIT NO. 1-2316 LEGAL DESCRIPTION L 1 B 1 Charleston Rainbow

BUILDING	MECHANICAL	ELECTRICAL
LOCATION _____	PLUMBING CONT. _____	TEMP. POLE CONT. _____
FIREPLACE FTS. _____	PERMIT NO. _____ DATE _____	PERMIT NO. _____ DATE _____
FOOTINGS _____	HEAT VENT. AC CONT. _____	INSPECTION _____ DATE _____
FOUNDATION WALL _____	PERMIT NO. _____ DATE _____	ELECTRICAL CONT. _____
FLOOR FRAMING _____	SEWER CONT. _____	PERMIT NO. _____ DATE _____
SLAB _____	PERMIT NO. _____ DATE _____	FIXTURES CONT. _____
CHIMNEY STEEL (FIREPLACE) _____	ROUGH SOIL _____	PERMIT NO. _____ DATE _____
WALL STEEL _____	ROUGH WATER _____	SLAB _____
COLUMN STEEL _____	TOP-OUT _____	ROUGH _____
BEAM STEEL _____	ROUGH GAS _____	FINAL ROUGH _____
PAVING _____	AC ROUGH DUCT _____	FINAL FIXTURE _____
ROOF SHEATHING _____	REF. ROUGH PIPING _____	FINAL ELECTRICAL _____
INTERIOR _____	FINAL PLUMBING _____	
EXTERIOR _____	FINAL GAS _____	TEMPORARY SERVICE _____
DRYWALL _____	FINAL AIR COND. _____	
LETING _____	FINAL REFRIG. _____	MISCELLANEOUS _____
BACKING (SHOWS) _____	FINAL SEWER _____	
PLASTER SCRATCH _____	FINAL SEPTIC TANK _____	
PLASTER BROWN _____		
URBAN REDEVELOPMENT APPROVAL _____		
FINAL BLDG _____ DATE _____		

APPROVED FOR OCCUPANCY BY METER 02957672 INSPECTOR _____ DATE _____

PLEASE NOTE REMARKS ON REVERSE SIDE 6700 Cabra LOG # _____ AREA # _____ 23.04

DEPARTMENT OF BUILDING & SAFETY
CITY OF LAS VEGAS, NEVADAKARDEX CARD
FENCE & RETAINING
WALLSOWNER Sproul Homes ADDRESS 6700 Cabra St. DATE 10/15/68CONTRACTOR Sproul Homes PERMIT NO. 44734LOT 1 BLOCK 1 SUBDIVISION Charleston Rainbow 5-A
Block

Fence (wire, wood, etc.)

Walls (masonry, rock, etc.)

Location

Final Inspection

Location CH 10-15-68Footings CH 10-15-68Wall Steel 1st 2d 3dFinal Inspection 10-15-68

Retaining Wall (masonry)

Retaining Wall (concrete)

Location

Footings

Wall Steel 1st 2d 3dBond Beam 1st 2d 3d

Final Inspection

Location

Footings

Wall Steel 1st 2d 3d

Final Inspection

23.14 B

ADDRESS 6700 Cabra

LOG NO.

AREA

DEPARTMENT OF BUILDING & SAFETY
CITY OF LAS VEGAS, NEVADAKARDEX CARD
FENCE & RETAINING
WALLSOWNER Schweppe ADDRESS 6700 Cabra DATE 5-3-76CONTRACTOR Artistic Masonry PERMIT NO. 8231LOT 1 BLOCK 1 SUBDIVISION block fence

Fence (wire, wood, etc.)

Walls (masonry, rock, etc.)

Location

Final Inspection

Location BW 5-3-76Footings BW 5-3-76Wall Steel 1st BW 5-3-76 2d 3d

Final Inspection

Retaining Wall (masonry)

Retaining Wall (concrete)

Location

Footings

Wall Steel 1st 2d 3dBond Beam 1st 2d 3d

Final Inspection

Location

Footings

Wall Steel 1st 2d 3d

Final Inspection

Therese Kyriakos 3.2.81

DEPT. of BLDG. & SAFETY - CITY of LAS VEGAS, NEVADA		
OWNER: Mill Homes	ADDRESS: 6700 Cabra Street	DATE: 5/26/68
GEN. GR. [unclear]	TYPE OF STRUCTURE: SFD	
PERMIT NO. 24256	LEGAL DESCRIPTION: L. I. B. 1, Charleston Rainbow #5-A	
BUILDING	MECHANICAL	ELECTRICAL
LOCATION: 5-6-12	PLUMBING CONT. [unclear]	TEMP. POLE CONT. [unclear]
FIREPLACE: [unclear]	PERMIT NO. 24312 DATE 5-6-68	PERMIT NO. [unclear] DATE [unclear]
FOOTINGS: [unclear]	HEAT & VENT. AC CONT. [unclear]	INSPECTION [unclear] DATE [unclear]
FOUNDATION WALL: [unclear]	PERMIT NO. 14418 DATE 2-31-68	ELECTRICAL CONT. [unclear]
FLOOR FRAMING: [unclear]	SEWER CONT. [unclear]	PERMIT NO. 25968 DATE 2-7-68
SLAB: [unclear]	PERMIT NO. 24256 DATE 6-28-68	CHIMNEYS CONT. [unclear]
CHIMNEY STEEL (FIREPLACE): [unclear]	ROUGH SOIL: [unclear]	PERMIT NO. [unclear] DATE [unclear]
WALL STEEL: [unclear]	ROUGH WATER: [unclear]	SLAB: [unclear]
COLUMN STEEL: [unclear]	TOP-OUT: [unclear]	ROUGH: [unclear]
BEAM STEEL: [unclear]	ROUGH GAS: [unclear]	FINAL ROUGH: [unclear]
FRAMING: [unclear]	AC ROUGH DUCT: [unclear]	FINAL FIXTURE: [unclear]
ROOF SHEATHING: [unclear]	REF. ROUGH PIPING: [unclear]	FINAL ELECTRICAL: [unclear]
INTERIOR: [unclear]	FINAL PLUMBING: [unclear]	TEMPORARY SERVICE: [unclear]
EXTERIOR: [unclear]	FINAL GAS: [unclear]	MISCELLANEOUS: [unclear]
DRI WALL: [unclear]	FINAL AIR COND: [unclear]	
LOADING: [unclear]	FINAL REFRIG: [unclear]	
BACKING (SLOPE): [unclear]	FINAL SEWER: [unclear]	
PLASTER: [unclear]	FINAL SEPTIC TANK: [unclear]	
URBAN REDEVELOPMENT APPROVAL: [unclear]		
FINAL BUILD: [unclear]		
DATE: [unclear]		

APPROVED FOR OCCUPANCY: METER [unclear] INSPECTOR [unclear]

PLEASE NOTE REMARKS ON REVERSE: 6700 Cabra Street LOG # T-11 AREA # 4