

6501 BRISTOL WAY

LOT 17 BLK 23 CHARLESTON HGTS 27-C ZONE R-1

D. Gatewood 1:30-79

CITY OF LAS VEGAS, NEVADA

LOG NO. & AREA

CONST. VAL. \$ 60.00

DEPARTMENT OF BUILDING & SAFETY

APPLICATION & BUILDING PERMIT — for:
Fence, Wall, Retaining Wall.

ADDRESS OF
CONSTRUCTION:

6501 Bristol Way

OWNER:

H.G. St. Clair

LOT(s)

17

BLOCK

23

SUBDIVISION

C.H. 27-C

ZONE:

R-1

Materials of Construction:

Block ☐

Concrete ☐

Wire ☐

Wood ☒

Other ☐

Yes No

PLANS:

☐ ☐

ARCHITECT:

None

ENGINEER:

None

CALCS:

☐ ☐

CONTRACTOR:

Owner

STATE
LICENSE #

CITY
LICENSE #

TOTAL SQUARE FEET:


TOTAL LINEAL FEET:

60'

Remarks:

CONDITIONS OF THE PERMIT:

1. Any type of retaining wall must be engineered by a Civil or Structural Engineer.
2. If a home owner takes out the Building Permit and if the owner sublets the work to a Contractor, then the Contractor must take out the permit and pay for it.
3. No fence or wall can be built on City property or rights-of-way, but this is not intended to preclude construction within utility easements if utilities will not be damaged or made inaccessible.
4. The fence or wall shall not enclose any water meter, light standard, or fire alarm box and shall not come closer than 24" from the nearest fire hydrant outlet.
5. Department Inspectors must approve footings before concrete is poured and block wall reinforcing before grouting is done.
6. Maximum height of any wall or fence is 6', side and rear yards; 4' maximum in front yard with the vertical surface above the height of 2' — 50% open and further that fencing within 25' of the intersection of curb faces on corner and through lots is limited to a maximum height of 30".
7. I must not obstruct required onsite parking space (1 space for each dwelling unit) by the erection of this fence or wall.
8. By the signing of this application I herewith agree to the requirements outlined above.

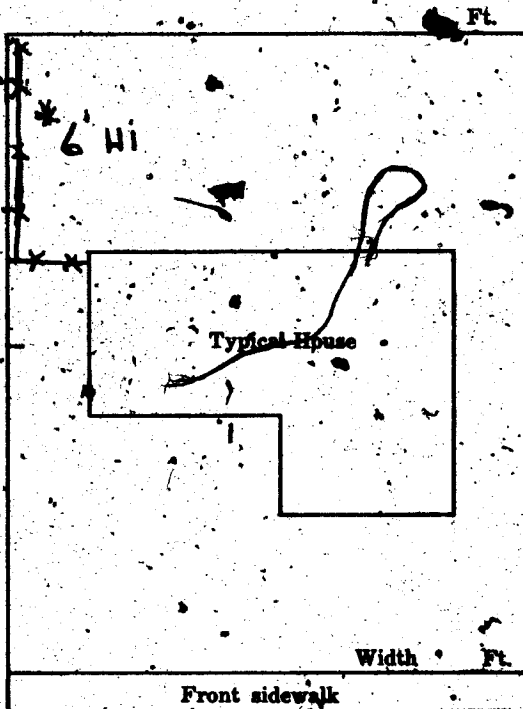

BRISTOL

SIGNED:

Hank H. Clair

DATE:

CONTRACTOR ☐ AGENT ☐ OWNER ☒

PLANNING DEPT:

R. D. Davis

Date:

5/23/67

ENGINEERING DEPT:

Date:

5-23-67

BUILDING DEPT:

J. K. Kneip

Date:

5-23-67

#1285

PERMIT NO:

37464

PERMIT FEE \$

3.00

RECEIPT

1956 \$006.00 — 8

CITY OF LAS VEGAS
DEPT. OF
BUILDING & SAFETY

MUST BE MACHINE VALIDATED

24 MAY 67

D. Gatewood 1-30-79

LOG NO. & AREA

CITY OF LAS VEGAS, NEVADA

CONST. VAL. \$ 20.00

DEPARTMENT OF BUILDING & SAFETY

APPLICATION & BUILDING PERMIT — for:
Fence, Wall, Retaining Wall.

ADDRESS OF
CONSTRUCTION:

6501 1/2 Bristol Way

OWNER:

St. Clair

LOT(s)

17

BLOCK

23

SUBDIVISION

CH 27C

ZONE:

R

Materials of Construction:

Block ☐

Concrete ☐

Wire ☒

Wood ☒

Other ☐

Yes

No

PLANS:

☐

☐

ARCHITECT:

ENGINEER:

CALCS:

☐

☒

CONTRACTOR:

STATE

LICENSE #

CITY

LICENSE #

TOTAL SQUARE FEET:


TOTAL LINEAL FEET:

14'

Remarks:

CONDITIONS OF THE PERMIT:

1. Any type of retaining wall must be engineered by a Civil or Structural Engineer.
2. If a home owner takes out the Building Permit and if the owner sublets the work to a Contractor, then the Contractor must take out the permit and pay for it.
3. No fence or wall can be built on City property or rights-of-way, but this is not intended to preclude construction within utility easements if utilities will not be damaged or made inaccessible.
4. The fence or wall shall not enclose any water meter, light standard, or fire alarm box and shall not come closer than 24" from the nearest fire hydrant outlet.
5. Department Inspectors must approve footings before concrete is poured and block wall reinforcing before grouting is done.
6. Maximum height of any wall or fence is 6', side and rear yards; 4' maximum in front yard with the vertical surface above the height of 2' — 50% open and further that fencing within 25' of the intersection of curb faces on corner and through lots is limited to a maximum height of 30".
7. I must not obstruct required onsite parking space (1 space for each dwelling unit) by the erection of this fence or wall.
8. By the signing of this application I herewith agree to the requirements outlined above.

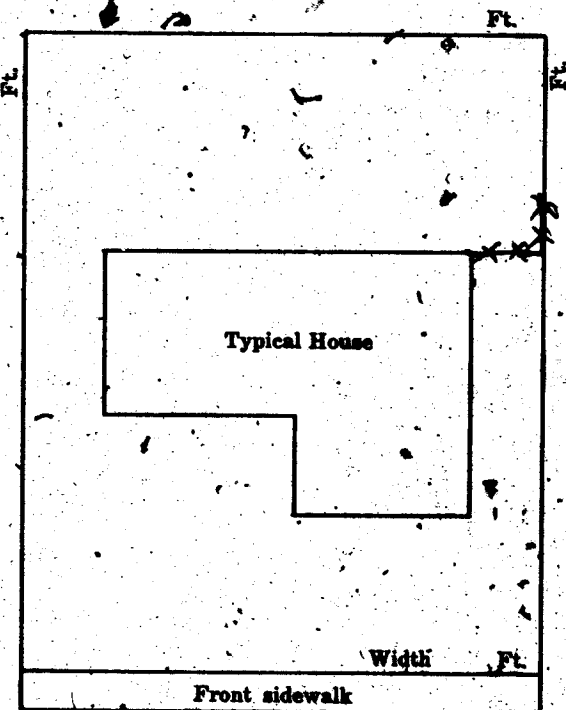

BRISTOL WAY

SIGNED

Harold St. Clair

DATE:

5/31

CONTRACTOR ☐ AGENT ☐ OWNER ☐

by Harold St. Clair III

PLANNING DEPT:

Date:

5/31/67

ENGINEERING DEPT:

Date:

BUILDING DEPT:

9. Wenzel

Date:

5-31-67

#1285*

PERMIT NO:

37686

PERMIT FEE:

3.00

RECEIPT

331 \$003.00 — 8

CITY OF LAS VEGAS

DEPT. OF
BUILDING & SAFETY

MUST BE MACHINE VALIDATED

1 JUN 67

D. Gatewood 1-30-79

CITY OF LAS VEGAS, NEVADA

LOG NO. & AREA

DEPARTMENT OF BUILDING & SAFETY

CONST. VAL. \$

1350

APPLICATION & BUILDING PERMIT - for
Fence, Wall, Retaining Wall.

ADDRESS OF
CONSTRUCTION:

6501 BRISTOL WAY

OWNER: MARVIN DU MAY

LOT(s)

17

BLOCK

23

SUBDIVISION

CHARLESTON

HQTS 27-C

ZONE

R1

Materials of Construction:

Block ☐

Concrete ☐

Wire ☒

Wood ☐

Other ☐

ARCHITECT:

ENGINEER:

PLANS: ☐

Yes ☐ No ☒

CALCS: ☐

Yes ☐ No ☒

CONTRACTOR:

American Fence

STATE

LICENSE #

8581

CITY

LICENSE #

275

TOTAL SQUARE FEET:


TOTAL LINEAL FEET:

25

Remarks:

CONDITIONS OF THE PERMIT:

1. Any type of retaining wall must be engineered by a Civil or Structural Engineer.
2. If a home owner takes out the Building Permit and if the owner sublets the work to a Contractor, then the Contractor must take out the permit and pay for it.
3. No fence or wall can be built on City property or rights-of-way, but this is not intended to preclude construction within utility easements. If utilities will not be damaged or made inaccessible.
4. The fence or wall shall not enclose any water meter, light standard, or fire alarm box and shall not come closer than 24" from the nearest fire hydrant outlet.
5. Department Inspectors must approve footings before concrete is poured and block wall reinforcing before grouting is done.
6. Maximum height of any wall or fence is 6', side and rear yards; 4' maximum in front yard with the vertical surface above the height of 2' - 50% open.
7. I must not obstruct required onsite parking space (1 space for each dwelling unit) by the erection of this fence or wall.
8. By the signing of this application I herewith agree to the requirements outlined above.

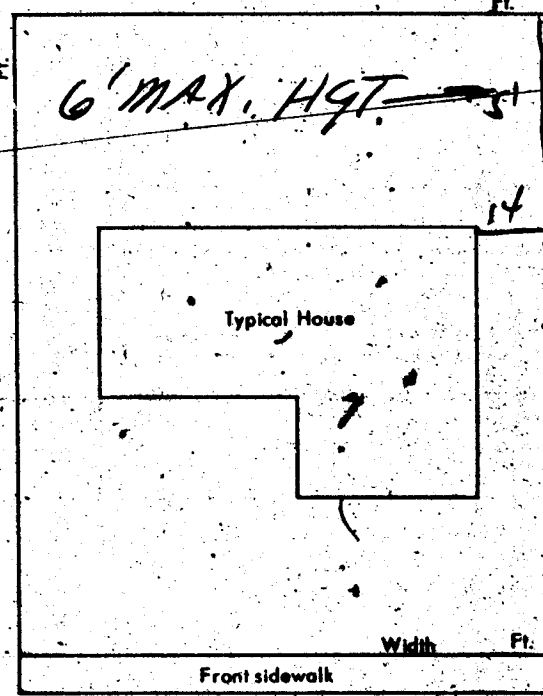

SIGNED:

CONTRACTOR ☐

AGENT ☐

OWNER ☒

DATE:

3-18-71

PLANNING DEPT.:

Date:

3/23/71

PUBLIC WORKS DEPT.:

Date:

BUILDING DEPT.:

Date:

2-23-71

#12850

PERMIT NO.:

57275

PERMIT FEE \$

5.00

RECEIPT

1835

\$005.00

8

CITY OF LAS VEGAS

DEPT. OF
BUILDING & SAFETY

MUST BE MACHINE VALIDATED

23 FEB 71

DEPARTMENT OF BUILDING & SAFETY
CITY OF LAS VEGAS, NEVADA

KARDEX CARD
FENCE & RETAINING
WALLS

OWNER St. Clair

ADDRESS 6501 Bristol Way

DATE 6/1/67

CONTRACTOR Owner

PERMIT NO. 37686

LOT 17

BLOCK 23

SUBDIVISION

Charleston Heights 27-C
Wire Fence

Fence (wire, wood, etc.)	Walls (masonry, rock, etc.)
Location	Location
Final Inspection <u>6-19-67</u>	Footings
	Wall Steel 1st 2d 3d
	Final Inspection
Retaining Wall (masonry)	Retaining Wall (concrete)
Location	Location
Footings	Footings
Wall Steel 1st 2d 3d	Wall Steel 1st 2d 3d
Bond Beam 1st 2d 3d	Final Inspection
Final Inspection	

23.14 B

ADDRESS 6501 Bristol Way

LOG NO.

AREA

DEPARTMENT OF BUILDING & SAFETY
CITY OF LAS VEGAS, NEVADA

KARDEX CARD
FENCE & RETAINING
WALLS

OWNER H. G. St. Clair

ADDRESS 6501 Bristol Way

DATE 5/23/67

CONTRACTOR Owner

PERMIT NO. 37464

LOT 17

BLOCK 23

SUBDIVISION

Charleston Heights 27-C
Wood Fence

Fence (wire, wood, etc.)	Walls (masonry, rock, etc.)
Location	Location
Final Inspection <u>Sept 5-26-67</u>	Footings
	Wall Steel 1st 2d 3d
	Final Inspection
Retaining Wall (masonry)	Retaining Wall (concrete)
Location	Location
Footings	Footings
Wall Steel 1st 2d 3d	Wall Steel 1st 2d 3d
Bond Beam 1st 2d 3d	Final Inspection
Final Inspection	

23.14 B

ADDRESS 6501 Bristol Way

LOG NO.

AREA

Reginald L. Jackson 2/24/80

OWNER <u>SPROUT HOMES INC</u>		DEPT. of BLDG & SAFETY - CITY of LAS VEGAS, NEVADA		ADDRESS <u>6501 Bristol Way</u>		DATE <u>7-9-63</u>	
PERMIT NO. <u>18179</u>		LEGAL DESCRIPTION <u>LOT 17 Blk 23</u>		TYPE OF STRUCTURE <u>SED</u>			
BUILDING		MECHANICAL		ELECTRICAL			
LOCATION <u>SP 5-28-63</u>		PLUMBING CONT. <u>UNITED</u>		TEMP. POLE CONT.		DATE	
FIREPLACE FTS		PERMIT NO. <u>13471</u>	DATE <u>6-26-63</u>	PERMIT NO.		DATE	
FOOTINGS <u>5-15-28-63</u>		HEAT & VENT AC CONT. <u>Gardner</u>		INSPECTION		DATE	
FOUNDATION WALL		PERMIT NO. <u>8-763</u>	DATE <u>6-12-63</u>	ELECTRICAL CONT.		DATE	
FLOOR FRAMING		SEWER CONT. <u>UNITED</u>		PERMIT NO. <u>13729</u>	DATE <u>7-27-63</u>		
SLAB <u>5-16-14-63</u>		PERMIT NO. <u>13471</u>	DATE <u>6-26-63</u>	FIXTURES CONT.		DATE	
CHIMNEY STEEL (FIREPLACE)		ROUGH SOIL		PERMIT NO. <u>13729</u>	DATE		
WALL STEEL		ROUGH WATER		SLAB		DATE	
COLUMN STEEL		TOP-OUT <u>1-20-7-16-63</u>		ROUGH		DATE	
BEAM STEEL		ROUGH GAS		FINAL ROUGH		DATE	
FRAMING <u>5-17-12-63</u>		AC ROUGH DUCT <u>1-20-7-16-63</u>		FINAL FIXTURE		DATE	
ROOF SHEATHING <u>5-17-12-63</u>		REF. ROUGH PIPING		FINAL ELECTRICAL <u>1-20-7-16-63</u>		DATE	
INTERIOR		FINAL PLUMBING <u>Phillips 9-4-63</u>		TEMPORARY SERVICE			
DRYWALL		FINAL GAS <u>Phillips 9-4-63</u>					
LATHING		FINAL AIR COND. <u>Phillips 9-4-63</u>					
BACKING (SIDING)		FINAL REFRIG.		MISCELLANEOUS			
PLASTER <u>5-17-12-63</u>		FINAL SEWER		GRADING & DRAINAGE		APP.	
BROWN		FINAL SEPTIC TANK		ON-SITE PARKING SPACES		APP.	
URBAN REDEVELOPMENT APPROVAL				ENG APPROVAL OF			
FINAL BLDG <u>Stubb</u>	DATE <u>9-5-63</u>			OFF-SITE IMPROVEMENTS			

APPROVED FOR OCCUPANCY & METER
PLEASE NOTE REMARKS ON REVERSE SIDE

6501 BRISTOL WAY

DEPARTMENT OF BUILDING & SAFETY
CITY OF LAS VEGAS, NEVADA

KARDEX CARD
FENCE & RETAINING
WALLS

OWNER Marvin DuMay ADDRESS 6501 Bristol Way DATE 2-23-71
CONTRACTOR American Fence PERMIT NO. 57275
LOT 17 BLOCK 23 SUBDIVISION Charleston Heights 27 C wire fence

Fence (wire, wood, etc.)	Walls (masonry, rock, etc.)
Location	Location
Final Inspection <u>SC 3-9-71</u>	Footings
	Wall Steel 1st ____ 2d ____ 3d ____
	Final Inspection
Retaining Wall (masonry)	Retaining Wall (concrete)
Location	Location
Footings	Footings
Wall Steel 1st ____ 2d ____ 3d ____	Wall Steel 1st ____ 2d ____ 3d ____
Bond Beam 1st ____ 2d ____ 3d ____	Final Inspection
Final Inspection	

23.14 B

ADDRESS 6501 Bristol Way LOG NO. _____ AREA _____