

2914 Ashby

LOT 20&21 BLK 2 McNeil zone r-e

LOG NO. & AREA

CITY OF LAS VEGAS, NEVADA

DEPARTMENT OF BUILDING & SAFETY

CONST. VAL. \$

APPLICATION & BUILDING PERMIT for:

Dwellings, Duplexes, Misc. Residential Const.

ADDRESS OF

CONSTRUCTION:

2914 Ashby

OWNER:

W. H. CROW

LOT(S) 20 & 21 BLOCK 2 SUBDIVISION

ZONE: E-E

Existing structure on lot: Dwelling ☒ Accessory bldg. ☐ Vacant lot ☐ Other ☐

PROPOSED CONSTRUCTION: carport and storage USE: Access

MATERIALS OF CONSTRUCTION: Wood Frame ☐ Concrete Block ☐ Reinforced Concrete ☐ Steel Frame ☐


SQUARE FEET OF FLOOR AREAS: 1st 2nd 3rd Other TOTAL SQ. FT. 609

FIRE ZONE: 1 2 3 Occupancy Group: A B C D E F G H I J-2345 CONST. TYPE: I II III IV V

ARCHITECT: ENGINEER: NO. of UNITS NO. of STORIES

Plans Submitted: Yes ☐ No ☐ Calculations Submitted: Yes ☐ No ☐ Sewer Fee Req'd: Yes ☐ No ☐

CONTRACTOR: OWNER STATE LICENSE # CITY LICENSE #

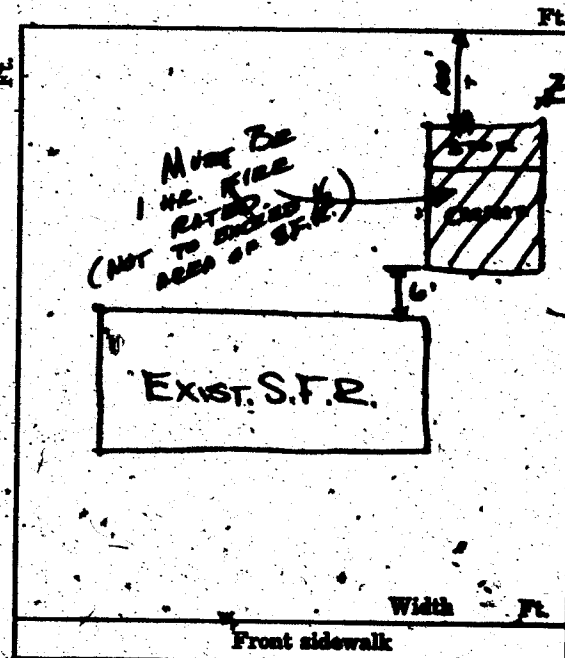ADD'L PERMITS REQ'D: Air Cond. ☐ Elec. ☐ Plumbing ☐ Signs ☐ Paving ☐ Fence ☐ Public Walks ☐ Curb-gutter ☐ Incinerators ☐ Fire Sprinkling System ☐

CONDITIONS OF THE PERMIT:

- I agree to call the City Building Department for inspections before concrete is poured, before rough wiring, electrical, plumbing, framing is covered. Also for Air conditioning, sheet-rock and sheathing inspection.
- I agree that when the job is completed that I will call for final inspection before occupancy.
- I agree to perform all construction in accordance with City Ordinances and Building Codes.
- The Contractor's signature below denotes authority from the owner to sign in his behalf and that the owner is aware of all requirements of this application and permit. Separate permits must be taken out for work outlined above this agreement.
- I have read and understand the contents of this application and permit; I hereby state that the information I have supplied on this application is true and correct.

SIGNED: W. H. CROW Contractor

BY: W. H. CROW Agent or Owner

CLARK COUNTY HEALTH DEPT. Date

LAS VEGAS FIRE DEPARTMENT Date

RECEIPT

8398 \$024.00 - 8

CITY OF LAS VEGAS
DEPT. OF
BUILDING & SAFETYMUST BE MACHINE VALIDATED
26 NOV 68

PLANNING DEPT. Date: 11-25-68

ENGINEERING DEPT. Date: 11-25-68

BUILDING DEPT. Date: 11-25-68

#1250 PERMIT NO. 45299 PERMIT FEE \$ 24.00

DEPT. of BLDG & SAFETY - CITY of LAS VEGAS, NEVADA

OWNER: W.C. COULTER

ADDRESS: 2914 Ashby

DATE: 8-14-62

GEN CONT. 11933

TYPE OF STRUCTURE: Pool

PERMIT NO. 11933

LEGAL DESCRIPTION

BUILDING	MECHANICAL	ELECTRICAL

APPROVED FOR OCCUPANCY

APPROVED FOR METER

PLEASE NOTE REMARKS ON REVERSE SIDE

INSPECTOR

LOG #

AREA #

23.04

2914 Ashby

M-3046

4

DEPT. of BLDG & SAFETY - CITY of LAS VEGAS, NEVADA

OWNER: W. H. CROW

ADDRESS: 2914 Ashby

DATE: 11/26/68

GEN CONT. 45299

LEGAL DESCRIPTION: Por 20-21 Block 2, McNeil Tr

TYPE OF STRUCTURE: carport & storage

PERMIT NO. 45299

BUILDING	MECHANICAL	ELECTRICAL

APPROVED FOR OCCUPANCY

APPROVED FOR METER

PLEASE NOTE REMARKS ON REVERSE SIDE

INSPECTOR

DATE

2914 Ashby

LOG #

AREA #

23.04

Debbie Angstrom 7-23-86

CITY OF LAS VEGAS, NEVADA

LOG NO. & AREA M-26 DATE 7/16/86 CONST. VAL. \$ 10,000
 DEPARTMENT OF BUILDING AND SAFETY 030-551-019 BUILDING PERMIT - FOR: Single Family Dwelling,
 PHONE 386-6251 Remodel, Additions, Misc. Residential Construction
 ADDRESS OF CONSTRUCTION: 2914 Ashby Ave. OWNER: Cleve Crundington PHONE NO.
 LOT: 2914 BLOCK 3 SUBDIVISION McNeil Court ZONE R-C
 PROPOSED CONSTRUCTION Remodel USE
 THIS PERMIT FOR 2914 BLDG. ☒ AC ☐ ELEC ☐ PLBG ☐ OTHER PERMITS REQD.: FENCE ☐ OFF SITE ☐ SWIM POOL ☐
 FLOOR AREA BSMT 1ST 532 2ND GARAGE PORCH TOTAL 532
 CONTRACTOR Arner STATE LICENSE NO. CITY LICENSE NO.
 ARCHITECT ENGINEER
 MASTER PLUMBER/CONTRACTOR MASTER ELECTRICIAN/CONTRACTOR

OTHER INSPECTIONS AND FEES

- Inspections outside of normal business hours = \$30.00 per hour (minimum charge three hours)
- Re-inspection fee during normal business hours assessed under provisions of TABLE 3-A of the Uniform Building Code = \$30.00 per hour
- Inspections during normal business hours for which no fee is specifically indicated = \$30.00 per hour (minimum charge one half hour)
- Additional plan review required by change, additions or revisions to approved plans = \$30.00 per hour (minimum charge two hours)

CONDITIONS OF THE PERMIT:

- I agree to call the City Building Department for inspections before concrete is poured, before rough wiring, electrical, plumbing, framing is covered. Also for air conditioning, drywall and sheathing inspection.
- I agree that when the job is completed that I will call for final inspection before occupancy.
- I agree to perform all construction in accordance with City Ordinances and Building Codes.
- The Contractor's signature below denotes authority from the owner to sign in his behalf and that the owner is aware of all requirements of this application and permit. Separate permits must be taken out for work outlined above this agreement.
- I have read and understand the contents of this application and permit; I hereby state that the information I have supplied on this application is true and correct.
- Approval for the work under this permit will be given only after refuse and debris have been removed from job site and public right of way.
- 24 HOUR MINIMUM NOTICE REQUIRED FOR INSPECTIONS

BY: [Signature] I HEREBY DECLARE THAT I AM THE LEGAL OWNER OF THE ABOVE PROPERTY.

OWNER

BY: [Signature] AGENT

I hereby certify that I have reviewed this application and the proposed plans and have found that the proposed development meets the requirements of the City of Las Vegas Flood Hazard Reduction Ordinance for the issuance of this Development Permit.

LAND DEVELOPMENT AND FLOOD CONTROL ENGINEER

DATE

PLANNING DEPT.


DATE

BUILDING DEPT.

DATE

PLUMBING		FEE	ELECTRICAL		FEE
WATER DISTRIBUTION	6.00	6.00	RECEPTACLE 3 SWITCH 1	.40	1.60
SEWER SYSTEM - NEW OR MODIFICATION	10.00	10.00	EACH LIGHT FIXTURE OR SOCKET 1	.30	0.30
FIXTURES WATER SOFTENER M.W. HEATER	2.00	6.00	SPECIAL OUTLET, APPLIANCE ETC.	.70	
GARBAGE DISPOSAL - WASHES	2.00		SERVICE/PANEL - SUBS. 00 - 200A/6.00, 400A/12.50		
FUEL PIPING	6.00		A.C. UNIT OR MOTORS	3.00	
IRRIGATION SYSTEM	6.00		2310 - 2402 TOTAL	1.90	
			MISC.		
2310 - 2403 TOTAL	32.00		2310 - 2401 ISSUANCE FEE		
AIR CONDITIONING		FEE	7114 - 3654 SEWER CONNECTION		
NEW UNIT - 3 TON = 9.00 OVER = 16.50			2310 - 2401 PLAN REVIEW FEE		
FURNACE TO 400,000/9.00 OVER/11.00			2310 - 2401 BLDG. PERMIT FEE	103.80	
VAPORATIVE COOLER	6.50		TOTAL FEES	137.70	
VENTILATION FAN	2.35				
2310 - 2405 TOTAL					

PERMIT EXPIRES 180 DAYS AFTER ABANDONMENT OF WORK

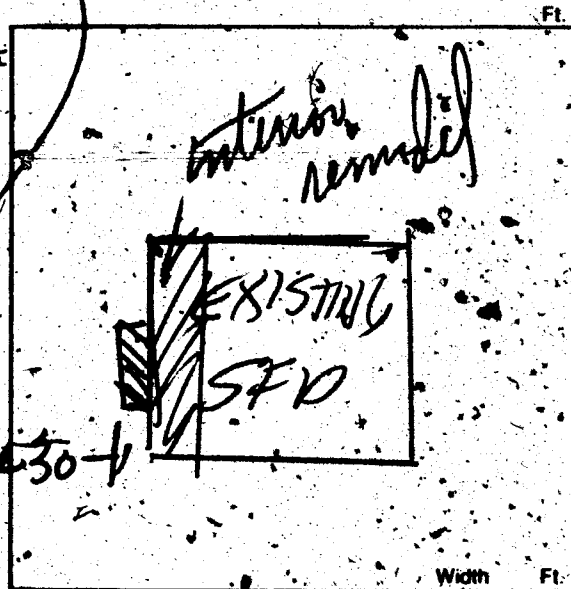

ID-OK

RECEIVED 06**

PLBG 32.00
 ELEC 1.90
 SFD 103.80
 CHEK 137.70
 9296A000 13:28

PERMIT NO.

MUST BE MACHINE VALIDATED

Debbie Ingram 10-16-86

Debbie Ingram 10-14-86

OWNER	Cleve Crudginton	ADDRESS	2914 Ashby Avenue
DATE	7-18-85	GEN. CONT.	Owner
BUILD. TYPE	Remodel	PERMIT No.	9296
LEGAL	See application for legal	LOG No.	M-726
BUILDING		MECHANICAL	
Pt. Loc. & Ft. ☐		Plumbing Cont.	Owner
Location & Footing ☐		Permit No.	9296
Stemwall ☐		A/C Cont.	Date 7-18-86
Concrete Slab Floor ☐		Permit No.	
Chimney Steel ☐		Sewer	
Fireplace Footing ☐		Irrig. Cont.	
Vert. Steel Reinf. ☐		Permit No.	
Horiz. Steel Reinf. ☐		Hood Cont.	
Roof Sheathing		Permit No.	
Insulation		Rough Soil ☐	
Framing		Rough Water ☐	
Ext. Lath		Top Out	
Ext. Scratch		Rough Gas	
Ext. Brown		A/C Rough Duct.	
Drywall		Final Plumbing	
Final Building		Final Gas	
Appr. for Occu. Final Building		Final Air Cond.	
		Final Sewer	
ELECTRICAL		ELECTRICAL	
Electrical Cont.	Owner	Rough Hood ☐	
Permit No.	9296	Final Hood ☐	
Date	7-21-85	Final Irrig.	
PT Rough			
Ground Electrode		ELECTRICAL	
Temporary Power		Temp. Pole Cont.	
Meter Tag		Permit No.	
Final Electrical		Inspection	