

34 AMBER

LOT 47 BLK 2 T#IN LAKES VILLAGE #11 R-1 ZONE

James 12-20-74

22-1

CITY OF LAS VEGAS, NEVADA

LOG NO. & AREA

DEPARTMENT OF BUILDING & SAFETY

CONST. VAL. \$

585.00

APPLICATION - BUILDING PERMIT for: Fence, Wall, Retaining Wall.

ADDRESS OF CONSTRUCTION:

34 AMBER CR

OWNER:

JABLONSKI, Ed

LOT(S)

47

BLOCK

2

SUBDIVISION

Twin Lakes Village #11

ZONE: R-1

Materials of Construction:

Block

Concrete

Wire

Wood

Other

Yes

No

ARCHITECT:

ENGINEER:

PLANS:

CALCS:

CONTRACTOR:

Owner

STATE LICENSE #

CITY LICENSE #

TOTAL SQUARE FEET

390

TOTAL LINEAL FEET:


65

Remarks:

Remarks section with three empty lines.

CONDITIONS OF THE PERMIT:

- 1. Any type of retaining wall must be engineered by a Civil or Structural Engineer.
2. If a home owner takes out the Building Permit and if the owner sublets the work to a contractor, then the contractor must take out the permit and pay for it.
3. No fence or wall can be built on City property or rights-of-way, but this is not intended to preclude construction within utility easements if utilities will not be damaged or made inaccessible.
4. The fence or wall shall not enclose any water meter, light standard, or fire alarm box and shall not come closer than 24" from the nearest fire hydrant outlet.
5. Department inspectors must approve footings before concrete is poured and block wall reinforcing before grouting is done.
6. Maximum height of any wall or fence is 6', side and rear yards; 4' maximum in front yard with the vertical surface above the height of 50% open.
7. I must not obstruct required onsite parking space (2 spaces for each dwelling unit) by the erection of this fence or wall.
8. By the signing of this application I herewith agree to the requirements outlined above.

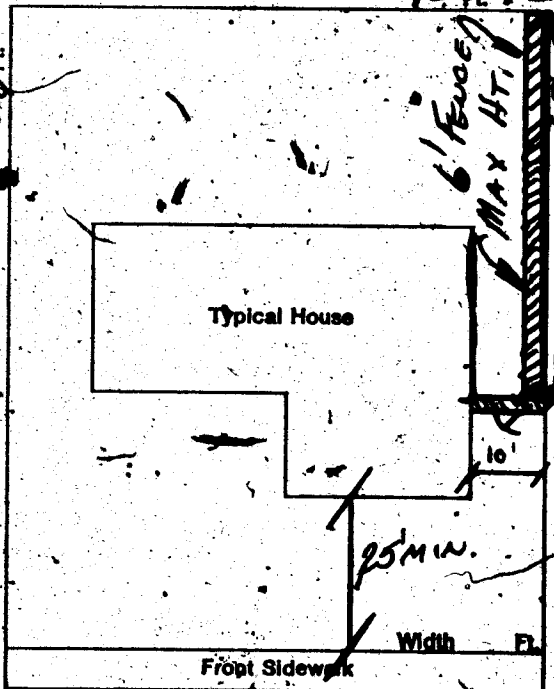

Amber Circle

SIGNED:

Signature of James Jablonski

DATE:

CONTRACTOR

AGENT

OWNER

PLANNING DEPT:

Signature of planning department official

Date:

6/30/76

PUBLIC WORKS DEPT:

Date:

BUILDING DEPT:

Signature of building department official

Date:

6-30-76

#12850

PERMIT NO:

3433

PERMIT FEE \$

8.60

RECEIPT

1976 1002.00 - 1/2

CITY OF LAS VEGAS

MUST BE MACHINE VALIDATED

*Berese Kyurkas 11-3-80*

DEPT. of BLDG & SAFETY—CITY of LAS VEGAS, NEVADA

OWNER: D. Spencer ADDRESS 34 Amber Cir DATE 6-25-65  
 GEN. CONT. Arden Bldgs TYPE OF STRUCTURE finish sfd  
 PERMIT NO. 31739 LEGAL DESCRIPTION

BUILDING		MECHANICAL		ELECTRICAL	
LOCATION		PLUMBING CONT.		TEMP. POLE CONT.	
FIREPLACE FTG		PERMIT NO. <u>18169</u>	DATE <u>6-25-65</u>	PERMIT NO.	DATE
FOOTINGS		HEAT & VENT. AC CONT.		INSPECTION	DATE
FOUNDATION WALL		PERMIT NO. <u>12739</u>	DATE <u>6-25-65</u>	ELECTRICAL CONT.	
FLOOR FRAMING		SEWER CONT.		PERMIT NO. <u>19744</u>	DATE <u>6-25-65</u>
SLAB		PERMIT NO.	DATE	FIXTURES CONT.	
CHIMNEY STEEL (FIREPLACE)		ROUGH SOIL		PERMIT NO.	DATE
WALL STEEL		ROUGH WATER		SLAB	
COLUMN STEEL		TOP-OUT		ROUGH	
BEAM STEEL		ROUGH GAS		FINAL ROUGH	
FRAMING		AC ROUGH DUCT		FINAL FIXTURE	
ROOF SHEATHING		REF. ROUGH PIPING		FINAL ELECTRICAL	<u>7/1/65 7/14/65</u>
INTERIOR	EXTERIOR	FINAL PLUMBING		TEMPORARY SERVICE	
DRYWALL		FINAL GAS			
LATHING		FINAL AIR COND.			
PAINTING (SIDING)		FINAL REFRIG.			
SCRATCH		FINAL SEWER			
BROWN		FINAL SEPTIC TANK			
URBAN REDEVELOPMENT APPROVAL					
FINAL BLDG.	DATE <u>7-14-65</u>				

INSPECTOR \_\_\_\_\_ DATE \_\_\_\_\_  
 APPROVED FOR OCCUPANCY METER \_\_\_\_\_  
 PLEASE NOTE REMARKS ON REVERSE SIDE 34 Amber Cir LOG # \_\_\_\_\_ AREA # \_\_\_\_\_ 23.0

DEPARTMENT OF BUILDING & SAFETY  
 CITY OF LAS VEGAS, NEVADA

KARDEX CARD  
 FENCE & RETAINING  
 WALLS

OWNER ED Jablonski ADDRESS 34 Amber Cr. DATE 6-30-76  
 CONTRACTOR Owner PERMIT NO. 3433  
 LOT \_\_\_\_\_ BLOCK \_\_\_\_\_ SUBDIVISION block fence

Fence (wire, wood, etc.)	Walls (masonry, rock, etc.)
Location _____	Location <u>SE 7-6-76</u>
Final Inspection _____	Footing <u>SE 7-6-76</u>
	Wall Steel 1st <u>SE 7-9-76</u> 2d _____ 3d _____
	Final Inspection _____
Retaining Wall (masonry)	Retaining Wall (concrete)
Location _____	Location _____
Footing _____	Footing _____
Wall Steel 1st _____ 2d _____ 3d _____	Wall Steel 1st _____ 2d _____ 3d _____
Bond Beam 1st _____ 2d _____ 3d _____	Final Inspection _____
Final Inspection _____	

23.14 B ADDRESS 34 Amber Cr. LOG NO. \_\_\_\_\_ AREA \_\_\_\_\_

Theresa Quirk 11-3-80

DEPT. of BLDG. & SAFETY - CITY of LAS VEGAS, NEVADA

OWNER Barnette & Assoc ADDRESS 34 Amber Circle DATE 10-2-83  
 GEN CONT Delta Const Corp TYPE OF STRUCTURE SU1  
 PERMIT NO 18696 LEGAL DESCRIPTION Lot 17, Block 2 Twin Lakes Village #11

BUILDING		MECHANICAL		ELECTRICAL	
LOCATION <u>10-9-83</u>	PLUMBING CONT. <u>10-17-83</u>	TEMP POLE CONT.	PERMIT NO.	DATE	
FIREPLACE FTS	PERMIT NO. <u>18457</u>	INSPECTION	DATE		
FOOTINGS <u>10-9-83</u>	HEAT & VENT. AC CONT. <u>10-17-83</u>	ELECTRICAL CONT.	PERMIT NO.	DATE	
FOUNDATION WALL	PERMIT NO. <u>18450</u>	FIXTURES CONT.	PERMIT NO.	DATE	
FLOOR FRAMING	SEWER CONT.	SCAB	PERMIT NO.	DATE	
SLAB <u>10-25-83</u>	PERMIT NO. <u>18451</u>	ROUGH	PERMIT NO.	DATE	
CHIMNEY STEEL (FIREPLACE)	ROUGH SOIL	FINAL ROUGH	PERMIT NO.	DATE	
WALL STEEL	ROUGH WATER	FINAL FIXTURE	PERMIT NO.	DATE	
COLUMN STEEL	TOP-OUT <u>10-17-83</u>	FINAL ELECTRICAL	PERMIT NO.	DATE	
BEAM STEEL	ROUGH GAS	TEMPORARY SERVICE	PERMIT NO.	DATE	
FRAMING	AC ROUGH DUCT	MISCELLANEOUS	PERMIT NO.	DATE	
ROOF SHEATHING <u>11-27-83</u>	RER ROUGH PIPING	GRADING & DRAINAGE	PERMIT NO.	DATE	
DRYWALL <u>11-25-83</u>	FINAL PLUMBING <u>11-27-83</u>	ON-SITE PAVING SPACES	PERMIT NO.	DATE	
LATHING	FINAL GAS	ENG. APPROVAL OF	PERMIT NO.	DATE	
BACKING (SIDING)	FINAL AIR COND.	OFF-SITE IMPROVEMENTS	PERMIT NO.	DATE	
PLASTER <u>11-17-83</u>	FINAL REFRIG.		PERMIT NO.	DATE	
URBAN REDEVELOPMENT APPROVAL	FINAL SEWER		PERMIT NO.	DATE	
FINAL BLDG. DATE	FINAL SEPTIC TANK		PERMIT NO.	DATE	

APPROVED FOR OCCUPANCY METER \_\_\_\_\_ INSPECTOR \_\_\_\_\_ DATE \_\_\_\_\_

PLEASE NOTE REMARKS ON REVERSE SIDE LOG # \_\_\_\_\_ AREA # \_\_\_\_\_ 23.04

34 Amber Circle