

6300 Bourbon Way

L-34 Blk 5 Sub Charleston Height 21 Z:R-1

2. Gatewood April 16, 1980

CITY OF LAS VEGAS, NEVADA

LOG NO. & AREA

CONST. VAL. \$ 650

DEPARTMENT OF PUBLIC SERVICES
DIVISION OF BUILDING & SAFETY

APPLICATION & BUILDING PERMIT - for:
Fence, Wall, Retaining Wall

ADDRESS OF
CONSTRUCTION:

6300 Burbank Way

OWNER:

Patricia Gray

LOT(s)

34

BLOCK

5

SUBDIVISION

Chan Hgts 21

ZONE

R-1

Materials of Construction:

Block ☒

Concrete ☐

Wire ☐

Wood ☐

Other ☒

Iron

Yes No

PLANS: ☐ ☐

CALCS: ☐ ☐

ARCHITECT:

ENGINEER:

CONTRACTOR:

Owner

STATE
LICENSE #

CITY
LICENSE #

TOTAL SQUARE FEET: 260


TOTAL LINEAL FEET: 65'

Remarks:

65' x 4' Block & Iron

CONDITIONS OF THE PERMIT:

- Any type of retaining wall must be engineered by a Civil or Structural Engineer.
- If a home owner takes out the Building Permit and if the owner sublets the work to a Contractor, then the Contractor must take out the permit and pay for it.
- No fence or wall can be built on City property or rights-of-way, but this is not intended to preclude construction within utility easements if utilities will not be damaged or made inaccessible.
- The fence or wall shall not enclose any water meter, light stand, or fire alarm box and shall not come closer than 24" from the nearest fire hydrant outlet.
- Department Inspectors must approve footings before concrete is poured and block wall reinforcing before grouting is done.
- Maximum height of any wall or fence is 6' side and rear yards; 4' maximum in front yard with the vertical surface above the height of 2' - 50% open.
- I must not obstruct required onsite parking space (2 spaces for each dwelling unit) by the erection of this fence or wall.
- By the signing of this application I herewith agree to the requirements outlined above.

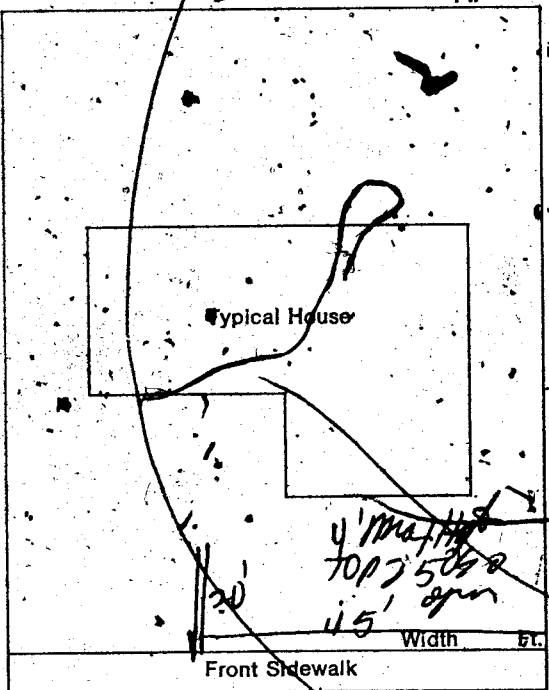

SIGNED:

CONTRACTOR ☒

AGENT ☐

PLANNING DEPT:

PUBLIC WORKS DEPT:

BUILDING DIVISION:

PERMIT NO:

PERMIT FEE \$

BILL \$ 0.00
WALL \$ 11.00
STL \$ 11.00
DATE 4/10/80
OWNER \$ 11.00
CHER \$ 11.00

R#1603 SR#001/01
CITY - BLDG. & SAFETY
04/10/80

MUST BE MACHINE VALIDATED

Theresa Kynakas 2-19-81

FENCE & RETAINING WALLS			
OWNER		DATE	
Patricia Gray		4-10-80	
ADDRESS			
6300 Bourbon Way			
CONTRACTOR		PERMIT NO.	FINAL INSPECTION
Owner		1603	Blk & Iron
LOT	BLOCK	SUBDIVISION	
34	5 Charleson Hgts #21		
E.G.#		AREA	
FENCES (wire, wood, block, & retaining walls)			
1	Location		
	Bm 4-14-P		
2	Footing		
	Bm 4-14-P		
3	Wall Steel		
	1st	2nd	
4	Bond Beam		
	1st	2nd	
5	Final		
	Bm 5-20-P		
Specify Type Of Fence			

Theresa Kynak 2-19-87

DEPT. of BLDG. & SAFETY - CITY of LAS VEGAS, NEVADA		
OWNER: <u>WILLIAM D. MARKS</u>	ADDRESS: <u>6300 BOURBON WAY</u>	DATE: <u>1-16-61</u>
GEN. CONT. <u>SAME</u>		TYPE OF STRUCTURE <u>PICKET FENCE</u>
PERMIT NO. <u>2750</u>	LEGAL DESCRIPTION <u>Lot 34, Blk. 5, Hts. #21</u>	
LOCATION & FLOOR ELEVATION	PLUMBING CONT.	TEMP. POLE CONT.
FOOTINGS	PERMIT NO. _____ DATE _____	PERMIT NO. _____ DATE _____
FOUND & PIERS	HEAT & VENT. CONT.	INSPECTION _____ DATE _____
WALL STEEL	PERMIT NO. _____ DATE _____	ELECTRICAL CONT.
BOND BEAM STEEL	SEWER CONT.	PERMIT NO. _____ DATE _____
	PERMIT NO. _____ DATE _____	OUTLETS
FRAMING & ROOF SHEATHING	ROUGH SOIL	MOTORS _____ H.P.
STEEL FABRICATION	ROUGH WATER	SLAB
CONNECTIONS & PAINTING	SEWER OR SEPTIC TANK	ROUGH
INTERIOR		FINAL ROUGH
EXTERIOR		
LATHING	TOP-OUT	FIXTURE CONT.
PLASTER		PERMIT NO. _____ DATE _____
SCRATCH	ROUGH GAS	FIXTURES
BROWN		
FINAL BLDG	ROUGH DUCT	FINAL FIXTURE
GRADING & DRAINAGE	FINAL PLUMBING	APPROVED FOR METER
ON-SITE PARKING	FINAL HEATING	
SPACES	FINAL GAS	
ENG. APPROVAL OF		
OFF-SITE IMPROVEMENTS		

APPROVED for OCCUPANCY:

Bushy 1-21-62
INSPECTOR

DATE

* PLEASE NOTE REMARKS ON REVERSE SIDE

6300 BOURBON WAY -

PICKET FENCE - 1-16-61

LOG: #

Area: #

28.04

DEPT. of BLDG. & SAFETY - CITY of LAS VEGAS, NEVADA		
OWNER: <u>Sproul Homes, Inc.</u>	ADDRESS: <u>6300 Bourbon Way</u>	DATE: <u>Aug. 24, 1960</u>
GEN. CONT. <u>Sproul Homes, Inc.</u>		TYPE OF STRUCTURE <u>S.F. dwelling</u>
PERMIT NO. <u>1287</u>	LEGAL DESCRIPTION: <u>L. 34, Blk. 5, Charleston Hts. Tr. 21</u>	
LOCATION & FLOOR ELEVATION	PLUMBING CONT.	TEMP. POLE CONT.
FOOTINGS	PERMIT NO. <u>1247</u> DATE <u>7-8-60</u>	PERMIT NO. _____ DATE _____
FOUND & PIERS	HEAT & VENT. CONT. <u>Heating</u>	INSPECTION _____ DATE _____
WALL STEEL	PERMIT NO. <u>1434</u> DATE <u>12-13-60</u>	ELECTRICAL CONT. <u>Wobul</u>
BOND BEAM STEEL	SEWER CONT. <u>Wobul</u>	PERMIT NO. <u>1245</u> DATE <u>7-20-60</u>
	PERMIT NO. <u>1247</u> DATE <u>7-8-60</u>	OUTLETS <u>43</u>
FRAMING & ROOF SHEATHING	ROUGH SOIL <u>London 9-2-60</u>	MOTORS _____ H.P.
STEEL FABRICATION	ROUGH WATER <u>London 9-2-60</u>	SLAB
CONNECTIONS & PAINTING	SEWER OR SEPTIC TANK <u>London 10-7-60</u>	ROUGH <u>Skidil 8-23-60</u>
INTERIOR		FINAL ROUGH
EXTERIOR		
LATHING	TOP-OUT <u>London 9-21-60</u>	FIXTURE CONT. <u>Robert</u>
PLASTER	ROUGH GAS <u>London 9-21-60</u>	PERMIT NO. <u>1245</u> DATE <u>7-20-60</u>
SCRATCH	ROUGH DUCT <u>Sproul 8-20-60</u>	FIXTURES <u>9</u>
BROWN	FINAL PLUMBING <u>London 11-3-60</u>	FINAL FIXTURE
FINAL BLDG	FINAL HEATING <u>London 11-3-60</u>	APPROVED FOR METER <u>Skidil 11-3-60</u>
GRADING & DRAINAGE	FINAL GAS <u>London 11-3-60</u>	
ON-SITE PARKING		
SPACES		
ENG. APPROVAL OF		
OFF-SITE IMPROVEMENTS		

APPROVED for OCCUPANCY:

INSPECTOR

DATE

* PLEASE NOTE REMARKS ON REVERSE SIDE

6300 Bourbon Way S. F. Dwg. 8/24/60

LOG: # T-31 Area: # 4

28.04