

6404 Bamboo Place

LOT 27 BLK 1 JADE PARK #3 ZONE RMH

L. Gatewood 1-18-79

6-10

CITY OF LAS VEGAS, NE

LOG NO. & AREA

CONST. VAL. \$ 987

DEPARTMENT OF PUBLIC SERVICES
DIVISION OF BUILDING & SAFETY

APPLICATION & BUILDING PERMIT - for:
Fence, Wall, Retaining Wall.

ADDRESS OF CONSTRUCTION: 6404 Bamboo Place

OWNER: Home Savings

LOT(s) 27 BLOCK 1 SUBDIVISION Jade Park

ZONE R-MA

Materials of Construction: Block ☒ Concrete ☐ Wire ☐ Wood ☐ Other ☐

Yes No

PLANS: ☐ ☐

CALCS: ☐ ☐

ARCHITECT: ENGINEER: Turegun & Ass.

CONTRACTOR: Anthony & Son Masonary

STATE LICENSE #: 13917


CITY LICENSE #

TOTAL SQUARE FEET: 658 TOTAL LINEAL FEET: 226

Remarks: 120' x 6'
66' x 5'
20' x 4'
20' x 3'

CONDITIONS OF THE PERMIT:

1. Any type of retaining wall must be engineered by a Civil or Structural Engineer.
2. If a home owner takes out the Building Permit and if the owner sublets the work to a Contractor, then the Contractor must take out the permit and pay for it.
3. No fence or wall can be built on City property or rights-of-way, but this is not intended to preclude construction within utility easements if utilities will not be damaged or made inaccessible.
4. The fence or wall shall not enclose any water meter, light standard, or fire alarm box and shall not come closer than 24" from the nearest fire hydrant outlet.
5. Department Inspectors must approve footings before concrete is poured and block wall reinforcing before grouting is done.
6. Maximum height of any wall or fence is 6', side and rear yards; 4' maximum in front yard with the vertical surface above the height of 2' 50% open.
7. I must not obstruct required onsite parking space (2 spaces for each dwelling unit) by the erection of this fence or wall.
8. By the signing of this application I herewith agree to the requirements outlined above.

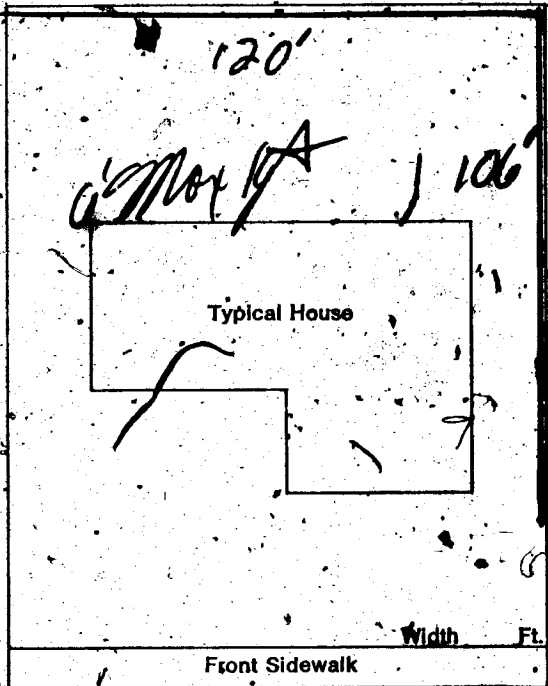

SIGNED: [Signature] DATE: 1-6-78

CONTRACTOR ☒ AGENT ☐ OWNER ☐

PLANNING DEPT: [Signature]

Date: 1-6-78

PUBLIC WORKS DEPT: [Signature]

Date: 1/14/78

BUILDING DIVISION: [Signature]

Date: 1-18-78

#12850

PERMIT NO: 3135-2

PERMIT FEE: 120 +

RECEIPT

MUST BE MACHINE VALIDATED

L. Gatewood 1-18-79

CITY OF LAS VEGAS, NEVADA

LOG NO. & AREA

5-05 T-1

CONST. VAL.

2500

DEPARTMENT OF PUBLIC SERVICES
DIVISION OF BUILDING AND SAFETY

APPLICATION & BUILDING PERMIT - for:
Dwellings, Duplexes, Misc. Residential Const.

ADDRESS OF
CONSTRUCTION:

6404 Bamboo Place

OWNER: HOME SERVICE CORP.

LOT(s)

27

BLOCK

1

SUBDIVISION

JADE PARK #3

ZONE

RMA

Existing structure on lot:

Dwelling ☐

Accessory Bldgs. ☐

Vacant Lot ☒

Other ☐

PROPOSED CONSTRUCTION:

MOBILE HOME ESTATE LOT

USE:

RES

MATERIALS OF CONSTRUCTION:

Wood Frame ☐

Concrete Block ☐

Reinforced Concrete ☐

Steel Frame ☐

SQUARE FEET OF FLOOR AREAS: 1st

2nd

3rd

Other

TOTAL SQ. FT. 6000

FIRE ZONE:

Occupancy Group

CONST. TYPE:

ARCHITECT:

ENGINEER:

TUREGUN & ASSOCIATES

NO. of UNITS

NO. of STORIES

Plans Submitted:

Yes ☒

No ☐

Calculations Submitted

Yes ☐

No ☐

Sewer Fee Req'd.

Yes ☒

No ☐

CONTRACTOR:

SUN HOME BUILDERS, INC.

STATE
LICENSE #

6660

CITY
LICENSE #

CLL 444 2 06059

ADD'L. PERMITS REQ'D.:

Air Cond. ☐

Elec. ☐

Plumbing ☐

Signs ☐

Paving ☐

Fence ☐

Public Walks ☐

Curb-gutters ☐

Incinerators ☐

Fire Sprinkling System ☐

CONDITIONS OF THE PERMIT:

1. I agree to call the City Building Department for inspections before concrete is poured, before rough wiring, electrical, plumbing, framing is covered. Also for Air conditioning, drywall and sheathing inspection.
2. I agree that when the job is completed that I will call for final inspection before occupancy.
3. I agree to perform all construction in accordance with City Ordinances and Building Codes.
4. The Contractor's signature below denotes authority from the owner to sign in his behalf and that the owner is aware of all requirements of this application and permit. Separate permits must be taken out for work outlined above this agreement.
5. I have read and understand the contents of this application and permit; I hereby state that the information I have supplied on this application is true and correct.

Approval for the work under this permit will be given only after refuse and debris have been removed from job site and public right of way.

SIGNED: SUN HOME BUILDERS, INC.


Contractor

BY:

K. R. Bandley

Agent or Owner

K. R. Bandley, Executive Vice President

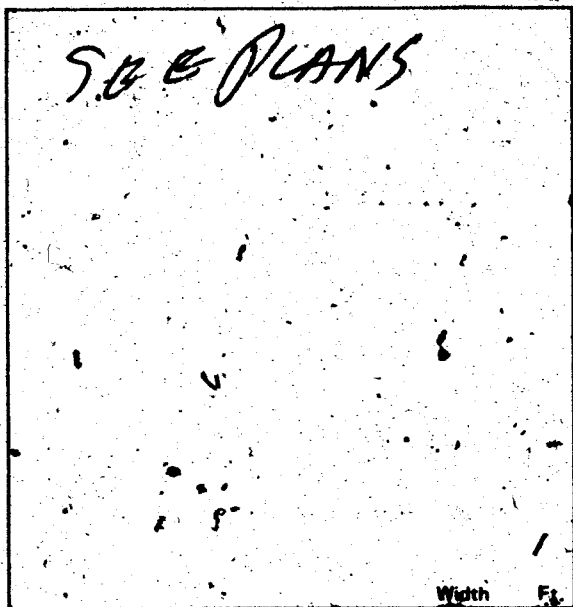

PLANNING DEPT.:

Date:

1-6-78

PUBLIC WORKS DEPT.:

Date:

1/11/78

BUILDING DIVISION:

Date:

1-19-78

PERMIT NO.:

3044-16

PERMIT FEE \$

18. —

154-01-220

RECEIPT

MUST BE MACHINE VALIDATED

D. Gatewood 1-18-79

CITY OF LAS VEGAS, NEVADA

DEPARTMENT OF PUBLIC SERVICES—APPLICATION AND PERMIT FOR PLUMBING DIVISION OF BUILDING AND SAFETY

ADDRESS OF
CONSTRUCTION:

6404 Bamboo Pl

OWNER'S
NAME:

Phyllis Staples

CIRCLE: New Bldg.; Add'n.; Remodel;

TYPE OF BLDG.

SFD

APT.

PUBLIC COMM.

CONTRACTOR'S NAME:

Auerer

STATE
LICENSE #

CITY
LICENSE #

UNITS	DESCRIPTION	FEE	TOTAL
	Bathtub	1.00	
	Shower	1.00	
	Lavatory	1.00	
	Toilet	1.00	
	Urinal	1.00	
	Floor Drain	1.00	
	Floor Sink	1.00	
	Wash Tray	1.00	
	Sink	1.00	
	Garbage Disposal	1.00	
	Garbage Disposal (comm.)	3.00	
	Clothes Dryer (gas)	1.00	
	Clothes Washer	1.00	
	Clothes Washer (comm.)	5.00	
	Dishwasher	1.00	
	Dishwasher (commercial)	5.00	
	Dental Unit	10.00	
	Drinking Fountain	1.00	
	Any Water using Equipment	1.00	
	Water Heater (gas) (elect.)	1.00	
	Sewer System—New, Replacement, or any Drainage System	4.00	
	Grease or Sand Trap	2.00	
	Trailer Trap	2.00	
	Septic Disposal System	4.00	
WATER SOFTENERS			
	Nonpermanent Type	4.00	
	Permanent Type (connected to Drainage)	5.00	
SWIMMING POOLS			
	Private or Wading Pool	10.00	
	Public or Semi-public	20.00	

UNITS	DESCRIPTION	FEE	TOTAL
WATER DISTRIBUTION SYSTEM			
	Single Family Dwelling	4.00	
	Multiple Family Dwelling plus each unit	4.00 2.00	
	Commercial Bldg. per floor	6.00	
	Hotel or Motel plus each bath	4.00 1.50	
	Trailer Park plus each space	20.00 1.00	
	Irrigation	4.00	
GAS PIPING SYSTEM			
	Single Family Dwelling	3.00	35
	Multiple Family Dwelling plus each unit	6.00 1.00	
	Commercial Bldg. per floor plus each unit	3.00 3.00	
	Gas Appliance (any type)	1.00	
AUTOMATIC FIRE EXTINGUISHING SYSTEM			
	Underground Piping	10.00	
	Distribution Piping ea. ft.	.01	
	Sprinkler Head each	.10	
	In Range Hood and Vent	5.00	
DRY STANDPIPE SYSTEM			
	Piping	50.00	
	Each Outlet	1.00	
WET STANDPIPE SYSTEM			
	Piping	5.00	
	Fire Hose Cabinet	1.00	
MINIMUM PERMIT FEE			
PIPELINE CONTRACTOR; SECT. 14-B.P.F. \$		4.00	
TOTAL PERMIT FEE \$		400	

I hereby certify that I have carefully examined and read the above application, that the same is true and correct, and that the work herein described is to be done in accordance with all the provisions of the applicable Ordinances of the City of Las Vegas, Nevada and the State Laws, whether herein specified or not.

Approval for the work under this permit will be given only after refuse and debris have been removed from job site and public right of way.

Signed

Bill Staples

Date:

Building Division:

B.D.

Date: 11-4-78

Permit No.

10897-1

Permit Fee \$

4.00

154-01-222

RECEIPT

MUST BE MACHINE VALIDATED

G. Gatewood 1-18-79

CITY OF LAS VEGAS, NEVADA

DEPARTMENT OF PUBLIC SERVICES - ELECTRICAL APPLICATION & PERMIT DIVISION OF BUILDING AND SAFETY

ADDRESS OF
CONSTRUCTION:

6404 Bambas Rd

OWNER'S
NAME:

Phyllis Staples

CIRCLE: New Bldg; Add'n.; Remodel;

TYPE OF BLDG.: SFD. APT. PUBLIC COMM.

CONTRACTOR'S NAME:

Owner

STATE
LICENSE #

CITY
LICENSE #

NUMBER	FIXTURE OR INSTALLATION	UNIT PRICE	TOTAL
	Rm addition, carport or garage enclosure	4.00	
	Temporary power	4.00	
	Light, receptacle or switch outlet	.20	
	Wall or ceiling space heater	.35	
	Garbage grinder outlet	.35	
	Dishwasher outlet	.35	
	Clothes dryer outlet	.35	
	Automatic clothes washer	.95	
	Electric range outlet	.35	
	Electric water heater outlet	.35	
	Special purpose outlet	.35	
	X-ray unit and its appurtenances	5.00	
	Watts of festoon lighting (Watts) First 3,000 watts for each additional thousand watts	4.00 1.50	
	Horsepower each motor first horsepower or less for each additional horsepower	1.75 .35	
1	Electric service (including any single meter socket) for each additional socket	3.00 .35	3
	Air conditioning service	1.50	
	Each KW(KVA) Generator (Transformer, Welder) First 100 KVA for each additional KW(KVA)	2.00 .01	
	Speaker, signal or alarm outlet	.15	
	Amplifiers	.50	
	Control panels	.25	
	Main control racks	1.00	
	T.V. and radio antennas-master system only	.75	
	Minimum fee for any permit	4.00	
	TOTAL FEE		21.40

Approval for the work under this permit will be given only after refuse and debris have been removed from job site and public right of way.

I hereby certify that I have carefully examined and read the above application; that the same is true and correct; and that the work herein described is to be done in accordance with all the provisions of the applicable Ordinances of the City of Las Vegas, Nevada and State laws whether herein specified or not.

SIGNED

Bill Staples

DATE

MASTER (ELECTRICIAN) (TECHNICIAN) (OWNER)

BUILDING DIVISION:

B.D.

DATE

11-14-78

PERMIT NO.

10897-2

PERMIT FEE

4.00

RECEIPT:

MUST BE MACHINE VALIDATED

G. Gatewood 2-15-79

CITY OF LAS VEGAS, NEVADA

LOG NO. & AREA

CONST. VAL. \$ 555.00

DEPARTMENT OF PUBLIC SERVICES
DIVISION OF BUILDING & SAFETY

APPLICATION & BUILDING PERMIT - for:

Fence, Wall, Retaining Wall.

ADDRESS OF
CONSTRUCTION:

6404 Bamboo Lane

OWNER:

Phillip Sablis

LOT(S)

27

BLOCK

1

SUBDIVISION

SAB PARK # 3

ZONE

RMA

Materials of Construction:

Block ☒

Concrete ☐

Wire ☐

Wood ☐

Other ☐

Yes No

PLANS: ☐ ☒

CALCS: ☐ ☐

ARCHITECT:

Jerry Anthony

ENGINEER:

13917

STATE
LICENSE #

44699

CITY

LICENSE #

14699

CONTRACTOR:

TOTAL SQUARE FEET:

222.00

TOTAL LINEAL FEET:

37'

Remarks:

37' x 6' block

CONDITIONS OF THE PERMIT:

1. Any type of retaining wall must be engineered by a Civil or Structural Engineer.
2. If a home owner takes out the Building Permit and if the owner sublets the work to a Contractor, then the Contractor must take out the permit and pay for it.
3. No fence or wall can be built on City property or rights-of-way, but this is not intended to preclude construction within utility easements if utilities will not be damaged or made inaccessible.
4. The fence or wall shall not enclose any water meter, light standard, or fire alarm box and shall not come closer than 24" from the nearest fire hydrant outlet.
5. Department Inspectors must approve footings before concrete is poured and block wall reinforcing before grouting is done.
6. Maximum height of any wall or fence is 6' and rear yard maximum in front yard with the vertical surface above the height of 2' - 50% open.
7. I must not obstruct required onsite parking spaces (2 spaces for each dwelling unit) by the erection of this fence or wall.
8. By the signing of this application I hereby agree to the requirements outlined above.

INAC \$.00

STL \$ 8.00

TOTL \$ 8.00

CHNG \$ 2.00

TOTAL \$ 10.00

CHNG \$ 2.00

TOTAL \$ 12.00

PLANNING DEPT:

AKR

Date:

2-6-79

PUBLIC WORKS DEPT:

AKR

Date:

2-6-79

BUILDING DIVISION:

BD

Date:

2-6-79

#12850

PERMIT NO:

0806

PERMIT FEE \$

8.00

RECEIPT

MUST BE MACHINE VALIDATED

DEPARTMENT OF BUILDING & SAFETY
CITY OF LAS VEGAS, NEVADA

KARDEX CARD
FENCE & RETAINING
WALLS

OWNER Home Savings ADDRESS 6404 Bamboo Place DATE 1-20-78

CONTRACTOR Anthony & Son Masonry PERMIT NO. 3135-2

LOT BLOCK SUBDIVISION block fence

Fence (wire, wood, etc.)	Walls (masonry, rock, etc.)
Location <u> </u>	Location <u>AP 8-10-78</u>
Final Inspection <u> </u>	Footings <u>RP 8-10-78</u>
	Wall Steel 1st <u> </u> 2d <u> </u> 3d <u> </u>
	Final Inspection <u>9-10-25-78</u>
Retaining Wall (masonry)	Retaining Wall (concrete)
Location <u> </u>	Location <u> </u>
Footings <u> </u>	Footings <u> </u>
Wall Steel 1st <u> </u> 2d <u> </u> 3d <u> </u>	Wall Steel 1st <u> </u> 2d <u> </u> 3d <u> </u>
Bond Beam 1st <u> </u> 2d <u> </u> 3d <u> </u>	Final Inspection <u> </u>
Final Inspection <u> </u>	

23.14 B ADDRESS 6404 Bamboo Place LOG NO. AREA

DIVISION of BUILDING & SAFETY - CITY of LAS VEGAS, NEVADA
OWNER Home Service Corp ADDRESS 6404 Bamboo Place DATE 1-20-78
GEN. CONT. Sun Home Builders TYPE OF STRUCTURE Mobile Home Estates
PERMIT NO. 3044-16 LEGAL DESCRIPTION L 27 B 1 Jade Park # 3

BUILDING	MECHANICAL	ELECTRICAL
Investigation	Plumbing Cont.	Temp. pole cont.
Location & Footing	Permit No. <u> </u> Date <u> </u>	Permit No. <u> </u> Date <u> </u>
Stem Wall	Heat & Vent. A/C Cont.	Inspection <u> </u> Date <u> </u>
Concrete Slab Floor	Permit No. <u> </u> Date <u> </u>	Electrical Cont.
Floor Framing	Sewer Cont. <u>Sun Home Builders</u>	Permit No. <u> </u> Date <u> </u>
Fireplace Footing	Permit No. <u>3043</u> Date <u> </u>	Fixtures Cont.
Chimney Steel	Rough Soil	Permit No. <u> </u> Date <u> </u>
Vert. Steel Reinf.	Rough Water	Slab
Horiz. Steel Reinf.	Top Out	Rough
Roof Sheathing	Rough Gas	Final Rough
Framing	A/C Rough Duct	Final Fixture
Backing for siding	Ref. Rough Piping	Final Electrical
Ext. Lath	Final Plumbing <u>BM 6 22 78</u>	
Ext. Scratch	Final Gas	Temporary Service
Ext. Brown	Final Air Cond.	
Int. Lath	Final Refrig.	MISCELLANEOUS
Int. Brown	Final Sewer	
Drywall	Final Septic Tank	Grading & Drainage
Insulation		On Site Parking Spaces <u> </u> App. <u> </u>
Final Building		Eng. Approval of <u> </u>
Appr. for Occu.		Off Site Improvements <u> </u>

INSPECTOR: E. C. 12. K DATE 7-11-79
APPROVED FOR OCCUPANCY & METER

PLEASE NOTE REMARKS ON REVERSE SIDE 6406 Bamboo Place LOG # AREA # T1-3 76.114

OWNER, PHILLIS STAPLES		ADDRESS 6404 BAMBOO PL	
DATE 11-14-78		GEN. CONT. OWNER	
TYPE OF STRUCTURE MOBILE HOME		PERMIT NO. 1089 FINAL INSPECTION	
LEGAL DESCRIPTION		LOG #	AREA #
APPROVED FOR OCCUPANCY & METER			
BUILDING		MECHANICAL	
Investigation		Plumbing Cont. <i>Owner</i>	
Location & Footing		Permit No. <i>1089-1</i> Date <i>11-14-78</i>	
Concrete Slab Floor		Heat & Vent. A/C Cont.	
Fireplace Footing		Permit No.	Date
Chimney Steel		Sewer Cont.	
Vert. Steel Reinf.		Permit No.	Date
Horiz. Steel Reinf.		Rough Soil	
Framing		Rough Water	
Ext. Lath		Top-Out	
Ext. Brown		Rough Gas	
Drywall		A/C Rough Duct	
Final Building <i>11-16-79</i>		Final Plumbing	
Appr. for Occu.		Final Gas	
ELECTRICAL		Final Air Cond.	
Temp. Pole Cont.		Final Sewer	
Permit No.	Date	REMARKS	
Inspection	Date		
Electrical Cont. <i>Owner</i>			
Permit No. <i>1089-2</i> Date <i>11-14-78</i>			
Rough		PLEASE NOTE ADDITIONAL REMARKS ON REVERSE SIDE.	
Final Rough		DIV. OF BLDG. & SAFETY	
Final Electrical <i>11-15-78</i>		CITY OF LAS VEGAS	
Temporary Service		REV. 10-78	
		2-1-31	

E-Z-WAY SYSTEMS
NEWARK OH 43055
LITHO IN U.S.A.

CITY OF LAS VEGAS, NEVADA

LOG NO. & AREA _____ DATE 12-5-88 CONST. VAL. \$ 1,065

DEPARTMENT OF BUILDING AND SAFETY

BUILDING PERMIT - FOR: Single Family Dwelling, Remodel, Additions, Misc. Residential Construction

PHONE 386-6251
ADDRESS OF CONSTRUCTION 6404 BAMBOO BLVD OWNER STAPLES PHONE NO. _____

LOT(s) 27 BLOCK 1 SUBDIVISION JADE PARK #3 ZONE R-M4

PROPOSED CONSTRUCTION MOBILE HOME USE _____

THIS PERMIT FOR 8679 BLDG. ☐ AC ☐ ELEC. ☐ PLBG. ☐ OTHER PERMITS REQD.: FENCE ☐ OFF SITE ☐ SWIM POOL ☐

FLOOR AREA BSMT _____ 1ST _____ 2ND _____ GARAGE _____ PORCH _____ TOTAL _____

CONTRACTOR ANDY'S MUD SERV STATE LICENSE NO. 0956 CITY LICENSE NO. 27068

ARCHITECT _____ ENGINEER _____

MASTER PLUMBER/CONTRACTOR _____ MASTER ELECTRICIAN/CONTRACTOR _____

OTHER INSPECTIONS AND FEES

1. Inspections outside of normal business hours = \$30.00 per hour (minimum charge three hours).
2. Reinspection fee during normal business hours assessed under provisions of TABLE 3-A of the Uniform Building Code = \$30.00 per hour.
3. Inspections during normal business hours for which no fee is specifically indicated = \$30.00 per hour (minimum charge one half hour).
4. Additional plan review required by changes, additions or revisions to approved plans = \$30.00 per hour (minimum charge two hours).

CONDITIONS OF THE PERMIT:

1. I agree to call the City Building Department for inspections before concrete is poured, before rough wiring, electrical, plumbing, framing is covered. Also for air conditioning, drywall and sheathing inspection.
2. I agree that when the job is completed that I will call for final inspection before occupancy.
3. I agree to perform all construction in accordance with City Ordinances and Building Codes.
4. The Contractor's signature below denotes authority from the owner to sign in his behalf and that the owner is aware of all requirements of this application and permit. Separate permits must be taken out for work outlined above this agreement.
5. I have read and understand the contents of this application and permit; I hereby state that the information I have supplied on this application is true and correct.
6. Approval for the work under this permit will be given only after refuse and debris have been removed from job site and public right of way.
7. 24 HOUR MINIMUM NOTICE REQUIRED FOR INSPECTIONS.

BY: _____ I HEREBY DECLARE THAT I AM THE LEGAL OWNER OF THE ABOVE PROPERTY. OWNER


BY: _____ AGENT

I hereby certify that I have reviewed this application and the proposed plans and have found that the proposed development meets the requirements of the City of Las Vegas Flood Hazard Reduction Ordinance for the issuance of this Development Permit.

LAND DEVELOPMENT AND FLOOD CONTROL ENGINEER

PLANNING DEPT. 12-5-88 DATE

BUILDING DEPT. 12-5-88 DATE

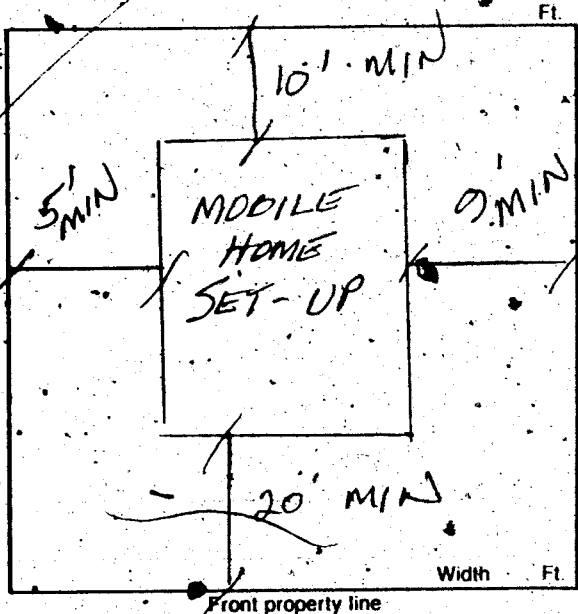

**FOR INSPECTIONS
CALL 799-2071**

PLUMBING		FEE	ELECTRICAL		
WATER DISTRIBUTION	6.00		RECEPTACLE	SWITCH	.40
SEWER SYSTEM - NEW OR MODIFICATION	10.00		EACH LIGHT FIXTURE OR SOCKET		.30
FIXTURES - WATER SOFTENER, H.W. HEATER	2.00		SPECIAL OUTLET, APPLIANCE ETC.		.70
GARBAGE DISPOSAL - WASHER	2.00		SERVICE/PANEL - SUB/3.00 - 200A/6.00 - 400A/12.50		
FUEL PIPING	6.00		A.C. UNIT OR MOTORS		3.00
IRRIGATION SYSTEM	8.00		2310 - 2402	TOTAL	
MISC.			MISC.		
2310 - 2403			2310 - 2401 ISSUANCE-FEE		
TOTAL			7114 - 3854 SEWER CONNECTION		
AIR CONDITIONING		FEE	2310 - 2401 PLAN REVIEW FEE		
NEW UNIT - 3 TON ± 9.00 OVER = 16.50			2310 - 2401 BLDG. PERMIT FEE		58.00
FURNACE TO 100,000/9.00 OVER/11.00			TOTAL FEES		
VAPORATIVE COOLER	6.50				
VENTILATION FAN	2.35				
2310 - 2405					
TOTAL					

RECEIPT
#0008**
SFD 55.00
CHEK 55.00
B670A000 12:50,

PERMIT NO. _____
MUST BE MACHINE VALIDATED

Permit Expires 180 Days After Abandonment of Work

Subdiagram 2-28-89

OWNER Staples		ADDRESS 3404 Bambo Pl.	
DATE 12-5-88		GEN. CONT. Andy's M/H	
BUILD. TYPE M/H		PERMIT No. 8670	
LEGAL		LOG No.	
BUILDING		MECHANICAL	
Pt. Loc. & Ft. ☐		Plumbing Cont.	
Location & Footing ☐		Permit No.	Date
Stemwall ☐		A/C Cont.	
Conc. Slab Floor ☐		Permit No.	Date
Chimney Steel ☐		Sewer Fee	
Fireplace Footing ☐		Irrig. Cont.	
Vert. Steel Reinf. ☐		Permit No.	Date
Horiz. Steel Reinf. ☐		Hood Cont.	
Roof Sheathing		Permit No.	Date
Insulation		Rough Soil ☐	
Framing		Rough Water ☐	
Ext. Lath		Top Out	
Ext. Scratch		Rough Gas	
Ext. Brown		A/C Rough Duct.	
Drywall		Final Plumbing	
Final Building	12/26/88	Final Gas	
Appr. for Occu. Final Building		Final Air Cond.	
ELECTRICAL		Final Sewer	
Electrical Cont.		Rough Hood ☐	
Permit No. /	Date	Final Hood ☐	
PT Rough		Final Irrig.	
Ground Electrode		ELECTRICAL	
Temporary Power		Temp. Pole Cont.	
Meter Tag		Permit No.	Date
Final Electrical		Inspection	Date