

220 Collen

11 Gatewood 9-4-79

CITY OF LAS VEGAS, NEVADA

LOG NO. & AREA

DEPARTMENT OF PUBLIC SERVICES
DIVISION OF BUILDING & SAFETY

APPLICATION & BUILDING PERMIT - for:
Fence, Wall, Retaining Wall.

CONST. VAL. \$ 1250 -

ADDRESS OF
CONSTRUCTION:

220 Colleen Dr.

OWNER:

Rose Butters

LOT(s)

31

BLOCK

7

SUBDIVISION

Charlton Hgts #31-B

ZONE

R-1

Materials of Construction:

Block ☒

Concrete ☐

Wre ☐

Wood ☐

Other ☐

Yes No

PLANS: ☐ ☐

CALCS: ☐ ☒

ARCHITECT:

ENGINEER:

CONTRACTOR:

owner

STATE

LICENSE #

CITY

LICENSE #

TOTAL SQUARE FEET:


TOTAL LINEAL FEET:

Remarks:

CONDITIONS OF THE PERMIT:

1. Any type of retaining wall must be engineered by a Civil or Structural Engineer.
2. If a home owner takes out the Building Permit and if the owner sublets the work to a Contractor, then the Contractor must take out the permit and pay for it.
3. No fence or wall can be built on City property or rights-of-way, but this is not intended to preclude construction within utility easements if utilities will not be damaged or made inaccessible.
4. The fence or wall shall not enclose any water meter, light standard, or fire alarm box and shall not come closer than 24" from the nearest fire hydrant outlet.
5. Department Inspectors must approve footings before concrete is poured and block wall reinforcing before grouting is done.
6. Maximum height of any wall or fence is 6' side and rear yards; 4' maximum in front yard with a vertical surface above the height of 2' - 50% open.
7. I must not obstruct required onsite parking space (2 spaces for each dwelling unit) by the erection of this fence or wall.
8. By the signing of this application I hereby agree to the requirements outlined above.

MIKE \$.00
WALL \$ 15.00
STL \$ 15.00
TOTL \$ 15.00
CHEK \$ 15.00
R#6620 SR#001/01
CITY - LAS VEGAS
BLDG. & SAFETY
08/30/79

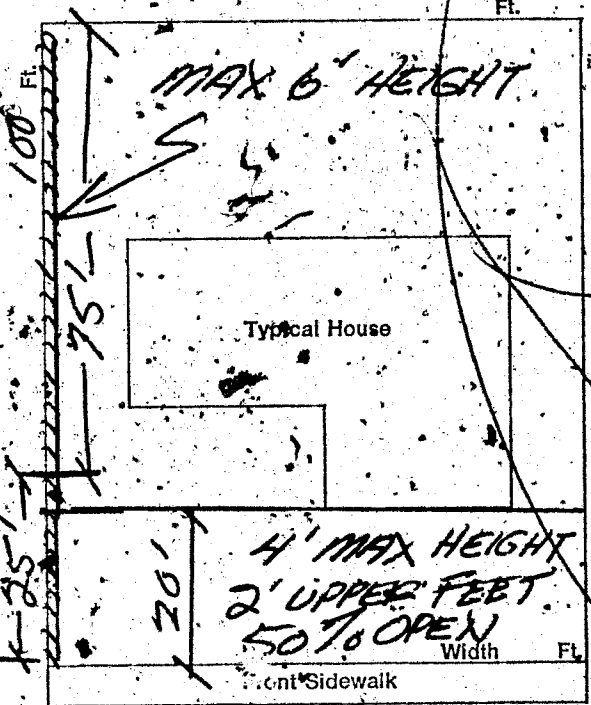

SIGNED:

Rose M. Butters

DATE

CONTRACTOR ☐

AGENT ☐

OWNER ☐

PLANNING DEPT:

J. Kelson

Date:

8/30/79

PUBLIC WORKS DEPT:

JSB

Date:

8-30-79

BUILDING DIVISION:

ma

Date:

8-30-79

#12850

PERMIT NO:

6620

PERMIT FEE \$

15.00

RECEIPT

MUST BE MACHINE VALIDATED

ANGELA L. JACKSON

OWNER, SPROUL HOMES, INC. DEPT. of BLDG. & SAFETY—CITY of LAS VEGAS, NEVADA
GEN. CONT. SAME ADDRESS 220 Colleen Dr. DATE 10-11-61
PERMIT NO. 6354 LEGAL DESCRIPTION Lot 31 Block 7 Chas. Hts. #31-B TYPE OF STRUCTURE S.F. Dw.

LOCATION <u>Fireplace</u> <u>FTG.</u> FOOTINGS <u>10-11-61</u> PILES FOUND <u>10-11-61</u> PIERS FLOOR <u>11-6-61</u> SLAB <u>11-6-61</u> ANCHOR BOLTS <u>11-6-61</u> BASE PLATES WALL STEEL COLUMN STEEL BEAM STEEL FRAMING <u>11-27-61</u> ROOF SHEATHING <u>11-27-61</u> STEEL FABRICATION STEEL CONNECTION INTERIOR LATHING BACKING PLASTER <u>12-11-61</u> FINAL BLDG. <u>12-11-61</u> DATE <u>12-11-61</u> GRADING & DRAINAGE ON-SITE PARKING ENG. APPROVAL OF OFF-SITE IMPROVEMENTS	PLUMBING CONT. <u>10-12-61</u> PERMIT NO. <u>3827</u> DATE <u>10-12-61</u> HEAT & VENT. CONT. <u>10-12-61</u> PERMIT NO. <u>3827</u> DATE <u>10-12-61</u> SEWER CONT. <u>10-12-61</u> PERMIT NO. <u>3827</u> DATE <u>10-12-61</u> ROUGH SOIL <u>10-24-61</u> ROUGH WATER <u>10-24-61</u> TOP-OUT <u>11-29-61</u> ROUGH GAS <u>11-29-61</u> AC ROUGH DUCT <u>11-29-61</u> REF. ROUGH PIPING SEWER <u>12-1-61</u> SEPIC TANK FINAL PLUMBING <u>1-1-62</u> FINAL GAS FINAL HEATING FINAL AIR COND. FINAL REFRIG.	TEMP. POLE CONT. PERMIT NO. <u>4107</u> DATE <u>1-1-62</u> INSPECTION ELECTRICAL CONT. <u>1-1-62</u> PERMIT NO. <u>4107</u> DATE <u>1-1-62</u> OUTLETS <u>44</u> MOTORS <u>H.P.</u> SLAB <u>11-27-61</u> ROUGH <u>11-27-61</u> FINAL ROUGH FIXTURES CONT. PERMIT NO. <u>4107</u> DATE <u>1-1-62</u> FIXTURES FINAL FIXTURE <u>1-1-62</u> URBAN REDEVELOPMENT APPROVAL
--	---	---

APPROVED FOR OCCUPANCY 12-28-61 INSPECTOR 12-28-61 DATE
APPROVED FOR METER 12-28-61
PLEASE NOTE REMARKS ON REVERSE SIDE 220 Colleen Dr. LOG# T-52 AREA# 4 23.04

OWNER L. Voberil DEPT. of BLDG. & SAFETY—CITY of LAS VEGAS, NEVADA
GEN. CONT. SAME ADDRESS 220 Colleen DATE 9-18-63
PERMIT NO. 21655 LEGAL DESCRIPTION Lot 31 Block 7 Chas Hts 31 B TYPE OF STRUCTURE blk fence

BUILDING	MECHANICAL	ELECTRICAL
LOCATION FIREPLACE <u>FTG.</u> FOOTINGS <u>10-3-63</u> FOUNDATION WALL FLOOR FRAMING SLAB CHIMNEY STEEL (FIREPLACE) WALL STEEL COLUMN STEEL BEAM STEEL FRAMING ROOF SHEATHING INTERIOR EXTERIOR DRYWALL LATHING BACKING (SIDING) PLASTER <u>SCRATCH</u> URBAN REDEVELOPMENT APPROVAL FINAL BLDG. <u>DATE</u>	PLUMBING CONT. PERMIT NO. <u>DATE</u> HEAT & VENT. AC CONT. PERMIT NO. <u>DATE</u> SEWER CONT. PERMIT NO. <u>DATE</u> ROUGH SOIL ROUGH WATER TOP-OUT ROUGH GAS AC ROUGH DUCT REF. ROUGH PIPING FINAL PLUMBING FINAL GAS FINAL AIR COND. FINAL REFRIG. FINAL SEWER FINAL SEPTIC TANK	TEMP. POLE CONT. PERMIT NO. <u>DATE</u> INSPECTION ELECTRICAL CONT. PERMIT NO. <u>DATE</u> FIXTURES CONT. PERMIT NO. <u>DATE</u> SLAB ROUGH FINAL ROUGH FINAL FIXTURE FINAL ELECTRICAL TEMPORARY SERVICE MISCELLANEOUS GRADING & DRAINAGE ON-SITE PARKING SPACES <u>APP.</u> ENG. APPROVAL OF OFF-SITE IMPROVEMENTS

APPROVED FOR OCCUPANCY & METER 11-24-63 INSPECTOR 11-24-63 DATE
PLEASE NOTE REMARKS ON REVERSE SIDE LOG# AREA# 23.04

220 Colleen

ANGELA L. JACKSON

FENCE & RETAINING WALLS			
OWNER		DATE	
Rose Butters		8-30-79	
ADDRESS			
220 Colleen Dr.			
CONTRACTOR		PERMIT NO.	FINAL INSPECTION
Owners		6620	Blk wall
LOT	BLOCK	SUBDIVISION	
31	7 Charleston Hgts	#31-B	
LOG #		AREA	
FENCES (wire, wood, block, & retaining walls)			
1	Location		
2	Footing		
3	Wall Stapl		
	1st	2nd	
4	Bond Beam		
	1st	2nd	
5	Final		
	Bm. 5-8-80		
Specify Type Of Fence			
78-2-11 DIV. OF BLDG. & SAFETY CITY OF LAS VEGAS REV. 10-78			