

6320 DAYTON AVE."

L5 B5 Char Hgts 40-B Zone R-1

G. Gatewood 9-2-79

CITY OF LAS VEGAS, NEVADA

LOG NO. & AREA

CONST. VAL. \$

440.00

DEPARTMENT OF BUILDING & SAFETY

APPLICATION & BUILDING PERMIT — for:
Fence, Wall, Retaining Wall.

ADDRESS OF CONSTRUCTION:

6329 Dayton St.

OWNER:

L. Dayton

LOT(S)

5

BLOCK

5

SUBDIVISION

Char. Hgts.

40-B

ZONE:

R-1

Materials of Construction:

Block ☐

Concrete ☐

Wire ☐

Wood ☐

Other ☐

Yes

No

ARCHITECT:

ENGINEER:

CALCS:

CONTRACTOR:

Fencing, Inc.

STATE

LICENSE # 26019

CITY

LICENSE #

100-8

TOTAL SQUARE FEET:


TOTAL LINEAL FEET:

240'

Remarks:

CONDITIONS OF THE PERMIT:

1. Any type of retaining wall must be engineered by a Civil or Structural Engineer.
2. If a home owner takes out the Building Permit and if the owner sublets the work to a Contractor, then the Contractor must take out the permit and pay for it.
3. A fence or wall can be built on City property or rights-of-way, but this is not intended to preclude construction within utility easements if utilities will not be damaged or made inaccessible.
4. The fence or wall shall not enclose any water meter, light standard, or fire alarm box and shall not come closer than 24" from the nearest fire hydrant outlet.
5. Department Inspectors must approve footings before concrete is poured and block wall reinforcing before grouting is done.
6. Maximum height of any wall or fence is 4' side and rear yards; 4' maximum in front yard with the vertical surface above the height of 2' — 50% open and further that fencing within 25' of the intersection of curb faces on corner and through lots is limited to a maximum height of 30".
7. It must not obstruct required onsite parking space (1 space for each dwelling unit) by the erection of this fence or wall.
8. By the signing of this application I herewith agree to the requirements outlined above.

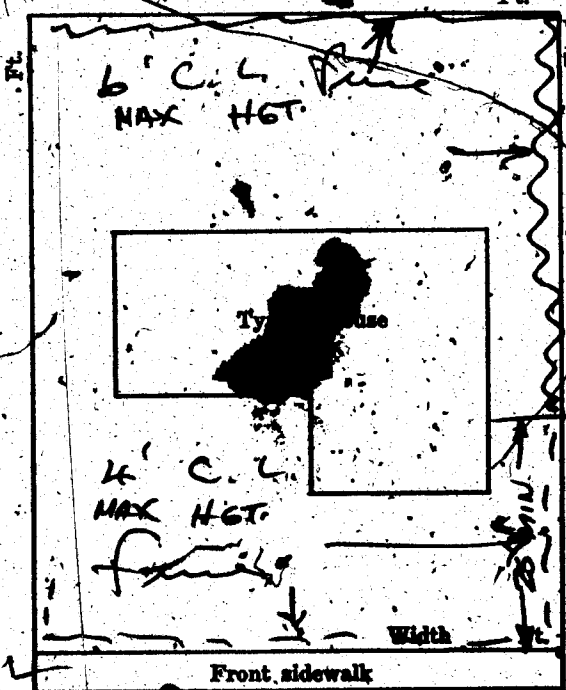

SIGNED:

CONTRACTOR ☐

AGENT ☐

OWNER ☐

DATE:

4-28-69

PLANNING DEPT:

Date:

4-28-69

ENGINEERING DEPT:

Date:

BUILDING DEPT:

Date:

4-28-69

#1285

PERMIT NO:

47274

PERMIT FEE \$

500

RECEIPT

449

\$005.00

8

CITY OF LAS VEGAS

DEPT. OF
BUILDING & SAFETY

MUST BE MACHINE VALIDATED

28 APR 69

DEPARTMENT OF BUILDINGS & SAFETY
CITY OF LAS VEGAS, NEVADA

INDEX CARD
FENCE & RETAINING
WALLS

OWNER L. Dayton

DATE 4/28/61

CONTRACTOR Fending Inc.

PERMIT NO. 47274

LOT 5

BLOCK 1

SUBDIVISION Chaparral Heights

Wire

Fence (wire, wood, etc.)

Walls (masonry, rock, etc.)

Location

Location

Final Inspection 4-29-61

Footings

Wall Steel 1st 2d 3d

Final Inspection

Retaining Wall (masonry)

Retaining Wall (concrete)

Location

Location

Footings

Footings

Wall Steel 1st 2d 3d

Wall Steel 1st 2d 3d

Bond Beam 1st 2d 3d

Final Inspection

Final Inspection

23.14 B.

ADDRESS 6320 Dayton

ZON NO.

AREA

DEPT. of BLDG & SAFETY—CITY of LAS VEGAS, NEVADA

OWNER SPROUL HOMES INC.

ADDRESS 6320 Dayton Ave.

DATE 6-20-62

GEN. CONT. SAME

PERMIT NO. 10885

LEGAL DESCRIPTION

Lot 5 Block 5 Chas. Hts. #40-B

TYPE OF STRUCTURE S.F. Dwl.

BUILDING		MECHANICAL		ELECTRICAL	

APPROVED FOR OCCUPANCY

APPROVED FOR RETER

PLEASE, NOTE REMARKS ON REVERSE SIDE

INSPECTOR

DATE

LOS: #

AREA: #

23.06

6320 Dayton Ave.

T-29