

6324 Clarice Ave

L 22 B 10 Char Hgts Zone R-1

Sharon Levine Feb 18, 1977

CITY OF LAS VEGAS, NEVADA
DEPARTMENT OF BUILDING AND SAFETY
APPLICATION FOR FENCE, WALL OR
RETAINING WALL

LOG NO. 1966

AREA: 1966

KARDEX CARD: 1966

TELEPHONE: 878-0070

CONSTRUCTION

VALUATION: 257°

INSPECTION

VALUATION: 204°

PERMIT FEE: 33807

PERMIT NUMBER: 4

DATE: May 18 1966

ADDRESS OF

CONSTRUCTION: 6324 Claude

OWNER'S

NAME: Sharon Levine

OWNER'S

ADDRESS: Sharon

Lot (s) 22 Block 19 Subdivision Sharon

Zone: R-1

Materials of Concrete

Construction: Block (☒) Concrete (☐) Wire (☐) Wood (☐) Other (☐)

Total Square Feet:

Total Lineal Feet:

CONTRACTOR'S NAME: Quines

STATE

LICENSE #

CITY

LICENSE#

Architect's Name:


PLANS SUBMITTED: Yes ☐ No ☐

Engineer's Name:

CALCULATIONS: Yes ☐ No ☐

Street Name: Claude

Front Yard: Feet

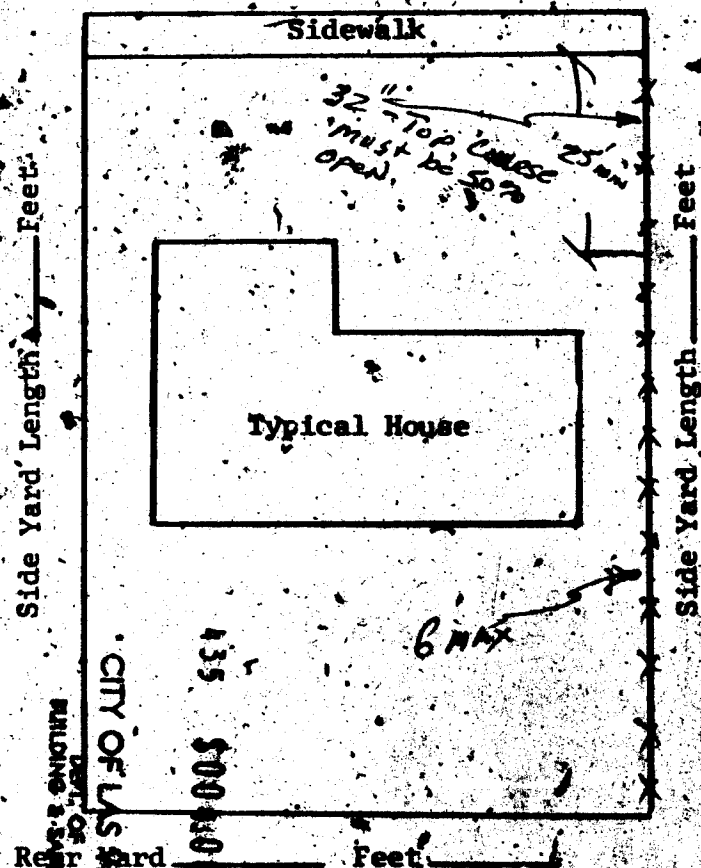

I understand that a portion of this (fence) (wall) constructed or erected on City property or right-of-way will be removed from said location at my expense upon request received from the City of Las Vegas, Nevada. I understand that the (fence) (wall) shall not enclose water meter, light standard, fire alarm box and shall not come closer than two (2') feet in any direction from any fire hydrant. I further state that I am familiar with effective Ordinances of the City of Las Vegas, Nev. and effective Statutes of the State of Nevada covering construction and use of above type; I agree to perform said construction in conformity therewith. I further agree that issuance of a permit on above application will not excuse me from conforming with said Ordinances and Statutes, despite any errors on the part of the Building Inspector or Engineer in checking plans and applications herewith submitted.

I have read and understand the contents of above application; I hereby state that same are true and correct.

SIGN HERE: Kathryn Luff

By

APPROVED BY: 5/18/66

PLANNING DEPT. & CODE ASSISTANCE DATE:

FIRE DEPARTMENT DATE:

ENGINEERING DEPT. DATE:

BUILDING & SAFETY DEPT. DATE:

Note: Owner or Contractor must call for all inspections required.

ANGELA L. JACKSON

DEPARTMENT OF BUILDING & SAFETY
CITY OF LAS VEGAS, NEVADA

KARDEX CARD
FENCE & RETAINING
WALLS

OWNER Elmer Griffith ADDRESS 6324 Clarice DATE 11-12-64

CONTRACTOR John Jones PERMIT NO. 28323

LOT 22 BLOCK 10 SUBDIVISION Charleston Heights

Fence (wire, wood, etc.)	Walls (masonry, rock, etc.)
Location _____	Location _____
Final Inspection <u>11-12-64</u>	Footings _____
	Wall Steel 1st <u>2d</u> 3d _____
	Final Inspection _____
Retaining Wall (masonry)	Retaining Wall (concrete)
Location _____	Location _____
Footings _____	Footings _____
Wall Steel 1st _____ 2d _____ 3d _____	Wall Steel 1st _____ 2d _____ 3d _____
Bond Beam 1st _____ 2d _____ 3d _____	Final Inspection _____
Final Inspection _____	

23.14 B ADDRESS 6324 Clarice Avenue LOG NO. _____ AREA _____

DEPARTMENT OF BUILDING & SAFETY
CITY OF LAS VEGAS, NEVADA

KARDEX CARD
FENCE & RETAINING
WALLS

OWNER Elmer Griffith ADDRESS 6324 Clarice DATE 5/18/66

CONTRACTOR Owner PERMIT NO. 33807

LOT 22 BLOCK 10 SUBDIVISION Chas. Hgts.
Block Fence

Fence (wire, wood, etc.)	Walls (masonry, rock, etc.)
Location _____	Location <u>5-25-66</u>
Final Inspection _____	Footings <u>5-25-66</u>
	Wall Steel 1st <u>2d</u> 3d _____
	Final Inspection <u>5-27-66</u>
Retaining Wall (masonry)	Retaining Wall (concrete)
Location _____	Location _____
Footings _____	Footings _____
Wall Steel 1st _____ 2d _____ 3d _____	Wall Steel 1st _____ 2d _____ 3d _____
Bond Beam 1st _____ 2d _____ 3d _____	Final Inspection _____
Final Inspection _____	

23.14 B ADDRESS 6324 Clarice AREA _____