

1700 E CEDAR AVE.

LOT 1 & 2 BLK 1 BOULDER DAN HOMESITE ADDITION ZONE R-1

L. Gatewood 2-13-79

L. Nelson 382-6446

Deer 9/68
CONST. VAL. \$ 7800

LOG NO. & AREA R-43/2 CITY OF LAS VEGAS, NEVADA
DEPARTMENT OF BUILDING & SAFETY

APPLICATION & BUILDING PERMIT — for:
Dwellings, Duplexes, Multi-Residential Const.

ADDRESS OF CONSTRUCTION: 1700 E. CEDAR AVE OWNER: HENRY E. & MAE RILLING

LOT(S) 1 AND 2 BLOCK 1 SUBDIVISION BOULDER DAM HOMESITE APP. ZONE: R-1

Existing structure on lot: Dwelling ☐ Accessory bldg. ☐ Vacant lot ☒ Other ☐

PROPOSED CONSTRUCTION: 2 BR. RESIDENCE USE: HOME

MATERIALS OF CONSTRUCTION: Wood Frame ☒ Concrete Block ☐ Reinforced Concrete ☐ Steel Frame ☐

SQUARE FEET OF FLOOR AREAS: 1st 780 2nd _____ 3rd _____ Other _____ TOTAL SQ. FT. 780


FIRE ZONE: 1 2 3 Occupancy Group A B C D E F G H I J-1-2-3-4-5 CONST. TYPE: I II III IV V

ARCHITECT: FARNSWORTH ENGINEER: L NO. of UNITS 1 NO. of STORIES 1

Plans Submitted: Yes ☒ No ☐ Calculations Submitted: Yes ☐ No ☒ Sewer Fee Req'd: Yes ☒ No ☐

CONTRACTOR: SECURITY HOUSING CORP. STATE LICENSE # 5863B CITY LICENSE # C11-180-2-9865

ADDL. PERMITS REQ'D: Air Cond. ☐ Elec. ☐ Plumbing ☐ Signs ☐ Paving ☐ Fence ☐ Public Walks ☐ Curb-gutters ☐
Incinerators ☐ Fire Sprinkling System ☐

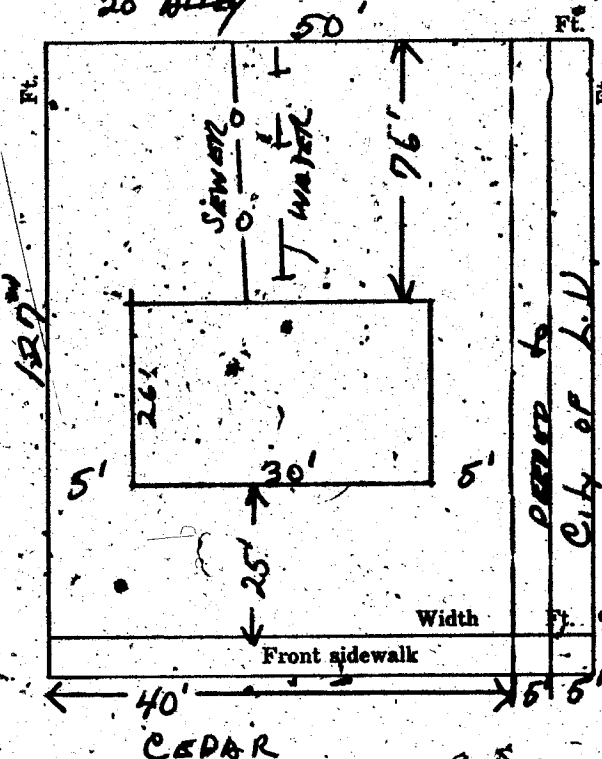

CONDITIONS OF THE PERMIT:

1. I agree to call the City Building Department for inspections before concrete is poured, before rough wiring, electrical, plumbing, framing is covered. Also for Air conditioning, sheet-rock and sheathing inspection.
2. I agree that when the job is completed that I will call for final inspection before occupancy.
3. I agree to perform all construction in accordance with City Ordinances and Building Codes.
4. The Contractor's signature below denotes authority from the owner to sign in his behalf and that the owner is aware of all requirements of this application and permit. Separate permits must be taken out for work outlined above this agreement.
5. I have read and understand the contents of this application and permit; I hereby state that the information I have supplied on this application is true and correct.

SIGNED: Security Housing Corp Contractor

BY: L. Nelson Agent or Owner

CLARK COUNTY HEALTH DEPT. Date _____

LAS VEGAS FIRE DEPARTMENT Date _____

RECEIPT

923 5045.00 - 8

CITY OF LAS VEGAS

DEPT. OF BUILDING & SAFETY
MUST BE MACHINE VALIDATED

PLANNING DEPT: [Signature] Date: 6-10-68

ENGINEERING DEPT: [Signature] Date: 6-12-68

BUILDING DEPT: [Signature] Date: 6-12-68

#1285 PERMIT NO: 43238 PERMIT FEE: 45.00

L. Gatewood 2-13-79

CITY OF LAS VEGAS, NEVADA
DEPARTMENT OF BUILDING & SAFETY

SEWER CONNECTION FEE: \$ 150⁰⁰

RECEIPT
for
SEWER CONNECTION FEE

JOB ADDRESS: 1700 E. Cedar OWNER'S NAME: Terry Billing

LOT _____ BLOCK _____ SUBDIVISION _____

QUANTITY	OCCUPANCY	UNIT FEE	AMOUNT
1	S.F. Dwelling	150 ⁰⁰	150 ⁰⁰

TOTAL 150⁰⁰
Less Credit* _____
TOTAL FEE \$ 150⁰⁰

*Credit for existing sewer is applied to the new sewer connection fee based on previous type of occupancy and only when the new occupancy requires an additional fee.

This receipt does not authorize the owner or his representative to start any work without obtaining a plumbing permit.

G. Weir 6-12-61
DEPARTMENT OF BUILDING & SAFETY DATE

Receipt
924 1500.00 - 3
CITY OF LAS VEGAS
DEPT. OF
BUILDING & SAFETY
Must be validated

73102

RECEIPT NO. 44138 FEE 150⁰⁰

L. Gatewood 2-13-79

INSPECT. *Sanitation & sound plumbing*

CITY OF LAS VEGAS, NEVADA
DEPARTMENT OF BUILDING & SAFETY

PERMIT FEE \$
APPLICATION & PERMIT FOR

JOB ADDRESS: 1700 E. CEDAR

OWNER'S NAME: HENRY RILLING

PLUMBING

LOT BLOCK SUBDIVISION

Bldg. type: SFD ☒ APT ☐ COMM ☐

Circle: ☒ New bldg; ☐ Old bldg; Add'n; Remodel; Pool; Wtr. Sftner; Lawn Sprkr; Other

CONTRACTOR: VEGAS PLUMBING State Lic. # 5813C City Lic. # 8413

QUANTITY	FIXTURE OR INSTALLATION	Unit Price	AMOUNT
1	Bathtub	1.00	1.00
	Clothes dryer (gas)	1.00	
	Clothes washer	1.00	
	Dental unit	1.00	
	Dishwasher	1.00	
	Drinking fountain	1.00	
	Fire sprinkling - underground piping	5.00	
	Fire sprinkling - distribution piping per each foot	.01	
	Fire sprinkling heads - per each head	.10	
	Floor drain \$1.00 Floor sink	1.00	
	Gas appliance (any type)	1.00	
	Gas piping system - single family dwelling	3.00	
	Gas piping system - multiple family \$3 per each unit plus	1.00	
	Gas piping system - commercial bldg. per each floor	3.00	
	Grease trap	1.00	
	Irrigation system	4.00	
1	Lavatory	1.00	1.00
	Minimum fee for any permit	4.00	
✓	Piping, Drainage	4.00	4.00
	Sewer replacement	4.00	
	Septic disposal system - Health Dept. approval required	4.00	
1	Shower	1.00	1.00
1	Sink - kitchen type	1.00	1.00
	Swimming pool - private - wading pool	8.00	
	Swimming pool - public - semi-public	12.00	
1	Toilet	1.00	1.00
	Urinal	1.00	
✓	Water distribution system, single family dwelling	4.00	4.00
	Water distribution system multiple dwg. \$4 + each unit	1.00	
	Water distribution system, Group "A" thru "G" per each floor	4.00	
	Water distribution system, Group "H" (hotel) \$4 + per bath*	.50	
1	Water heater (gas) (electric)	1.00	1.00
	Water using equipment	1.00	
	Water softener nonpermanent type	4.00	
	Water softener permanent (connected to drainage)	5.00	
	Wash tray	1.00	

I hereby certify that I have carefully examined & read the above application; that the same is true & correct; and the work herein described is to be done in accordance with the provisions of City of Las Vegas Ordinances & State Laws, whether herein specified or not. * As defined in City Code and Ordinances.

SIGNED: [Signature] Date: 6-21-81
Registered Plumber Spec. Cont'r, Owner

Engineering Dept. Date

Building Department Date

Sewer Conn. Fees

Paid in Engr. Dept.

PERMIT NO. 24203 PERMIT FEE \$ 14.00

TOTAL FEE \$ 14.00

RECEIPT

1246 \$014.00 - 7

CITY OF LAS VEGAS
DEPT. OF
BUILDING & SAFETY

Must be machine validated

L. Gatewood 2-13-79

CITY OF LAS VEGAS, NEVADA

DEPARTMENT OF BUILDING & SAFETY - ELECTRICAL APPLICATION & PERMIT

ADDRESS OF
CONSTRUCTION:

1700 E. Cedar Ave

OWNER'S
NAME:

Henry Kelling

LOT(S)

BLOCK

SUBDIVISION

Type of bldg.

SFD ☐

Apt. ☐

Comm. ☐

Check Proper Construction:

New Bldg. ☐

Addn. ☐

Remodel ☐

Temporary Pole ☐

Old Bldg. ☒

CONTRACTOR'S NAME:

Roberto Electric

STATE

LICENSE #

5148

CITY

LICENSE #

3392

NUMBER	FIXTURE OR INSTALLATION	UNIT PRICE	
7	Fixture or sockets	.15	105
26	Light receptacle or switch outlet	.20	520
	Wall or ceiling space heater	.35	
	Blast coil heater per kilowatt	.35	
	Garbage grinder outlet	.35	
	Dishwasher outlet	.35	
	Clothes dryer outlet	.35	
	Automatic clothes washer	.35	
1	Electric range outlet	.35	35
1	Electric water heater outlet	.35	35
	Mercury arc lamp and equipment	.35	
	Special purpose outlet	.35	
	X-ray unit and its appurtenances	5.00	
	Watts of festoon lighting (Watts) First 3,000 watts	4.00	
	for each additional thousand watts	1.50	
	Horsepower - all motors first horsepower or less	1.75	
	for each additional horsepower	.35	
	Temporary power and lights (temporary pole)	4.00	
✓	Electric service (including any single meter socket)	3.00	
	for each additional socket	.35	200
	Air conditioning service amps	1.50	
	Each KW (KVA) Generator (Transformer) (Welder) KW (KVA)	2.00	
	First 100 KVA - For each additional KW (KVA)	.01	
	Special inspection per hour	4.00	
	Speaker outlets	.15	
	Signal or Alarm outlets	.15	
	Amplifiers	.50	
	Control panels	.25	
	T. V. outlets - master system only	.15	
	Radio outlets	.15	
	Main control racks	1.00	
	T. V. and Radio antennas - master system only	.75	
	Minimum fee for any permit	4.00	
	Total fee		995

I hereby certify that I have carefully examined and read the above application; that the same is true and correct; and that the work herein described is to be done in accordance with all the provisions of the applicable Ordinances of the City of Las Vegas, Nevada and State laws whether herein specified or not.

SIGNED

MASTER (ELECTRICIAN) (TECHNICIAN) (OWNER)

Date

6/25/68

BUILDING DEPARTMENT

J. W. W. W.

Date

6-25/68

#12860

PERMIT NO.

45757

PERMIT FEE

9.95

RECEIPT

1404 \$809.95 - 6

CITY OF LAS VEGAS

DEPT. OF BUILDING & SAFETY

MUST BE MACHINE VALIDATED

25 JUN 68

L. Gatewood 2-13-79

CITY OF LAS VEGAS, NEVADA
DEPT. OF PUBLIC SERVICES

LOG NO. & AREA: _____
DIVISION OF BUILDING & SAFETY
PHONE: 386-6251

CONST. VAL. 3,800.00
APPLICATION & BUILDING PERMIT - for:
Dwellings, Duplexes, Misc. Residential Const.

ADDRESS OF CONSTRUCTION: 1700 Cedar

OWNER: MR. H. RILLING

LOT(s) 1, 2 BLOCK 1 SUBDIVISION BOULDER HILL LUMESIDE ADD. 2 ZONE: R1

Existing structure on lot: Dwelling ☐ Accessory bldgs. ☐ Vacant lot ☐ Other ☐

PROPOSED CONSTRUCTION: Room ADDN USE: Sun room

MATERIALS OF CONSTRUCTION: Wood Frame ☐ Concrete Block ☐ Reinforced Concrete ☐ Steel Frame ☐

SQ. FEET OF FLOOR AREAS: 1st _____ 2nd _____ 3rd _____ Other _____ TOTAL SQ. FT. 300


FIRE ZONE: _____ Occupancy Group _____

CONST. TYPE: _____

ARCHITECT: _____ ENGINEER: _____ NO. of UNITS _____ NO. of STORIES _____

Plans Submitted: Yes ☐ No ☐ Calculations Submitted: Yes ☐ No ☐ Sewer Fee Req'd: Yes ☐ No ☐

CONTRACTOR: Owner STATE LICENSE # _____ CITY LICENSE # _____
ADD'L. PERMITS REQ'D: Air Cond. ☐ Elec. ☐ Plumbing ☐ Signs ☐ Paving ☐ Fence ☐ Public Walks ☐ Curb-gutters ☐
Incinerators ☐ Fire Sprinkling System ☐

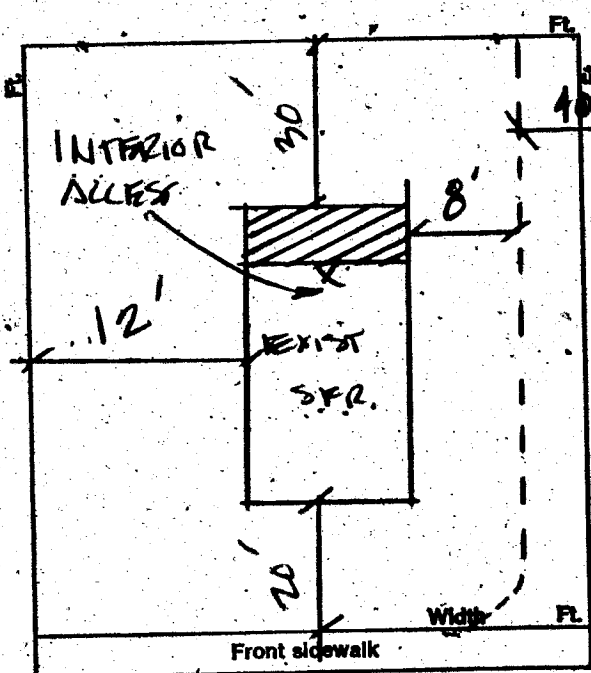

CONDITIONS OF THE PERMIT:

- I agree to call the City Building Department for inspections before concrete is poured, before rough wiring, electrical, plumbing, framing is covered. Also for air conditioning, sheet-rock and sheathing inspection.
 - I agree that when the job is completed that I will call for final inspection before occupancy.
 - I agree to perform all construction in accordance with City Ordinances and Building Codes.
- The Contractor's signature below denotes authority from the owner to sign in his behalf and that the owner is aware of all requirements of this application, and permit. Separate permits must be taken out for work outlined above this agreement.
- I have read and understand the contents of this application and permit; I hereby state that the information I have supplied on this application is true and correct.

SIGNED: _____ Contractor
BY: H. Rilling Agent or Owner

CLARK COUNTY HEALTH DEPT. _____ Date _____

LAS VEGAS FIRE DEPARTMENT _____ Date _____

PLANNING DEPT. _____ Date: 3/20/77

PUBLIC WORKS DEPT. _____ Date: _____

BUILDING DEPT. nm Date: 3-28-77

PERMIT NO.: 1658 PERMIT FEE \$ 18.00

154-01-220
76-11-14

CITY OF LAS VEGAS
DEPT. OF PUBLIC SERVICES
BUILDING & SAFETY

MUST BE MACHINE VALIDATED

L. Gatewood 2-13-79

CITY OF LAS VEGAS, NEVADA

DIVISION OF BUILDING & SAFETY - ELECTRICAL APPLICATION & PERMIT

ADDRESS OF
CONSTRUCTION:

1700 Cedar

OWNER'S
NAME:

Mr. H. Rilling

CIRCLE: New Bldg.; Add'n.; Remodel; TYPE OF BLDG.: SFD. APT. PUBLIC COMM.

CONTRACTOR'S NAME:

OWNER

STATE
LICENSE #

CITY
LICENSE #

NUMBER	FIXTURE OR INSTALLATION	UNIT PRICE	TOTAL
1	Rm addition, carport or garage enclosure	4.00	
	Temporary power	4.00	
	Light, receptacle or switch outlet	.20	
	Wall or ceiling space heater	.35	
	Garbage grinder outlet	.35	
	Dishwasher outlet	.35	
	Clothes dryer outlet	.35	
	Automatic clothes washer	.35	
	Electric range outlet	.35	
	Electric water heater outlet	.35	
	Special purpose outlet	.35	
	X-ray unit and its appurtenances	5.00	
	Watts of festoon lighting (Watts) First 3,000 watts for each additional thousand watts	4.00 1.50	
	Horsepower each motor first horsepower or less for each additional horsepower	1.75 .35	
	Electric service (including any single meter socket) for each additional socket	3.00 .35	
	Air conditioning service	1.50	
	Each KW(KVA) Generator (Transformer, Welder) First 100 KVA for each additional KW(KVA)	2.00 .01	
	Speaker, signal or alarm outlet	.15	
	Amplifiers	.50	
	Control panels	.25	
	Main control racks	1.00	
	T.V. and radio antennas-master system only	.75	
	Minimum fee for any permit	4.00	
	TOTAL FEE		

Approval for the work under this permit will be given only after refuse and debris have been removed from job site and public right of way.

I hereby certify that I have carefully examined and read the above application; that the same is true and correct; and that the work herein described is to be done in accordance with all the provisions of the applicable Ordinances of the City of Las Vegas, Nevada and State laws whether herein specified or not.

SIGNED

MASTER (ELECTRICIAN) (TECHNICIAN) (OWNER)

DATE

3/29/77

BUILDING DEPARTMENT

DATE

3-29-77

10-14

01-221 PERMIT NO.

811

702

7632 RECEIVED 3007.00 - 6

CITY OF LAS VEGAS
DIVISION OF BUILDING & SAFETY

DEPT. of BLDG & SAFETY - CITY of LAS VEGAS, NEVADA
OWNER Henry Rilling ADDRESS 1700 E. Cedar DATE 6/12/68
GEN. CONT. Security Housing TYPE OF STRUCTURE SFD
PERMIT NO. 43238 LEGAL DESCRIPTION L 1 & 2 B 1 Boulder Dam Homesite

BUILDING	MECHANICAL	ELECTRICAL


PLEASE NOTE REMARKS ON REVERSE SIDE 1700 E. Cedar Ave.

LOG # R-43 AREA # 2 23.04

DIVISION of BUILDING & SAFETY - CITY of LAS VEGAS, NEVADA
OWNER Mr. H. Rilling ADDRESS 1700 Cedar DATE 3-29-77
GEN. CONT. Owner 1658 TYPE OF STRUCTURE Room addn
PERMIT NO. LEGAL DESCRIPTION L 1,2 B 1 Boulder Dam Homestie

BUILDING	MECHANICAL	ELECTRICAL
Investigation	Plumbing Cont.	Temp. pole cont.
Location & Footing 29 4-15-77	Permit No. Date	Permit No. Date
Stem Wall	Heat & Vent. A/C Cont.	Inspection Date
Concrete Slab Floor 29 4-15-77	Permit No. Date	ELECTRICAL CONT. Owner
Floor Framing	SEWER CONT.	Permit No. 811 Date
Fireplace Footing	Permit No. Date	Fixtures Cont.
Chimney Steel	ROUGH SOIL	Permit No. Date
Vert. Steel Reinf.	ROUGH WATER	Slab
Horiz. Steel Reinf.	TOP-OUT	ROUGH 29 4-15-77
Roof Sheathing 29 4-15-77	ROUGH GAS	FINAL ROUGH
Framing 29 4-15-77	A/C ROUGH DUCT	FINAL FIXTURE
Backing for siding	REF. ROUGH PIPING	FINAL ELECTRICAL 29 4-15-77
Ext. Lath	FINAL PLUMBING	TEMPORARY SERVICE
Ext. Scratch	FINAL GAS	MISCELLANEOUS
Ext. Brown	FINAL AIR COND.	GRADING & DRAINAGE
Int. Lath	FINAL REFRIG.	ON-SITE PARKING SPACES APP.
Int. Brown	FINAL SEWER	ENG. APPROVAL OF
Drywall 29 4-15-77	FINAL SEPTIC TANK	OFF-SITE IMPROVEMENTS
Insulation 29 4-15-77		
Final Building		
Appr for Occu		

INSPECTOR:

DATE

APPROVED FOR OCCUPANCY & METER:

PLEASE NOTE REMARKS ON REVERSE SIDE 1700 Cedar

LOG #

AREA #

76.11.4