

1536 W Charleston

Rec'd - Tolson

MAYOR BILL BRIARE

COMMISSIONERS
RON L. BIE
PAUL J. CHRISTENSEN
ROY WOOFER
AL LEVY

CITY ATTORNEY
GEORGE F. OGILVIE

CITY MANAGER
RUSSELL DORN



CITY of LAS VEGAS

March 31, 1981

Karvel Rose
NIC
P.O. Box 42729
Las Vegas, Nevada 89104

Re: Z-6-80
EXTENSION OF TIME

Dear Mr. Rose:

The Board of City Commissioners at a regular meeting held March 4, 1981, APPROVED your request for an Extension of Time on property located at 1536 W. Charleston Boulevard, R-E zone (under Resolution of Intent to P-R), subject to the following conditions:

1. Conformance to the requirements of all ordinances enacted subsequent to the zoning approval.
2. Extension of Time shall be limited to two years.

Sincerely,

Carol Ann Hawley

CAROL ANN HAWLEY
City Clerk

CAH:mpk

cc: Dept. of Community Planning & Development
Dept. of Public Services
Dept. of Building & Safety
Dept. of Fire Services



Not issued as of 7-1-82

MAYOR BILL BRIARE

COMMISSIONERS
PAUL J. CHRISTENSEN
RON LURIE
MYRON E. LEAVITT
ROY WOOFER

CITY ATTORNEY
CARL E. LOVELL, JR.

CITY MANAGER
WILLIAM E. ADAMS, P.E.



CITY of LAS VEGAS



DEPARTMENT BUILDING & SAFETY
BUILDING INSPECTION REPORT OF REQUIREMENTS FOR COMPLIANCE WITH CITY OF LAS VEGAS
BUILDING CODES AND ZONING ORDINANCE

ADDRESS 1536 W. Charleston

OWNER N.I.C.

DATE Feb 20, 1980

PERMITS REQUIRED

BLDG. ☐ None

ELEC. ☐ None

PLBG. ☐ None

A.C. ☐ None

CORRECTIONS TO BE MADE


BLDG. None

ELEC. None

PLBG. None

A.C. None

MISC. None

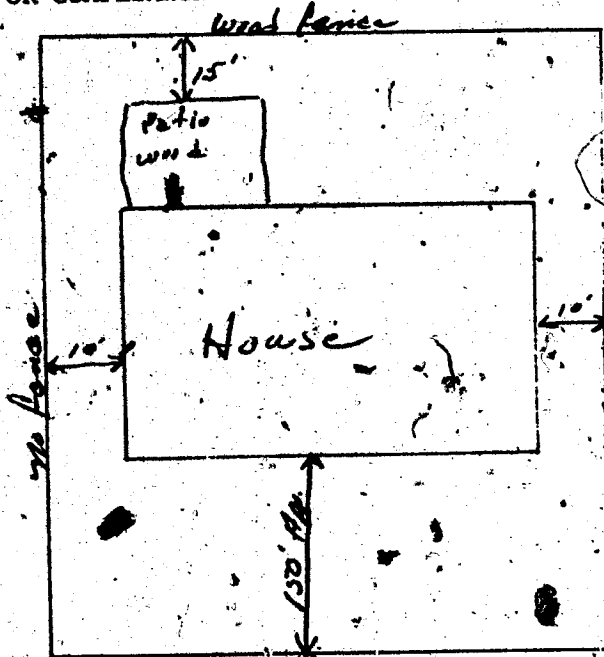

CERTIFICATE OF INSPECTION

APPROVED yes DATE 2-20-80

☐ NOT APPROVED CALL FOR
REINSPECTION.
386 6251

REMARKS This house does not have a stove in Kitchen Area. No Bed rooms. House was certified for P R Zone

BLDG. INSPECTOR L. Clark