

3608 Chevy Chase

LOT 78 BLK 6 WASHINGTON SQUARE UNIT # 1 ZONE R-1

2. Gatewood 2-21-79

CITY OF LAS VEGAS, NEVADA
DEPARTMENT OF BUILDING AND SAFETY
APPLICATION AND PERMIT FOR FENCE,
WALL OR RETAINING WALL

LOG NO. _____
AREA: _____
KARDEX CARD: _____
TELEPHONE: _____

CONSTRUCTION
VALUATION: 76.00
INSPECTION
VALUATION: 60.00
PERMIT FEE: 3.00
PERMIT NUMBER: 34100
DATE: 6-13 1966


ADDRESS OF 3608 OWNER'S
CONSTRUCTION: Cherry Chase NAME: NEV 5495 ADDRESS 3608 Chase

Lot (s) 78 Block 6 Subdivision WASHINGTON Sp. #1 Zone R-1
Materials of Concrete
Construction: Block () Concrete () Wire () Wood (x) Other ()

Total Square Feet: _____ Total Linear Feet 60
CONTRACTOR'S NAME: American Fence STATE LICENSE # 8581 CITY 7954 LICENSE # _____

Architect's Name: _____ PLANS SUBMITTED: Yes _____ No _____
Engineer's Name: _____ CALCULATIONS: Yes _____ No _____

Street Name: _____
Front Yard: _____ Feet

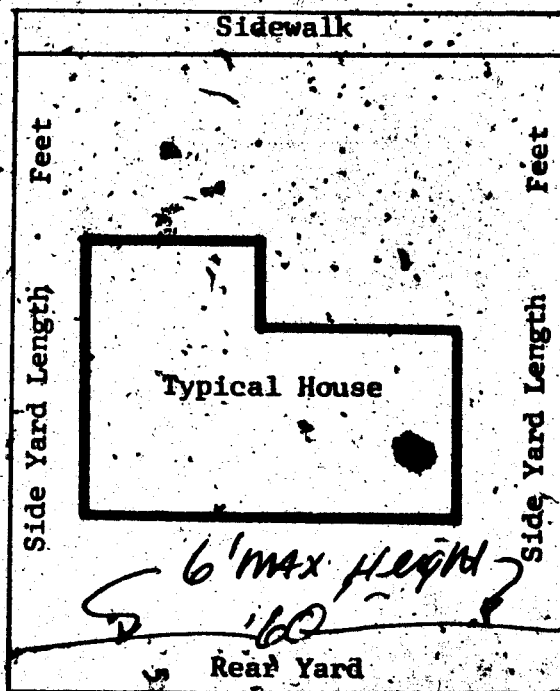

I understand that any portion of this (fence) (wall) constructed or erected on City property or right-of-way will be removed from said location at my expense upon request received from the City of Las Vegas, Nevada. I understand that the (fence), (wall) shall not enclose water meter, light standard, fire alarm box and shall not come closer than two (2') feet in any direction from any fire hydrant. I further state that I am familiar with effective Ordinances of the City of Las Vegas, Nev. and effective Statutes of the State of Nevada covering construction and use of the above type. I agree to perform said construction in conformity therewith. I further agree that issuance of a permit on above application will not excuse me from conforming with said Ordinances and Statutes, despite any errors on the part of the Building Inspector or Engineer in checking plans and applications herewith submitted.

I have read and understand the contents of above application; I hereby state that same are true and correct.

SIGN HERE: _____
By: _____

APPROVED BY: 6/14/66
PLANNING DEPT. & CODE ASSISTANCE DATE

FIRE DEPARTMENT DATE

ENGINEERING DEPARTMENT DATE

BUILDING & SAFETY DEPARTMENT DATE

6-12-66 P. 34100 F-3

CITY OF LAS VEGAS
DEPT. OF BUILDING & SAFETY
23. 1966

FENCE PERMIT ONLY

S. Gatewood 2-21-79

CITY OF LAS VEGAS, NEVADA
DEPARTMENT OF BUILDING & SAFETY
APPLICATION & BUILDING PERMIT
for FENCE, WALL, RETAINING WALL

CONSTRUCTION
VALUATION: \$ 100.00
INSPECTION
VALUATION: \$

ADDRESS OF 3608 OWNER'S 3608
CONSTRUCTION: CHEVY CHASE NAME NEVADA SVCS & LOAN ADDRESS: CHEVY CHASE

Lot (s) 78 Block 6 Subdivision Washington Sq Unit #1 Zone R-1

Materials of Concrete
Construction: Block (☒) Concrete (☐) Wire (☐) Wood (☐) Other (☐)

Total Square Feet: 80

Total Lineal Feet 80


CONTRACTOR'S NAME: AMERICAN FENCE

STATE 8581 CITY 7954
LICENSE # 8581 LICENSE # 7954

Architect's Name: _____

PLANS SUBMITTED: Yes ☐ No ☐
CALCULATIONS: Yes ☐ No ☐

Engineer's Name: _____

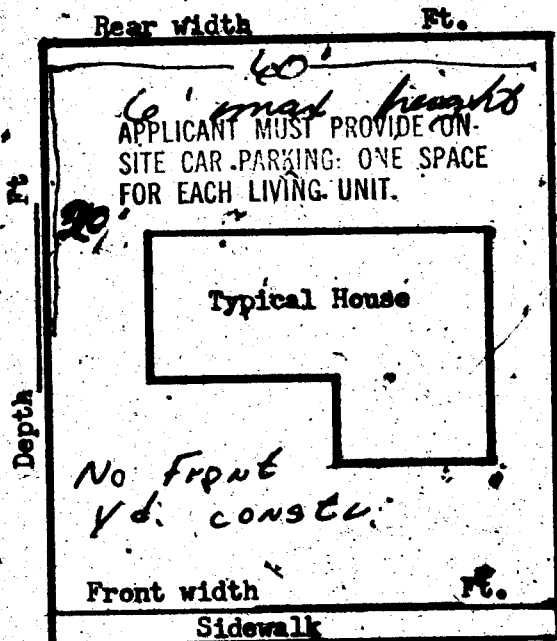

I understand that any portion of this (fence) (wall) constructed or erected on City property or right-of-way will be removed from said location at my expense upon request received from the City of Las Vegas, Nevada. I understand that the (fence) (wall) shall not enclose water meter, light standard, fire alarm box & shall not come closer than two (2') feet in any direction from any fire hydrant. I further state that I am familiar with effective Ordinances of the City of Las Vegas, Nevada & effective Statutes of the State of Nevada covering construction and use of the above type; I agree to perform said construction in conformity therewith. I further agree that issuance of a permit on above application will not excuse me from conforming with said Ordinances and Statutes, despite any errors on the part of the Building Inspector or Engineer in checking plans and applications herewith submitted. I have read and understand the contents of above application & permit; I hereby state that same are true and correct.

SIGN HERE: American Fence Date: 10-28-66
By: Steve Surber

APPROVED BY: [Signature]

PLANNING DEPT. & CODE ASSISTANCE

DATE 10/28/66

FIRE DEPARTMENT

DATE

ENGINEERING DEPARTMENT

DATE

BUILDING & SAFETY DEPARTMENT

DATE 10-28-66

#1203

PERMIT NO. 35365

PERMIT FEE \$ 4.00

RECEIPT
415 \$004.00 - 8

CITY OF LAS VEGAS
DEPT. OF
BUILDING & SAFETY

Must be machine validated

28 OCT 66

L. Gatewood 2-21-79

CITY OF LAS VEGAS, NEVADA

LOG NO. & AREA

DEPARTMENT OF BUILDING & SAFETY

1971

CONST. VAL. \$ 400.00

APPLICATION & BUILDING PERMIT - for:

Dwellings, Duplexes, Misc. Residential Const.

ADDRESS OF CONSTRUCTION:

3608 E CHEVY CHASE

OWNER:

R M HOLLAND

LOT(s)

78

BLOCK

6

SUBDIVISION

WASHINGTON SQ UN 1

ZONE:

R-1

Existing structure on lot: Dwelling ☒ Accessory bldgs. ☐ Vacant lot ☐ Other ☐

PROPOSED CONSTRUCTION:

PATIO DOOR

USE

SAME

MATERIALS OF CONSTRUCTION:

Wood Frame ☒

Concrete Block ☐

Reinforced Concrete ☐

Steel Frame ☐

SQUARE FEET OF FLOOR AREAS:

1st

2nd

3rd

Other

TOTAL SQ. FT.

FIRE ZONE:

1 2 3

Occupancy Group

A

B

C

D

E

F

G

H

I

J-1

2-3-4-5

CONST. TYPE:

I

II

III

IV

V

ARCHITECT:

ENGINEER:

NO. of UNITS

NO. of STORIES

Plans Submitted: Yes ☐ No ☒

Calculations Submitted

Yes ☐

No ☐

Sewer Fee Req'd.

Yes ☐

No ☐

CONTRACTOR:

OWNER

STATE

LICENSE

CITY

LICENSE

ADD'L PERMITS REQ'D:

Air Cond. ☐

Elec. ☐

Plumbing ☐

Signs ☐

Paving ☐


Fence ☐

Public Walks ☐

Curb-gutters ☐

Incinerators ☐

Fire Sprinkling System ☐

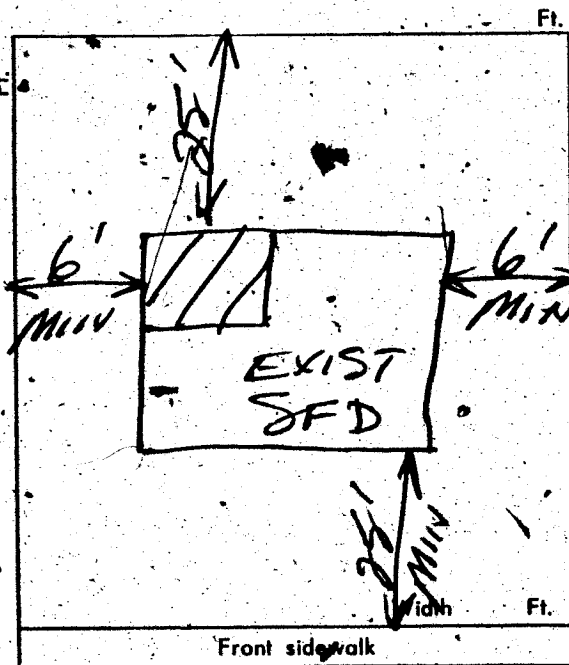

CONDITIONS OF THE PERMIT:

1. I agree to call the City Building Department for inspections before concrete is poured, before rough wiring, electrical, plumbing, framing is covered. Also for Air conditioning, sheet-rock and sheathing inspection.
2. I agree that when the job is completed if I will call for final inspection before occupancy.
3. I agree to perform all construction in accordance with City Ordinances and Building Codes.
4. The Contractor's signature below denotes authority from the owner to sign in his behalf and that the owner is aware of all requirements of this application and permit. Separate permits must be taken out for work outlined above this agreement.
5. I have read and understand the contents of this application and permit; I hereby state that the information I have supplied on this application is true and correct.

SIGNED:

Richard M. Holland

Contractor

BY:

Agent or Owner

CLARK COUNTY HEALTH DEPT.

Date

LAS VEGAS FIRE DEPARTMENT

Date

PLANNING DEPT:

me

Date:

4-12-71

PUBLIC WORKS DEPT:

Date:

BUILDING DEPT:

H. T. Walker

Date:

#12850

PERMIT NO.

59713

PERMIT FEE \$

62.00

RECEIPT

7613

006.00

CITY OF LAS VEGAS

DEPT. OF

BUILDING & SAFETY

MUST BE MACHINE VALIDATED

2 APR 71

Theresa Kyriakos 4-2-81

DEPARTMENT OF BUILDING & SAFETY
CITY OF LAS VEGAS, NEVADA

MANDEX CARD
FENCE & RETAINING
WALLS

OWNER Nevada Savings

ADDRESS 3608 Chevy Chase

DATE 6/14/66

CONTRACTOR American Fence

PERMIT NO. 31100

LOT 78

BLOCK A

SUBDIVISION Washington Sq.

Wood Fence

Fence (wire, wood, etc.)

Walls (masonry, rock, etc.)

Location

Final Inspection Gilt 6/26/66

Location

Footings

Wall Steel 1st 2d 3d

Final Inspection

Retaining Wall (masonry)

Retaining Wall (concrete)

Location

Footings

Wall Steel 1st 2d 3d

Bond Beam 1st 2d 3d

Final Inspection

Location

Footings

Wall Steel 1st 2d 3d

Final Inspection

23.14 B

ADDRESS 3608 Chevy Chase

LOG NO.

AREA

DEPT. of BLDG. & SAFETY—CITY of LAS VEGAS, NEVADA

OWNER C. T. Lindsay

ADDRESS 3608 Chevy Chase Ave

DATE 11-30-64

GEN. CONT. Same

PERMIT NO. 26623

LEGAL DESCRIPTION

Lot 78 block 6 Washington Sq. Unit #1

TYPE OF STRUCTURE SDD

BUILDING		MECHANICAL		ELECTRICAL	
LOCATION		PLUMBING CONT.		TEMP. POLE CONT.	
FIREPLACE FTS		PERMIT NO. 16272	DATE 12-6-64	PERMIT NO. 16720	DATE 5-4-64
FOOTINGS	25-3-64	HEAT & VENT. AC CONT.	Cherry 11-5-64	INSPECTION	2-5-64
FOUNDATION WALL	12-6-7-64	PERMIT NO. 11566	DATE 6-15-64	ELECTRICAL CONT.	Shook
FLOOR FRAMING		SEWER CONT.	11-5-64	PERMIT NO. 17807	DATE 7-21-64
BLAB	12-6-26-64	PERMIT NO. 16370	DATE 12-6-64	FIXTURES CONT.	Shook
CHIMNEY STEEL (FIREPLACE)		ROUGH SOIL	12-6-18-64	PERMIT NO. 17807	DATE 7-21-64
WALL STEEL	12-7-13-64	ROUGH WATER	12-6-18-64	SLAB	
COLUMN STEEL		TOP-OUT	12-8-7-64	ROUGH	12-7-27-64
BEAM STEEL	12-7-13-64	ROUGH GAS	12-8-7-64	FINAL ROUGH	
FRAMING		AC ROUGH DUCT	12-8-7-64	FINAL FIXTURE	
ROOF SHEATHING	12-7-22-64	REF. ROUGH PIPING		FINAL ELECTRICAL	Practice 12-9-64
INTERIOR		FINAL PLUMBING	12-10-22-64	TEMPORARY SERVICE	
DRYWALL	12-9-7-64	FINAL GAS	12-10-22-64	MISCELLANEOUS	
LATHING		FINAL AIR COND.	12-10-22-64	GRADING & DRAINAGE	
BACKING (SIDING)		FINAL REFRIG.		ON-SITE PARKING SPACES	
PLASTER	SCRATCH	FINAL SEWER	12-7-7-64	ENG. APPROVAL OF	
	BROWN	FINAL SEPTIC TANK		OFF-SITE IMPROVEMENTS	
URBAN REDEVELOPMENT APPROVAL					
FINAL BDDG	12-9-7-64				

APPROVED FOR OCCUPANCY & METER

INSPECTOR

DATE

PLEASE NOTE REMARKS ON REVERSE SIDE

3608 Chevy Chase

LOG #

AREA #

T 7

23.04

The one Kyuakos 4-2-81

DEPT. of BLDG. & SAFETY - CITY of LAS VEGAS, NEVADA

OWNER R. M. Holland ADDRESS 3608 E. Chevy Chase DATE 4-12-71
GEN. CONT. Owner TYPE OF STRUCTURE patio floor
PERMIT NO. 59713 LEGAL DESCRIPTION Lot 78 Block 6 Washington Sq # 1

BUILDING		MECHANICAL	ELECTRICAL
LOCATION		PLUMBING CONT.	TEMP. POLE CONT.
FIREPLACE FTS		PERMIT NO. DATE	PERMIT NO. DATE
FOOTINGS		HEAT & VENT. AC CONT.	INSPECTION DATE
FOUNDATION WALL		PERMIT NO. DATE	ELECTRICAL CONT.
FLOOR FRAMING		SEWER CONT.	PERMIT NO. DATE
SLAB		PERMIT NO. DATE	FIXTURES CONT.
CHIMNEY STEEL (FIREPLACE)		ROUGH SOL.	PERMIT NO. DATE
WALL STEEL		ROUGH WATER	SLAB
COLUMN STEEL		TOP-OUT	ROUGH
BEAM STEEL		ROUGH GAS	FINAL ROUGH
FRAMING		AC ROUGH DUCT	FINAL FIXTURE
ROOF SHEATHING		REF. ROUGH PIPING	FINAL ELECTRICAL
INTERIOR	EXTERIOR	FINAL PLUMBING	TEMPORARY SERVICE
DRY WALL		FINAL GAS	
LATHING		FINAL AIR COND.	
BACKING (SIDING)		FINAL REFRIG.	
PLASTER	SCRATCH	FINAL SEWER	
	BROWN	FINAL SEPTIC TANK	
URBAN REDEVELOPMENT APPROVAL			
FINAL BLDG. DATE			

APPROVED FOR OCCUPANCY & METER AD B5-6-71 INSPECTOR DATE

PLEASE NOTE REMARKS ON REVERSE SIDE 3608 E. Chevy Chase LOT # AREA # 23 04

DEPARTMENT OF BUILDING & SAFETY
CITY OF LAS VEGAS, NEVADA

KARDEX CARD
FENCE & RETAINING
WALLS

OWNER Nevada Saving & Loan ADDRESS 3608 Chevy Chase DATE 10/28/66
CONTRACTOR American Fence PERMIT NO. 35365
LOT 78 BLOCK 6 SUBDIVISION Washington Sq. Unit #1
Block Fence

Fence (wire, wood, etc.)	Walls (masonry, rock, etc.)
Location	Location <u>CH 11-1-66</u>
Final Inspection	Footing <u>CH 11-1-66</u>
	Wall Steel 1st <u>2d</u> <u>3d</u>
	Final Inspection <u>11-14-66</u>
Retaining Wall (masonry)	Retaining Wall (concrete)
Location	Location
Footing	Footing
Wall Steel 1st <u>2d</u> <u>3d</u>	Wall Steel 1st <u>2d</u> <u>3d</u>
Bond Beam 1st <u>2d</u> <u>3d</u>	Final Inspection
Final Inspection	

Lona Frosaly

4-74-83

CITY OF LAS VEGAS, NEVADA

020-984-002

LOG NO. & AREA

DEPARTMENT OF BUILDING AND SAFETY

CONST. VAL. \$

480.00

APPLICATION & BUILDING PERMIT - for:
Dwellings, Duplexes, Misc. Residential Const.ADDRESS OF
CONSTRUCTION:

3608 Cherry Chase

OWNER:

Pearline Boone

LOT(s)

78

BLOCK

6

SUBDIVISION

WASHINGTON Square #1

ZONE:

R-1

Existing structure on lot:

Dwelling ☒Accessory Bldg. ☐Vacant Lot ☐Other ☐

PROPOSED CONSTRUCTION:

carport to garage 10x12

USE:

MATERIALS OF CONSTRUCTION:

Wood Frame ☐Concrete Block ☐Reinforced Concrete ☐Steel Frame ☒

SQUARE FEET OF FLOOR AREAS: 1st

2nd

3rd

Other

TOTAL SQ. FT.

FIRE ZONE:

Occupancy Group

CONST. TYPE:

ARCHITECT:

ENGINEER:

NO. of UNITS

NO. of STORIES

Plans Submitted:

Yes ☐No ☐

Calculations Submitted

Yes ☐No ☐

Sewer Fee Req'd.

Yes ☐No ☐

CONTRACTOR:

Boone

STATE
LICENSE #CITY
LICENSE #

ADD'L. PERMITS REQ'D.:

Air Cond. ☐Elec. ☐Plumbing ☐Signs ☐Fencing ☐Fence ☐Public Walks ☐Curb-gutters ☐Incinerators ☐Fire Sprinkling System ☐

CONDITIONS OF THE PERMIT:

- I agree to call the City Building Department for inspections before concrete is poured, before rough wiring, electrical, plumbing, framing is covered, before for Air conditioning, drywall and sheathing inspection.
- I agree that when the job is completed that I will call for final inspection before occupancy.
- I agree to perform all construction in accordance with City Ordinances and Building Codes.
- The Contractor's signature below denotes authority from the owner to sign in his behalf and that the owner is aware of all requirements of this application and permit. Separate permits must be taken out for work outlined above this agreement.
- I have read and understand the contents of this application and permit; I hereby state that the information I have supplied on this application is true and correct.

Approval for the work under this permit will be given only after refuse and debris have been removed from job site and public right of way. Separate permits are required for work within the public right of way.

SIGNED:

Pearline Boone

Contractor

BY:

TOTAL \$ 10.00

SFD \$ 10.00

STL \$ 10.00

TOTAL \$ 10.00

CHK \$ 10.00

R#8902 SR#001/01

CITY LAS VEGAS

Contract or Owner

PLANNING DEPT.:

Harry Van Buren

Date:

4/12/83

PUBLIC WORKS DEPT.:

Wick

Date:

4/12/83

BUILDING DIVISION:

li

Date:

PERMIT NO.:

8909

PERMIT FEE \$

10.00

2300-2401

RECEIPT
BLDG. & SAFETY
04/13/83

MUST BE MACHINE VALIDATED

Donna Hoidal

12-11-84

OWNER Pearline Boone		ADDRESS 3608 Chevy Chase	
DATE 4-13-83	GEN. CONT. Owner		
TYPE OF STRUCTURE Carport to garage		PERMIT NO. 8908	FINAL INSPECTION 3
LEGAL DESCRIPTION L 78 B 6 Washington		LOG NO.	AREA NO.
APPROVED FOR OCCUPANCY & METER			
BUILDING		MECHANICAL	
Investigation		Plumbing Cont.	
Location & Footing		Permit No.	Date
Concrete Slab Floor		Heat & Vent. A/C Cont.	
Fireplace Footing		Permit No.	Date
Chimney Steel		Sewer Cont.	
Vert. Steel Band		Permit No.	Date
Horiz. Steel Band		Rough Soil	
Framing		Rough Water	
Ext. Lath		Top Out	
Ext. Brown		Rough Gas	
Daywall		A/C R/ugh Duct	
Final Building 4/15/126-84		Final Plumbing	
Appr. for Occu.		Final Gas	
ELECTRICAL		Final Air Cond.	
Temp. Pole Cont.		Final Sewer	
Permit No.	Date	REMARKS	
Inspection	Date		
Electrical Cont.			
Permit No.	Date		
Rough		PLEASE NOTE ADDITIONAL REMARKS ON REVERSE SIDE	
Final Rough		DEPT. OF BLDG. & SAFETY	
Final Electrical		CITY OF LAS VEGAS	
Temporary Service		REV. 82-3-29	