

1114 Cunningsham

SEE APPLICATION

These Kynak 1-19-81

CITY OF LAS VEGAS, NEVADA

LOG NO. & AREA

CONST. VAL. \$

588

DEPARTMENT OF PUBLIC SERVICES
DIVISION OF BUILDING AND SAFETY

APPLICATION & BUILDING PERMIT - for:
Dwellings, Duplexes, Misc. Residential Const.

ADDRESS OF
CONSTRUCTION

OWNER:

LOT(s)

BLOCK

SUBDIVISION

ZONE:

Existing structure on lot:

Dwelling ☐

Accessory Bldgs. ☐

Vacant Lot ☐

Other ☐

PROPOSED CONSTRUCTION:

MATERIALS OF CONSTRUCTION:

Wood Frame ☐

Concrete Block ☐

Reinforced Concrete ☐

Steel Frame ☐

SQUARE FEET OF FLOOR AREAS:

1st

2nd

3rd

Other

TOTAL SQ. FT.

FIRE ZONE:

Occupancy Group

CONST. TYPE:

ARCHITECT:

ENGINEER:

NO. of UNITS

NO. of STORIES

Plans Submitted:

Yes ☐

No ☐

Calculations Submitted

Yes ☐

No ☐

Sewer Fee Req'd.

Yes ☐

No ☐

CONTRACTOR:

STATE
LICENSE #

CITY
LICENSE #

ADDL. PERMITS REQ'D.

Air Cond. ☐

Elec. ☐

Plumbing ☐

Signs ☐

Paving ☐

Fence ☐

Public Walks ☐

Curb-gutters ☐

Incinerators ☐

Fire Sprinkling System ☐

CONDITIONS OF THE PERMIT:

1. I agree to call the City Building Department for inspections before concrete is poured, before rough wiring, electrical, plumbing, framing is covered. Also for Air conditioning, drywall and sheathing inspection.
2. I agree that when the job is completed that I will call for final inspection before occupancy.
3. I agree to perform all construction in accordance with City Ordinances and Building Codes.
4. The Contractor's signature below denotes authority from the owner to sign in his behalf and that the owner is aware of all requirements of this application and permit. Separate permits must be taken out for work outlined above this agreement.
5. I have read and understand the contents of this application and permit; I hereby state that the information I have supplied on this application is true and correct.

Approval for the work under this permit will be given only after refuse and debris have been removed from job site and public right of way.

SIGNED:

Contractor

BY:

Agent or Owner

BLDG. & SAFETY

01/16/81

1BTL \$.00

SFD \$ 11.50

STL \$ 11.50

TOTAL \$ 23.00

CASH \$ 15.00

CHNG \$ 3.50

AM7990 SR#001/01

CITY - LAS VEGAS

MUST BE MACHINE VALIDATED

PLANNING DEPT:

Date:

PUBLIC WORKS DEPT:

Date:

BUILDING DIVISION:

Date:

PERMIT NO.:

PERMIT FEE \$

1721-2401

Theresa Kyriakos 4-17-81

DEPT. of BLDG & SAFETY—CITY of LAS VEGAS, NEVADA
OWNER Mabel Wilson ADDRESS 1111 Cunningham DATE 2-17-61
GEN. CONT. W. J. Chester TYPE OF STRUCTURE wire fence
PERMIT NO. 23775 LEGAL DESCRIPTION See Application

BUILDING		MECHANICAL	ELECTRICAL
LOCATION		PLUMBING CONT.	TEMP. POLE CONT.
FIREPLACE FTS.		PERMIT NO. <u>5</u> DATE <u>1</u>	PERMIT NO. <u>5</u> DATE <u>1</u>
FOOTINGS		HEAT & VENT. AC CONT.	INSPECTION DATE
FOUNDATION WALL		PERMIT NO. <u>5</u> DATE	ELECTRICAL CONT.
FLOOR FRAMING		SEWER CONT.	PERMIT NO. DATE
SLAB		PERMIT NO. DATE	FIXTURES CONT.
CHIMNEY STEEL (FIREPLACE)		ROUGH SOIL	PERMIT NO. DATE
WALL STEEL		ROUGH WATER	SLAB
COLUMN STEEL		TOP-OUT	ROUGH
BEAM STEEL		ROUGH GAS	FINAL ROUGH
FRAMING		AC ROUGH DUCT	FINAL FIXTURE
ROOF SHEATHING		REF. ROUGH PIPING	FINAL ELECTRICAL
	INTERIOR EXTERIOR	FINAL PLUMBING	
DRYWALL		FINAL GAS	TEMPORARY SERVICE
LATHING		FINAL AIR COND.	
BACKING (SIDING)		FINAL REFRIG.	MISCELLANEOUS
PLASTER		FINAL SEWER	GRADING & DRAINAGE
REDEVELOPMENT APPROVAL		FINAL SEPTIC TANK	ON-SITE PARKING SPACES APP.
FINAL BLDG <u>1111</u>	DATE <u>2-24-61</u>		ENG. APPROVAL OF
			OFF-SITE IMPROVEMENTS

APPROVED FOR OCCUPANCY & METER _____ INSPECTOR _____ DATE _____
PLEASE NOTE REMARKS ON REVERSE SIDE

1111 Cunningham

DEPT. of BLDG. & SAFETY—CITY of LAS VEGAS, NEVADA
OWNER MABEL WILSON ADDRESS 1111 Cunningham Drive DATE 3-4-57
GEN. CONT. OWNER TYPE OF STRUCTURE REDWOOD FENCE
PERMIT NO. 28253 LEGAL DESCRIPTION SE¹/₄, NE¹/₄, SE¹/₄, NE¹/₄, Sec. 28, T. 20S, R. 61E.

LOCATION & FLOOR ELEVATION	PLUMBING CONT.	TEMP. POLE CONT.
FOOTINGS	PERMIT NO. DATE	PERMIT NO. DATE
FOUND. & PIERS	HEAT & VENT. CONT.	INSPECTION DATE
WALL STEEL	PERMIT NO. DATE	ELECTRICAL CONT.
BOND BEAM STEEL	SEWER CONT.	PERMIT NO. DATE
FRAMING & ROOF SHEATHING	PERMIT NO. DATE	OUTLETS
STEEL FABRICATION	ROUGH SOIL	MOTORS H.P.
CONNECTIONS & PAINTING	ROUGH WATER	SLAB
	SEWER OR SEPTIC TANK	ROUGH
LATHING	TOP-OUT	FINAL ROUGH
PLASTER	ROUGH GAS	FIXTURE CONT.
SCRATCH	ROUGH DUCT	PERMIT NO. DATE
BROWN	FINAL PLUMBING	FIXTURES
FINAL BLDG <u>Approved 2-6-1957</u>	FINAL HEATING	FINAL FIXTURE
GRADING & DRAINAGE	FINAL GAS	APPROVED FOR METER
ON-SITE PARKING SPACES		
ENG. APPROVAL OF		
OFF-SITE IMPROVEMENTS		

APPROVED for OCCUPANCY: _____ INSPECTOR _____ DATE _____

* PLEASE NOTE REMARKS ON REVERSE SIDE

1111 Cunningham Drive - REDWOOD FENCE

3/4/57

23.04

CITY OF LAS VEGAS, NEVADA

LOG NO. & AREA

DEPARTMENT OF PUBLIC SERVICES
DIVISION OF BUILDING & SAFETY

APPLICATION & BUILDING PERMIT - for:
Fence, Wall, Retaining Wall.

CONST. VAL \$ 2050

ADDRESS OF CONSTRUCTION:

1114 Cunningham

OWNER:

Julius Parker

LOT(s)

BLOCK

2

SUBDIVISION

Porton 8 3 1/2 S 1/2 NE 1/4 Sec 28

ZONE

R-1

Materials of Construction:

Block ☒

Concrete ☐

Wire ☐

Wood ☐

Other ☐

Yes No

ARCHITECT:

ENGINEER:

PLANS:

☐ ☐

CONTRACTOR:

Duran

STATE LICENSE #

CITY LICENSE #

CALCS:

☐ ☐

TOTAL SQUARE FEET:

820


TOTAL LINEAL FEET:

160

Remarks:

CONDITIONS OF THE PERMIT:

1. Any type of retaining wall must be engineered by a Civil or Structural Engineer.
2. If a home owner takes out the Building Permit and if the owner sublets the work to a Contractor, then the Contractor must take out the permit and pay for it.
3. No fence or wall can be built on City property or rights-of-way, but this is not intended to preclude construction within utility easements if utilities will not be damaged or made inaccessible.
4. The fence or wall shall not enclose any water meter, light standard, or fire alarm box and shall not come closer than 4" from the nearest fire hydrant outlet.
5. Department Inspectors must approve the plans before concrete is poured and block wall reinforcing before grouting is done.
6. Maximum height of any wall or fence is 6', side and rear yards: 4' maximum in front yard with the vertical surface above the height of 2' - 50% open.
7. I must not obstruct required on-site parking space (2 spaces for each dwelling unit) by the erection of this fence or wall.
8. By the signing of this application I herewith agree to the requirements outlined above.

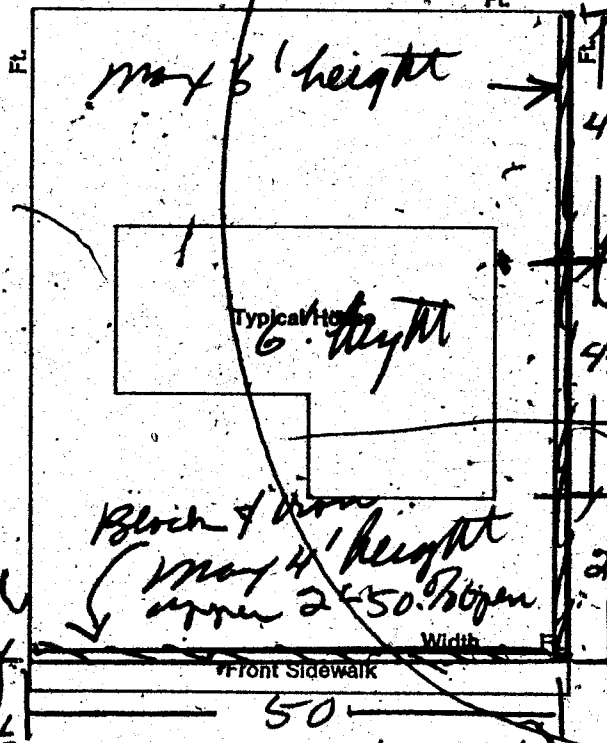

SIGNED:

Julius Parker

DATE:

CONTRACTOR ☐ AGENT ☐ OWNER ☐

PLANNING DEPT:

J. Brown

Date:

3/3/81

PUBLIC WORKS DEPT:

J. Brown

Date:

3-3-81

BUILDING DIVISION:

WR 3

Date:

3/3/81

PERMIT NO:

9174

PERMIT FEE:

3850

OWNER ☐
1 BILL \$ 00
WALL \$ 38.50
STL \$ 138.50
TOTL \$ 38.50
CASH \$ 40.00
CHNG \$ 1.50
R#9174 SR#001/01
CITY - LAS VEGAS
BLDG. & SAFETY
03/03/81

MUST BE MACHINE VALIDATED

7-15-82

FENCE & RETAINING WALL		
OWNER Julius Parker		
ADDRESS 1114 Cunningham		
CONTRACTOR	PERMIT NO.	FINAL INSPECTION
Comer	9174	
LOT	BLOCK	SUBDIVISION
	2 Portion Bk. 54	Lot Sec 24
AREA		
FENCES (wire, wood, block, & retaining walls)		
1	Location	
2	Footing	EC-3-10-81
3	Wall Steel	Spout 11-17-81
	1st	2nd
4	Bond Beam	
	1st	2nd
5	Final	CM/2-4-81
Specify Type Of Fence		
79-2-11 DIV. OF BLDG. & SAFETY CITY OF LAS VEGAS REV. 10-78		

OWNER Paul Parker		ADDRESS 1114 Cunningham	
DATE	1-16-81	GEN. CONT. OWNER	7990
TYPE OF STRUCTURE	Storage Shed	PERMIT NO.	
LEGAL DESCRIPTION	See application	FINAL INSPECTION	
LOG #		AREA #	
APPROVED FOR OCCUPANCY & METER			
BUILDING		MECHANICAL	
Investigation		Plumbing Cont.	
Location & Footing		Permit No.	Date
Concrete Slab Floor		Heat & Vent. A/C Cont.	
Fireplace Footing		Permit No.	Date
Chimney Steel		Sewer Cont.	
Vert. Steel Reinf.		Permit No.	Date
Horiz. Steel Reinf.		Rough Soil	
Framing		Rough Water	
Ext. Lath		Top-Out	
Ext. Brown		Rough Gas	
Drywall		A/C Rough Duct	
Final Building	CM/2-4-81	Final Plumbing	
Appr. for Occu.		Final Gas	
ELECTRICAL		Final Air Cond.	
Temp. Pole Cont.		Final Sewer	
Permit No.	Date	REMARKS	
Inspection	Date		
Electrical Cont.			
Permit No.	Date		
Rough		PLEASE NOTE ADDITIONAL REMARKS ON REVERSE SIDE	
Final Rough		DIV. OF BLDG. & SAFETY CITY OF LAS VEGAS REV. 10-78	
Final Electrical		79-3-16	
Temporary Service			

Debbie Ingram 3-30-88

CITY OF LAS VEGAS, NEVADA

LOG NO. & AREA

DATE

CONST. VAL. \$ 1,000

DEPARTMENT OF BUILDING AND SAFETY

BUILDING PERMIT - FOR: Single Family Dwelling;
Remodel, Additions, Misc. Residential Construction

PHONE 386-6251

ADDRESS OF
CONSTRUCTION

1114

OWNER

Julius Parker

PHONE
NO.

LOT(S)

Rt 83082

BLOCK

SUBDIVISION

S2X1E75425725R66 R-1

PHONE

PROPOSED CONSTRUCTION

carport

USE

THIS PERMIT FOR

8520

BLDG.

☐

A/C

☐

ELEC.

☐

PLBG.

☐

OTHER PERMITS REQD.: FENCE ☐ OFF SITE ☐ SWIM POOL ☐

FLOOR AREA

BSMT

1ST

2ND

GARAGE

PORCH

200

TOTAL

CONTRACTOR

owner

STATE
LICENSE NO.

CITY
LICENSE NO.

ARCHITECT

ENGINEER

MASTER PLUMBER/
CONTRACTOR

MASTER ELECTRICIAN/
CONTRACTOR

OTHER INSPECTIONS AND FEES

1. Inspections outside of normal business hours = \$30.00 per hour (minimum charge three hours)
2. Re-inspection fee during normal business hours assessed under provisions of TABLE 3-A of the Uniform Building Code = \$30.00 per hour
3. Inspections during normal business hours for which no fee is specifically indicated = \$30.00 per hour (minimum charge one half hour)
4. Additional plan review required by changes, additions or revisions to approved plans = \$30.00 per hour (minimum charge two hours)

CONDITIONS OF THE PERMIT:

1. I agree to call the City Building Department for inspections before concrete is poured, before rough wiring, electrical, plumbing, framing is covered. Also for air conditioning, drywall and sheathing inspection.
2. I agree that when the job is completed that I will call for final inspection before occupancy.
3. I agree to perform all construction in accordance with City Ordinances and Building Codes.
4. The Contractor's signature below denotes authority from the owner to sign in his behalf and that the owner is aware of all requirements of this application and permit. Separate permits must be taken out for work outlined above this agreement.
5. I have read and understand the contents of this application and permit. I hereby state that the information I have supplied on this application is true and correct.
6. Approval for the work under this permit will be given only after refuse and debris have been removed from job site and public right of way.
7. 24 HOUR MINIMUM NOTICE REQUIRED FOR INSPECTIONS.

BY: Julius Parker
I HEREBY DECLARE THAT I AM THE LEGAL OWNER OF THE ABOVE PROPERTY.

OWNER

BY:

AGENT

I hereby certify that I have reviewed this application and the proposed plans and have found that the proposed development meets the requirements of the City of Las Vegas Flood Hazard Reduction Ordinance for the issuance of this Development Permit.

LAND DEVELOPMENT AND FLOOD CONTROL ENGINEER

DATE

3/30/88

PLANNING DEPT


DATE

BUILDING DEPT

DATE

3-30-88

PLUMBING		FEE	ELECTRICAL		FEE
WATER DISTRIBUTION	6.00		RECEPTACLE	SWITCH	.40
SEWER SYSTEM - NEW OR MODIFICATION	10.00		EACH LIGHT FIXTURE OR SOCKET		.30
FIXTURES - WATER SOFTENER, H.W. HEATER	2.00		SPECIAL OUTLET, APPLIANCE ETC.		.70
GARBAGE DISPOSAL - WASHER	2.00		SERVICE/PANEL - SUB/3.00 - 200A/6.00 - 400A/12.50		
FUEL PIPING	6.00		A.C. UNIT OR MOTORS		3.00
IRRIGATION SYSTEM	8.00		2310 - 2402	TOTAL	
MISC.			MISC.		
2310 - 2403			2310 - 2401 ISSUANCE FEE		
TOTAL			7114 - 3654 SEWER CONNECTION		
AIR CONDITIONING		FEE	2310 - 2401 PLAN REVIEW FEE		
NEW UNIT - 3 TON = 9.00 OVER = 16.50			2310 - 2401 BLDG. PERMIT FEE		
FURNACE TO 100,000/9.00 OVER/11.00					
VAPORATIVE COOLER	6.50				
VENTILATION FAN	2.35				
2310 - 2405					
TOTAL					

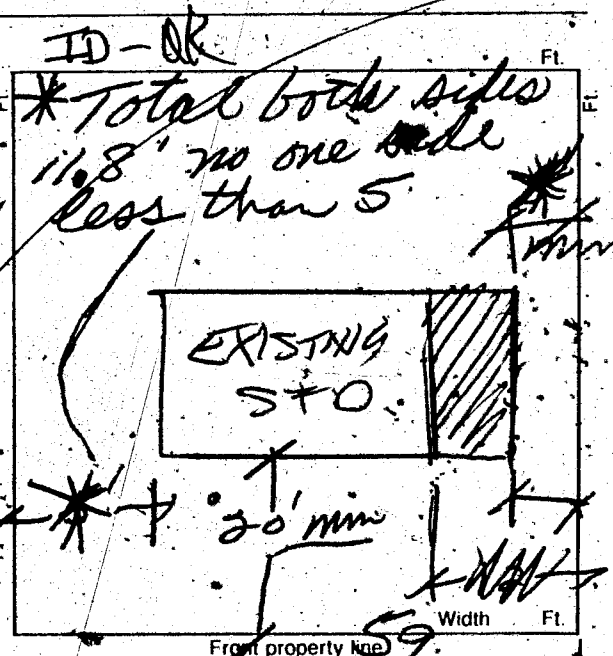

AS PER city Design
FOR INSPECTIONS
CALL 799-2071

RECEIVED 003**

SFD 21.00
CASH 21.00
8520A000 10:43

PERMIT NO.

MUST BE MACHINE VALIDATED

Permit Expires 180 Days After Abandonment of Work

Budget Babington Butler 4-13-90

OWNER	Julius Parker	ADDRESS	1114 Cuningham
DATE	3-31-88	GEN. CONT.	Owner
BUILD. TYPE	carport	PERMIT No.	8520
LEGAL		LOG No.	
BUILDING		MECHANICAL	
Pt. Loc. & Ft. ☐		Plumbing Cont.	
Location & Footing ☐		Permit No.	Date
Stemwall ☐		A/C Cont.	
Concrete Slab Floor ☐		Permit No.	Date
Chimney Steel ☐		Sewer Fee	
Fireplace Footing ☐		Irrig. Cont.	
Vert. Steel Reinf. ☐		Permit No.	Date
Horiz. Steel Reinf. ☐		Hood Cont.	
Roof Sheathing ☒		Permit No.	Date
Insulation		Rough Soil ☐	
Framing		Rough Water ☐	
Ext. Lath		Top-Out	
Ext. Scratch		Rough Gas	
Ext. Brown		A/C Rough Duct.	
Drywall		Final Plumbing	
Final Building		Final Gas	
Appr. for Occu. Final Building		Final Air Cond.	
		Final Sewer	
ELECTRICAL		Rough Hood ☐	
Electrical Cont.		Final Hood ☐	
Permit No.	Date	Final Irrig.	
PT Rough			
Ground Electrode		ELECTRICAL	
Temporary Power		Temp. Pole Cont.	☒
Meter Tag		Permit No.	Date
Final Electrical		Inspection	Date