

.2613 Castlewood Dr .

. L 18 B-1 Sub Ench Vill #1 Zone R-1 .

L. Gatewood 2-16-79

CITY OF LAS VEGAS, NEVADA
DEPARTMENT OF BUILDING AND SAFETY
APPLICATION FOR FENCE, WALL OR
RETAINING WALL

LOG NO. 1966

AREA: _____

KARDEX CARD: _____

TELEPHONE: 717-1344

CONSTRUCTION

VALUATION: 81.50

INSPECTION

VALUATION: 65.00

PERMIT FEE: 3.00

PERMIT NUMBER: 32615

DATE: 2-16 1966

ADDRESS OF

CONSTRUCTION: Castwood

OWNER'S

NAME

Mr. S. J. & Mrs. J. M.

OWNER'S

ADDRESS

Los Vegas

Lot (s) 18

Block 1

Subdivision Enclave

Unit #1

Zone: R-1

Materials of Construction: Concrete

Block () Concrete () Wire () Wood () Other ()

Total Square Feet: _____

Total Linear Feet: 65

CONTRACTOR'S NAME: American Fence

STATE

LICENSE # 8581

CITY

LICENSE# _____

Architect's Name: _____

PLANS SUBMITTED: Yes _____ No _____

Engineer's Name: _____

CALCULATIONS: Yes _____ No _____

Street Name: Castwood

Front Yard: _____ Feet 65

I understand that any portion of this (fence) (wall) constructed or erected on City property or right-of-way will be removed from said location at my expense upon request received from the City of Las Vegas, Nevada. I understand that the (fence) (wall) shall not enclose water meter, light standard, fire alarm box and shall not come closer than two (2') feet in any direction from any fire hydrant. I further state that I am familiar with effective Ordinances of the City of Las Vegas, Nev. and effective Statutes of the State of Nevada covering construction and use of above type; I agree to perform said construction in conformity therewith. I further agree that issuance of a permit on above application will not excuse me from conforming with said Ordinances and Statutes, despite any errors on the part of the Building Inspector or Engineer in checking plans and applications herewith submitted.

I have read and understand the contents of above application; I hereby state that same are true and correct.

SIGN HERE: American Fence

By: Stan Thibault

APPROVED BY: 2/16/66

PLANNING DEPT. & CODE ASSISTANCE

DATE: _____

FIRE DEPARTMENT


DATE: _____

ENGINEERING DEPT.

DATE: _____

BUILDING & SAFETY DEPT.

DATE: 2-16-66

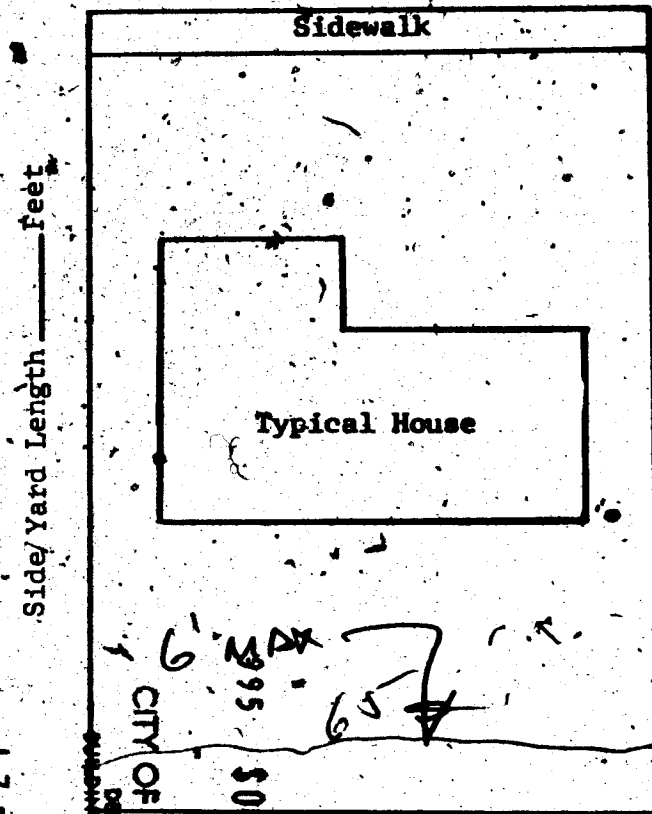

Rear Yard: _____ Feet

Side Yard Length: _____ Feet

Side Yard Length: _____ Feet

G. Gatewood 2-16-79

CITY OF LAS VEGAS, NEVADA
DEPARTMENT OF BUILDING AND SAFETY
APPLICATION FOR FENCE, WALL OR
RETAINING WALL

LOG NO. _____

AREA: _____

KARDEX CARD: ☒

TELEPHONE: _____

CONSTRUCTION

VALUATION: 102

INSPECTION

VALUATION: 81

PERMIT FEE: 300

PERMIT NUMBER: 33596

DATE: 5-2-1966

ADDRESS OF

CONSTRUCTION: 2613 Castwood OWNER'S NAME: Ruben A. Hsener

Lot (s) 18 Block 1 Subdivision ENCHANTED VILLAGES #1 Zone: R-1

Materials of Concrete

Construction: Block () Concrete () Wire (4) Wood () Other ()

Total Square Feet: _____ Total Linear Feet 81'

CONTRACTOR'S NAME: American Fence

STATE

LICENSE # 8581

CITY 7954

LICENSE#

Architect's Name: _____

PLANS SUBMITTED: Yes _____ No _____

Engineer's Name: _____

CALCULATIONS: Yes _____ No _____

Street Name: _____


Front Yard: _____ Feet

I understand that any portion of this (fence) (wall) constructed or erected on City property or right-of-way will be removed from said location at my expense upon request received from the City of Las Vegas, Nevada. I understand that the (fence) (wall) shall not enclose water meter, light standard, fire alarm box, and shall not come closer than two (2') feet in any direction from any fire hydrant. I further state that I am familiar with effective Ordinances of the City of Las Vegas, Nev. and effective Statutes of the State of Nevada covering construction and use of above type; I agree to perform said construction in conformity therewith. I further agree that issuance of a permit on above application will not excuse me from conforming with said Ordinances and Statutes, despite any errors on the part of the Building Inspector or Engineer in checking plans and applications herewith submitted.

I have read and understand the contents of above application; I hereby state that same are true and correct.

SIGN HERE: _____

By: _____

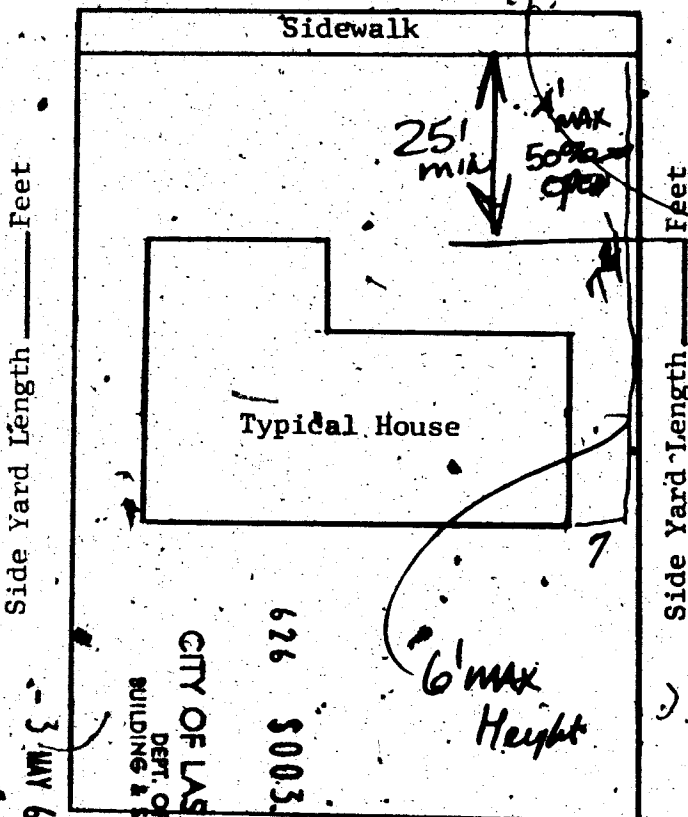

626 \$003.00
CITY OF LAS VEGAS
DEPT. OF
BUILDING & SAFETY
MAY 66

Rear Yard: _____ Feet

APPROVED BY: 5/2/66
PLANNING DEPT. & CODE ASSISTANCE DATE:

FIRE DEPARTMENT DATE:

ENGINEERING DEPT. DATE:

BUILDING & SAFETY DEPT. 5-2-66 DATE:

Note: Owner or Contractor must call for all inspections required.

L. Gatewood 2-16-79

CITY OF LAS VEGAS, NEVADA

DEPARTMENT OF BUILDING & SAFETY — ELECTRICAL APPLICATION & PERMIT

ADDRESS OF CONSTRUCTION: 2613 CASTLEWOOD DR.

OWNER'S NAME: B. KAUFMAN

CIRCLE: New Bldg.: Add'n: Remodel: TYPE OF BLDG.: SFD APT. PUBLIC COMM:

CONTRACTOR'S NAME: ANDERSON ELECTRIC

STATE LICENSE # 10997

CITY LICENSE # 2-00350

NUMBER	FIXTURE OR INSTALLATION	UNIT PRICE	
	Fixture or sockets	.15	
	Light, receptacle or switch outlet	.20	
	Wall or ceiling space heater	.35	
	Blast coil heater per kilowatt	.35	
	Garbage grinder outlet	.35	
	Dishwasher outlet	.35	
	Clothes dryer outlet	.35	
	Automatic clothes washer	.35	
	Electric range outlet	.35	
	Electric water heater outlet	.35	
	Mercury arc lamp and equipment	.35	
	Special purpose outlet	.35	
	X-ray unit and its appurtenances	5.00	
	Watts of festoon lighting (Watts) First 3,000 watts for each additional thousand watts	4.00 1.50	
	Horsepower — all motors first horsepower or less for each additional horsepower	1.75 .35	
	Temporary power and lights (temporary pole)	4.00	
1	Electric service (including any single meter socket) for each additional socket	3.00 .35	3.00
	Air conditioning service amps	1.50	
	Each KW (KVA) Generator (Transformer) (Welder) KW (KVA) First 100 KVA — For each additional KW (KVA)	2.00 .01	
	Special inspection per hour	4.00	
	Speaker outlets	.15	
	Signal Alarm outlets	.15	
	Amplifiers	.50	
	Control panels	.25	
	T. V. outlets — master system only	.15	
	Radio outlets	.15	
	Main control racks	1.00	
	T. V. and Radio antennas — master system only	.75	
	Minimum fee for any permit	4.00	
	Total fee		4.00

I hereby certify that I have carefully examined and read the above application; that the same is true and correct; and that the work herein described is to be done in accordance with all the provisions of the applicable Ordinances of the City of Las Vegas, Nevada and State laws, whether herein specified or not.

SIGNED: K. R. Lenoir 84
MASTER (ELECTRICIAN) (TECHNICIAN) (OWNER)

DATE: 1/25/74

BUILDING DEPARTMENT

DATE:

#12860 PERMIT NO.

8568

PERMIT FEE: \$

4.00

RECEIPT

6998 \$004.00 — 6

CITY OF LAS VEGAS

DEPT. OF
BUILDING & SAFETY

MUST BE MACHINE VALIDATED

5 FEB 74

Theresa Aguilar 11-12-80.

CITY OF LAS VEGAS, NEVADA

DEPARTMENT OF PUBLIC SERVICES - PLUMBING APPLICATION & PERMIT DIVISION OF BUILDING AND SAFETY

ADDRESS OF
CONSTRUCTION: 2613 Castlewood

OWNER'S
NAME: NICKLAS V. LEON

CIRCLE: Addition; Remodel; New Bldg. TYPE OF BLDG.: SFD APT. COMM. PUBLIC

CONTRACTOR'S NAME: MEADOWS PLYG. CO.

STATE
LICENSE # 014412

CITY
LICENSE # 16590

UNITS	DESCRIPTION	FEE	TOTAL
PERMIT ISSUANCE			
	For Issuing Each Permit	7.00	7.00
	For Issuing Each Supplemental Permit	4.25	
FIXTURE CHARGE			
	Bathtub	1.50	
	Shower	1.50	
	Lavatory	1.50	
	Toilet	1.50	
	Urinal	1.50	
	Floor Drain	1.50	
	Floor Sink	1.50	
	Wash Tray	1.50	
	Sink	1.50	
	Garbage Disposal (residential)	1.50	
	Garbage Disposal (commercial)	5.50	
	Clothes Dryer (gas) (venting)	1.50	
	Clothes Washer (residential)	1.50	
	Clothes Washer (Commercial)	1.50	
	Dishwasher (residential)	1.50	
	Dishwasher (commercial)	1.50	
	Dental Unit	1.50	
	Drinking Fountain	1.50	
	Refrigerator, Ice Maker, Water Dispenser	1.50	
	Any other water using equipment, Attached coffee Makers, Ice Makers	1.50	
	Water Heaters (gas) (electric)	1.50	1.50
SEWER SYSTEM			
	New, Replacement, Modification, or Any Drainage Work	7.50	
	Grease or Sand Trap or Interceptor	2.00	
	Trailer Trap (rental parks)	3.50	
WATER SOFTENERS			
	Non Permanent Type (rental)	2.00	
	Permanent Type (connected to drain)	2.00	
SWIMMING POOLS			
	Private or Wading Pool (including spa)	15.00	
	Public or Semi Public	25.00	
	Spas - Preformed (private)	10.00	
	Spas - Preformed (commercial)	15.00	
WATER DISTRIBUTION SYSTEM			
	Single Family Dwelling	5.00	
	Multi-Family Dwelling	5.00	
	Plus Each Dwelling Unit	2.50	
	Commercial Building per floor	3.00	
	Plus Each Unit (leased space or office)	6.00	

UNITS	DESCRIPTION	FEE	TOTAL
	Hotel or Motel	8.00	
	Plus Each Unit	2.50	
	Trailer Park	25.00	
	Plus Each Space	1.50	
	Irrigation	8.00	
FUEL PIPING SYSTEM			
	Single Family Dwelling	4.50	
	Multi-Family Dwelling	8.00	
	Plus Each Unit	1.50	
	Commercial Building (per floor)	4.50	
	Plus Each Unit (leased space or office)	4.50	
	Medium Pressure Gas System (plan check)	6.00	
	Each Gas Appliance (any type)	1.50	
	Standby Emergency (generating engines)	2.50	
	Steam Boilers	2.50	
	Service Station Fuel Tank and Piping System	5.00	
		5.00	
AUTOMATIC FIRE EXTINGUISHING SYSTEM			
	Underground Piping	15.00	
	Distribution Piping (per foot)	.03	
	Sprinkler Head (each)	.15	
	In Range Hood and Vent	7.50	
	Dry Standpipe System	62.50	
	Piping	1.50	
	Each Outlet	7.50	
	Wet Standpipe System	1.50	
	Piping	2.50	
	Fire Hose Cabinet	2.50	
SOLAR ENERGY SYSTEMS			
	Collectors (including piping) (per collector)	2.50	
	Storage Tanks (each)	2.50	
PIPELINE CONTRACT			
	For Onsite Sewer, Gas or Water Contract Value. Fee based on Building Code Permit Valuation Chart.		
	Inspections for which no fee is specifically indicated (minimum charge - one half hour)	7.50 per hour	
	Additional plan review required by changes, additions or revisions to approved plans (minimum charge - one half hour)	7.50 per hour	

Plumbing permit fees may be computed the same as building permit fees by using the cost of installation for valuation amount when such work is not included in the above schedule.

I hereby certify that I have carefully examined and read the above application; that the same is true and correct; and that the work herein described is to be done in accordance with all the provisions of the applicable Ordinances of the City of Las Vegas, Nevada and the State Laws, whether herein specified or not.

Approval for the work under this permit will be given only after refuse and debris have been removed from job site and public right of way.

SIGNED [Signature] Date Oct. 27, 1980
Registered Master Plumber, Spec. Contr. or Owner

BUILDING DIVISION [Signature] Date

PERMIT NO. 6368-4 PERMIT FEE \$ 8.50

#1721-2403 (REV. 3/80)

RECEIPT

MUST BE MACHINE VALIDATED

Angela S. Jackson

ELEC. ONLY, PLBG. ONLY, A.C. ONLY			
OWNER <i>Jessie Emmett Reedy</i>		DATE <i>6-3-80</i>	
ADDRESS <i>2713 Castlewood</i>			
CONTRACTOR <i>Larkin Plumbing & Heat</i>		PERMIT NO. <i>3420</i>	FINAL INSPECTION
LOT	BLOCK <i>2</i>	SUBDIVISION	
LOG NO.		AREA	
ELECTRIC ONLY		PLUMBING ONLY	
Contractor		Contractor <i>Larkin P. & H.</i>	
Permit No.		Permit No. <i>3420</i>	
Rough Elec.		Rough Soil	
Final Rough		Rough Water	
Final Elec.		Top Out	
Temp. Service		Rough Gas	
HEAT & VENT. A/C ONLY		Final Plbg.	
Contractor		Final Gas <i>MMC 4-26-80</i>	
Permit No.		Sewer Final	
A/C Rough Duct			
Rough Gas			
Final A/C			
Final Gas			

79-3-15 DIV. OF BLDG. & SAFETY
CITY OF LAS VEGAS
REV. 10-78

ELEC. ONLY, PLBG. ONLY, A.C. ONLY			
OWNER <i>Nicklas V. Perr</i>		DATE <i>10-27-80</i>	
ADDRESS <i>2613 Castlewood</i>			
CONTRACTOR <i>Maiden P. & H.</i>		PERMIT NO. <i>6368-4</i>	FINAL INSPECTION
LOT	BLOCK	SUBDIVISION	
LOG NO.		AREA	
ELECTRIC ONLY		PLUMBING ONLY	
Contractor		Contractor <i>Maiden P. & H.</i>	
Permit No.		Permit No. <i>6368-4</i>	
Rough Elec.		Rough Soil	
Final Rough		Rough Water	
Final Elec.		Top Out	
Temp. Service		Rough Gas	
HEAT & VENT. A/C ONLY		Final Plbg.	
Contractor		Final Gas <i>MMC 12-17-80</i>	
Permit No.		Sewer Final <i>P.A. 12-23-80</i>	
A/C Rough Duct		<i>Water / Sewer</i>	
Rough Gas			
Final A/C			
Final Gas			

79-3-15 DIV. OF BLDG. & SAFETY
CITY OF LAS VEGAS
REV. 10-78

DEPARTMENT OF BUILDING & SAFETY
CITY OF LAS VEGAS, NEVADA

KARDEX CARD
FENCE & RETAINING
WALLS

OWNER Ruben A. Usher ADDRESS 2613 Castlewood DATE 5/2/66

CONTRACTOR American Fence PERMIT NO. 33596

LOT 18 BLOCK 1 SUBDIVISION Enchanted Village #1

Fence (wire, wood, etc.)		Walls (masonry, rock, etc.)	
Location <u>5-3-66</u>		Location _____	
Final Inspection _____		Footings _____	
		Wall Steel 1st _____ 2d _____ 3d _____	
		Final Inspection _____	
Retaining Wall (masonry)		Retaining Wall (concrete)	
Location _____		Location _____	
Footings _____		Footings _____	
Wall Steel 1st _____ 2d _____ 3d _____		Wall Steel 1st _____ 2d _____ 3d _____	
Bond Beam 1st _____ 2d _____ 3d _____		Final Inspection _____	
Final Inspection _____			

23.14 B ADDRESS 2613 Castlewood LOG NO. _____ AREA _____

Department of Building & Safety
City of Las Vegas, Nevada

Special Kاردex
Elec. only, Plbg. only, A.C. only

Owner B. Kaufman Address 2613 Castlewood Dr. Date: 2/5/74
Contractor _____ Permit No. _____
Lot _____ Block _____ Subdivision _____

Electric Only	Plumbing Only	Heat & Vent. A. C. Only
Contractor <u>Anderson</u>	Contractor _____	Contractor _____
Permit No. <u>8568</u>	Permit No. _____	Permit No. _____
Slab _____	Rough Soil _____	A.C. Rough Duct _____
Rough Elect* _____	Rough Water _____	Ref. Ro. Piping _____
Final Rough _____	Top Out _____	Rough Gas _____
Final Fixture _____	Rough Gas _____	Final Refrig _____
Final Elec <u>2-5-74</u>	Final Plbg. _____	Final Air Cond _____
Temp. Service _____	Final Gas _____	Final Gas _____
	Final Sewer _____	
	Final Septic Tank _____	

23.06 D Address 2613 Castlewood Dr. Log No. Service Area _____

Angela S. Jackson

DEPARTMENT OF BUILDING & SAFETY
CITY OF LAS VEGAS, NEVADA

KARDEX CARD
FENCE & RETAINING
WALLS

OWNER Nevada Savings & Loan ADDRESS 2613 Castlewood DATE 2-16-66

CONTRACTOR American Fence Co. PERMIT NO. 32611

LOT 18 BLOCK L SUBDIVISION Enchanted Village #1 WOOD FENCE

Fence (wire, wood, etc.)	Walls (masonry, rock, etc.)
Location _____	Location _____
Final Inspection <u>Hymer 2-22-66</u>	Footing _____
	Wall Steel 1st _____ 2d _____ 3d _____
	Final Inspection _____
Retaining Wall (masonry)	Retaining Wall (concrete)
Location _____	Location _____
Footing _____	Footing _____
Wall Steel 1st _____ 2d _____ 3d _____	Wall Steel 1st _____ 2d _____ 3d _____
Bond Beam 1st _____ 2d _____ 3d _____	Final Inspection _____
Final Inspection _____	

23.14 B

ADDRESS 2613 Castlewood LOG NO. _____ AREA _____