

608 S. Decatur

Debbie Anglin 3-30-88

MAYOR RON LURIE

COUNCILMEN
BOB NOLEN
W. WAYNE BUNKER
STEVE MILLER
ARNIE ADAMSEN

CITY MANAGER
ASHLEY HALL



CITY of LAS VEGAS

March 21, 1988

RECEIVED

4/00

C.C. G.

53

73

21

For file

Microfilm

Mr. Ernest A. Becker
50 South Jones, Suite 100
Las Vegas, NV 89107-2699

Re: Charleston Heights Shopping Center

Dear Ernest:

Per your request, we are changing the addresses of several of the lease spaces at Charleston Heights Shopping Center as follows:

Lease Space 14	From: 650A South Decatur Boulevard
	To: 600 South Decatur Boulevard
Lease Space 18	From: 608 South Decatur Boulevard
	To: 604 South Decatur Boulevard
Lease Space 19	From: 604 South Decatur Boulevard
	To: 608 South Decatur Boulevard

The dividing of lease space 13 be addressed as follows:

Lease Space 13 - 1	598 South Decatur Boulevard
- 2	594 South Decatur Boulevard
- 3	590 South Decatur Boulevard
13 - 4	586 South Decatur Boulevard
13 - 5	580 South Decatur Boulevard

A plan showing the requested changes is attached for your reference.

-continued-



CLV7009

400 E. STEWART AVENUE • LAS VEGAS, NEVADA 89101 • (702) 386-6011

To: Mr. Ernest A. Becker
Re: Charleston Heights
Shopping Center

March 21, 1988
Page -2-

We will notify the various City departments of this change. However notification of the various utility companies, post office and other correspondents, such as the Assessor's Office, etc. will be your responsibility. Please provide each of them with a copy of this letter so that they can make the appropriate changes.

If you have any questions concerning this action, please let us know.

Sincerely,



DEPARTMENT OF COMMUNITY PLANNING
AND DEVELOPMENT
HAROLD P. FOSTER, DIRECTOR

John B. Herbert
JOHN B. HERBERT
PLANNING ASSISTANT

JBH:jp

cc: Building and Safety
Business Activity
Fire Department
Metro Police Dept.
Clark County Assessor's Office
Susan French
Kim Hovaldt
COA file

Debbie Ingram 3-30-88

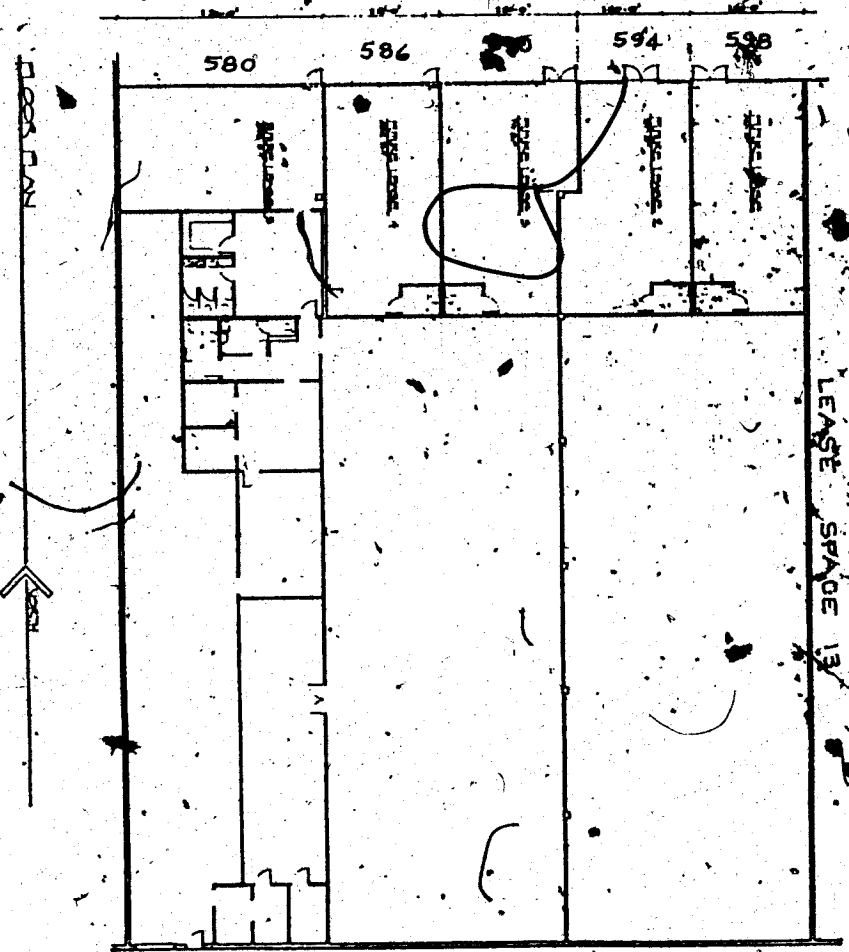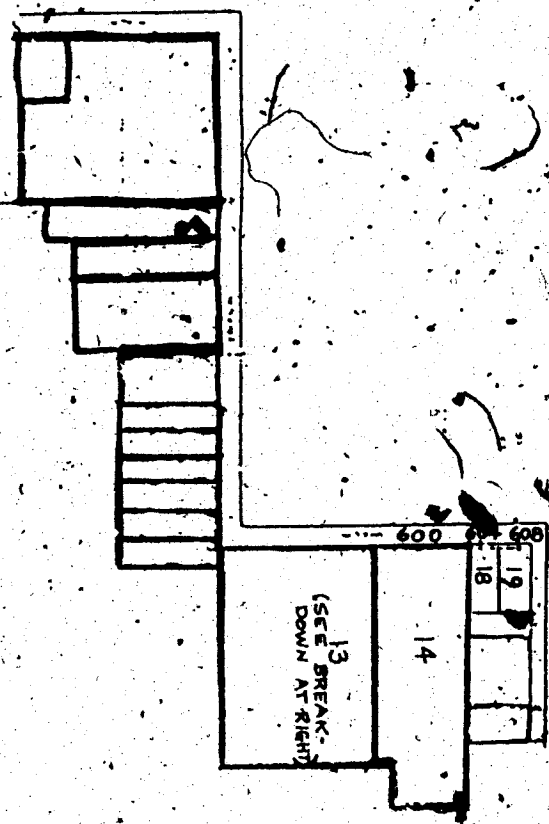

Becker Magnolia 3-30-88



ERNEST A. BECKER ENTERPRISES

50 South Jones Boulevard • Suite 100 • Las Vegas, Nevada 89107-2699
(702) 878-1903 • (800) 634-6105

March 16, 1988

John Robert
City of Las Vegas
400 East Stewart
Las Vegas, Nevada 89101

RE: Charleston Heights
Shopping Center

Dear John:

Per our telephone conversation of this date, we would appreciate your eliminating the address of 650 South Decatur Boulevard and assigning 500 sequence numbers to the lease spaces that require numbering due to the remodeling under construction at this time.

Thank you for your cooperation. If you have any questions, please do not hesitate to call.

Yours truly,

CHARLESTON HEIGHTS SHOPPING CENTER


Ernest A. Becker
Agent

aa

P.S. Please change

Existing address for 604 +

608 S. Decatur Blvd.

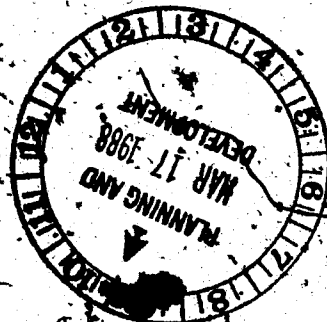

ERNEST A. BECKER
BETTY W. BECKER
ERNEST A. BECKER, JR.
BARRY W. BECKER
RANDALL L. BECKER
BRUCE F. BECKER

Dustin Ingram 3-30-88



ERNEST A. BECKER ENTERPRISES

50 South Jones Boulevard • Suite 100 • Las Vegas, Nevada 89107-2699
(702) 878-1903 • (800) 634-6105

March 16, 1988

John Hebert
City of Las Vegas
400 East Stewart
Las Vegas, Nevada 89101

RE: Charleston Heights
Shopping Center

Dear John:

Per our telephone conversation of this date, we would appreciate your eliminating the address of 650-A South Decatur Boulevard and assigning the address of 600 South Decatur Boulevard to this lease space.


Thank you for your cooperation. If you have any questions, please do not hesitate to call.

Yours truly,

CHARLESTON HEIGHTS SHOPPING CENTER

Ernest A. Becker
Agent

aa

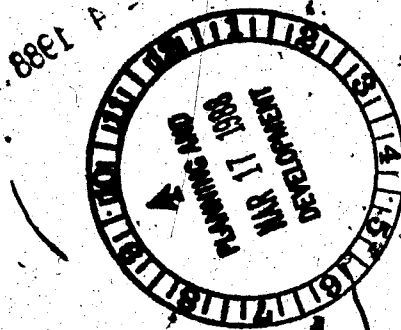

ERNEST A. BECKER
BETTY W. BECKER
ERNEST A. BECKER, JR.
BARRY W. BECKER
RANDALL E. BECKER
BRUCE F. BECKER