

DEPARTMENT OF BUILDING AND SAFETY
PHONE 386-6251



2071

DEVELOPMENT PERMIT
FOR: SIGNS

LOG NO. & AREA M-1319-90 DATE 5/31/90 CONST. VAL. \$ 9084

ADDRESS OF CONSTRUCTION 7504 Westcliff OWNER GREEN VALLEY GROCERY PHONE _____

CONTRACTOR LARSEN ELECTRIC SIGNS, INC STATE LICENSE NO. 10219-A CITY LICENSE NO. Z-01821

LOT(S) _____ BLOCK _____ SUBDIVISION Plum 35 4 5 6 ZONE: C-1

PROPOSED CONSTRUCTION: (2) SINGLE FACE ILLUMINATED CABINETS


MATERIAL FOR SIGN: Metal Wood Plastic Other TYPE OF PROJECT: New Sign Replacement Relocation

TYPE	SIZE	HEIGHT ZONE			VALUATION	PERMIT FEE
		A Up to 30'	B Over 30' up to 50'	C Over 50'		
NON-ELECTRIFIED:						
Single faced	sq. ft. @	\$5.00	\$7.00	\$9.00	\$	\$
Double faced	sq. ft. @	\$10.00	\$12.00	\$14.00	\$	\$
NEON OR OTHER ELECTRIFIED:						
		<u>Single Face Cabinets 397 sq. ft.</u>			<u>4764</u>	<u>61.00</u>
Single faced	<u>360 sq. ft. @</u>	\$12.00	\$14.00	\$16.00	\$ <u>4320</u>	\$ <u>61.00</u>
Double faced	sq. ft. @	\$16.00	\$18.00	\$20.00	\$	\$
FOR COMPUTER SIGNS OR SIGNS NOT INCLUDED ABOVE-USE CONST. VAL.						\$

FOR INSPECTIONS
CALL 799-2071

I hereby certify that I have examined and read the above application; that the same is true and correct; and that the work herein described is to be done in accordance with all the provisions of the applicable Ordinances of the City of Las Vegas, Nevada and the State Laws, whether herein specified or not.

SIGNED: [Signature] MASTER NEON-ELECTRIC BILLBOARD CONTRACTOR

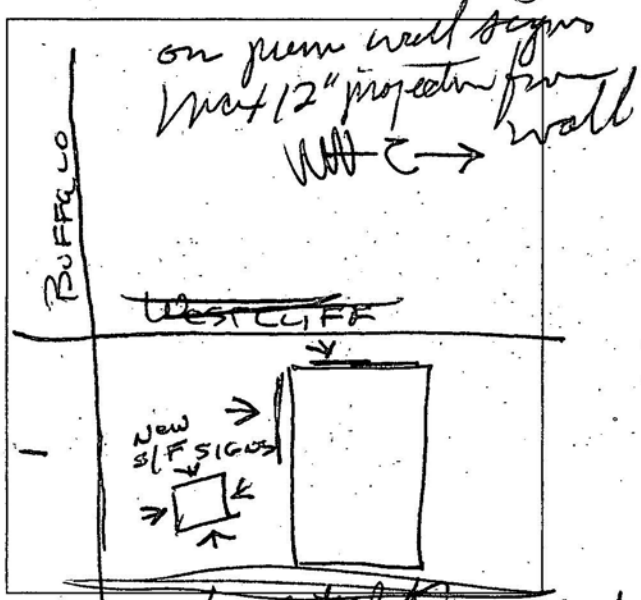

05/31/90

RECEIPT

***06**
SIGN 122.00
CHRG 122.00
5022A000 10:00

no final

PLANNING DEPT. _____ DATE 5/31/90
BUILDING DEPT. _____ DATE 5-31-90

PLAN REVIEW FEE _____
PERMIT FEE 122.00
2310-2401
TOTAL FEES 122.00