

CITY OF LAS VEGAS, NEVADA

DEPARTMENT OF BUILDING AND SAFETY
PHONE 386 6251

34527

MIT NO

071

91-117871

PLUMBING PERMIT

LOG NO & AREA

M-6574

DATE

8/27/91

CONST VAL \$

ADDRESS OF
CONSTRUCTION208 Marion
208 Marion

OWNER

Coddington

PHONE

CONTRACTOR

Dunn

STATE
LICENSE NOCITY
LICENSE NO

LOT(s)

BLOCK

SUBDIVISION

ZONE

PROPOSED CONSTRUCTION

PLUMBING
PERMIT NO

Run gas line to open underground

App o al fo the wo k der ths pe mt w ll be g ven only afte efuse
a d deb s ha e been emo ed fo m job s te and publ c ght of way

UNITS	DESCRIPTION	FEE	TOTAL
PERMIT ISSUANCE			
F iss g E h P m t		10.00	10.00
Fo Issu g Each S ppleme tal Pe m t		4.50	
FIXTURE CHARGE			
Bathtub Showe La ato y Tolet U l	EA	2.00	
Floo D an Floo S k Wash Tay Snk	EA	2.00	
Ga bage D sposal Clothes W she D shwashe (es de tal)	EA	2.00	
Ga bage D sposal (omme cal)	EA	8.00	
Clothes Washe D shwashe (omme cal)	EA	2.00	
Clothes D ye (gas) (e t g)		0.00	
Dental U t		8.00	
D nk ng Fo nta		2.00	
Ref ge ato Ice Make Wate D spe e		0.00	
A y othe wate s g equpme t Attache Coffee Make s Ice Makers		2.00	
Hot Wate He te (Gas o Ele t)	EA	2.00	
SEWER SYSTEM			
New R pl ceme t M d f to o A y D age Wo k		10.00	
G ease o Sa d T po l t pto		2.00	
T a ler Trap (e tal pa ks)		5.00	
WATER SOFTENERS			
No P ma t Type (e tal)		2.00	
P m e t Type (co d t d)		2.00	
WATER DISTRIBUTION SYSTEM			
S ngle Fam ly Dwell ng		6.00	
Mult Fam ly Dwell ng		6.00	
Pl s Each Dwell ng Un t		3.00	
Comme cal B ld ng pe floo		3.00	
Pl s Each U t (leased space o off ce)		2.00	
Hotel o Motel		8.00	
Plus Each Un t		3.00	
T ale Pa k		30.00	
Plus Ea h Spa e		2.00	
I gat o S ngl F m ly Dwell ng		8.00	
I r gat on Comme cal Fee Based on B ld g Code Val at on Cha t Const ct on Val at o			

UNITS	DESCRIPTION	FEE	TOTAL
FUEL PIPING SYSTEM			
S gl F m ly Dw ll g		6.00	6.00
M lt Fam ly Dwell g		10.00	
Plus Each Un t		2.00	
Comme cal B ld ng (pe floo)		6.00	
Pl s Each Un t (leased space o off ce)		6.00	
M d um P s e System (Pla Che k)		12.00	
E ch Gas Appl a ce (A y Typ)		2.00	
Steam Bo le s		5.00	
SOLAR ENERGY SYSTEMS			
C ll to s (l d ng p p g) (pe collecto)		5.00	
Storage Ta ks (each)		5.00	
PIPELINE CONTRACT			
Fo Onste Sewe Gas o Wate Cont act V l Fee based o B ld ng Code Pe m t Val at o Cha t			
OTHER INSPECTIONS AND FEES			
Inspect ons o ts de of o mal b s ess hou s (m n m m cha ge—th ee ho s)		25.00 pe hou	
Unde p o s o s of Tabl 3 A f the U fo m B ld g C d wo k wh ch has be n spected o ce and not app o ed may be subject to a Re spected on Fee not less tha \$30.00 per each inspect on du ng bus ness ho s		30.00 each	
Add to al pla w eq ed by h nges Add tions to o e s ons to app oved plans (m mum cha ge two ho s)		30.00 pe ho	
Plumb ng pe m t f s may be comp t d the same as b ld g pe m t fees by s g the co t of stallato fo l ato amou twhe s ch wo k s ot included the abo e sched le Const uct on Val at on			

FOR INSPECTIONS
CALL 799 2071SEWER # 7114 3654
CONNECTION

FIXTURES _____ X 08/27/91

FEE

2310 2403

PERMIT
FEE

79.00

TOTAL
FEES

17.12

RECEIPT

0002 ---
 PLBG 17 12
 CASH 17 12
 0780A000 14 49

I hereby certify that I have carefully examined and read the above applica-
tion that the same is true and correct and that the work herein described is to
be done in accordance with all the provisions of the applicable Ordinances of
the City of Las Vegas Nevada and he State Laws whether herein specified or
not

SIGNED

CONTRACTOR

MASTER CARD NO

BY

R g i d m t Pl mb Sp Co t Ow

BUILD NG DEPT

DATE

PERMIT NO

MUST BE MACHINE VALIDATED

CITY OF LAS VEGAS, NEVADA

DEPARTMENT OF BUILDING AND SAFETY
PHONE 386 6251

FO



155937-6

T NO

BUILDING PERMIT

FOR Single Family Dwelling Remodel
Additions Misc Residential Construction

060-403-007

LOG NO & AREA _____ DATE _____ CONST VAL \$ 680

ADDRESS OF CONSTRUCTION 208 MARION DR OWNER WILLIAM COBURN PHONE 3622455

LOT(S) 7 BLOCK 6 SUBDIVISION STEWART PLACE UNIT #4 ZONE 19R-1

PROPOSED CONSTRUCTION Cover USE _____

THIS PERMIT FOR BLDG ☐ A/C ☐ ELEC ☐ PLBG ☐ OTHER PERMITS REQD FENCE ☐ OFF SITE ☐ SWIM POOL ☐

FLOOR AREA BSMT _____ 1ST _____ 2ND _____ GARAGE _____ PORCH 136 TOTAL 136

CONTRACTOR Owner STATE LICENSE NO _____ CITY LICENSE NO _____

ARCHITECT _____ ENGINEER _____

MASTER PLUMBER/CONTRACTOR _____ MASTER ELECTRICIAN/CONTRACTOR _____

OTHER INSPECTIONS AND FEES

1 I p t t d f m l b h o r s = \$30.00 p h (m m h r g t h b)
2 R p t f d g m l b h n s d d p T A B L E S A f t h U f m B l d g C d
3 I p t n s d g m l b h f w h h f p f l y d c a t d - \$30.00 p h (m m h r g
4 Addit l p l r e w r e q d b y h g d d t t p p v e d i a s = \$30.00 p h (m m h r g
t w h o)

CONDITIONS OF THE PERMIT

- I agree to call the City Building Department to inspect before concrete is poured before any wiring electrical plumbing framing is covered. Also for air conditioning ductwork and heating inspection.
- I agree that when the job is completed that I will call for final inspection before occupancy.
- I agree to perform all construction in accordance with City Ordinances and Building Codes.
- The Contractor's signature below denotes authority from the owner to sign on his behalf and that the owner is aware of all elements of this application and permit. Separate permits must be taken out for work outlined above this agreement.
- I have read and understand the contents of this application and permit. I hereby state that the information I have supplied on this application is true and correct.
- Approval for the work under this permit will be given only after all fines and debts have been removed from job site and payment of bill of materials.
- 24 HOUR MINIMUM NOTICE REQUIRED FOR INSPECTIONS

BY W. C. Coburn
I HEREBY DECLARE THAT I AM THE LEGAL OWNER OF THE ABOVE PROPERTY OWNER

BY _____ AGENT

I hereby certify that I have reviewed this application and the proposed plans and have found that the proposed development meets the requirements of the City of Las Vegas Flood Hazard Reduction Ordinance for the issuance of this Development Permit.

LAND DEVELOPMENT AND FLOOD CONTROL ENGINEER

PLANNING DEPT

BUILDING DEPT

DATE


DATE

DATE

PLUMBING		FEE	ELECTRICAL		
WATER DISTRIBUTION	6 00		RECEPTACLE _____ SWITCH _____	40	
SEWER SYSTEM NEW OR MODIFICATION	10 00		EACH LIGHT FIXTURE OR SOCKET _____	30	
FIXTURES WATER SOFTENER H/W HEATER	2 00		SPECIAL OUTLET APPLIANCE ETC	70	
GARBAGE DISPOSAL WASHER	2 00		SERVICE/PANEL SUB/3 00 200A/6 00 400A/12 50		
FUEL PIPING	6 00		A/C UNIT OR MOTORS	3 00	
IRRIGATION SYSTEM	8 00		2310 2402 TOTAL		
MISC			MISC		
2310 2403 TOTAL			2310 2401 ISSUANCE FEE		
AIR CONDITIONING		FEE	7114 3654 SEWER CONNECTION		
NEW UNIT 3 TON = 9 00 OVER = 16 50			2310 2401 PLAN REVIEW FEE		
FURNACE TO 100 000/9 00 OVER/11 00			2310 2401 BLDG PERMIT FEE		
VAPORATIVE COOLER	6 50				
VENTILATION FAN	2 35		TOTAL FEES		
2310 2405 TOTAL					

SPECIAL CONDITIONS

AS PER CITY DESIGN

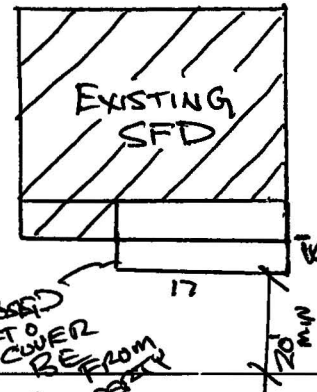

PATIO COVER
MUST BE 20' MIN FROM FRONT PROPERTY LINE

ID-OK

RECEIPT

0000
SFD 15 60
CASH 15 60
4550A000 15 58

04/18/89

PERMIT NO _____
MUST BE MACHINE VALIDATED

Permit Expires 180 Days After Abandonment of Work

CITY OF LAS VEGAS

[illegible]

FOR ADDITIONAL ASSISTANCE CALL * 386 6251
SEE REVERSE SIDE FOR INSPECTION TYPES

EFFECTIVE JULY 1 1991
PHONE PREFIX WILL BE 229