

CITY OF LAS VEGAS, NEVADA **IDOKY** PERMIT NODEPARTMENT OF BUILDING AND SAFETY
PHONE 229 6251BUILDING PERMIT
FOR Single Family Dwelling Remodel
Additions Misc Residential ConstructionPLAN CHECK NO. M-178043 DATE 1-20-93 CONST VAL \$ 1,296.00ADDRESS OF CONSTRUCTION 1109 MARION DR OWNER Joe Delgado PHONE 4380923LOT(s) 5 BLOCK 1 SUBDIVISION LAS VEGAS #1 BY LEAS HOMES ZONE R-1PROPOSED CONSTRUCTION Garage Foundation ONLY USE _____THIS PERMIT FOR ☐ BLDG ☐ A/C ☐ ELEC ☐ PLBG ☐ OTHER PERMITS REQD ☐ FENCE ☐ OFF SITE ☐ SWIM POOL ☐FLOOR AREA BSMT _____ 1ST _____ 2ND _____ GARAGE ✓ PORCH _____ TOTAL 648CONTRACTOR OWNER/Builder STATE LICENSE NO _____ CITY LICENSE NO _____

ARCHITECT _____ ENGINEER _____

MASTER PLUMBER/CONTRACTOR _____ MASTER ELECTRICIAN/CONTRACTOR _____

OTHER INSPECTIONS AND FEES


CONDITIONS OF THE PERMIT

- I agree to call the City Building Department for inspections before construction begins and before rough work is completed.
- I agree that when the job is completed that I will call for final inspection before occupancy.
- I agree to perform all construction in accordance with City Ordinances and Building Codes.
- The Contractor's signature below denotes a thorough review of the plans and that the owner is aware of all requirements of this application and permit. Separate permits must be taken out for work outlined above this agreement.
- I have read and understand the contents of this application and permit. I hereby state that the information supplied on this application is true and correct.
- Approval for the work under this permit will be given only after fees and deposits have been received from job site and public right of way.
- 24 HOUR MINIMUM NOTICE REQUIRED FOR INSPECTIONS

BY Joe Delgado OWNER

BY _____ AGENT

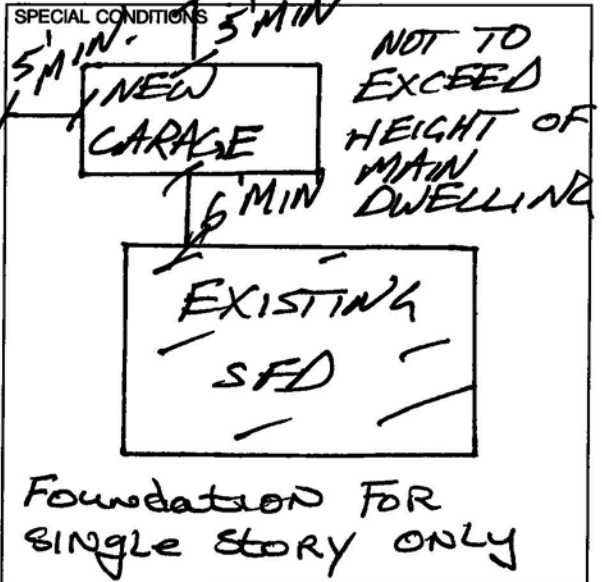
I hereby certify that I have reviewed this application and the proposed plans and have found that the proposed development meets the requirements of the City of Las Vegas Flood Hazard Reduction Ordinance for the issuance of this Development Permit

LAND DEVELOPMENT AND FLOOD CONTROL ENGINEER

DATE 4/9/93
DATE 4-26-93
BUILDING DEPT

PLUMBING		FEE
WATER DISTRIBUTION	6 70	
SEWER SYSTEM NEW OR MODIFICATION	11 05	
FIXTURES WATER SOFTENER HW HEATER	2 25	
GARBAGE DISPOSAL WASHER	2 25	
FUEL PIPING	6 70	
IRRIGATION SYSTEM	8 90	
MISC		
2310 2433	TOTAL	
AIR CONDITIONING		FEE
NEW UNIT 3 TON = 10 00 OVER = 18 20		
FURNACE TO 100 000/10 00 OVER/12 20		
VAPORATIVE COOLER	7 20	
VENTILATION FAN	2 65	
2310 2435	TOTAL	

ELECTRICAL		FEE
RECEPTACLE _____ SWITCH _____		50
EACH LIGHT FIXTURE OR SOCKET _____		40
SPECIAL OUTLET APPLIANCE ETC		80
SERVICE/PANEL SUB/3 40 200A/6 70 400A/13 85		
A/C UNIT OR MOTORS	3 40	
MISC		
2310 2432	TOTAL	04/27/93
1113 2437 ZONING		200
2310 2431 PLAN REVIEW		3100
2310 2401 BLDG PERMIT		
7143 2973 SEWER CONNECTION		
6122 3352 TORTOISE		
2897 PIF		
88100 1232 TRANSPORT		
TOTAL FEES		\$ 3300

RECEIVED 06**
MUST BE MACHINE VALIDATED
ZONE 2 00
SFD 31 00
CASH 33 00
7100A000 10 07

PERMIT NO

Permit Expires 180 Days After Abandonment of Work