

CITY OF LAS VEGAS, NEVADA

PERMIT NO.

93-172282

84

DEPARTMENT OF BUILDING AND SAFETY
PHONE 229-6251

FOR INSPECTIONS, CALL 229-2071

BUILDING PERMIT

FOR: Single Family Dwelling, Remodel
Additions, Misc. Residential Construction

PLAN CHECK NO.

DATE

CONST. VAL. \$

ADDRESS OF
CONSTRUCTION

OWNER

PHONE

LOT(s)

BLOCK

SUBDIVISION

ZONE

PROPOSED CONSTRUCTION

USE

THIS PERMIT FOR

BLDG. ☐A/C ☐ELEC. ☐PLBG. ☐OTHER PERMITS REQD.: FENCE ☐OFF
SITE ☐SWIM
POOL ☐

FLOOR AREA

BSMT

1ST

2ND

GARAGE

PORCH

TOTAL

CONTRACTOR

STATE
LICENSE NO.CITY
LICENSE NO.

ARCHITECT

ENGINEER

MASTER PLUMBER/
CONTRACTORMASTER ELECTRICIAN/
CONTRACTOR

OTHER INSPECTIONS AND FEES

1. Inspections outside of normal business hours = \$40.00 per hour (minimum charge three hours).
2. Re-inspection fee during normal business hours assessed under provisions of TABLE 3-A of the Uniform Building Code = \$40.00 per hour.
3. Inspections during normal business hours for which no fee is specifically indicated = \$40.00 per hour (minimum charge one hour).
4. Additional plan review required by changes, additions, or revisions to approved plans = \$40.00 per hour (minimum charge two hours).

CONDITIONS OF THE PERMIT:

1. I agree to call the City Building Department for inspections before concrete is poured, before rough wiring, electrical, plumbing, framing is covered. Also for air conditioning, drywall and sheathing inspection.
2. I agree that when the job is completed that I will call for final inspection before occupancy.
3. I agree to perform all construction in accordance with City Ordinances and Building Codes.
4. The Contractor's signature below denotes authority from the owner to sign in his behalf and that the owner is aware of all requirements of this application and permit. Separate permits must be taken out for work outlined above this agreement.
5. I have read and understand the contents of this application and permit; I hereby state that the information I have supplied on this application is true and correct.
6. Approval for the work under this permit will be given only after refuse and debris have been removed from job site and public right of way.
7. 24 HOUR MINIMUM NOTICE REQUIRED FOR INSPECTIONS.

BY: Franklin Sandy
I HEREBY DECLARE THAT I AM THE LEGAL OWNER OF THE ABOVE PROPERTY


OWNER

BY: _____

AGENT

I hereby certify that I have reviewed this application and the proposed plans and have found that the proposed development meets the requirements of the City of Las Vegas Flood Hazard Reduction Ordinance for the issuance of this Development Permit.

SPECIAL CONDITIONS:

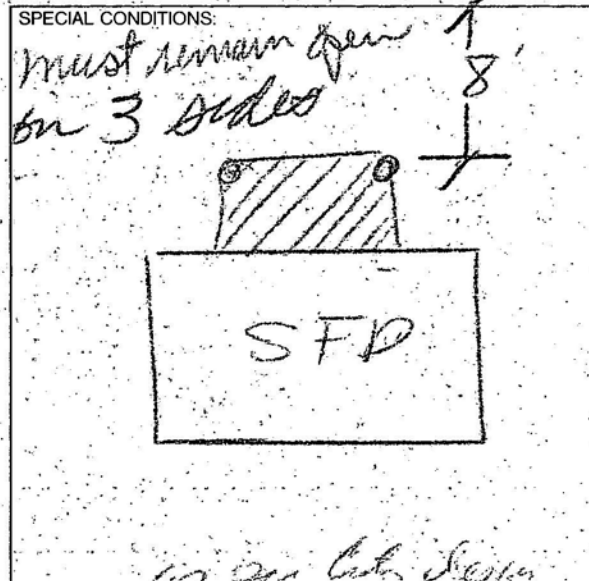

LAND DEVELOPMENT AND FLOOD CONTROL ENGINEER

DATE

PLANNING DEPT.

DATE

BUILDING DEPT.

DATE

PLUMBING		FEE
WATER DISTRIBUTION	6.70	
SEWER SYSTEM - NEW OR MODIFICATION	11.05	
FIXTURES - WATER SOFTENER, H.W. HEATER	2.25	
GARBAGE DISPOSAL - WASHER	2.25	
FUEL PIPING	6.70	
IRRIGATION SYSTEM	8.90	
MISC.		
2310 - 2433	TOTAL	
AIR CONDITIONING		FEE
NEW UNIT - 3 TON = 10.00 OVER = 18.20		
FURNACE TO 100,000/10.00 OVER/12.20		
VAPORATIVE COOLER	7.20	
VENTILATION FAN	2.65	
2310 - 2435	TOTAL	

ELECTRICAL

FEE

RECEPTACLE	SWITCH	.50
EACH LIGHT FIXTURE OR SOCKET		.40
SPECIAL OUTLET, APPLIANCE ETC.		.80
SERVICE/PANEL - SUB/3.40 - 200A/6.70 - 400A/13.85		
A.C. UNIT OR MOTORS	3.40	
MISC.		
2310 - 2432	TOTAL	
1113 - 2437 ZONING		
2310 - 2431 PLAN REVIEW		
2310 - 2401 BLDG. PERMIT		
7143 - 2973 SEWER CONNECTION		
6122 - 3352 TORTOISE		
- 2897 P.I.F.		
88100-1232 TRANSPORT		
TOTAL FEES		

RECEIPT
MUST BE MACHINE VALIDATED

ZONE 2.00
SFD 38.00
CHECK 40.00
9980A000 12:28

PERMIT NO.

Permit Expires 180 Days After Abandonment of Work