

CITY OF LAS VEGAS, NEVADA

DEPARTMENT OF BUILDING AND SAFETY
PHONE 386 6251FO
0

16233

Permit No. - 093524

DEVELOPMENT PERMIT

FOR Fence Wall Retaining Wall

LOG NO & AREA m-42 DATE 1/3/91 CONST VAL \$ 3025⁰⁰ADDRESS OF CONSTRUCTION 8351 Hammer Ln OWNER STEVE BRATTON PHONE _____CONTRACTOR Frank Lovino STATE LICENSE NO 020977 CITY LICENSE NO 024852LOT(s) 1 BLOCK _____ SUBDIVISION Files 9 1938 ZONE EE☐ CONSTRUCTION PLANS SUBMITTED BY OWNER/CONTRACTOR ☒ CONSTRUCTION DESIGN BY CITY DESIGN SHEET

ENGINEER _____

Approval for the work under this permit will be given only after refuse and debris have been removed from job site and public right of way

DESCRIPTION	TOTAL LIN FT	TOTAL SQ FT
CHAIN LINK OR WIRE MESH		
ORNAMENTAL IRON		
WOOD		
MASONRY	245	1230 ⁰⁰
RETAINING		


OTHER INSPECTIONS AND FEES

- 1 Inspections outside of normal business hours = \$30.00 per hour (minimum charge three hours)
- 2 Re inspection fee during normal business hours assessed under provisions of TABLE 3 A of the Uniform Building Code = \$30.00 each
- 3 Inspections during normal business hours for which no fee is specifically indicated = \$30.00 per hour (minimum charge one half hour)
- 4 Additional plan review required by changes additions or revisions at approved plans = \$30.00 per hour (minimum charge two hours)

CONDITIONS OF THE PERMIT

- 1 Any type of retaining wall must be engineered by a Civil or Structural Engineer
- 2 If a home owner takes out the Building Permit and if the owner sublets the work to a Contractor then the Contractor must take out the permit and pay for it
- 3 No fence or wall can be built on City property or rights of way but this is not intended to preclude construction within utility easements if utilities will not be damaged or made inaccessible
- 4 The fence or wall shall not enclose any water meter light standard or fire alarm box and shall not come closer than 24" from the nearest fire hydrant outlet
- 5 Department Inspectors must approve footings before concrete is poured and block wall reinforcing before grouting is done
- 6 Maximum height of any wall or fence is 6' side and rear yards 4' maximum in front yard with the vertical surface above the height of 2' - 50% open
- 7 I must not obstruct required onsite parking space (2 spaces for each dwelling unit) by the erection of this fence or wall
- 8 By the signing of this application I herewith agree to the requirements outlined above

FOR INSPECTIONS CALL 799 2071

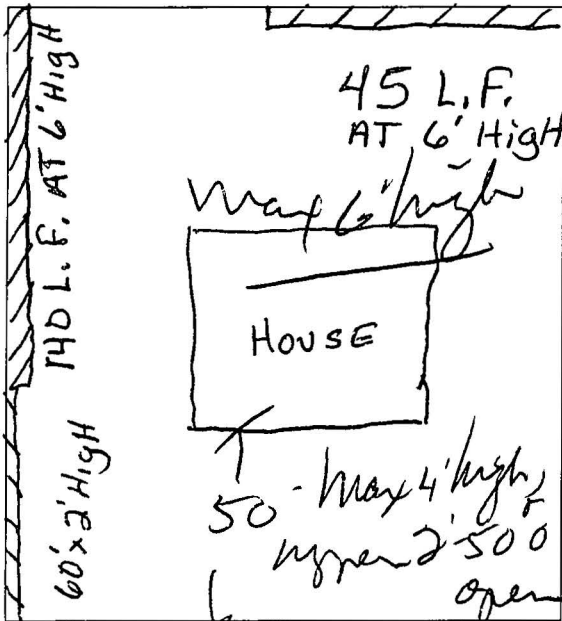

SIGNED _____ CONTRACTOR AGENT OWNER

PLANNING DEPT _____ DATE 1/3/91

I hereby certify that I have reviewed this application and the proposed plans and have found that the proposed development meets the requirements of the City of Las Vegas Flood Hazard Reduction Ordinance for the issuance of this Development Permit

LAND DEVELOPMENT AND FLOOD CONTROL ENGINEER _____ DATE 1-3-91BUILDING DEPT _____ DATE 1/3/91

Open
City Clerk
Shaw

01/03/91

RECEIPT

0002
WALL 56 00
CHECK 56 00
0901A000 14 52

PLAN
REVIEW
FEEPERMIT
FEE 56 00
2310 2401TOTAL
FEES

MUST BE MACHINE VALIDATED

PERMIT EXPIRES 180 DAYS AFTER ABANDONMENT OF WORK

CITY OF LAS VEGAS, NEVADA

PERMIT NO

91-102859

DEPARTMENT OF BUILDING AND SAFETY
PHONE 386 6251

DEVELOPMENT PERMIT

FOR Fence Wall Retaining Wall

LOG NO & AREA M-2582

DATE

CONST VAL \$ 950ADDRESS OF CONSTRUCTION 8351 Hammer Ln

OWNER

Steve PlattenPHONE 870-4460CONTRACTOR OWNERSTATE
LICENSE NOCITY
LICENSE NO

LOT(s) BLOCK SUBDIVISION

Plot SW 1/4 Sec 33 T19S R60EZONE R-E☐ CONSTRUCTION PLANS SUBMITTED BY OWNER/CONTRACTOR☒ CONSTRUCTION DESIGN BY CITY DESIGN SHEET

ENGINEER

Approval for the work under this permit will be given only after refuse
and debris have been removed from job site and public right of way


DESCRIPTION	TOTAL LIN FT	TOTAL SQ FT
CHAIN LINK OR WIRE MESH		
ORNAMENTAL IRON		
MASONRY <u>MASONRY 4'</u>	<u>23</u>	<u>92</u>
<u>6'</u>	<u>48</u>	<u>288</u>
MASONRY		
RETAINING		

OTHER INSPECTIONS AND FEES

- 1 Inspections outside of normal business hours = \$30.00 per hour (minimum charge three hours)
- 2 Re inspection fee during normal business hours assessed under provisions of TABLE 3 A of the Uniform Building Code = \$30.00 each
- 3 Inspections during normal business hours for which no fee is specifically indicated = \$30.00 per hour (minimum charge one half hour)
- 4 Additional plan review required by changes additions or revisions to approved plans = \$30.00 per hour (minimum charge two hours)

ID OK

CONDITIONS OF THE PERMIT

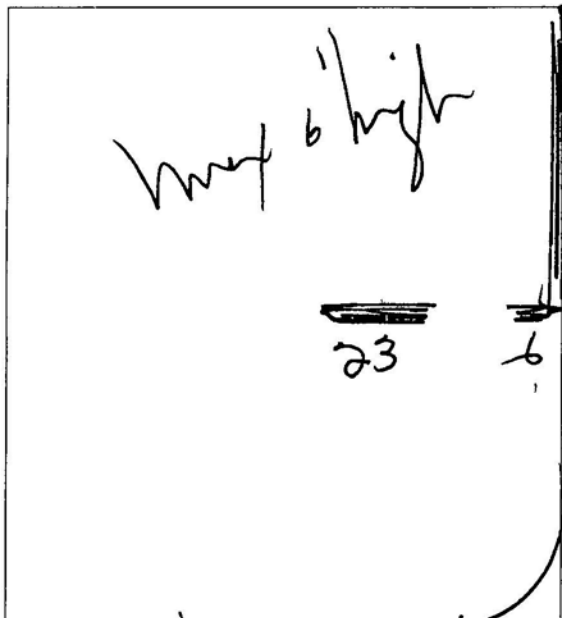

- 1 Any type of retaining wall must be engineered by a Civil or Structural Engineer
- 2 If a home owner takes out the Building Permit and if the owner sublets the work to a Contractor then the Contractor must take out the permit and pay for it
- 3 No fence or wall can be built on City property or rights of way but this is not intended to preclude construction within utility easements if utilities will not be damaged or made inaccessible
- 4 The fence or wall shall not enclose any water meter light standard or fire alarm box and shall not come closer than 24' from the nearest fire hydrant outlet
- 5 Department Inspectors must approve footings before concrete is poured and block wall reinforcing before grouting is done
- 6 Maximum height of any wall or fence is 6' side and rear yards 4' maximum in front yard with the vertical surface above the height of 2' - 50' open
- 7 I must not obstruct required onsite parking space (2 spaces for each dwelling unit) by the erection of this fence or wall
- 8 By the signing of this application I herewith agree to the requirements outlined above

FOR INSPECTIONS CALL 799 2071

Hammer
Steve Platten
SIGNED _____ CONTRACTOR AGENT OWNER

PLANNING DEPT. 4/15/91
DATE

I hereby certify that I have reviewed this application and the proposed plans and have found that the proposed development meets the requirements of the City of Las Vegas Flood Hazard Reduction Ordinance for the issuance of this Development Permit

R. B. Baskin
LAND DEVELOPMENT AND FLOOD CONTROL ENGINEER
DATE 4/12/91

Chris Hrealy
BUILDING DEPT. DATE 4/12/91

RECEIPT

0006

WALL 22 00

CHECK 22 00

2331A000 10 00

04/12/91

PLAN
REVIEW
FEEPERMIT
FEE
2310 2401TOTAL
FEES 22⁰⁰

MUST BE MACHINE VALIDATED

PERMIT EXPIRES 180 DAYS AFTER ABANDONMENT OF WORK

CITY OF LAS VEGAS, NEVADA

PERMIT NO

91-102859

64

DEPARTMENT OF BUILDING AND SAFETY
PHONE 386 6251

FOR INSPECTIONS CALL 799 2071

DEVELOPMENT PERMIT

FOR Fence Wall Retaining Wall

LOG NO & AREA M-2582 DATE 4/12/91 CONST VAL \$ 950ADDRESS OF CONSTRUCTION 8351 Hammer Ln OWNER Steve Prather PHONE 870-4460CONTRACTOR OWNER STATE LICENSE NO _____ CITY LICENSE NO _____LOT(s) _____ BLOCK _____ SUBDIVISION PT SW 1/4 Sec 33 T19S R60E ZONE R-E☐ CONSTRUCTION PLANS SUBMITTED BY OWNER/CONTRACTOR ☒ CONSTRUCTION DESIGN BY CITY DESIGN SHEET

ENGINEER _____

Approval for the work under this permit will be given only after refuse and debris have been removed from job site and public right of way

DESCRIPTION	TOTAL LIN FT	TOTAL SQ FT
CHAIN LINK OR WIRE MESH		
ORNAMENTAL IRON		
WOOD MASONRY <u>4'</u>	<u>23</u>	<u>92</u>
MASONRY <u>6</u>	<u>48</u>	<u>288</u>
RETAINING		

OTHER INSPECTIONS AND FEES


- 1 Inspect on site of normal business hours = \$30.00 per hour (minimum charge three hours)
- 2 Re inspection fee during normal business hours assessed under provisions of TABLE 3 A of the Uniform Building Code = \$30.00 each
- 3 Inspections during normal business hours for which no fee is specifically indicated = \$30.00 per hour (minimum charge one half hour)
- 4 Additional plan review required by changes additions or revisions at approved plans = \$30.00 per hour (minimum charge two hours)

ID-OK

CONDITIONS OF THE PERMIT

- 1 Any type of retaining wall must be engineered by a Civil or Structural Engineer
- 2 If a home owner takes out the Building Permit and if the owner sublets the work to a Contractor then the Contractor must take out the permit and pay for it
- 3 No fence or wall can be built on City property or rights of way but this is not intended to preclude construction within utility easements if utilities will not be damaged or made inaccessible
- 4 The fence or wall shall not enclose any water meter light standard or fire alarm box and shall not come closer than 24' from the nearest fire hydrant outlet
- 5 Department Inspectors must approve footings before concrete is poured and block wall reinforcing before grouting is done
- 6 Maximum height of any wall or fence is 6' side and rear yards 4' maximum in front yard with the vertical surface above the height of 2' - 50% open
- 7 I must not obstruct required onsite parking space (2 spaces for each dwelling unit) by the erection of this fence or wall
- 8 By the signing of this application I herewith agree to the requirements outlined above

FOR INSPECTIONS CALL 799 2071

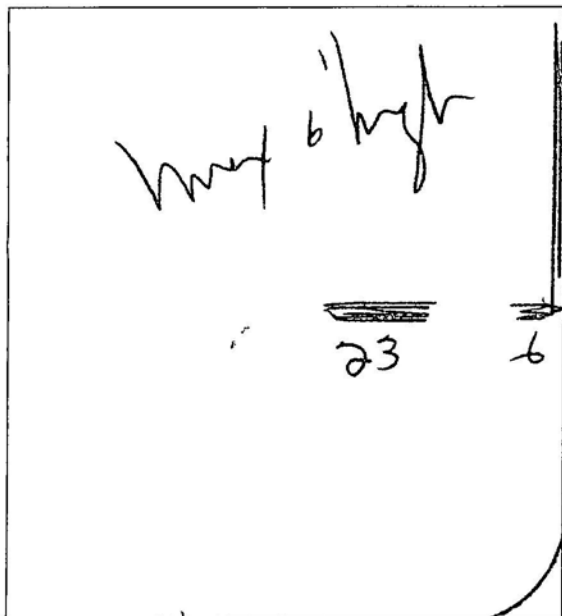

Hammer
Steve Prather
SIGNED _____ CONTRACTOR AGENT OWNER
DATE 4/15/91

PLANNING DEPT
I hereby certify that I have reviewed this application and the proposed plans and have found that the proposed development meets the requirements of the City of Las Vegas Flood Hazard Reduction Ordinance for the issuance of this Development Permit

R. B. B...
LAND DEVELOPMENT AND FLOOD CONTROL ENGINEER
DATE 4/12/91

Chris Hedy
BUILDING DEPT
DATE 4/12/91

RECEIPT

0006

WALL 22 00

CHEK 22 00

3331A000 10 09

04/13/91

PLAN
REVIEW
FEEPERMIT
FEE
2310 2401TOTAL
FEES 22⁰⁰

MUST BE MACHINE VALIDATED

PERMIT EXPIRES 180 DAYS AFTER ABANDONMENT OF WORK

DEPARTMENT OF BUILDING & SAFETY CITY OF LAS VEGAS

**PERMIT
NUMBER**

102869

**INSPECTION
NUMBER**

JOB ADDRESS

8351 Hammer

LOT NO

BLOCK NO

SUBDIVISION NAME

FIRE DEPT MAP NO

JOB PHONE

CALL IN DATE

CALL IN TIME

SCHEDULE DATE

INSPECTOR NO

INSPECTOR NAME

64

**INSPECTION
REQUESTED**

F/BLDG black wall

☐ PARTIAL
INSPECTION

☐ PARTIAL
APPROVAL (P)

PARTIAL DESCRIPTION

☒ APPROVED
(A)

☐ STOP
WORK (S)

☐ COMMENTS
(C)

☐ TEMPORARY
APPROVAL (T) — UNTIL

☐ HOLD
(H)

☐ REJECTED (R)

REINSPECTION REQUIRED CALL *799 2071

☐ REFEE (F)

REINSPECTION FEE REQUIRED PAY AT CITY HALL
3RD FLOOR 400 E STEWART STREET

☐ PERMIT
REQUIRED

**INSPECTOR
SIGNATURE**

[Signature]

INSPECTION DATE

5/13/19

☒ PROJECT
COMPLETE

BRING HARD CARD WITH FIRE QUALITY CONTROL & PLANNING APPROVALS
SIGNED OFF TO BLDG & SAFETY FOR C of O ISSUANCE (Commercial Only)

IF YOU HAVE ANY QUESTIONS ON THIS INSPECTION YOU MAY
CALL THE INSPECTOR FROM 7 00 AM 7 15 AM OR 2 45 PM 3 00 PM AT

FOR ADDITIONAL ASSISTANCE CALL *386-6251
SEE REVERSE SIDE FOR INSPECTION TYPES

*EFFECTIVE JULY 1 1991
PHONE PREFIX WILL BE 229

DEPARTMENT OF BUILDING & SAFETY CITY OF LAS VEGAS

**PERMIT
NUMBER**

102864

**INSPECTION
NUMBER**

JOB ADDRESS

8351 HAMMER

LOT NO

BLOCK NO

SUBDIVISION NAME

FIRE DEPT MAP NO

JOB PHONE

CALL IN DATE

CALL IN TIME

SCHEDULE DATE

INSPECTOR NO

INSPECTOR NAME

64

**INSPECTION
REQUESTED**

F/AIDG PLACK 11-16

☐ PARTIAL
INSPECTION

☐ PARTIAL
APPROVAL (P)

PARTIAL DESCRIPTION

☒ APPROVED
(A)

☐ STOP
WORK (S)

☐ COMMENTS
(C)

☐ TEMPORARY
APPROVAL (T) -- UNTIL

☐ HOLD
(H)

☐ REJECTED (R)

REINSPECTION REQUIRED CALL *799 2071

☐ REFEE (F)

REINSPECTION FEE REQUIRED PAY AT CITY HALL
3RD FLOOR 400 E STEWART STREET

☐ PERMIT
REQUIRED

**INSPECTOR
SIGNATURE**

[Signature]

INSPECTION DATE

5/13/91

☒ **PROJECT
COMPLETE**


BRING HARD CARD WITH FIRE QUALITY CONTROL & PLANNING APPROVALS
SIGNED OFF TO BLDG & SAFETY FOR C of O ISSUANCE (Commercial Only)

IF YOU HAVE ANY QUESTIONS ON THIS INSPECTION YOU MAY
CALL THE INSPECTOR FROM 7 00 A M 7 15 A M OR 2 45 P M 3 00 P M AT

FOR ADDITIONAL ASSISTANCE CALL *386-6251
SEE REVERSE SIDE FOR INSPECTION TYPES

* EFFECTIVE JULY 1 1991
PHONE PREFIX WILL BE 229

DEPARTMENT OF BUILDING & SAFETY CITY OF LAS VEGAS

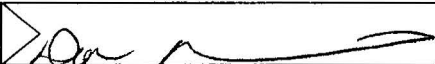JOB ADDRESS 8351 HAMMER			PERMIT NO
LOT NO	MAP NO	INSPECTOR 611	DATE
SUBDIVISION NAME			PHONE
INSPECTOR SIGNATURE 			INSPECTION DATE 4/11/91

xld PERMIT PULLED
 FOOTING POURED WITHOUT INSPECTION MUST GO TO
 APPEALS COURT TO GET FOOTING OK'
 APPEALS COURT MEETS EACH TUESDAY

☐ PARTIAL INSPECTION DESCRIPTION

☐ APPROVED
 ☒ PERMIT REQUIRED
 ☐ STOP WORK

☐ REJECTED CORRECTION NOTICE REINSPECTION REQUIRED CALL 799 2071

INSPECT	DESCRIPTION	INSPECT	DESCRIPTION	INSPECT	DESCRIPTION
☐ B 1	FOOTING LAYOUT REBAR ZONING	☐ P 1	ON SITE SEWER	☐ X 2	UNDERGROUND HYDRO
☐ B 2	STEM WALL - FORMS & REBAR	☐ P 2	ON SITE WATER	☐ X 3	UNDERGROUND FINAL/FLOW
☐ B 3	PRE SLAB	☐ P 3	BUILDING SEWER (YARD LINES)	☐ X 4	SPRINKLER SYSTEM HYDRO
☐ B 4	ROOF SHEATHING	☐ P 4	UNDERSLAB PLUMBING	☐ X 5	FIRE ALARM
☐ B 5	FRAMING	☐ P 5	TOP OUT WATER GAS WASTE	☐ X 6	OTHER
☐ B 6	INSULATION	☐ P 6	FINAL GAS TEST	☐ X 7	FINAL FIRE
☐ B 7	DRYWALL NAILING	☐ P 7	FINAL PLUMBING		
☐ B 8	EXTERIOR LATH/STUCCO			☐ E 1	UNDERGROUND ELETRICAL
☐ B 9	WALL GROUT & STEEL	☐ M 1	ROUGH VENT	☐ E 2	ROUGH ELECTRICAL
☐ B 10	POOL PRE GUNITE	☐ M 2	HOOD	☐ E 3	LOW VOLTAGE ELECTRICAL
☐ B 11	POOL PRE PLASTER / FINAL	☐ M 3	FINAL MECHANICAL	☐ E 4	SIGN INSPECTION
☐ B 12	BUILDING FINAL			☐ E 5	FINAL ELECTRICAL
☐ B 13	CERT OF OCC	☐ X 1	KICKER / FLUSH	☐ E 6	TEMP POWER

☐ FINAL INSPECTION

BRING HARD CARD WITH FIRE QUALITY CONTROL & PLANNING APPROVALS
SIGNED OFF TO BLDG & SAFETY FOR C of O ISSUANCE (Commercial Only)

FOR ASSISTANCE CALL 388-6251

DEPARTMENT OF BUILDING & SAFETY CITY OF LAS VEGAS



**PERMIT
NUMBER**

102817

**INSPECTION
NUMBER**

JOB ADDRESS

8351 Tlanner Ln

LOT NO

BLOCK NO

SUBDIVISION NAME

FIRE DEPT MAP NO

JOB PHONE

CALL IN DATE

4/15/91

CALL IN TIME

2:10 PM

SCHEDULE DATE

INSPECTOR NO

64

INSPECTOR NAME

**INSPECTION
REQUESTED**

footing

AM

HOMEOWNER POURED OWN FOOTING HE SAYS
HE PLACED 1/2" REBAR IN THE FOOTING

☐ PARTIAL
INSPECTION

☐ PARTIAL
APPROVAL (P)

PARTIAL DESCRIPTION

☒ APPROVED
(A)

☐ STOP
WORK (S)

☐ COMMENTS
(C)

☐ TEMPORARY
APPROVAL (T) -- UNTIL

☐ HOLD
(H)

☐ REJECTED (R)

REINSPECTION REQUIRED CALL 799 2071

☐ REFEE (F)

REINSPECTION FEE REQUIRED PAY AT CITY HALL
3RD FLOOR 400 E STEWART STREET

☐ PERMIT
REQUIRED

**INSPECTOR
SIGNATURE**

Don

INSPECTION DATE

4/15/91

☐ **PROJECT
COMPLETE**

BRING HARD CARD WITH FIRE QUALITY CONTROL & PLANNING APPROVALS
SIGNED OFF TO BLDG & SAFETY FOR C of O ISSUANCE (Commercial Only)

IF YOU HAVE ANY QUESTIONS ON THIS INSPECTION YOU MAY
CALL THE INSPECTOR FROM 7 00 AM 7 15 AM OR 2 45 PM 3 00 PM AT



FOR ADDITIONAL ASSISTANCE CALL 386-6251
SEE REVERSE SIDE FOR INSPECTION TYPES

DEPARTMENT OF BUILDING & SAFETY CITY OF LAS VEGAS

☐ PERMIT NUMBER		91102869		☐ INSPECTION NUMBER	
JOB ADDRESS 8351 Hammer Lane					
LOT NO		BLOCK NO		SUBDIVISION NAME	
FIRE DEPT MAP NO		JOB PHONE		CALL IN DATE 4/19/91	CALL IN TIME 8 844A
SCHEDULE DATE					
INSPECTOR NO 64		INSPECTOR NAME			
INSPECTION REQUESTED		Short / Wall			
PM					
☐ PARTIAL INSPECTION		☐ PARTIAL APPROVAL (P)		PARTIAL DESCRIPTION	
☒ APPROVED (A)		☐ STOP WORK (S)		☐ COMMENTS (C)	
☐ TEMPORARY APPROVAL (T)		☐ HOLD (H)		-- UNTIL	
☒ REJECTED (R)		REINSPECTION REQUIRED CALL 799 2071			
☐ REFEE (F)		REINSPECTION FEE REQUIRED PAY AT CITY HALL 3RD FLOOR 400 E STEWART STREET			
☐ PERMIT REQUIRED					
INSPECTOR SIGNATURE [Signature]				INSPECTION DATE 4/22/91	
☐ PROJECT COMPLETE		BRING HARD CARD WITH FIRE QUALITY CONTROL & PLANNING APPROVALS SIGNED OFF TO BLDG & SAFETY FOR C of O ISSUANCE (Commercial Only)			
IF YOU HAVE ANY QUESTIONS ON THIS INSPECTION YOU MAY CALL THE INSPECTOR FROM 7 00 A M 7 15 A M OR 2 45 P M 3 00 P M AT ▶					

FOR ADDITIONAL ASSISTANCE CALL 386 6251
SEE REVERSE SIDE FOR INSPECTION TYPES

DEPARTMENT OF BUILDING & SAFETY CITY OF LAS VEGAS

JOB ADDRESS 8357 HAMMER			PERMIT NO
LOT NO	MAP NO	INSPECTOR 64/	DATE
SUBDIVISION NAME			PHONE
INSPECTOR SIGNATURE 			INSPECTION DATE 4/11/91

NO PERMIT PULLED.
FOOTING POURED WITHOUT INSPECTION MUST GO TO
APPEALS COURT TO GET FOOTING OK'D
APPEALS COURT MEETS EACH TUESDAY.

☐ PARTIAL INSPECTION DESCRIPTION

☐ APPROVED
 ☒ PERMIT REQUIRED
 ☐ STOP WORK

☐ REJECTED CORRECTION NOTICE REINSPECTION REQUIRED CALL 799 2071

INSPECT	DESCRIPTION	INSPECT	DESCRIPTION	INSPECT	DESCRIPTION
☐ B 1	FOOTING LAYOUT REBAR ZONING	☐ P 1	ON SITE SEWER	☐ X 2	UNDERGROUND HYDRO
☐ B 2	STEM WALL - FORMS & REBAR	☐ P 2	ON SITE WATER	☐ X 3	UNDERGROUND FINAL/FLOW
☐ B 3	PRE SLAB	☐ P 3	BUILDING SEWER (YARD LINES)	☐ X 4	SPRINKLER SYSTEM HYDRO
☐ B 4	ROOF SHEATHING	☐ P 4	UNDERSLAB PLUMBING	☐ X 5	FIRE ALARM
☐ B 5	FRAMING	☐ P 5	TOP OUT WATER GAS WASTE	☐ X 6	OTHER
☐ B 6	INSULATION	☐ P 6	FINAL GAS TEST	☐ X 7	FINAL FIRE
☐ B 7	DRYWALL NAILING	☐ P 7	FINAL PLUMBING		
☐ B 8	EXTERIOR LATH/STUCCO			☐ E 1	UNDERGROUND ELECTRICAL
☐ B 9	WALL GROUT & STEEL	☐ M 1	ROUGH VENT	☐ E 2	ROUGH ELECTRICAL
☐ B 10	☐ POOL PRE GUNITE	☐ M 2	HOOD	☐ E 3	LOW VOLTAGE ELECTRICAL
☐ B 11	☐ POOL PRE PLASTER / FINAL	☐ M 3	FINAL MECHANICAL	☐ E 4	SIGN INSPECTION
☐ B 12	BUILDING FINAL			☐ E 5	FINAL ELECTRICAL
☐ B 13	CERT OF OCC	☐ X 1	KICKER / FLUSH	☐ E 6	TEMP POWER

☐ FINAL INSPECTION

BRING HARD CARD WITH FIRE QUALITY CONTROL & PLANNING APPROVALS
SIGNED OFF TO BLDG & SAFETY FOR C. of O. ISSUANCE (Commercial Only)

FOR ASSISTANCE CALL 388-8251

DEPARTMENT OF BUILDING & SAFETY CITY OF LAS VEGAS

PERMIT
NUMBER

102869

INSPECTION
NUMBER

JOB ADDRESS

8351 Hammer Ln

LOT NO

BLOCK NO

SUBDIVISION NAME

FIRE DEPT MAP NO

JOB PHONE

CALL IN DATE

4-12-91

CALL IN TIME

2-1028A

SCHEDULE DATE

INSPECTOR NO

INSPECTOR NAME

64

INSPECTION
REQUESTED

footings

AM

HOMEOWNER POURED OWN FOOTING HE SAYS
HE PLACED $\frac{1}{2}$ " REBAR IN THE FOOTING

☐ PARTIAL
INSPECTION☐ PARTIAL
APPROVAL (P)

PARTIAL DESCRIPTION

☒ APPROVED
(A)☐ STOP
WORK (S)☐ COMMENTS
(C)☐ TEMPORARY
APPROVAL (T) - UNTIL☐ HOLD
(H)☐ REJECTED (R)

REINSPECTION REQUIRED CALL 799 2071

☐ REFEE (F)REINSPECTION FEE REQUIRED PAY AT CITY HALL
3RD FLOOR 400 E STEWART STREET☐ PERMIT
REQUIREDINSPECTOR
SIGNATURE

Don

INSPECTION DATE

4/15/91

☐ PROJECT
COMPLETEBRING HARD CARD WITH FIRE QUALITY CONTROL & PLANNING APPROVALS
SIGNED OFF TO BLDG & SAFETY FOR C of O ISSUANCE (Commercial Only)IF YOU HAVE ANY QUESTIONS ON THIS INSPECTION YOU MAY
CALL THE INSPECTOR FROM 7 00 AM 7 15 AM OR 2 45 PM 3 00 PM ATFOR ADDITIONAL ASSISTANCE CALL 386 6251
SEE REVERSE SIDE FOR INSPECTION TYPES

DEPARTMENT OF BUILDING & SAFETY CITY OF LAS VEGAS



**PERMIT
NUMBER**

91102869

**INSPECTION
NUMBER**

JOB ADDRESS

8351 Hammer Lane

LOT NO

BLOCK NO

SUBDIVISION NAME

FIRE DEPT MAP NO

JOB PHONE

CALL IN DATE

4/9/91

CALL IN TIME

8 844A

SCHEDULE DATE

INSPECTOR NO

64

INSPECTOR NAME

**INSPECTION
REQUESTED**

Grout / Wall

am

☐ PARTIAL
INSPECTION

☐ PARTIAL
APPROVAL (P)

PARTIAL DESCRIPTION

☒ APPROVED
(A)

☐ STOP
WORK (S)

☐ COMMENTS
(C)

☐ TEMPORARY
APPROVAL (T) — UNTIL

☐ HOLD
(H)

☐ REJECTED (R)

REINSPECTION REQUIRED CALL 799 2071

☐ REFEE (F)

REINSPECTION FEE REQUIRED PAY AT CITY HALL
3RD FLOOR 400 E STEWART STREET

☐ PERMIT
REQUIRED

**INSPECTOR
SIGNATURE**

[Signature]

INSPECTION DATE

4/22/91

☐ **PROJECT
COMPLETE**

BRING HARD CARD WITH FIRE QUALITY CONTROL & PLANNING APPROVALS
SIGNED OFF TO BLDG & SAFETY FOR C of O ISSUANCE (Commercial Only)

IF YOU HAVE ANY QUESTIONS ON THIS INSPECTION YOU MAY
CALL THE INSPECTOR FROM 7 00 A M 7 15 A M OR 2 45 P M 3 00 P M AT

FOR ADDITIONAL ASSISTANCE CALL 386 6251
SEE REVERSE SIDE FOR INSPECTION TYPES

DEPARTMENT OF BUILDING & SAFETY CITY OF LAS VEGAS

JOB ADDRESS 8351 Hammer Ln.		PERMIT NO. 93524
LOT NO.	MAP NO. 7-204a	INSPECTOR C4
SUBDIVISION NAME		DATE 1-7-91
INSPECTOR SIGNATURE [Signature]		PHONE [Blank]
		INSPECTION DATE 1/8/91

[illegible]☐ PARTIAL INSPECTION DESCRIPTION

☒ **APPROVED**

☒ **APPROVED** ☐ **PERMIT REQUIRED**

☒ **APPROVED** ☐ **PERMIT REQUIRED** ☐ **STOP WORK**

☐ **REJECTED CORRECTION NOTICE REINSPECTION REQUIRED CALL 799 2071**


INSPECT	DESCRIPTION	INSPECT	DESCRIPTION	INSPECT	DESCRIPTION
☒ B 1	FOOTING LAYOUT REBAR ZONING	☐ P 1	ON SITE SEWER	☐ X 2	UNDERGROUND HYDRO
☐ B 2	STEM WALL -- FORMS & REBAR	☐ P 2	ON SITE WATER	☐ X 3	UNDERGROUND FINAL/FLOW
☐ B 3	PRE SLAB	☐ P 3	BUILDING SEWER (YARD LINES)	☐ X 4	SPRINKLER SYSTEM HYDRO
☐ B 4	ROOF SHEATHING	☐ P 4	UNDERSLAB PLUMBING	☐ X 5	FIRE ALARM
☐ B 5	FRAMING	☐ P 5	TOP OUT WATER GAS WASTE	☐ X-6	OTHER
☐ B 6	INSULATION	☐ P 6	FINAL GAS TEST	☐ X 7	FINAL FIRE
☐ B 7	DRYWALL NAILING	☐ P 7	FINAL PLUMBING		
☐ B 8	EXTERIOR LATH/STUCCO			☐ E 1	UNDERGROUND ELETRICAL
☐ B 9	WALL GROUT & STEEL	☐ M 1	ROUGH VENT	☐ E 2	ROUGH ELECTRICAL
☐ B 10	 PRE GUNITE	☐ M 2	HOOD	☐ E 3	LOW VOLTAGE ELECTRICAL
☐ B 11	 PRE PLASTER / FINAL	☐ M 3	FINAL MECHANICAL	☐ E 4	SIGN INSPECTION
☐ B 12	BUILDING FINAL			☐ E 5	FINAL ELECTRICAL
☐ B 13	CERT OF OCC	☐ X 1	KICKER / FLUSH	☐ E 6	TEMP POWER

☐ **FINAL INSPECTION**

BRING HARD CARD WITH FIRE QUALITY CONTROL & PLANNING APPROVALS
SIGNED OFF TO BLDG & SAFETY FOR C of O ISSUANCE (Commercial Only)

FOR ASSISTANCE CALL 386-6251

DEPARTMENT OF BUILDING & SAFETY CITY OF LAS VEGAS

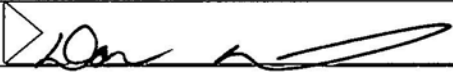JOB ADDRESS 8357 HAMMER LN		PERMIT NO 97524	
LOT NO	MAP NO	INSPECTOR 64	DATE
SUBDIVISION NAME			PHONE
INSPECTOR SIGNATURE 			INSPECTION DATE 1/22/94

☐ PARTIAL INSPECTION DESCRIPTION

☒ APPROVED		☐ PERMIT REQUIRED		☐ STOP WORK	
☐ REJECTED CORRECTION NOTICE REINSPECTION REQUIRED CALL 799 2071					

INSPECT	DESCRIPTION	INSPECT	DESCRIPTION	INSPECT	DESCRIPTION
☐ B 1	FOOTING LAYOUT REBAR ZONING	☐ P 1	ON SITE SEWER	☐ X 2	UNDERGROUND HYDRO
☐ B 2	STEM WALL - FORMS & REBAR	☐ P 2	ON SITE WATER	☐ X 3	UNDERGROUND FINAL/FLOW
☐ B 3	PRE SLAB	☐ P 3	BUILDING SEWER (YARD LINES)	☐ X 4	SPRINKLER SYSTEM HYDRO
☐ B 4	ROOF SHEATHING	☐ P 4	UNDERSLAB PLUMBING	☐ X 5	FIRE ALARM
☐ B 5	FRAMING	☐ P 5	TOP OUT WATER GAS WASTE	☐ X 6	OTHER
☐ B 6	INSULATION	☐ P 6	FINAL GAS TEST	☐ X 7	FINAL FIRE
☐ B 7	DRYWALL NAILING	☐ P 7	FINAL PLUMBING		
☐ B 8	EXTERIOR LATH/STUCCO			☐ E 1	UNDERGROUND ELETRICAL
☒ B 9	WALL GROUT & STEEL	☐ M 1	ROUGH VENT	☐ E 2	ROUGH ELECTRICAL
☐ B 10	☐ PRE GUNITE	☐ M 2	HOOD	☐ E 3	LOW VOLTAGE ELECTRICAL
☐ B 11	☐ PRE PLASTER / FINAL	☐ M 3	FINAL MECHANICAL	☐ E 4	SIGN INSPECTION
☐ B 12	BUILDING FINAL			☐ E 5	FINAL ELECTRICAL
☐ B 13	CERT OF OCC	☐ X 1	KICKER / FLUSH	☐ E 6	TEMP POWER

☐ FINAL INSPECTION	BRING HARD CARD WITH FIRE QUALITY CONTROL & PLANNING APPROVALS SIGNED OFF TO BLDG & SAFETY FOR C of O ISSUANCE (Commercial Only)
--	---

FOR ASSISTANCE CALL 386-6251

DEPARTMENT OF BUILDING & SAFETY CITY OF LAS VEGAS

JOB ADDRESS 8351 Hammer		PERMIT NO. 93524	
LOT NO	MAP NO 8-153p	INSPECTOR 64	DATE 1-24-91
SUBDIVISION NAME		PHONE 553-1602	
INSPECTOR SIGNATURE <i>[Signature]</i>		INSPECTION DATE 1/25/91	

"final" BLOCK work (Lorino M...)

☐ PARTIAL INSPECTION DESCRIPTION

☒ **APPROVED**
☐ **PERMIT REQUIRED**
☐ **STOP WORK**

☐ **REJECTED CORRECTION NOTICE REINSPECTION REQUIRED CALL 799 2071**

INSPECT	DESCRIPTION	INSPECT	DESCRIPTION	INSPECT	DESCRIPTION
☐ B 1	FOOTING LAYOUT REBAR ZONING	☐ P 1	ON SITE SEWER	☐ X 2	UNDERGROUND HYDRO
☐ B 2	STEM WALL - FORMS & REBAR	☐ P 2	ON SITE WATER	☐ X 3	UNDERGROUND FINAL/FLOW
☐ B 3	PRE SLAB	☐ P 3	BUILDING SEWER (YARD LINES)	☐ X 4	SPRINKLER SYSTEM HYDRO
☐ B 4	ROOF SHEATHING	☐ P 4	UNDERSLAB PLUMBING	☐ X 5	FIRE ALARM
☐ B 5	FRAMING	☐ P 5	TOP OUT WATER GAS WASTE	☐ X 6	OTHER
☐ B 6	INSULATION	☐ P 6	FINAL GAS TEST	☐ X 7	FINAL FIRE
☐ B 7	DRYWALL NAILING	☐ P 7	FINAL PLUMBING		
☐ B 8	EXTERIOR LATH/STUCCO			☐ E 1	UNDERGROUND ELETRICAL
☐ B 9	WALL GROUT & STEEL	☐ M 1	ROUGH VENT	☐ E 2	ROUGH ELECTRICAL
☐ B 10	<u>POOL</u> PRE GUNITE	☐ M 2	HOOD	☐ E 3	LOW VOLTAGE ELECTRICAL
☐ B 11	<u>POOL</u> PRE PLASTER / FINAL	☐ M 3	FINAL MECHANICAL	☐ E 4	SIGN INSPECTION
☒ B 12	BUILDING FINAL			☐ E 5	FINAL ELECTRICAL
☐ B 13	CERT OF OCC	☐ X 1	KICKER / FLUSH	☐ E 6	TEMP POWER

☐ **FINAL INSPECTION**

BRING HARD CARD WITH FIRE QUALITY CONTROL & PLANNING APPROVALS
SIGNED OFF TO BLDG & SAFETY FOR C of O ISSUANCE (Commercial Only)