

CITY OF LAS VEGAS, NEVADA

PERMIT NO.

DEPARTMENT OF BUILDING AND SAFETY
PHONE 386-6251

F



56529

DEVELOPMENT PERMIT
FOR: SIGNS

91-119663

LOG NO. & AREA

280-690-029.
3895 N. TENAYA WAY

DATE

9/13/91

CONST. VAL. \$

625⁰⁰ADDRESS OF
CONSTRUCTION

APP. 133' S. OF ALEXANDER

OWNER

TIE II
JAMES DEV. GROUP

PHONE

CONTRACTOR

SIGNS WEST, INC.

STATE

LICENSE NO.

30374

CITY

LICENSE NO.

CH-03485-2-

LOT(S)

BLOCK

SUBDIVISION

A PT OF NW 1/4 OF NE 1/4 OF
LIBERTY BELL MANOR

ZONE:

048886
R-3

PROPOSED CONSTRUCTION:

SEC 10 T20384 SUB-DIVISION DEVELOPMENT SIGN-DIRECTIONAL

MATERIAL FOR SIGN:

Metal ☐ Wood ☒ Plastic ☐ Other ☐

TYPE OF PROJECT:

New Sign ☒ Replacement ☐ Relocation ☐

TYPE		SIZE	HEIGHT ZONE			VALUATION	PERMIT FEE
NON-ELECTRIFIED:			A	B	C		
			Up to 30'	Over 30' up to 50'	Over 50'		
Single faced		sq. ft. @	\$5.00	\$7.00	\$9.00	\$	\$
Double faced	64	sq. ft. @	\$10.00	\$12.00	\$14.00	\$	\$
NEON OR OTHER ELECTRIFIED:							
Single faced		sq. ft. @	\$12.00	\$14.00	\$16.00	\$	\$
Double faced		sq. ft. @	\$16.00	\$18.00	\$20.00	\$	\$
FOR COMPUTER SIGNS OR SIGNS NOT INCLUDED ABOVE-USE CONST. VAL.							\$

FOR INSPECTIONS
CALL 799-2071

I hereby certify that I have examined and read the above application; that the same is true and correct; and that the work herein described is to be done in accordance with all the provisions of the applicable Ordinances of the City of Las Vegas, Nevada and the State Laws, whether herein specified or not.

SIGNED:

MASTER NEON-ELECTRIC BILLBOARD CONTRACTOR

RECEIPT

0005

SIGN 10.00

CHEK 10.00

09/16/91

1763A000 11:22

PLAN
REVIEW
FEEPERMIT
FEE
2310-2401TOTAL
FEES

PLANNING DEPT.

DATE

BUILDING DEPT.


DATE

MUST BE MACHINE VALIDATED

Permit Expires 180 Days After Abandonment of Work

N² NE⁴ SEC 10 T20S R60E

280-690

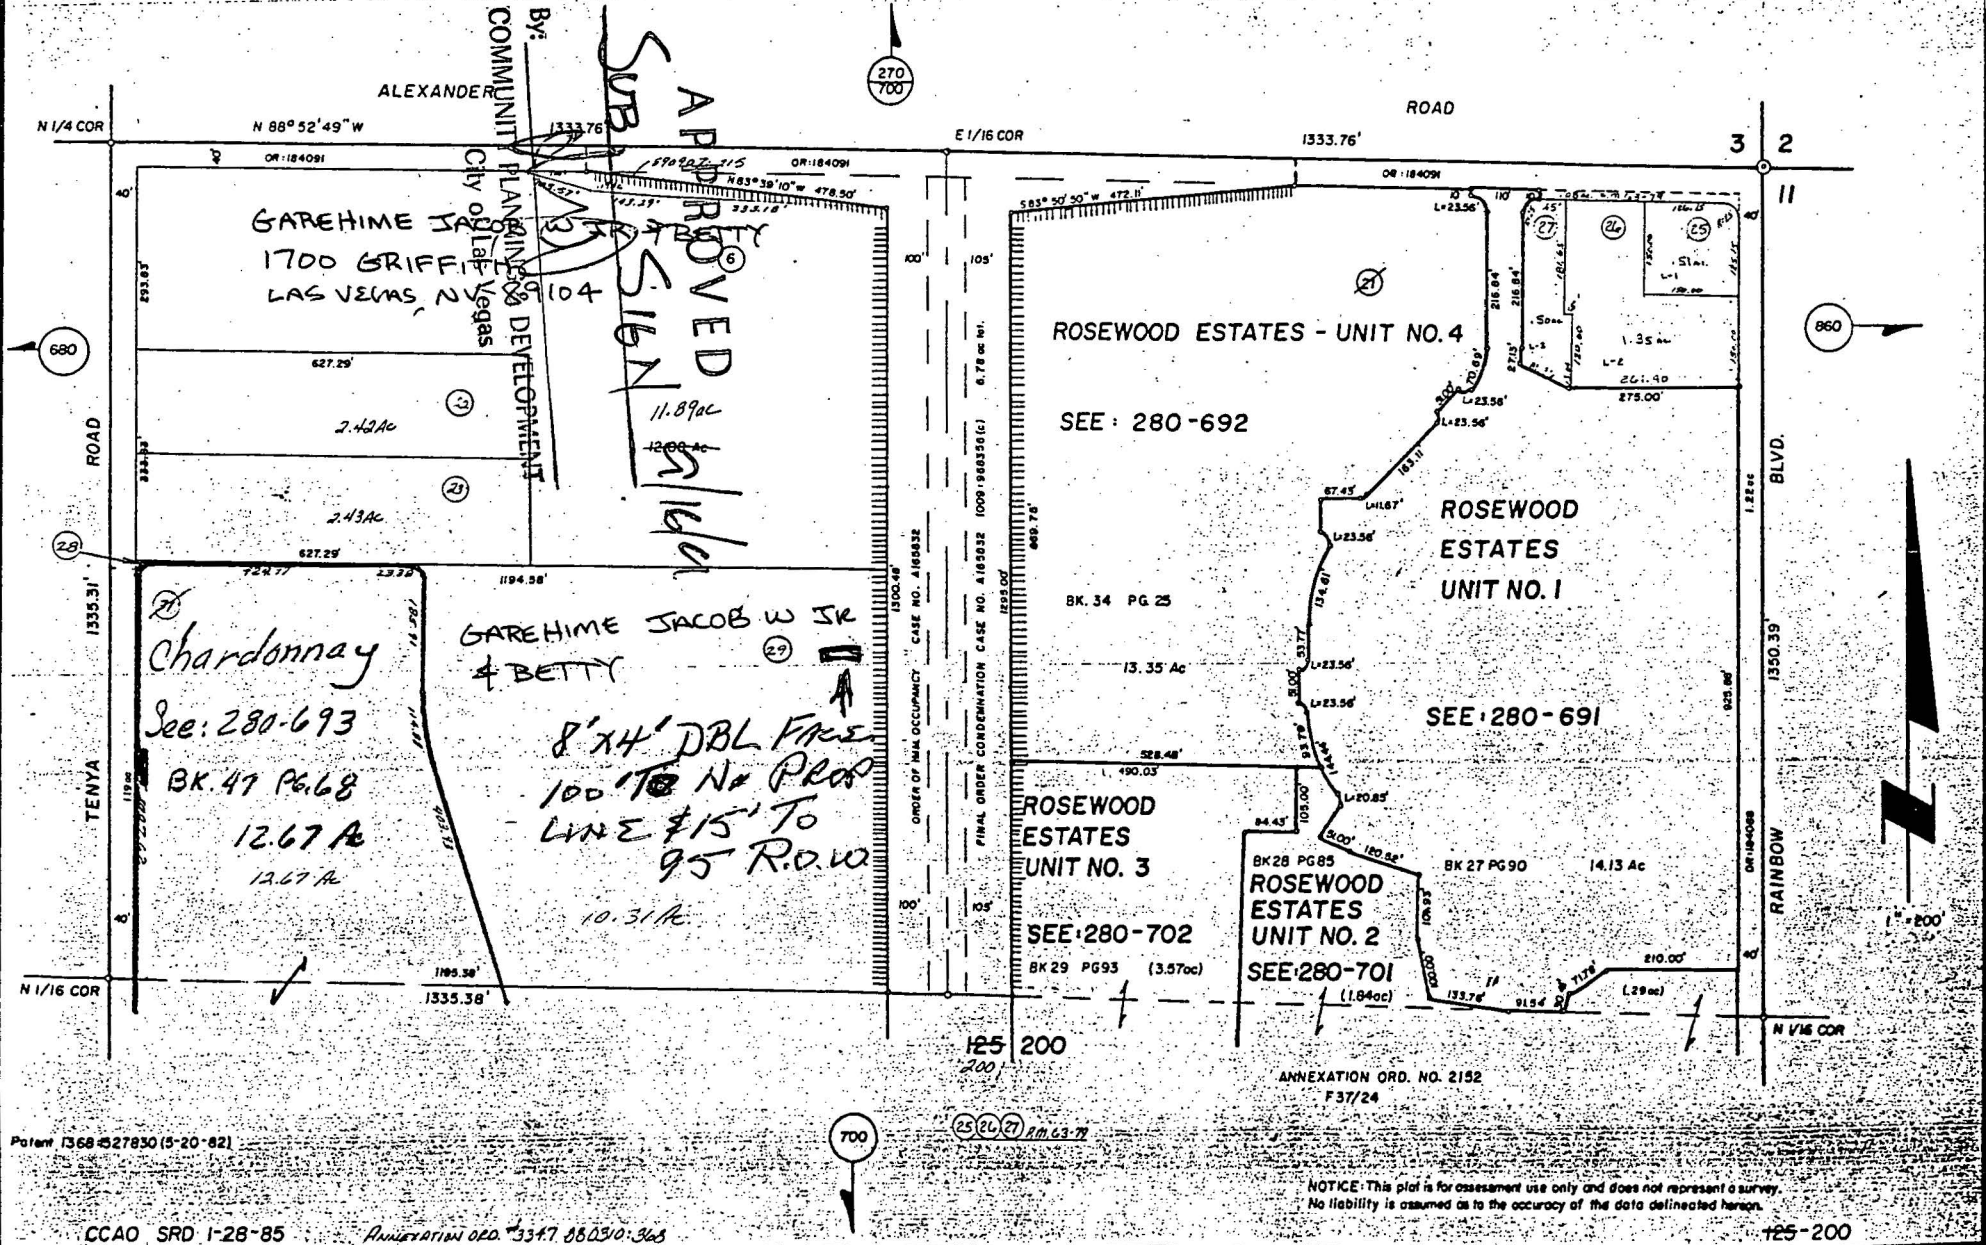

Patent 1368-527850 (5-20-82)

CCAO SRD 1-28-85

ANNEXATION ORD. 3347 880310:363

NOTICE: This plot is for assessment use only and does not represent a survey. No liability is assumed as to the accuracy of the data delineated herein.

125-200