

CITY OF LAS VEGAS, NEVADA

PERMIT NO. 9-063752

DEPARTMENT OF BUILDING AND SAFETY
PHONE 386-6251

FOR INSPECTIONS, CALL 799-2071

AIR CONDITIONING PERMIT

LOG NO. & AREA R182 DATE _____ CONST. VAL. \$ _____ADDRESS OF CONSTRUCTION 6171 Whispering Sands OWNER DAVID & BARBARA FIANN PHONE _____CONTRACTOR Ronald L. Jason A/C STATE LICENSE NO. 016943 CITY LICENSE NO. C-11-08-342

LOT(s) _____ BLOCK _____ SUBDIVISION _____ ZONE _____

PROPOSED CONSTRUCTION ~~ADDITION TO SFD~~ SFD USE _____

UNITS	DESCRIPTION	FEE	TOTAL
PERMIT ISSUANCE			
1	For the issuance of each permit	15 00	15.00
	For issuing each supplemental permit	4 50	
UNIT FEE SCHEDULE			
	For the installation or relocation of each forced-air or gravity-type furnace or burner, including ducts and vents attached to such appliance, up to and including 100,000 Btu/h.	9 00	
	For the installation or relocation of each forced-air or gravity-type furnace or burner, including ducts and vents attached to such appliance over 100,000 Btu/h.	11 00	
	For the installation or relocation of each floor furnace, including vent	9 00	
	For the installation or relocation of each suspended heater, recessed wall heater or floor-mounted unit heater	9 00	
#	For the installation, relocation or replacement of each appliance vent installed and not included in an appliance permit	4 50	4.50
	For the repair of, alteration of, or addition to each heating appliance, refrigeration unit, cooling unit, absorption unit, or each heating, cooling absorption, or evaporative cooling system, including installation of controls regulated by this code	9 00	
1	For the installation or relocation of each boiler or compressor to and including three tons, or each absorption system to and including 100,000 Btu/h	9 00	9.00
	For the installation or relocation of each boiler or compressor over three tons to and including 15 tons, or each absorption system over 100,000 Btu/h and including 500,000 Btu/h	16 50	
	For the installation or relocation of each boiler or compressor over 15 tons to and including 30 tons, or each absorption system over 500,000 Btu/h to and including 1,000,000 Btu/h.	22 50	
	For the installation or relocation of each boiler or compressor over 30 tons to and including 50 tons, or for each absorption system over 1,000,000 Btu/h to and including 1,750,000 Btu/h	33 50	
	For the installation or relocation of each boiler or refrigeration compressor over 50 tons, or each absorption system over 1,750,000 Btu/h	56.00	

Approval for the work under this permit will be given only after refuse and debris have been removed from job site and public right of way

UNITS	DESCRIPTION	FEE	TOTAL
	For each air-handling unit to and including 10,000 cubic feet per minute, including ducts attached thereto Note: This fee shall not apply to an air-handling unit which is a portion of a factory-assembled appliance, cooling unit, evaporative cooler or absorption unit for which a permit is required elsewhere in this code	6 50	
	For each air-handling unit over 10,000 cfm	11 00	
	For each evaporative cooler other than portable type	6 50	
1	For each ventilation fan. COMMERCIAL RESIDENTIAL	4 50 2 35	23.5
	For each ventilation system which is not a portion of any heating or air-conditioning system authorized by a permit	6 50	
	For the installation of each hood which is served by mechanical exhaust, including the ducts for such hood	6 50	
	For each fire damper installed in an existing system	4 50	
OTHER INSPECTIONS AND FEES:			
	Inspections outside of normal business hours (minimum charge — three hours)	25 00 per hour	
	Reinspection fee assessed under provisions of TABLE 3-A of the Uniform Building Code = \$15 00 EACH	15 00 each	
	Inspections for which no fee is specifically indicated (minimum charge — one-half hour)	30 00 per hour	
	Additional plan review required by changes, additions or revisions to approved plans (minimum charge — two hours)	30 00 per hour	
	Mechanical permit fees may be computed the same as building permit fees by using the cost of installation for valuation amount when such work is not included in the above schedule		
	Gas piping which is directly related and necessary to the repair or replacement of heating, air conditioning, or refrigeration systems not exceeding 500,000 BTU/H	6 00	

2310-2405

RECEIPT
0002

A/C 26.35

CHEK 26.35

3812A000 14:08

10/20/89

I hereby certify that I have carefully examined and read the above application, that the same is true and correct, and that the work herein described is to be done in accordance with all the provisions of the applicable Ordinances of the City of Las Vegas, Nevada and the State Laws, whether herein specified or not

SIGNED Ronald Lee Jason A/C CONTRACTOR MASTER CARD NO _____

BY [Signature] Spec Contr or Owner

BUILDING DEPT [Signature] DATE 10/20/89

PERMIT
FEE _____TOTAL
FEES 26.35

MUST BE MACHINE VALIDATED

Permit Expires 180 Days After Abandonment of Work

CITY OF LAS VEGAS, NEVADA

PERMIT NO.

DEPARTMENT OF BUILDING AND SAFETY
PHONE 386-6251

FOR INSPECTIONS, CALL 799-2071

89-023469
ELECTRICAL PERMIT

LOG NO. & AREA _____ DATE _____ CONST. VAL. \$ _____

ADDRESS OF CONSTRUCTION 6171 WHISPERING SANDS OWNER DAVID FINNCONTRACTOR ED PETERS ELEC STATE LICENSE NO C213480 CITY LICENSE NO CH278213966(PRINT NAME OF MASTER ELECTRICIAN) FRANK VAFFEE MASTER CARD NO 150 PHONE 648-9392PROPOSED CONSTRUCTION: TEMP. POWER POLE USE _____

ELECTRIC PERMIT NO. _____

Approval for the work under this permit will be given only after refuse and debris have been removed from job site and public right of way

UNITS	DESCRIPTION	FEE	TOTAL
PERMIT ISSUANCE			
<u>1</u>	For Issuing Each Permit	10 00	<u>10.00</u>
	Supplemental Fee	4 50	
APPLIANCE CHARGE			
Residential or General Commercial			
	Receptacle _____ Switch _____	.40	
	Each Light Fixture, Socket, or Exit Light, Smoke Detector or Exhaust Fan	30	
	EACH OUTLET FOR SPECIAL PURPOSE. Dishwasher, Garbage Grinder, Trash Compactor, GFI, Clothes Washer, Dryer, Electric Range, Ovens, Water Heater, Space Heater, Blast Coil Heater, (PER KW), Mercury Lamp, Quartz Lamp, Sodium Lamp, 20AMP Sign Circuit	70	
	X-Ray Unit	10 00	
	Area Lighting (First 3,000 Watts)	8 00	
	Each Additional 1,000 Watts	3 00	
MOTORS (1 H.P. AND OVER) TRANSFORMERS, ELEVATORS, WELDERS, GENERATORS, CHILLERS, SIGNS AND A/C UNITS (OVER 5 TONS)			
	First H P. or Ton For each Unit	3 00	
	First KVA For Each Unit	3 00	
	Each Additional H P., Ton or KVA up to 50	50	
	Each Additional H P., Ton or KVA over 50	35	
<u>1</u>	Temporary power or Pole	6 00	<u>6.00</u>
ELECTRIC SERVICE OR MAIN DISCONNECT			
	Up to 200 AMP	6 00	
	400 AMP And 600 AMP	12 50	
	Over 600 AMP To 1200 AMP	25 00	
	Over 1200 AMP	50 00	
	Each Additional Meter Socket	50	
	Sub Panel, Motor Control Center Disconnect Switch, Transfer Switch (Each)	3 00	
	Swimming Pool (Residential)	20 00	
	Swimming Pool (Semi-Public)	30.00	
	Spas	8 00	
	Recreational Vehicle Spaces (Each)	3 00	

UNITS	DESCRIPTION	FEE	TOTAL
	Busways-Trolley or Plug-in (Ea 100 Ft)	3 00	
	Gas Pumps, Dispensers (Each)	3 00	
	Permanent A/C Unit (5 Tons or Less)	3 00	
	Each Air Handler	1.00	
RESIDENTIAL LOW VOLTAGE INSTALLATIONS			
	Speaker Outlets (Each)	30	
	Signal or Alarm Outlets (Each)	30	
	Amplifiers	2 00	
	Control Panel	.50	
	TV Master System	30	
	Telephone or Computer Outlet	30	
OTHER INSPECTIONS AND FEES: INCLUDES ISSUANCE FEES WHEN APPLICABLE			
	Inspections outside of normal business hours (minimum charge — three hours)	30 00 per hour	
	Reinspection fee assessed under provisions of TABLE 3-A of the Uniform Building Code = \$30 00 EACH	30.00 each	
	Inspections for which no fee is specifically indicated (minimum charge — one-half hour)	30 00 per hour	
	Additional plan review required by changes, additions or revisions to approved plans (minimum charge — one-half hour). After work hours — \$30 00 per hour — minimum 1 hour	30 00 per hour	
	Starter Permit	50 00	
CONTRACT PRICE OR COST OF INSTALLATION			
	Commercial —Burglar Alarms		
	—Music Systems		
	—Data Processing		
	—Communication		
	Conduit Only—Contract Price		
	All Misc. Electric		

Electrical permit fees may be computed the same as building permit fees by using the cost of installation for valuation amount when such work is not included in the above schedule

2310-2402 05/02/89

RECEIPT

0008

ELEC 16.00

CHEK 16.00

5227A000 14:36

I hereby certify that I have carefully examined and read the above application, that the same is true and correct, and that the work herein described is to be done in accordance with all the provisions of the applicable Ordinances of the City of Las Vegas, Nevada and the State Laws, whether herein specified or not.

Ed Peters
SIGNED HOMEOWNER, CONTRACTORVS 5-2-89
BUILDING DEPT DATE

Permit Expires 180 Days After Abandonment of Work

PERMIT FEE _____

LESS STARTER PERMIT _____

TOTAL FEES 16.00PERMIT NO. _____
MUST BE MACHINE VALIDATED

CITY OF LAS VEGAS, NEVADA

PERMIT NO. 90-059501

DEPARTMENT OF BUILDING AND SAFETY
PHONE 386-6251

FOR INSPECTIONS, CALL 799-2071

BUILDING PERMIT

FOR: Single Family Dwelling, Remodel
Additions, Misc. Residential Construction

LOG NO. & AREA

M-456

DATE

MARCH 7 1990

CONST. VAL. \$

2,500.00

ADDRESS OF
CONSTRUCTION6171 WHISPERING SANDS DR. OWNER: DAVID FINN
Port SE 1/4 NE 1/4 SEC 14 T19S R60E MDBM

PHONE 646-5506

LOT(s)

BLOCK

SUBDIVISION

ZONE

R-E

PROPOSED CONSTRUCTION

16'x24' Room Addition

USE

THIS PERMIT FOR

BLDG ☒ A/C ☐ ELEC. ☐ PLBG. ☐OTHER PERMITS REQD.: FENCE ☐OFF SITE ☐ SWIM POOL ☐

FLOOR AREA

BSMT

1ST

16'x24'

2ND

GARAGE

PORCH

TOTAL 384

CONTRACTOR

HAWK CONST. CO

STATE LICENSE NO

0021934

CITY LICENSE NO

021962-03226

ARCHITECT

ENGINEER

MASTER PLUMBER/
CONTRACTORMASTER ELECTRICIAN/
CONTRACTOR

OTHER INSPECTIONS AND FEES

- 1 Inspections outside of normal business hours = \$30.00 per hour (minimum charge three hours)
- 2 Re-inspection fee during normal business hours assessed under provisions of TABLE 3-A of the Uniform Building Code = \$30.00 per hour
- 3 Inspections during normal business hours for which no fee is specifically indicated = \$30.00 per hour (minimum charge one half hour)
- 4 Additional plan review required by changes, additions, or revisions to approved plans = \$30.00 per hour (minimum charge two hours)

CONDITIONS OF THE PERMIT:

- 1 I agree to call the City Building Department for inspections before concrete is poured, before rough wiring, electrical, plumbing, framing is covered. Also for air conditioning, drywall and sheathing inspection
- 2 I agree that when the job is completed that I will call for final inspection before occupancy
- 3 I agree to perform all construction in accordance with City Ordinances and Building Codes.
- 4 The Contractor's signature below denotes authority from the owner to sign in his behalf and that the owner is aware of all requirements of this application and permit. Separate permits must be taken out for work outlined above this agreement.
- 5 I have read and understand the contents of this application and permit, I hereby state that the information I have supplied on this application is true and correct
- 6 Approval for the work under this permit will be given only after refuse and debris have been removed from job site and public right of way
7. 24 HOUR MINIMUM NOTICE REQUIRED FOR INSPECTIONS

BY

I HEREBY DECLARE THAT I AM THE LEGAL OWNER OF THE ABOVE PROPERTY

OWNER

BY

John V. Acampar

AGENT

I hereby certify that I have reviewed this application and the proposed plans and have found that the proposed development meets the requirements of the City of Las Vegas Flood Hazard Reduction Ordinance for the issuance of this Development Permit.

LAND DEVELOPMENT AND FLOOD CONTROL ENGINEER

DATE

3-8-90

PLANNING DEPT

DATE


3-8-90

BUILDING DEPT

DATE

PLUMBING		FEE	ELECTRICAL		FEES
WATER DISTRIBUTION	6 00		RECEPTACLE _____ SWITCH _____	40	03/08/90
SEWER SYSTEM - NEW OR MODIFICATION	10 00		EACH LIGHT FIXTURE OR SOCKET _____	30	
FIXTURES - WATER SOFTENER, H.W. HEATER	2 00		SPECIAL OUTLET, APPLIANCE ETC	70	
GARBAGE DISPOSAL - WASHER	2 00		SERVICE/PANEL - SUB/3 00 - 200A/6 00 - 400A/12 50		
FUEL PIPING	6 00		A.C. UNIT OR MOTORS	3 00	
IRRIGATION SYSTEM	8 00		2310 - 2432 TOTAL		
MISC.			MISC		
2310 - 2433 TOTAL			2310 - 2431 ISSUANCE FEE		
AIR CONDITIONING		FEE	7143 - 2973 SEWER CONNECTION		
NEW UNIT - 3 TON = 9 00 OVER = 16.50			2310 - 2431 PLAN REVIEW FEE		
FURNACE TO 100,000/9 00 OVER/11 00			2310 - 2431 BLDG PERMIT FEE	68.00	
VAPORATIVE COOLER	6 50		TOTAL FEES		
VENTILATION FAN	2 35				
2310 - 2435 TOTAL					

Permit Expires 180 Days After Abandonment of Work

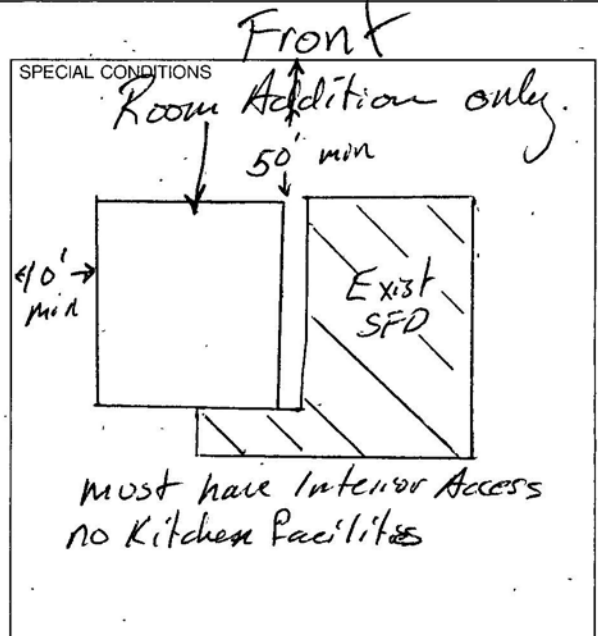

RECEIPT

***0006**

SFD 68.00

CASH 68.00

0608A000 15:59

PERMIT NO.

MUST BE MACHINE VALIDATED

CITY OF LAS VEGAS, NEVADA

PERMIT NO. 00-007727

DEPARTMENT OF BUILDING AND SAFETY
PHONE 386-6251

FOR INSPECTIONS, CALL 799-2071

BUILDING PERMIT

FOR: Single Family Dwelling, Remodel
Additions, Misc. Residential ConstructionLOG NO. & AREA 711-456 DATE 4/19/90 CONST. VAL. \$ _____ADDRESS OF CONSTRUCTION 6711 Whispering Stangs OWNER DEB Finn PHONE _____

LOT(s) _____ BLOCK _____ SUBDIVISION _____ ZONE _____

PROPOSED CONSTRUCTION 16X24 Room Addition USE _____THIS PERMIT FOR _____ BLDG. ☐ A/C ☐ ELEC. ☐ PLBG. ☐ OTHER PERMITS REQD. FENCE ☐ OFF SITE ☐ SWIM POOL ☐

FLOOR AREA BSMT _____ 1ST _____ 2ND _____ GARAGE _____ PORCH _____ TOTAL _____

CONTRACTOR owner STATE LICENSE NO. _____ CITY LICENSE NO. _____

ARCHITECT _____ ENGINEER _____

MASTER PLUMBER/
CONTRACTOR _____ MASTER ELECTRICIAN/
CONTRACTOR _____

OTHER INSPECTIONS AND FEES

- 1 Inspections outside of normal business hours = \$30.00 per hour (minimum charge three hours)
- 2 Re-inspection fee during normal business hours assessed under provisions of TABLE 3-A of the Uniform Building Code = \$30.00 per hour
- 3 Inspections during normal business hours for which no fee is specifically indicated = \$30.00 per hour (minimum charge one half hour)
- 4 Additional plan review required by changes, additions, or revisions to approved plans = \$30.00 per hour (minimum charge two hours)

CONDITIONS OF THE PERMIT:

- 1 I agree to call the City Building Department for inspections before concrete is poured, before rough wiring, electrical, plumbing, framing is covered. Also for air conditioning, drywall and sheathing inspection
- 2 I agree that when the job is completed that I will call for final inspection before occupancy
- 3 I agree to perform all construction in accordance with City Ordinances and Building Codes
- 4 The Contractor's signature below denotes authority from the owner to sign in his behalf and that the owner is aware of all requirements of this application and permit. Separate permits must be taken out for work outlined above this agreement
- 5 I have read and understand the contents of this application and permit, I hereby state that the information I have supplied on this application is true and correct
- 6 Approval for the work under this permit will be given only after refuse and debris have been removed from job site and public right of way
- 7 24 HOUR MINIMUM NOTICE REQUIRED FOR INSPECTIONS

BY [Signature]
I HEREBY DECLARE THAT I AM THE LEGAL OWNER OF THE ABOVE PROPERTY OWNERBY _____
AGENT

I hereby certify that I have reviewed this application and the proposed plans and have found that the proposed development meets the requirements of the City of Las Vegas Flood Hazard Reduction Ordinance for the issuance of this Development Permit

LAND DEVELOPMENT AND FLOOD CONTROL ENGINEER

DATE

PLANNING DEPT

DATE

BUILDING DEPT

DATE

PLUMBING		FEE	ELECTRICAL		FEE
WATER DISTRIBUTION	6.00		RECEPTACLE <u>6</u> SWITCH <u>1</u>	40	<u>240.00</u>
SEWER SYSTEM - NEW OR MODIFICATION	10.00		EACH LIGHT FIXTURE OR SOCKET <u>1</u>	30	<u>30.00</u>
FIXTURES - WATER SOFTENER, H.W. HEATER	2.00		SPECIAL OUTLET, APPLIANCE ETC.	70	
GARBAGE DISPOSAL - WASHER	2.00		SERVICE/PANEL - SUB/3 00-200A/6 00-400A/12.50		
FUEL PIPING	6.00		A.C. UNIT OR MOTORS	3.00	
IRRIGATION SYSTEM	8.00		2310 - 2432	TOTAL	<u>3.10</u>
MISC			MISC.		
2310 - 2433 TOTAL			2310 - 2431 ISSUANCE FEE		
AIR CONDITIONING		FEE	7143 - 2973 SEWER CONNECTION		
NEW UNIT - 3 TON = 9.00 OVER = 16.50			2310 - 2431 PLAN REVIEW FEE		
FURNACE TO 100,000/9.00 OVER/11.00			2310 - 2431 BLDG PERMIT FEE		
VAPORATIVE COOLER	6.50		TOTAL FEES		
VENTILATION FAN	2.35		<u>68.00</u>		
2310 - 2435 TOTAL			<u>71.10</u>		

Permit Expires 180 Days After Abandonment of Work

ID-OK

SPECIAL CONDITIONS

RECEIPT

0006

ELEC	3.10
SFD	68.00
CHEK	71.10
3190A000	14:04

PERMIT NO. _____
MUST BE MACHINE VALIDATED

CITY OF LAS VEGAS, NEVADA

PERMIT NO.

DEPARTMENT OF BUILDING AND SAFETY
PHONE 386-6251

FOR INSPECTIONS, CALL 799-2071

BUILDING PERMIT **55985**
FOR: Single Family Dwelling, Remodel,
Additions, Misc. Residential Construction

LOG NO. & AREA

R182/89

DATE

#43750

CONST. VAL. \$

576000

ADDRESS OF
CONSTRUCTION

6171 Whispering Sandals

OWNER

Barbara Fern

PHONE

LOT(s)

2

BLOCK

8

SUBDIVISION

PM-35-84

ZONE

RE

PROPOSED CONSTRUCTION

GARAGE

USE

THIS PERMIT FOR

BLDG. ☐ A/C ☐ ELEC. ☐ PLBG. ☐OTHER PERMITS REQD.: FENCE ☐OFF SITE ☐SWIM POOL ☐

FLOOR AREA

BSMT

1ST

2ND

GARAGE

576

PORCH

TOTAL

576

CONTRACTOR

owner

STATE
LICENSE NO.CITY
LICENSE NO.

ARCHITECT

ENGINEER

MASTER PLUMBER/
CONTRACTORMASTER ELECTRICIAN/
CONTRACTOR

OTHER INSPECTIONS AND FEES

- 1 Inspections outside of normal business hours = \$30.00 per hour (minimum charge three hours)
- 2 Re-inspection fee during normal business hours assessed under provisions of TABLE 3-A of the Uniform Building Code = \$30.00 per hour
- 3 Inspections during normal business hours for which no fee is specifically indicated = \$30.00 per hour (minimum charge one half hour)
- 4 Additional plan review required by changes, additions or revisions to approved plans = \$30.00 per hour (minimum charge two hours)

CONDITIONS OF THE PERMIT:

- 1 I agree to call the City Building Department for inspections before concrete is poured, before rough wiring, electrical, plumbing, framing is covered. Also for air conditioning, drywall and sheathing inspection
- 2 I agree that when the job is completed that I will call for final inspection before occupancy
- 3 I agree to perform all construction in accordance with City Ordinances and Building Codes.
- 4 The Contractor's signature below denotes authority from the owner to sign in his behalf and that the owner is aware of all requirements of this application and permit. Separate permits must be taken out for work outlined above this agreement
- 5 I have read and understand the contents of this application and permit, I hereby state that the information I have supplied on this application is true and correct
- 6 Approval for the work under this permit will be given only after refuse and debris have been removed from job site and public right of way
- 7 24 HOUR MINIMUM NOTICE REQUIRED FOR INSPECTIONS.

BY  I HEREBY DECLARE THAT I AM THE LEGAL OWNER OF THE ABOVE PROPERTY

OWNER

BY

AGENT


I hereby certify that I have reviewed this application and the proposed plans and have found that the proposed development meets the requirements of the City of Las Vegas Flood Hazard Reduction Ordinance for the issuance of this Development Permit

LAND DEVELOPMENT AND FLOOD CONTROL ENGINEER

PLANNING DEPT

BUILDING DEPT

SPECIAL CONDITIONS

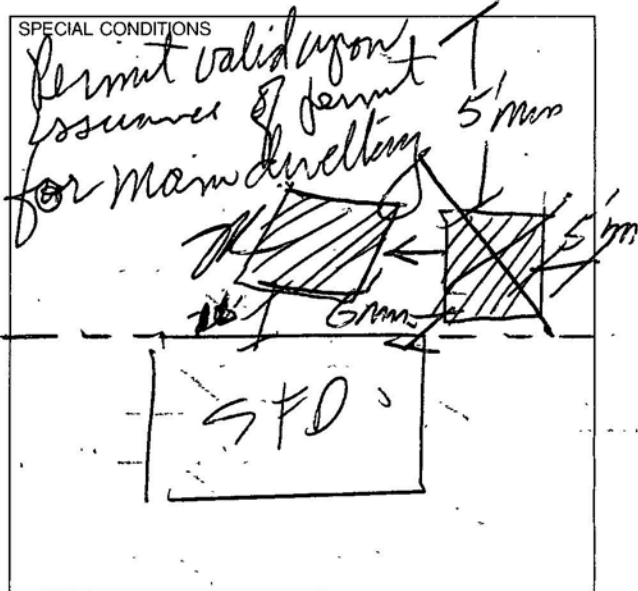

RECEIPT

0002

SFD 67.80

CHEK 67.80

8959A000 12:50

02/07/90

PLUMBING		FEE	ELECTRICAL		FEE
WATER DISTRIBUTION	6.00		RECEPTACLE _____ SWITCH _____		.40
SEWER SYSTEM - NEW OR MODIFICATION	10.00		EACH LIGHT FIXTURE OR SOCKET _____		30
FIXTURES - WATER SOFTENER, H/W HEATER	2.00		SPECIAL OUTLET, APPLIANCE ETC		.70
GARBAGE DISPOSAL - WASHER	2.00		SERVICE/PANEL - SUB/3 00 - 200A/6 00 - 400A/12 50		
FUEL PIPING	6.00		A/C UNIT OR MOTORS	3.00	
IRRIGATION SYSTEM	8.00		2310 - 2402	TOTAL	
MISC			MISC.		
2310 - 2403	TOTAL		2310 - 2401 ISSUANCE FEE		
AIR CONDITIONING		FEE	7 114 - 3654 SEWER CONNECTION		
NEW UNIT - 3 TON = 9.00 OVER = 16.50			2310 - 2401 PLAN REVIEW FEE		
FURNACE TO 100,000/9.00 OVER/11.00			2310 - 2401 BLDG. PERMIT FEE		
VAPORATIVE COOLER	6.50		TOTAL FEES		
VENTILATION FAN	2.35				
2310 - 2405	TOTAL				

Permit Expires 180 Days After Abandonment of Work

PERMIT NO.

MUST BE MACHINE VALIDATED

CITY OF LAS VEGAS, NEVADA

DEPARTMENT OF BUILDING AND SAFETY
PHONE 229-6251

PERMIT NO.

93-187159

DEVELOPMENT PERMIT
FOR: Swimming Pool or Spa

PLAN CHECK NO. M-2456 ¹⁹³ DATE 5-13-93 CONST. VAL. \$ 5000.00
 ADDRESS OF CONSTRUCTION 6171 WHISPERING SANDS OWNER DAVID FINN PHONE 259-0919
 CONTRACTOR RIVIERA POOLS & SPAS STATE LICENSE NO. 33651 CITY LICENSE NO. 4389.2.051809
 LOT(s) _____ BLOCK _____ SUBDIVISION PT SE 4 NE 4 SEC 4 T 15 R 60 E ZONE: _____
 PLUMBING CONTRACTOR RIVIERA POOLS & SPAS ELECTRICAL CONTRACTOR MOORE ELECTRIC
 CIRCLE TYPE OF POOL THAT APPLIES: (PRIVATE) SEMI-PUBLIC PUBLIC 34145-C2 SPA #052787
 MATERIALS OF CONSTRUCTION: REINFORCED GUNITE REINFORCED CONCRETE OTHER _____
 SQUARE FEET OF SURFACE POOL 400 SPA N/A VOLUME IN GALLONS 11,000

Approval for the work under this permit will be given only after refuse and debris have been removed from job site and public right of way.

I state that I am familiar with the effective ordinances of the City of Las Vegas, Nevada and the effective Statutes of the State of Nevada covering construction and use of the above type; I agree to perform said construction in conformity therewith. I further agree that issuance of a permit on the above application will not excuse me from conforming with the said Ordinances and Statutes despite any errors on the part of the building inspector or engineer in checking plans and application herewith.

All swimming pools must be fenced before the pool is filled with water. No electrical lines shall cross over a pool. Applicants must have separate plot plans showing location of power pole, proposed or existing fencing and location of swimming pool. I agree to repair any utility line, if damaged during excavation work. I have read and understand the contents of above application. I hereby state that the same are true and correct.

RIVIERA POOLS & SPAS
 SIGNED [Signature] CONTRACTOR
 BY [Signature] AGENT/OWNER
 PLANNING DEPT. [Signature] DATE 5-14-93
 BUILDING DEPT. _____ DATE _____

- Inspections outside of normal business hours = \$30.00 per hour (minimum charge three hours).
- Re-Inspection fee during normal business hours assessed under provisions of TABLE 3-A of the Uniform Building Code = \$30.00 each.
- Inspections during normal business hours for which no fee is specifically indicated = \$30.00 per hour (minimum charge one half hour).
- Additional plan review required by changes, additions or revisions to approved plans = \$30.00 per hour (minimum charge two hours) **0009**

BUILDING DEPT.		DATE		
DESCRIPTION			FEE	TOTAL
ISSUANCE FEE			10.70	15.50
SEWER CONNECTION FEE (to 30,000 GALLONS)				110.00
BUILDING PERMIT - POOL & OR SPA				69.00
PLUMBING PERMIT	PRIVATE POOL OR SPA	PREFORMED SPA	10.70	22.00
		OTHERWISE	21.40	
	PUBLIC OR SEMI-PUBLIC POOL OR SPA	PREFORMED SPA	21.40	64.00
		OTHERWISE	32.10	
	FUEL PIPING FOR POOL HEATER		6.40	
ELECTRICAL PERMIT	SPA		8.50	22.00
	SWIMMING POOL	RESIDENTIAL	21.40	
		PUBLIC-SEMI-PUBLIC		32.10
	ELECTRICAL SERVICE CHANGE		6.40	
MISC. Zoning				3.00
TOTAL FEES				247.90

SEWER 110.00
 RECEIPT
 PLBG 28.40
 ELEC 22.00
 ZONE 3.00
 CHEK 247.90
 8497A000 16:03

05/14/93

MUST BE MACHINE VALIDATED

PERMIT EXPIRES 180 DAYS AFTER ABANDONMENT OF WORK

LOG NO. & AREA

DATE

4/18/89

CONST. VAL. \$

5,272

DEPARTMENT OF BUILDING AND SAFETY

PHONE 386-6251

DEVELOPMENT PERMIT AND BUILDING PERMIT

FOR: Fence, Wall, Retaining Wall

ADDRESS OF
CONSTRUCTION

6171 Whispering Sawos Dr

OWNER

DAVID E BARRON, FIRM

PHONE

646-5546

CONTRACTOR

Owner-builder

STATE
LICENSE NOCITY
LICENSE NO.

LOT(s)

2

BLOCK

PM 44/89

SUBDIVISION

ZONE

AB

☐ CONSTRUCTION PLANS SUBMITTED BY OWNER/CONTRACTOR☒ CONSTRUCTION DESIGN BY CITY DESIGN SHEET.BUILDING
PERMIT NO

ENGINEER

Approval for the work under this permit will be given only after refuse
and debris have been removed from job site and public right of way

DESCRIPTION	TOTAL LIN FT	TOTAL SQ FT
CHAIN LINK OR WIRE MESH		
ORNAMENTAL IRON		
☒ WOOD	4 131	524
☒ MASONRY	6 327	1962
RETAINING		


OTHER INSPECTIONS AND FEES

- 1 Inspections outside of normal business hours = \$30.00 per hour (minimum charge three hours)
- 2 Re-inspection fee during normal business hours assessed under provisions of TABLE 3-A of the Uniform Building Code = \$30.00 each
- 3 Inspections during normal business hours for which no fee is specifically indicated = \$30.00 per hour (minimum charge one half hour).
- 4 Additional plan review required by changes, additions or revisions at approved plans = \$30.00 per hour (minimum charge two hours)

CONDITIONS OF THE PERMIT:

1. Any type of retaining wall must be engineered by a Civil or Structural Engineer
2. If a home owner takes out the Building Permit and if the owner sublets the work to a Contractor, then the Contractor must take out the permit and pay for it.
3. No fence or wall can be built on City property or rights-of-way, but this is not intended to preclude construction within utility easements if utilities will not be damaged or made inaccessible
4. The fence or wall shall not enclose any water meter, light standard, or fire alarm box and shall not come closer than 24" from the nearest fire hydrant outlet.
5. Department Inspectors must approve footings before concrete is poured and block wall reinforcing before grouting is done.
6. Maximum height of any wall or fence is 6', side and rear yards; 4' maximum in front yard with the vertical surface above the height of 2' - 50% open.
7. I must not obstruct required onsite parking space (2 spaces for each dwelling unit) by the erection of this fence or wall.
8. By the signing of this application I herewith agree to the requirements outlined above

FOR INSPECTIONS, CALL 799-2071

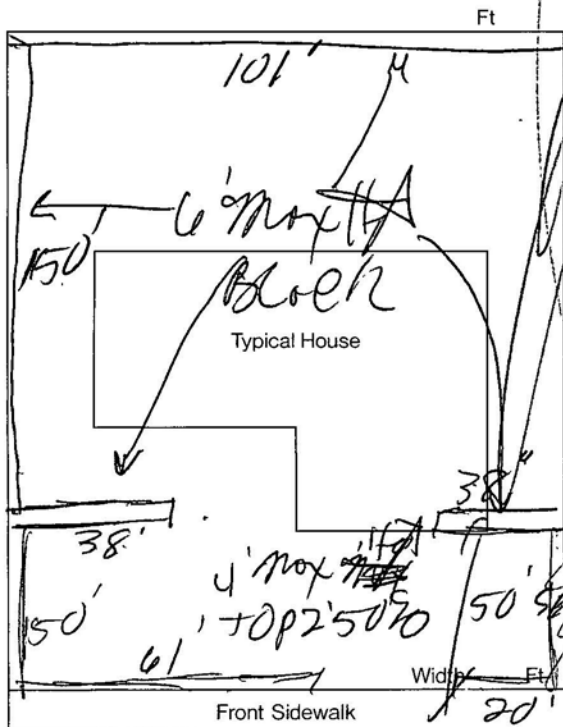

SIGNED

CONTRACTOR - AGENT - OWNER

PLANNING DEPT

DATE

I hereby certify that I have reviewed this application and the proposed plans and have found that the proposed development meets the requirements of the City of Las Vegas Flood Hazard Reduction Ordinance for the issuance of this Development Permit

PLAN
REVIEW
FEE

LAND DEVELOPMENT AND FLOOD CONTROL ENGINEER

DATE

BUILDING DEPT

DATE

PERMIT
FEE
2310-2401TOTAL
FEES

67.80

RECEIPT

0008

WALL 67.80

CASH 67.80

4514A000 13:05

CITY OF LAS VEGAS, NEVADA

PERMIT NO. 89-043750

DEPARTMENT OF BUILDING AND SAFETY
PHONE 386-6251

FOR INSPECTIONS, CALL 799-2071

BUILDING PERMIT

FOR: Single Family Dwelling, Remodel,
Additions, Misc. Residential Construction

LOG NO. & AREA R-182 DATE 8/24/89 CONST. VAL. \$ 37,400.00

ADDRESS OF CONSTRUCTION 6171 Whispering Sands Dr. OWNER BARBARA FINN PHONE 646-5506

LOT(s) 2 BLOCK 1 SUBDIVISION PM-35-84 ZONE R-E

PROPOSED CONSTRUCTION SFD USE _____

THIS PERMIT FOR _____ BLDG. ☒ A/C ☐ ELEC. ☐ PLBG. ☐ OTHER PERMITS REQD: FENCE ☐ OFF SITE ☐ SWIM POOL ☐

FLOOR AREA BSMT _____ 1ST 863 2ND 522 GARAGE _____ PORCH 192 TOTAL 1577

CONTRACTOR owner STATE LICENSE NO. _____ CITY LICENSE NO. 1577

ARCHITECT DRAFT L. FARNSWORTH ENGINEER _____

MASTER PLUMBER/CONTRACTOR _____ MASTER ELECTRICIAN/CONTRACTOR _____

OTHER INSPECTIONS AND FEES

- 1 Inspections outside of normal business hours = \$30.00 per hour (minimum charge three hours)
- 2 Re-inspection fee during normal business hours assessed under provisions of TABLE 3-A of the Uniform Building Code = \$30.00 per hour
- 3 Inspections during normal business hours for which no fee is specifically indicated = \$30.00 per hour (minimum charge one half hour)
- 4 Additional plan review required by changes, additions or revisions to approved plans = \$30.00 per hour (minimum charge two hours)

CONDITIONS OF THE PERMIT:

- 1 I agree to call the City Building Department for inspections before concrete is poured, before rough wiring, electrical, plumbing, framing is covered. Also for air conditioning, drywall and sheathing inspection.
- 2 I agree that when the job is completed that I will call for final inspection before occupancy
- 3 I agree to perform all construction in accordance with City Ordinances and Building Codes.
- 4 The Contractor's signature below denotes authority from the owner to sign in his behalf and that the owner is aware of all requirements of this application and permit. Separate permits must be taken out for work outlined above this agreement
- 5 I have read and understand the contents of this application and permit, I hereby state that the information I have supplied on this application is true and correct.
- 6 Approval for the work under this permit will be given only after refuse and debris have been removed from job site and public right of way
- 7 24 HOUR MINIMUM NOTICE REQUIRED FOR INSPECTIONS

BY [Signature]
I HEREBY DECLARE THAT I AM THE LEGAL OWNER OF THE ABOVE PROPERTY OWNER

BY _____
AGENT

I hereby certify that I have reviewed this application and the proposed plans and have found that the proposed development meets the requirements of the City of Las Vegas Flood Hazard Reduction Ordinance for the issuance of this Development Permit.


LAND DEVELOPMENT AND FLOOD CONTROL ENGINEER

PLANNING DEPT.

BUILDING DEPT.

PLUMBING		FEE	ELECTRICAL		FEE
WATER DISTRIBUTION	6.00	6.00	RECEPTACLE <u>33</u> SWITCH <u>13</u>	40	13.00
SEWER SYSTEM - NEW OR MODIFICATION	10.00	10.00	EACH LIGHT FIXTURE OR SOCKET <u>16</u>	30	4.80
FIXTURES <u>4</u> WATER SOFTENER/H.W. HEATER	2.00	10.00	SPECIAL OUTLET, APPLIANCE ETC. <u>8</u>	.70	5.60
GARBAGE DISPOSAL - WASHER	2.00	2.00	SERVICE/PANEL - SUB/3.00 (200A/6.00-400A/12.50)		6.00
FUEL PIPING	6.00		A/C UNIT OR MOTORS <u>1</u>	3.00	3.00
IRRIGATION SYSTEM	8.00		2310 - 2402	TOTAL	43.80
MISC			MISC <u>Temp pole</u>		6.00
2310 - 2403	TOTAL	28.00	2310 - 2401 ISSUANCE FEE		
AIR CONDITIONING		FEE	7114 - 3654 SEWER CONNECTION		
NEW UNIT - 3 TON = 9.00 OVER = 16.50			2310 - 2401 PLAN REVIEW FEE		
FURNACE TO 100,000/9.00 OVER/11.00			2310 - 2401 BLDG. PERMIT FEE		
VAPORATIVE COOLER	6.50		TOTAL FEES		
VENTILATION FAN	2.85				
2310 - 2403	TOTAL				

SPECIAL CONDITIONS.

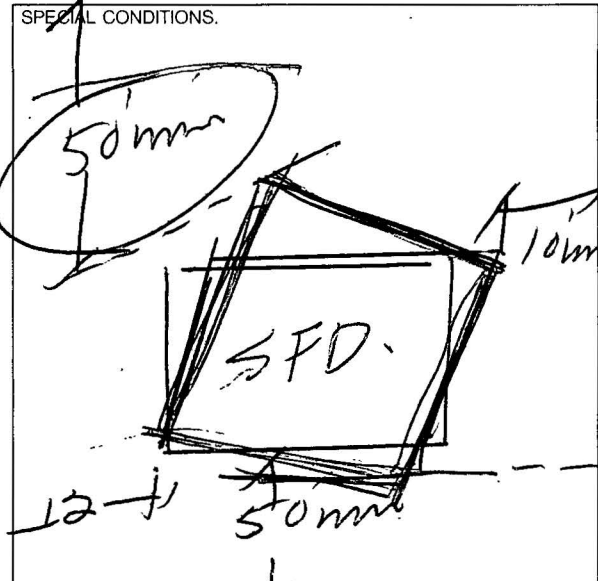

RECEIPT 02**

ELEC 43.80
PLBG 28.00
SFD 275.00
CHK 346.80
3810A000 14:06

PERMIT NO. _____
MUST BE MACHINE VALIDATED

Permit Expires 180 Days After Abandonment of Work

☐ PERMIT NUMBER 93-191913		INSPECTION NUMBER 25	
JOB ADDRESS 6171 WHISPERING SANDS DR			
LOT NO	BLOCK NO	SUBDIVISION NAME	
FIRE DEPT MAP NO 1419-38	JOB PHONE	CALL-IN DATE 06/24/93	CALL-IN TIME 14:29
INSPECTOR NO 612		INSPECTOR NAME Mosley	
INSPECTION REQUESTED LIQUID PETROLEUM GAS (517)			
LPG GATE OPEN NEXT DOOR TO 6161 645-7318			
NEED TO HAVE MOUNTED ON A SLAB OR FOOTING			
CALL BACK WHEN READY			
304/101/489			
☐ PARTIAL INSPECTION	☐ PARTIAL APPROVAL (P)	PARTIAL DESCRIPTION	
☐ APPROVED (A)	☐ STOP WORK (S)	☐ COMMENTS (C)	☐ TEMPORARY - UNTIL APPROVAL (T)
☒ REJECTED (R)			☐ HOLD (H)
☐ REFEE (F)			☐ PERMIT REQUIRED
INSPECTOR SIGNATURE [Signature]		INSPECTION DATE 6-25-93	
☐ PROJECT COMPLETE		BRING HARD CARD WITH FIRE, QUALITY CONTROL & PLANNING APPROVALS SIGNED OFF TO BLDG & SAFETY FOR C. of O. ISSUANCE (Commercial Only)	
INSPECTION TYPES			
☐ 501 UNDER/ABOVE GROUND TANK	☐ 509 FIRE ALARM SYSTEM	☐ 517 LIQUID PETROLEUM GAS	
☐ 503 HOOD SYSTEM	☐ 513 EXTINGUISHING SYSTEM	☐ 519 SUPERVISION MONITORING	
☐ 505 UNDERGROUND FINAL/FLOW	☐ 515 FIRE INVESTIGATION	☐ 539 TEMPORARY FIRE	
☐ 507 SPRINKLER SYSTEM/OVERHEAD HYDRO	☐ 516 MEDICAL GAS	☐ 540 FINAL FIRE	
		☐ 550 OTHER	

DEPARTMENT OF BUILDING & SAFETY CITY OF LAS VEGAS

☒	PERMIT NUMBER	93-187159	APPLICATION NUMBER	121908
JOB ADDRESS 6171 WHISPERING SANDS DR			INSPECTION NUMBER 21	
LOT/BLOCK		RECORDED SUBDIVISION NAME		
FIRE DEPT MAP NO. 1419-38	JOB PHONE 259-0919	CALL-IN-DATE 06/08/93	CALL-IN TIME 13:22	SCHEDULE DATE 06/09/93
INSPECTOR/NAME KEEFE BEYER - 71		MARKETING/BUSINESS NAME		
INSPECTION REQUESTED		POOL PRE-PLASTER/FINAL (910)		
GRAB RAIL COMP RAILS OKAYED BY TED B SR. INSP <i>NOT READY</i> <i>\$40. REINSPECTION FEE REQ.</i>				
☐ PARTIAL INSPECTION		☐ PARTIAL APPROVAL (P)		PARTIAL DESCRIPTION
☐ APPROVED (A)	☐ STOP WORK (S)	☐ COMMENTS (C)	☐ TEMPORARY APPROVAL (T) - UNTIL	☐ HOLD (H)
☒ REJECTED (R)	REINSPECTION REQUIRED - CALL * 229-2071			☐ PERMIT REQUIRED
☐ REFEE (F)	REINSPECTION FEE REQUIRED - PAY AT CITY HALL 3RD FLOOR - 400 E. STEWART STREET.			
INSPECTOR SIGNATURE <i>[Signature]</i>		INSPECTION DATE 9 JUNE 93		
☐ PROJECT COMPLETE		BRING HARD CARD WITH FIRE, QUALITY CONTROL & PLANNING APPROVALS SIGNED OFF TO BLDG & SAFETY FOR C of O ISSUANCE (Commercial Only)		
IF YOU HAVE ANY QUESTIONS ON THIS INSPECTION, YOU MAY CALL THE INSPECTOR FROM 7:00 A.M. - 7 15 A.M. OR 2.45 P.M. - 3.00 P.M. AT				229-6769

For Additional Assistance Call * 229-6251. See Reverse Side For Inspection Types.

DEPARTMENT OF BUILDING & SAFETY CITY OF LAS VEGAS

☒	PERMIT NUMBER	93-187159	APPLICATION NUMBER	121903
JOB ADDRESS 6171 WHISPERING SANDS DR			INSPECTION NUMBER 15	
LOT/BLOCK		RECORDED SUBDIVISION NAME		
FIRE DEPT MAP NO 1419-33	JOB PHONE 259-0919	CALL-IN-DATE 06/07/93	CALL-IN TIME 11:18	SCHEDULE DATE 06/08/93
INSPECTOR/NAME KEEFE BEYER - 71		MARKETING/BUSINESS NAME		
INSPECTION REQUESTED	POOL PRE-PLASTER/FINAL (910)			
NO DOGS PERMISSION TO ENTER YARD				
<i>NOT READY</i>				
☐ PARTIAL INSPECTION	☐ PARTIAL APPROVAL (P)	PARTIAL DESCRIPTION		
☐ APPROVED (A)	☐ STOP WORK (S)	☐ COMMENTS (C)	☐ TEMPORARY APPROVAL (T) - UNTIL	☐ HOLD (H)
☒ REJECTED (R)	REINSPECTION REQUIRED - CALL * 229-2071		☐ PERMIT REQUIRED	
☐ REFEE (F)	REINSPECTION FEE REQUIRED - PAY AT CITY HALL 3RD FLOOR - 400 E. STEWART STREET.			
INSPECTOR SIGNATURE	<i>[Signature]</i>		INSPECTION DATE 8 June 93	
☐ PROJECT COMPLETE	BRING HARD CARD WITH FIRE, QUALITY CONTROL & PLANNING APPROVALS SIGNED OFF TO BLDG & SAFETY FOR C. of O. ISSUANCE (Commercial Only)			
IF YOU HAVE ANY QUESTIONS ON THIS INSPECTION, YOU MAY CALL THE INSPECTOR FROM 7:00 A.M. - 7:15 A.M. OR 2:45 P.M. - 3:00 P.M. AT				229-6769

For Additional Assistance Call * 229-6251. See Reverse Side For Inspection Types.