

CITY OF LAS VEGAS, NEVADA

PR



122327

OPIES

ELECTRICAL PERMIT

DEPARTMENT OF BUILDING AND SAFETY: PHONE 229-6251
FOR INSPECTIONS: CALL 229-2071

PERMIT NO.

93-184785

PLAN CHECK NO.

DATE

CONST. VAL. \$

ADDRESS OF
CONSTRUCTION

OWNER

CONTRACTOR

STATE
LICENSE NO.CITY
LICENSE NO.

(PRINT NAME OF MASTER ELECTRICIAN)

MASTER CARD NO

CONTRACTOR PHONE

PROPOSED CONTRACTOR

ELECTRIC
PERMIT NO.Approval for the work under this permit will be given only after refuse
and debris have been removed from job site and public right of way

UNITS	DESCRIPTION	FEE	TOTAL
PERMIT ISSUANCE			
1	For Issuing Each Permit	15.50	15.50
	Supplemental Fee	5.20	
APPLIANCE CHARGE			
Residential or General Commercial			
50	Receptacle 30 Switch 20	50	25.00
10	Each Light Fixture, Socket, or Exit Light, Smoke Detector or Exhaust Fan	40	4.00
5	EACH OUTLET FOR SPECIAL PURPOSE: Dishwasher, Garbage Grinder, Trash Compactor, G.F.I., Clothes Washer, Dryer, Electric Range, Ovens, Water Heater, Space Heater, Blast Coil Heater, (PER K.W.), Mercury Lamp, Quartz Lamp, Sodium Lamp, 20 AMP Sign Circuit	80	4.00
	X-Ray Unit	11.05	
	Area Lighting (First 3,000 Watts)	8.60	
	Each Additional 1,000 Watts	3.40	
MOTORS (1H.P. AND OVER) TRANSFORMERS, ELEVATORS, WELDERS, GENERATORS, CHILLERS, SIGNS AND A/C UNITS (OVER 5 TONS)			
	First H.P. or Ton For Each Unit	3.40	
	First KVA For Each Unit	3.40	
	Each Additional H.P., Ton or KVA up to 50	.60	
	Each Additional H.P., Ton or KVA over 50	.45	
	Temporary Power or Pole	6.70	
ELECTRIC SERVICE OR MAIN DISCONNECT			
1	Up to 225 AMP	6.70	6.70
	400 AMP And 600 AMP	13.85	
	Over 600 AMP To 1200 AMP	27.65	
	Over 1200 AMP	55.25	
	Each Additional Meter Socket	.60	
	Sub Panel, Motor Control Center Disconnect Switch, Transfer Switch (Each)	3.40	
	Swimming Pool (Residential)	22.00	
	Swimming Pool (Semi-Public)	33.00	
	Spas	8.90	
	Recreational Vehicle Spaces (Each)	3.40	

UNITS	DESCRIPTION	FEE	TOTAL
	Busways-Trolley or Plug-in (Ea. 100 Ft.)	3.40	
	Gas Pumps, Dispensers (Each)	3.40	
1	Permanent A/C Unit (5 Tons or Less)	3.40	3.40
	Each Air Handler	1.15	
RESIDENTIAL LOW VOLTAGE INSTALLATIONS			
	Speaker Outlets (Each)	.40	
	Signal or Alarm Outlets (Each)	.40	
	Amplifiers	2.80	
	Control Panel	.60	
	TV Master System	.40	
2	Telephone or Computer Outlet	.40	.80
	Wiring	10.00	
OTHER INSPECTIONS AND FEES: INCLUDES ISSUANCE FEES WHEN APPLICABLE			
	Inspections outside of normal business hours (minimum charge — three hours)	40.00 per hour	
	Reinspection fee assessed under provisions of TABLE 3-A of the Uniform Building Code — \$40.00 EACH	40.00 each	
	Inspections for which no fee is specifically indicated (minimum charge — one hour).	40.00 per hour	
	Additional plan review required by changes, additions or revisions to approved plans (minimum charge — one hour). After work hours — \$40.00 per hour — minimum 1 hour	40.00 per hour	
	Starter Permit	52.00	
CONTRACT PRICE OR COST OF INSTALLATION			
	Commercial — Burglar Alarms		
	— Music Systems		
	— Data Processing		
	— Communication		
	Conduit Only — Contract Price		
	All Misc. Electric		

I hereby certify that I have carefully examined and read the above application; that the
same is true and correct; and that the work herein described is to be done in accordance
with all the provisions of the applicable Ordinances of the City of Las Vegas, Nevada and
the State Laws, whether herein specified or not.

SIGNED HOMEOWNER, CONTRACTOR

BUILDING DEPT

DATE

2310-2432

PERMIT
FEELESS
STARTER PERMITTOTAL
FEES

RECEIPT

Electrical permit fees may be
computed the same as building
permit fees by using the cost of
installation for valuation amount
when such work is not included in
the above schedule

Permit Expires 180 Days After Abandonment of Work

PERMIT NO.

MUST BE MACHINE VALIDATED

CITY OF LAS VEGAS, NEVADA

DEPARTMENT OF BUILDING AND SAFETY
PHONE 229-6251

PERMIT NO.



121806

71

AIR CONDITIONING PERMIT

93186751

PLAN CHECK NO. P-121-93 DATE 4-21-93 CONSTRUCTION 93-186751ADDRESS OF CONSTRUCTION 2237 Homeland St. OWNER Lewis Homes PHONE 367-6064CONTRACTOR Interstate Plumbing & Mech STATE LICENSE NO. 28743 CITY LICENSE NO. CK137833LOT(s) 88 BLOCK H SUBDIVISION The Shores 2-D Ph 6 ZONE:

PROPOSED CONSTRUCTION _____ USE: _____

UNITS	DESCRIPTION	FEE	TOTAL
PERMIT ISSUANCE			
1	For the issuance of each permit.	15.50	15.50
	For issuing each supplemental permit.	5.20	
UNIT FEE SCHEDULE			
	For the installation or relocation of each forced-air or gravity-type furnace or burner, including ducts and vents attached to such appliance, up to and including 100,000 Btu/h.	10.00	
	For the installation or relocation of each forced-air or gravity-type furnace or burner, including ducts and vents attached to such appliance over 100,000 Btu/h.	12.20	
	For the installation or relocation of each floor furnace, including vent.	10.00	
	For the installation or relocation of each suspended heater, recessed wall heater or floor-mounted unit heater.	10.00	
	For the installation, relocation or replacement of each appliance vent installed and not included in an appliance permit	5.20	
	For the repair of, alteration of, or addition to each heating appliance, refrigeration unit, cooling unit, absorption unit, or each heating, cooling absorption, or evaporative cooling system, including installation of controls regulated by this code.	10.00	
	For the installation or relocation of each boiler or compressor to and including three tons, or each absorption system to and including 100,000 Btu/h.	10.00	
1	For the installation or relocation of each boiler or compressor over three tons to and including 15 tons, or each absorption system over 100,000 Btu/h and including 500,000 Btu/h	18.20	18.20
	For the installation or relocation of each boiler or compressor over 15 tons to and including 30 tons, or each absorption system over 500,000 Btu/h to and including 1,000,000 Btu/h	24.95	
	For the installation or relocation of each boiler or compressor over 30 tons to and including 50 tons, or for each absorption system over 1,000,000 Btu/h to and including 1,750,000 Btu/h	37.00	
	For the installation or relocation of each boiler or refrigeration compressor over 50 tons, or each absorption system over 1,750,000 Btu/h.	61.90	

Approval for the work under this permit will be given only after refuse and debris have been removed from job site and public right of way.

UNITS	DESCRIPTION	FEE	TOTAL
	For each air-handling unit to and including 10,000 cubic feet per minute, including ducts attached thereto. Note: This fee shall not apply to an air-handling unit which is a portion of a factory-assembled appliance, cooling unit, evaporative cooler or absorption unit for which a permit is required elsewhere in this code.	7.20	
	For each air-handling unit over 10,000 cfm.	12.20	
	For each evaporative cooler other than portable type.	7.20	
	For each ventilation fan.	COMMERCIAL 5.20 RESIDENTIAL 2.65	
	For each ventilation system which is not a portion of any heating or air-conditioning system authorized by a permit.	7.20	
	For the installation of each hood which is served by mechanical exhaust, including the ducts for such hood.	7.20	
	For each fire damper installed in an existing system.	5.20	
OTHER INSPECTIONS AND FEES:			
	Inspections outside of normal business hours (minimum charge — three hours.)	40.00 per hour	
	Reinspection fee assessed under provisions of TABLE 3-A of the Uniform Building Code	40.00 each	
	Inspections for which no fee is specifically indicated (minimum charge — one hour)	40.00 per hour	
	Additional plan review required by changes, additions or revisions to approved plans (minimum charge — two hours)	40.00 per hour	
	Mechanical permit fees may be computed the same as building permit fees by using the cost of installation for valuation amount when such work is not included in the above schedule.		
	Gas piping which is directly related and necessary to the repair or replacement of heating, air conditioning, or refrigeration systems not exceeding 500,000 BTU/h.	7.20	

2310-2435

5/13/93
9/9/93

RECEIPT

I hereby certify that I have carefully examined and read the above application; that the same is true and correct; and that the work herein described is to be done in accordance with all the provisions of the applicable Ordinances of the City of Las Vegas, Nevada and the State Laws, whether herein specified or not.

SIGNED [Signature] CONTRACTOR MASTER CARD NO.
BY Interstate Plumbing & Mech Spec Cont'r or Owner
KRJ 15/12/93 BUILDING DEPT DATE

PERMIT
FEETOTAL
FEES 33.70

PERMIT EXPIRES 180 DAYS AFTER ABANDONMENT OF WORK

MUST BE MACHINE VALIDATED

169

CITY OF LAS VEGAS, NEVADA

PERMIT NO. 93-180922

DEPARTMENT OF BUILDING AND SAFETY
PHONE 229-6251

FEE



117754

PLUMBING PERMIT

93180922

LOG NO. & AREA P-121-93

DATE

CONST. VAL. \$

ADDRESS OF CONSTRUCTION 2237 Homeland Street

OWNER Lewis Homes

PHONE 871-4737

CONTRACTOR CDM PLUMBING

STATE LICENSE NO. 0022392

CITY C11-01835-2-028475
LICENSE NO.

LOT(s) 88 BLOCK H SUBDIVISION The Shores 2-D Phase 4

ZONE:

PROPOSED CONSTRUCTION:

USE:

PLUMBING
PERMIT NO.Approval for the work under this permit will be given only after refuse
and debris have been removed from job site and public right of way

UNITS	DESCRIPTION	FEE	TOTAL
PERMIT ISSUANCE			
1	For Issuing Each Permit	15.50	15.50
	For Issuing Each Supplemental Permit	5.20	
FIXTURE CHARGE			
9	Bathtub, Shower, Lavatory, Toilet, Urinal	EA. 2.25	20.25
2	Floor Drain, Floor Sink, Wash Tray, Sink	EA. 2.25	4.50
3	Garbage Disposal, Clothes Washer, Dishwasher (residential)	EA. 2.25	6.75
	Garbage Disposal (commercial)	EA. 8.90	
	Clothes Washer, Dishwasher (commercial)	EA. 2.25	
	Clothes Dryer (gas) (venting)	2.25	
	Dental Unit	8.90	
	Drinking Fountain	2.25	
1	Refrigerator - Ice Maker, Water Dispenser	2.25	2.25
	Any other water using equipment, Attached Coffee Makers, Ice Makers	EA. 2.25	
1	Hot Water Heater (Gas or Electric)	2.25	2.25
SEWER SYSTEM			
1	New, Replacement, Modification, or Any Drainage Work	11.05	11.05
	Grease or Sand Trap or Interceptor	2.25	
	Trailer Trap (rental parks)	5.50	
WATER SOFTENERS			
	Non Permanent Type (rental)	2.25	
	Permanent Type (connected to drain)	2.25	
WATER DISTRIBUTION SYSTEM			
1	Single Family Dwelling	6.70	6.70
	Multi-Family Dwelling	6.70	
	Plus Each Dwelling Unit	3.40	
	Commercial Building per floor	3.40	
	Plus Each Unit (leased space or office)	2.25	
	Hotel or Motel	8.90	
	Plus Each Unit	3.40	
	Trailer Park	33.00	
	Plus Each Space	2.25	
	Irrigation Single Family Dwelling	8.90	
	Irrigation Commercial Fee Based on Building Code Valuation Chart		
	Construction Valuation		

UNITS	DESCRIPTION	FEE	TOTAL
FUEL PIPING SYSTEM			
1	Single Family Dwelling	6.70	6.70
	Multi-Family Dwelling	11.05	
	Plus Each Unit	2.25	
	Commercial Building (per floor)	6.70	
	Plus Each Unit (leased space or office)	6.70	
	Medium Pressure System (Plan Check)	13.30	
5	Each Gas Appliance (Any Type)	2.25	11.25
	Steam Boilers	5.80	
SOLAR ENERGY SYSTEMS			
	Collectors (including piping) (per collector)	5.80	
	Storage Tanks (each)	5.80	
PIPELINE CONTRACT			
	For Onsite Sewer, Gas or Water Contract Value. Fee based on Building Code Permit Valuation Chart		
OTHER INSPECTION AND FEES:			
	Inspections outside of normal business hours (minimum charge—three hours)	40.00 per hour	
	Under provisions of Table 3-A of the Uniform Building Code, work which has been inspected once and not approved may be subject to a Reinspection Fee not less than \$40.00 per each inspection during business hours.	40.00 each	
	Additional plan review required by changes. Additions to or revisions to approved plans (minimum charge two hours)	40.00 per hour	
	Plumbing permit fees may be computed the same as building permit fees by using the cost of installation for valuation amount when such work is not included in the above schedule		
	Construction Valuation		

FOR INSPECTIONS
CALL 229-2071SEWER #7114-3654
CONNECTION

RECEIPT

FIXTURES X

FEE

2310-2403
PERMIT
FEETOTAL \$87.20
FEES

PERMIT NO.

I hereby certify that I have carefully examined and read the above application; that the same is true and correct; and that the work herein described is to be done in accordance with all the provisions of the applicable Ordinances of the City of Las Vegas, Nevada and the State Laws, whether specified or not.

Michael H. Jettin

SIGNED

CONTRACTOR

MASTER CARD NO. 138

BY

Registered Master Plumber Spec. Contr. or Owner

BUILDING DEPT

DATE

Permit Expires 180 Days After Abandonment of Work

MUST BE MACHINE VALIDATED

CITY OF LAS VEGAS, NEVADA

PERMIT NO.

93-174777

DEPARTMENT OF BUILDING AND SAFETY
PHONE 229-6251

BUILDING PERMIT

FOR: Single Family Dwelling, Remodel
Additions, Misc. Residential Construction

PLAN CHECK NO. P-121-93

CONST. VAL. \$ 45,600

ADDRESS OF CONSTRUCTION 2237 Homeland Street

OWNER Lewis Homes of Nevada

PHONE 736-8960

LOT(s) 88 BLOCK H SUBDIVISION

Shores No. 2 Phase 2-D-6

ZONE

PROPOSED CONSTRUCTION Single Family Residence

USE Dwelling

THIS PERMIT FOR BLDG. ☒ A/C ☐ ELEC. ☐ PLBG. ☐OTHER PERMITS REQD. FENCE ☐OFF SITE ☐SWIM POOL ☐

FLOOR AREA BSMT N/A 1ST 1532 2ND —

GARAGE 441

PORCH 41

TOTAL 2014

CONTRACTOR Lewis Homes of Nevada

STATE LICENSE NO. 14761

CITY LICENSE NO. 8707

ARCHITECT Lewis Homes of Nevada

ENGINEER G. C. Wallace

MASTER PLUMBER/
CONTRACTORMASTER ELECTRICIAN/
CONTRACTOR

OTHER INSPECTIONS AND FEES

- 1 Inspections outside of normal business hours = \$30.00 per hour (minimum charge three hours)
- 2 Re-inspection fee during normal business hours assessed under provisions of TABLE 3-A of the Uniform Building Code = \$30.00 per hour.
- 3 Inspections during normal business hours for which no fee is specifically indicated = \$30.00 per hour (minimum charge one half hour)
- 4 Additional plan review required by changes, additions, or revisions to approved plans = \$30.00 per hour (minimum charge two hours)

CONDITIONS OF THE PERMIT:

- 1 I agree to call the City Building Department for inspections before concrete is poured, before rough wiring, electrical, plumbing, framing is covered. Also for air conditioning, drywall and sheathing inspection.
- 2 I agree that when the job is completed that I will call for final inspection before occupancy
- 3 I agree to perform all construction in accordance with City Ordinances and Building Codes.
- 4 The Contractor's signature below denotes authority from the owner to sign in his behalf and that the owner is aware of all requirements of this application and permit. Separate permits must be taken out for work outlined above this agreement
- 5 I have read and understand the contents of this application and permit; I hereby state that the information I have supplied on this application is true and correct
- 6 Approval for the work under this permit will be given only after refuse and debris have been removed from job site and public right of way
7. 24 HOUR MINIMUM NOTICE REQUIRED FOR INSPECTIONS.

BY I HEREBY DECLARE THAT I AM THE LEGAL OWNER OF THE ABOVE PROPERTY

OWNER

BY: Sandy Norskog
Sandy Norskog - Project Coordinator

AGENT

I hereby certify that I have reviewed this application and the proposed plans and have found that the proposed development meets the requirements of the City of Las Vegas Flood Hazard Reduction Ordinance for the issuance of this Development Permit.

LAND DEVELOPMENT AND FLOOD CONTROL ENGINEER DATE 1/21/93

PLANNING DEPT DATE 1/25/93

BUILDING DEPT DATE 1/20/93

PLUMBING		FEE
WATER DISTRIBUTION	6.00	
SEWER SYSTEM - NEW OR MODIFICATION	10.00	
FIXTURES - WATER SOFTENER, H/W HEATER	2.00	
GARBAGE DISPOSAL - WASHER	2.00	
FUEL PIPING	6.00	
IRRIGATION SYSTEM	8.00	
MISC		
2310 - 2433	TOTAL	
AIR CONDITIONING		FEE
NEW UNIT - 3 TON = 9.00 OVER = 16.50		
FURNACE TO 100,000/9.00 OVER/11.00		
VAPORATIVE COOLER	6.95	
VENTILATION FAN	2.55	
2310 - 2435	TOTAL	

ELECTRICAL		FEE
RECEPTACLE _____ SWITCH _____		.45
EACH LIGHT FIXTURE OR SOCKET _____		.35
SPECIAL OUTLET, APPLIANCE ETC		.75
SERVICE/PANEL - SUB/3.25 - 200A/6 45 - 400A/13 40		
A C UNIT OR MOTORS	3.25	
2310 - 2432	TOTAL	
MISC		

1113-2437 Zoning	17.00
2310 - 2431 PLAN REVIEW	10.00
2310 - 2401 BLDG PERMIT	340.00
7143 - 2973 SEWER CONNECTION	1100.00
6122 - 3352 TORTOISE	
_____ - 2897 P.I.F.	
88100-1232 TRANSPORT	500.00
TOTAL FEES	1967.00

SPECIAL CONDITIONS.

Plan #: 6-169-H


SEE PLOT PLAN

RECEIPT
MUST BE MACHINE VALIDATED

PERMIT NO.

Permit Expires 180 Days After Abandonment of Work

112390

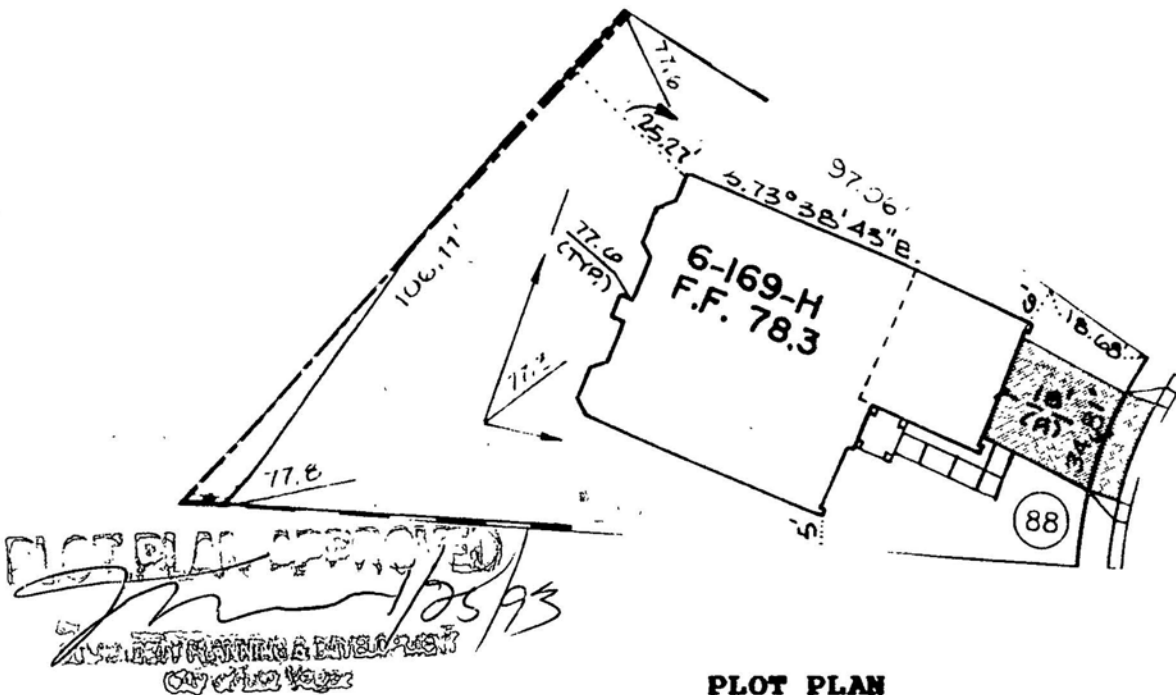

PLOT PLAN

LEWIS HOMES OF NEVADA


SUBDIVISION Shore No. 2 PHASE: 2-D-6
Lot: 88 Address: 2237 Homeland Street
Refer to plot plan for model number.

2237 HOMEAND ST.

SHEET 1 of 2

112390

QUAN	TYPE	SPAN	P1-H1	OVERHANGS	JOB	MARK
20	SCI2	400000	6	800 - 800	*B1016* LEWIS HOMES PL 169	E

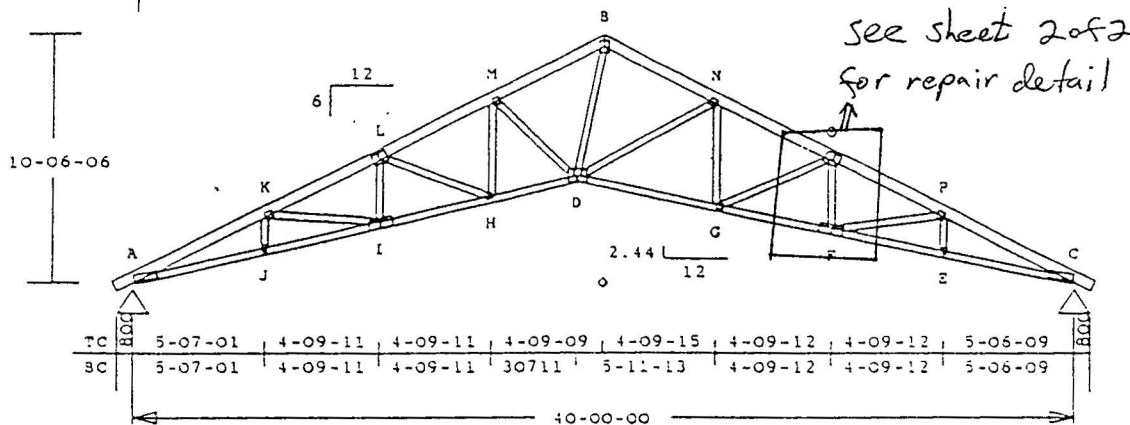

TRUSSTAR2 -- VERSION 33.0
RUN DATE: 11-11-91

CSI SIZE LUMBER 1.15FB
TOP .51 2X 6 1650F1.5 1900
BTM .88 2X 4 1650F1.5 1900
WBS .89 2X 4 STNBTRHF 546
EXCEPTIONS:
D-B 2X 4 1650F1.5 1900
LUMBER STRESS INCREASE: 25.0%
REPETITIVE MEMBER STRESS USED.

LATERAL BRACING:
TOP CHORD - CONTINUOUS
BTM CHORD - CONTINUOUS
TRUSS SPACING - 24.0 IN.

LOADING LIVE DEAD (PSF)
TOP CHD 16.0 14.0
BTM CHD .0 10.0
TOTAL 16.0 24.0 40.0

SUPPORT CRITERIA
JT REACT WIDTH JT REACT WIDTH
LBS IN-SX LBS IN-SX
A 1576 3- 8 C 1576 3- 8

LEFT RIGHT
HEEL 0IN - 4SX 0IN - 4SX

MEMBER FORCES (LBS)

TOP CHORDS
A-K = 5635 C K-L = 4863 C
L-M = 4077 C M-B = 3452 C
B-N = 2874 C N-O = 3737 C
O-P = 4457 C P-C = 5163 C
BOTTOM CHORDS
A-J = 5170 T J-I = 5170 T
I-H = 4462 T H-D = 3742 T
D-G = 3411 T G-F = 4069 T
F-E = 4714 T E-C = 4714 T
WEBS
J-K = 102 T K-I = 693 C
I-L = 314 T L-H = 747 C
H-M = 497 T M-D = 754 C
D-B = 2592 T D-N = 880 C
G-N = 519 T G-O = 702 C
F-O = 312 T F-P = 639 C
E-P = 101 T

DL-LL DEFL = .92" IN D-G
LL DEFL = .36" S/360
DL-LL HORZ = .67" AT C
S/DL-LL DEFL=523 S/DEPTH= 4.0

PLATING CONFORMS TO UBC.
(ICBO 1591, BOCA 30-88,
DILHR 370040-N)
PLATE VALUES MAY BE
VERIFIED WITH:
MYTECH ENG. INC.
GRIP VALUES BASED ON SPF
& DF LUMBER USING GROSS
AREA TEST METHOD.
PLATES - 20 GAUGE M20
GRIPPING 373-273 PSI PER PAIR
INCLUDES 25.0% INCREASE
TENSION 910- 565 PLI PER PAIR
SHEAR 885- 431 PLI PER PAIR

JT TYPE	PLATE	SIZE	X	Y
A	2102	4.00 X 12.00	9.1	2.8
B	3006	5.00 X 6.00	CTR	CTR
C	2102	4.00 X 12.00	8.5	2.7
E	1001	2.00 X 4.00	CTR	CTR
G	1050	3.00 X 4.00	CTR	CTR
H	1050	3.00 X 4.00	CTR	CTR
J	1001	2.00 X 4.00	CTR	CTR
K	1050	4.00 X 4.00	CTR	CTR
L	1150	6.00 X 8.00	CTR	4.0
M	1050	4.00 X 4.00	CTR	CTR
N	1050	4.00 X 4.00	CTR	CTR
O	1150	6.00 X 8.00	CTR	4.0
P	1050	4.00 X 4.00	CTR	CTR

PLATES - 16 GAUGE M16
GRIPPING 317-287 PSI PER PAIR
INCLUDES 25.0% INCREASE
TENSION 1624- 943 PLI PER PAIR
SHEAR 1328- 738 PLI PER PAIR

JT TYPE	PLATE	SIZE	X	Y
D	6071	7.00 X 10.00	CTR	3.2
F	1150	5.00 X 12.50	CTR	3.0
I	1150	5.00 X 12.50	CTR	3.2

NOTES:

1. TRUSSES MANUFACTURED BY - PHELPS & SONS INC.
2. CONFORMS TO TPI-85.
3. BUILDING DESIGNER IS RESPONSIBLE FOR ADEQUATE DESIGN OF TRUSS TO BRG PLATE CONNECTION WHICH ALLOWS .67 INCHES OF HORZ. MOVEMENT AT JOINT C
4. ANCHOR TRUSS FOR A TOTAL HORIZONTAL LOAD OF 316 LBS.


Job V.G. - KLA VISTA
Plan 169
Elev. ALL
Span 40'0" - E



GENERAL
BUILDING
SYSTEMS

4630 WEST RUSSELL ROAD
LAS VEGAS, NEVADA 89118
PHONE 702-222-0850
FAX 702-222-0851

APPROVED

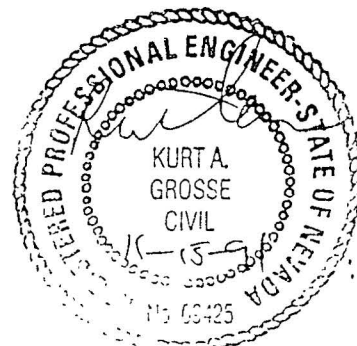DATE 18-NOV-91


112390

JOB: Repair Detail For General Building Systems, Inc.Job: Lewis Homes Pl. 169 Truss ID: E

Sheet 2 of 2

Problem: Web O-F is damaged as shown.

Repair: Apply a 2'-0" long 2x4 stud H-F scab to both faces of the truss as shown. Attach with 4-10d nails each side of the damaged area.

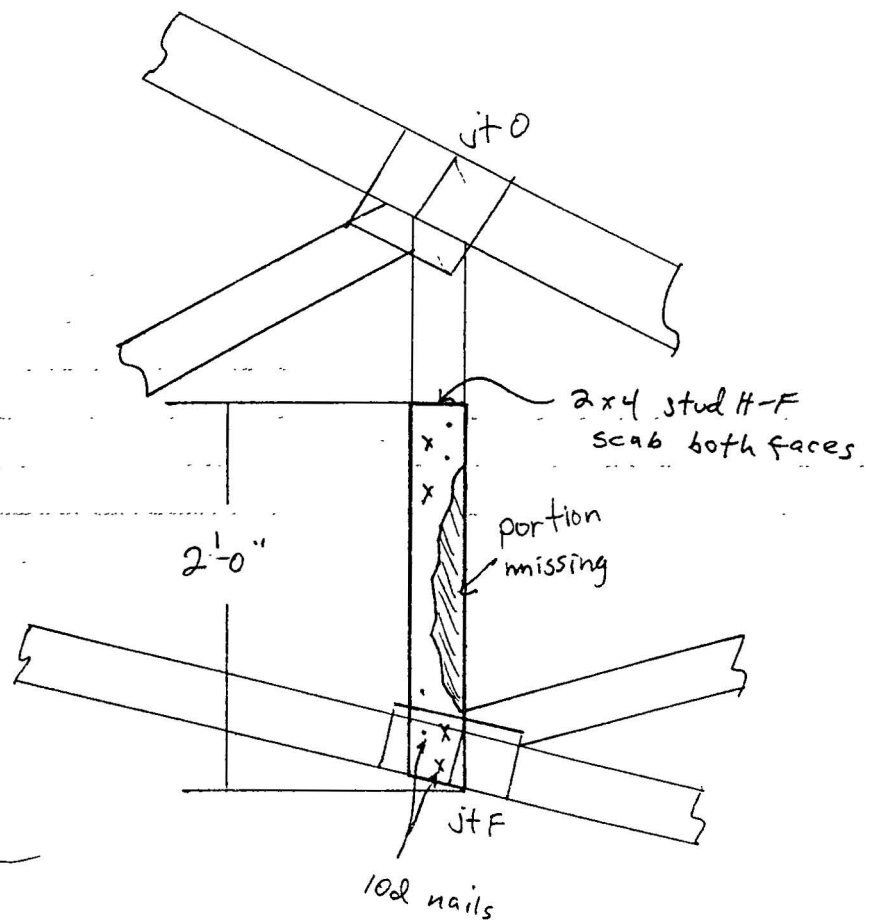**K.G. ENGINEERING, INC.**

5244 PEBBLE BEACH BLVD • #D • LAS VEGAS, NEVADA 89108