

CITY OF LAS VEGAS, NEVADA

PERMIT NO. - 105805

DEPARTMENT OF BUILDING AND SAFETY
PHONE 386-6251

FOR



38718

BUILDING PERMIT

FOR: Single Family Dwelling, Remodel
Additions, Misc: Residential Construction

LOG NO. & AREA

350-215-046
M 3466

DATE

5/9/91

CONST. VAL. \$

324.00

ADDRESS OF
CONSTRUCTION

8912 MARBLE

DR.

OWNER

DALE KUNTZ

PHONE

255-1872

LOT(s)

46

BLOCK

14

SUBDIVISION

SUN CITY SUMMERLIN - UNIT #6

ZONE

P-C

PROPOSED CONSTRUCTION

6' X 18' PATIO ENCLOSURE

USE

THIS PERMIT FOR

BLDG. ☐A/C ☐ELEC. ☐PLBG. ☐

OTHER PERMITS REQD.:

FENCE ☐OFF SITE ☐SWIM POOL ☐

FLOOR AREA

BSMT

1ST

2ND

GARAGE

PORCH

TOTAL 108

CONTRACTOR

SUNSHIELD AWNING

STATE
LICENSE NO.

26124

CITY
LICENSE NO.

21367

ARCHITECT

ENGINEER

MASTER PLUMBER/
CONTRACTORMASTER ELECTRICIAN/
CONTRACTOR

OTHER INSPECTIONS AND FEES

1. Inspections outside of normal business hours = \$30.00 per hour (minimum charge three hours).
2. Re-inspection fee during normal business hours assessed under provisions of TABLE 3-A of the Uniform Building Code = \$30.00 per hour.
3. Inspections during normal business hours for which no fee is specifically indicated = \$30.00 per hour (minimum charge one half hour).
4. Additional plan review required by changes, additions, or revisions to approved plans = \$30.00 per hour (minimum charge two hours).

CONDITIONS OF THE PERMIT:

1. I agree to call the City Building Department for inspections before concrete is poured, before rough wiring, electrical, plumbing, framing is covered. Also for air conditioning, drywall and sheathing inspection.
2. I agree that when the job is completed that I will call for final inspection before occupancy.
3. I agree to perform all construction in accordance with City Ordinances and Building Codes.
4. The Contractor's signature below denotes authority from the owner to sign in his behalf and that the owner is aware of all requirements of this application and permit. Separate permits must be taken out for work outlined above this agreement.
5. I have read and understand the contents of this application and permit; I hereby state that the information I have supplied on this application is true and correct.
6. Approval for the work under this permit will be given only after refuse and debris have been removed from job site and public right of way.
7. 24 HOUR MINIMUM NOTICE REQUIRED FOR INSPECTIONS.

BY:

I HEREBY DECLARE THAT I AM THE LEGAL OWNER OF THE ABOVE PROPERTY

OWNER

BY:

David E. Kusma

AGENT

I hereby certify that I have reviewed this application and the proposed plans and have found that the proposed development meets the requirements of the City of Las Vegas Flood Hazard Reduction Ordinance for the issuance of this Development Permit.

LAND DEVELOPMENT AND FLOOD CONTROL ENGINEER

DATE

5/9/91

PLANNING DEPT.


DATE

5/9/91

BUILDING DEPT.

DATE

SPECIAL CONDITIONS:

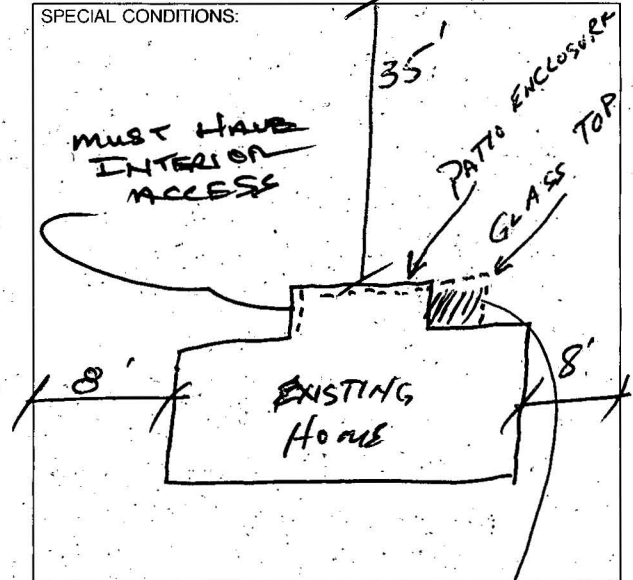

1C B0 3421 P

NOT A HABITABLE
ROOM

RECEIPT

PLUMBING		FEE	ELECTRICAL		FEE
WATER DISTRIBUTION	6.00		RECEPTACLE _____ SWITCH _____		.40
SEWER SYSTEM - NEW OR MODIFICATION	10.00		EACH LIGHT FIXTURE OR SOCKET _____		.30
FIXTURES - WATER SOFTENER, H.W. HEATER	2.00		SPECIAL OUTLET, APPLIANCE ETC.		.70
GARBAGE DISPOSAL - WASHER	2.00		SERVICE/PANEL - SUB/3.00 - 200A/6.00 - 400A/12.50		
FUEL PIPING	6.00		A.C. UNIT OR MOTORS	3.00	
IRRIGATION SYSTEM	8.00		2310 - 2432	TOTAL	
MISC.			MISC.		
2310 - 2433	TOTAL		2310 - 2431 ISSUANCE FEE		
AIR CONDITIONING		FEE	7143 - 2973 SEWER CONNECTION		
NEW UNIT - 3 TON = 9.00 OVER = 16.50			2310 - 2431 PLAN REVIEW FEE		
FURNACE TO 100,000/9.00 OVER/11.00			2310 - 2431 BLDG. PERMIT FEE		
VAPORATIVE COOLER	6.50		TOTAL FEES		
VENTILATION FAN	2.35		12.00		
2310 - 2435	TOTAL				

PERMIT NO.

MUST BE MACHINE VALIDATED

Permit Expires 180 Days After Abandonment of Work