

CITY OF LAS VEGAS, NEVADA

DEPARTMENT OF BUILDING AND SAFETY
PHONE 386-6251

71

PERMIT NO. 106613

BUILDING PERMIT

FOR: Single Family Dwelling, Remodel
Additions, Misc. Residential ConstructionLOG NO. & AREA 30-255-047 M-3620 DATE _____ CONST. VAL. \$ 6000ADDRESS OF CONSTRUCTION 8916 MARBLE DR. OWNER BLOOMQUIST PHONE 255-2316LOT(s) 47 BLOCK 14 SUBDIVISION SUN CITY SUMMERLIN - UNIT #6 ZONE P-CPROPOSED CONSTRUCTION 11 X 18 PATIO ENCLOSURE USE _____THIS PERMIT FOR BLDG. ☐ A/C ☐ ELEC. ☐ PLBG. ☐ OTHER PERMITS REQD.: FENCE ☐ OFF SITE ☐ SWIM POOL ☐

FLOOR AREA BSMT _____ 1ST _____ 2ND _____ GARAGE _____ PORCH _____ TOTAL _____

CONTRACTOR SUNSHIELD AWNING STATE LICENSE NO. 26124 CITY LICENSE NO. 25375

ARCHITECT _____ ENGINEER _____

MASTER PLUMBER/CONTRACTOR _____ MASTER ELECTRICIAN/CONTRACTOR _____

OTHER INSPECTIONS AND FEES

1. Inspections outside of normal business hours = \$30.00 per hour (minimum charge three hours).
2. Re-inspection fee during normal business hours assessed under provisions of TABLE 3-A of the Uniform Building Code = \$30.00 per hour.
3. Inspections during normal business hours for which no fee is specifically indicated = \$30.00 per hour (minimum charge one half hour).
4. Additional plan review required by changes, additions, or revisions to approved plans = \$30.00 per hour (minimum charge two hours).

CONDITIONS OF THE PERMIT:

1. I agree to call the City Building Department for inspections before concrete is poured, before rough wiring, electrical, plumbing, framing is covered. Also for air conditioning, drywall and sheathing inspection.
2. I agree that when the job is completed that I will call for final inspection before occupancy.
3. I agree to perform all construction in accordance with City Ordinances and Building Codes.
4. The Contractor's signature below denotes authority from the owner to sign in his behalf and that the owner is aware of all requirements of this application and permit. Separate permits must be taken out for work outlined above this agreement.
5. I have read and understand the contents of this application and permit; I hereby state that the information I have supplied on this application is true and correct.
6. Approval for the work under this permit will be given only after refuse and debris have been removed from job site and public right of way.
7. 24 HOUR MINIMUM NOTICE REQUIRED FOR INSPECTIONS.

BY: _____ OWNER

I HEREBY DECLARE THAT I AM THE LEGAL OWNER OF THE ABOVE PROPERTY

BY: David E. Blusman AGENT


I hereby certify that I have reviewed this application and the proposed plans and have found that the proposed development meets the requirements of the City of Las Vegas Flood Hazard Reduction Ordinance for the issuance of this Development Permit.

LAND DEVELOPMENT AND FLOOD CONTROL ENGINEER

DATE 5/15/91DATE 5-15-91

BUILDING DEPT. DATE _____

SPECIAL CONDITIONS:

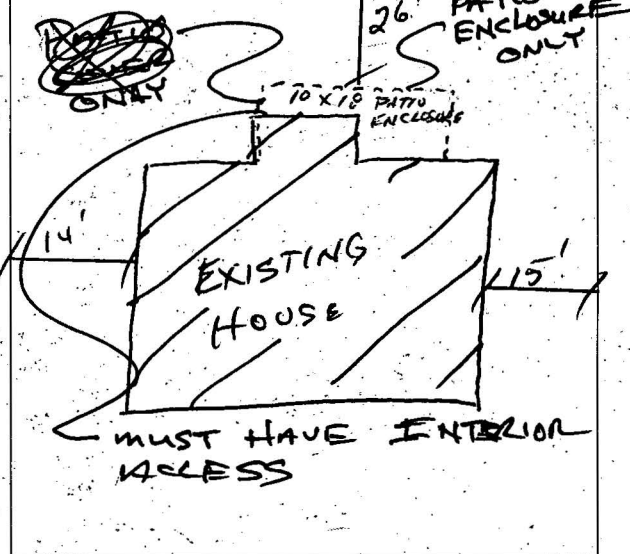

ICBO 3421 P

RECEIPT#

SFD 70.00

CHK 70.00

4367A000 11:18

05/15/91

PLUMBING	FEE	ELECTRICAL	
WATER DISTRIBUTION	6.00	RECEPTACLE _____ SWITCH _____	.40
SEWER SYSTEM - NEW OR MODIFICATION	10.00	EACH LIGHT FIXTURE OR SOCKET _____	.30
FIXTURES - WATER SOFTENER, H.W. HEATER	2.00	SPECIAL OUTLET, APPLIANCE ETC.	.70
GARBAGE DISPOSAL - WASHER	2.00	SERVICE/PANEL - SUB/3.00 - 200A/6.00 - 400A/12.50	
FUEL PIPING	6.00	A.C. UNIT OR MOTORS	3.00
IRRIGATION SYSTEM	8.00	2310 - 2432 TOTAL	
MISC.		MISC.	

2310 - 2433 TOTAL		2310 - 2431 ISSUANCE FEE	
AIR CONDITIONING	FEE	7143 - 2973 SEWER CONNECTION	
NEW UNIT - 3 TON = 9.00 OVER = 16.50		2310 - 2431 PLAN REVIEW FEE	
FURNACE TO 100,000/9.00 OVER/11.00		2310 - 2431 BLDG. PERMIT FEE	
VAPORATIVE COOLER	6.50	TOTAL FEES	<u>70.00</u> <u>70.00</u>
VENTILATION FAN	2.35		
2310 - 2435 TOTAL			

PERMIT NO. _____

MUST BE MACHINE VALIDATED

Permit Expires 180 Days After Abandonment of Work