

CITY OF LAS VEGAS, NEVADA

DEPARTMENT OF BUILDING AND SAFETY
PHONE 386 6251



DEMIT NO 90-059167
DEVELOPMENT PERMIT
FOR Fence Wall Retaining Wall

LOG NO & AREA _____ DATE 3/19/90 CONST VAL \$ 460.00
ADDRESS OF CONSTRUCTION 3700 EL CONDON Ave OWNER MRS Wilma Chambers PHONE 876-3379

CONTRACTOR BUMBY STATE LICENSE NO _____ CITY LICENSE NO _____

LOT(s) 28 BLOCK 302 SUBDIVISION Las Verdes Hgts 6 Unit #03 ZONE R-1

☐ CONSTRUCTION PLANS SUBMITTED BY OWNER/CONTRACTOR ☒ CONSTRUCTION DESIGN BY CITY DESIGN SHEET

ENGINEER _____

Approval for the work under this permit will be given only after refuse and debris have been removed from job site and public right of way


DESCRIPTION	TOTAL LIN FT	TOTAL SQ FT
CHAIN LINK OR WIRE MESH		
ORNAMENTAL IRON		
WOOD		
MASONRY <u>25x6'-504'</u>	<u>75</u>	<u>184</u>
RETAINING		

OTHER INSPECTIONS AND FEES	
1	Inspections outside of normal business hours = \$30.00 per hour (minimum charge three hours)
2	Re-inspection fee during normal business hours assessed under provisions of TABLE 3 A of the Uniform Building Code = \$30.00 each
3	Inspections during normal business hours for which no fee is specifically indicated = \$30.00 per hour (minimum charge one half hour)
4	Additional plan review required by changes add tions or revisions at approved plans = \$30.00 per hour (minimum charge two hours)

CONDITIONS OF THE PERMIT

- Any type of retaining wall must be engineered by a Civil or Structural Engineer
- If a home owner takes out the Building Permit and if the owner sublets the work to a Contractor then the Contractor must take out the permit and pay for it
- No fence or wall can be built on City property or rights of way but this is not intended to preclude construction within utility easements if utilities will not be damaged or made inaccessible
- The fence or wall shall not enclose any water meter light standard or fire alarm box and shall not come closer than 24' from the nearest fire hydrant outlet
- Department Inspectors must approve footings before concrete is poured and block wall reinforcing before grouting is done
- Maximum height of any wall or fence is 6' side and rear yards 4' maximum in front yard with the vertical surface above the height of 2' - 50% open
- It must not obstruct required onsite parking space (2 spaces for each dwelling unit) by the erection of this fence or wall
- By the signing of this application I herewith agree to the requirements outlined above

FOR INSPECTIONS CALL 799 2071

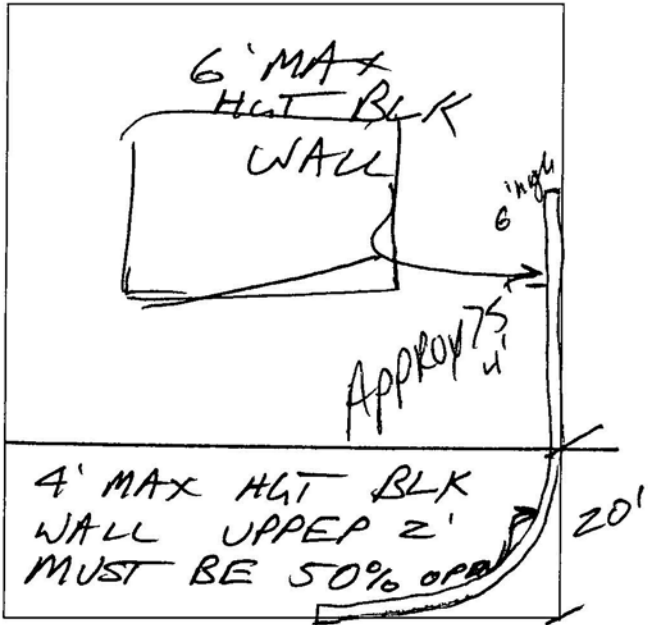

Wilma Chambers
SIGNED _____ CONTRACTOR AGENT OWNER
3/5/90
PLANNING DEPT DATE

I hereby certify that I have reviewed this application and the proposed plans and have found that the proposed development meets the requirements of the City of Las Vegas Flood Hazard Reduction Ordinance for the issuance of this Development Permit

R. B. B... 3/5/90
LAND DEVELOPMENT AND FLOOD CONTROL ENGINEER DATE
TS 3/5-90
BUILDING DEPT DATE

OK - NOTHING OVER
30' WITHIN
SIGHT TRIANGLE
WORK 3/5/90

PLAN REVIEW FEE _____
PERMIT FEE 12.00
2310 2401
TOTAL FEES _____

RECEIPT	
0002	
WALL	12 00
CASH	12 00
0315A000	10 56

DEPARTMENT OF BUILDING & SAFETY CITY OF LAS VEGAS

JOB ADDRESS 3700 El Carlon		PERMIT NO 59167	
LOT NO	MAP NO 13	INSPECTOR 55	DATE 3-6
SUBDIVISION NAME			PHONE 833-3379
INSPECTOR SIGNATURE Am Early			INSPECTION DATE
☐ PARTIAL INSPECTION DESCRIPTION			
☒ APPROVED		☐ PERMIT REQUIRED	
☐ STOP WORK			
☐ REJECTED CORRECTION NOTICE REINSPECTION REQUIRED CALL 799 2071			
INSPECT	DESCRIPTION	INSPECT	DESCRIPTION
☒ B 1	FOOTING LAYOUT REBAR ZONING	☐ P 1	ON SITE SEWER
☐ B 2	STEM WALL -- FORMS & REBAR	☐ P 2	ON SITE WATER
☐ B 3	PRE SLAB	☐ P 3	BUILDING SEWER (YARD LINES)
☐ B 4	ROOF SHEATHING	☐ P 4	UNDERSLAB PLUMBING
☐ B 5	FRAMING	☐ P 5	TOP OUT WATER GAS WASTE
☐ B 6	INSULATION	☐ P 6	FINAL GAS TEST
☐ B 7	DRYWALL NAILING	☐ P 7	FINAL PLUMBING
☐ B 8	EXTERIOR LATH/STUCCO		
☐ B 9	WALL GROUT & STEEL	☐ M 1	ROUGH VENT
☐ B 10	POOL PRE GUNITE	☐ M 2	HOOD
☐ B 11	POOL PRE PLASTER / FINAL	☐ M 3	FINAL MECHANICAL
☐ B 12	BUILDING FINAL		
☐ B 13	CERT OF OCC	☐ X 1	KICKER / FLUSH
		☐ X 2	UNDERGROUND HYDRO
		☐ X 3	UNDERGROUND FINAL/FLOW
		☐ X 4	SPRINKLER SYSTEM HYDRO
		☐ X 5	FIRE ALARM
		☐ X 6	OTHER
		☐ X 7	FINAL FIRE
		☐ E 1	UNDERGROUND ELETTRICAL
		☐ E 2	ROUGH ELECTRICAL
		☐ E 3	LOW VOLTAGE ELECTRICAL
		☐ E 4	SIGN INSPECTION
		☐ E 5	FINAL ELECTRICAL
		☐ E 6	TEMP POWER
☐ FINAL INSPECTION		BRING HARD CARD WITH FIRE QUALITY CONTROL & PLANNING APPROVALS SIGNED OFF TO BLDG & SAFETY FOR C of O ISSUANCE (Commercial Only)	

FOR ASSISTANCE CALL 386 6251

DEPARTMENT OF BUILDING & SAFETY CITY OF LAS VEGAS

JOB ADDRESS 3700 EL COLON RD		PERMIT NO 059167	
LOT NO	MAP NO	INSPECTOR #44	DATE
SUBDIVISION NAME			PHONE
INSPECTOR SIGNATURE <i>[Signature: Fred Coley]</i>			INSPECTION DATE 3/6/90

OK TO Pour FOOTING

☐ PARTIAL INSPECTION DESCRIPTION

☒ **APPROVED**

☐ **PERMIT REQUIRED**

☐ **STOP WORK**

☐ **REJECTED CORRECTION NOTICE REINSPECTION REQUIRED CALL 799 2071**

INSPECT	DESCRIPTION	INSPECT	DESCRIPTION	INSPECT	DESCRIPTION
☒ B 1	FOOTING LAYOUT REBAR ZONING	☐ P 1	ON SITE SEWER	☐ X 2	UNDERGROUND HYDRO
☐ B 2	STEM WALL -- FORMS & REBAR	☐ P 2	ON SITE WATER	☐ X 3	UNDERGROUND FINAL/FLOW
☐ B 3	PRE SLAB	☐ P 3	BUILDING SEWER (YARD LINES)	☐ X 4	SPRINKLER SYSTEM HYDRO
☐ B 4	ROOF SHEATHING	☐ P 4	UNDERSLAB PLUMBING	☐ X 5	FIRE ALARM
☐ B 5	FRAMING	☐ P 5	TOP OUT WATER GAS WASTE	☐ X 6	OTHER
☐ B 6	INSULATION	☐ P 6	FINAL GAS TEST	☐ X 7	FINAL FIRE
☐ B 7	DRYWALL NAILING	☐ P 7	FINAL PLUMBING		
☐ B 8	EXTERIOR LATH/STUCCO			☐ E 1	UNDERGROUND ELETRICAL
☐ B 9	WALL GROUT & STEEL	☐ M 1	ROUGH VENT	☐ E 2	ROUGH ELECTRICAL
☐ B 10	<i>POOL</i> PRE GUNITE	☐ M 2	HOOD	☐ E 3	LOW VOLTAGE ELECTRICAL
☐ B 11	<i>POOL</i> PRE PLASTER / FINAL	☐ M 3	FINAL MECHANICAL	☐ E 4	SIGN INSPECTION
☐ B 12	BUILDING FINAL			☐ E 5	FINAL ELECTRICAL
☐ B 13	CERT OF OCC	☐ X 1	KICKER / FLUSH	☐ E 6	TEMP POWER

☐ **FINAL INSPECTION**

BRING HARD CARD WITH FIRE QUALITY CONTROL & PLANNING APPROVALS
SIGNED OFF TO BLDG & SAFETY FOR C of O ISSUANCE (Commercial Only)

FOR ASSISTANCE CALL 386-8251