

CITY OF LAS VEGAS, NEVADA

DEPARTMENT OF BUILDING AND SAFETY
PHONE 229 6251

PERMIT NO

93-191135

FC



120385

BUILDING PERMIT

FOR Single Family Dwelling Remodel
Additions Misc Residential ConstructionPLAN CHECK NO 1-312 193 DATE 4/09/93 CONST VAL \$ 59,400ADDRESS OF CONSTRUCTION 8225 GRAND PACIFIC DRIVE OWNER PLASTER DEVELOPMENT CO PHONE 385-5011LOT(s) 109 BLOCK 2 SUBDIVISION RIDGEVIEW WEST UNIT 9A ZONEPROPOSED CONSTRUCTION SINGLE FAMILY USE RESIDENCETHIS PERMIT FOR ☐ BLDG ☐ A/C ☐ ELEC ☐ PLBG ☐ OTHER PERMITS REQD ☐ FENCE ☐ OFF SITE ☐ SWIM POOL ☐FLOOR AREA BSMT 1008 1ST 1074 2ND 1074 GARAGE 387 PORCH 36 TOTAL 2505CONTRACTOR PLASTER DEVELOPMENT CO., INC. STATE LICENSE NO U17957 CITY LICENSE NO 614-D48-2-14722ARCHITECT VTN ENGINEER VTNMASTER PLUMBER/
CONTRACTOR VTN MASTER ELECTRICIAN/
CONTRACTOR VTN

OTHER INSPECTIONS AND FEES

- 1 Inspections outside of normal business hours = \$40.00 per hour (minimum charge three hours)
- 2 Re inspection fee during normal business hours assessed under provisions of TABLE 3 A of the Uniform Building Code = \$40.00 per hour
- 3 Inspections during normal business hours for which no fee is specifically indicated = \$40.00 per hour (minimum charge one hour)
- 4 Additional plan review required by changes additions or revisions to approved plans = \$40.00 per hour (minimum charge two hours)

CONDITIONS OF THE PERMIT

- 1 I agree to call the City Building Department for inspections before concrete is poured before rough wiring electrical plumbing framing is covered Also for air conditioning drywall and sheathing inspection
- 2 I agree that when the job is completed that I will call for final inspection before occupancy
- 3 I agree to perform all construction in accordance with City Ordinances and Building Codes
- 4 The Contractor's signature below denotes authority from the owner to sign in his behalf and that the owner is aware of all requirements of this application and permit Separate permits must be taken out for work outlined above this agreement
- 5 I have read and understand the contents of this application and permit I hereby state that the information I have supplied on this application is true and correct
- 6 Approval for the work under this permit will be given only after refuse and debris have been removed from job site and public right of way
- 7 24 HOUR MINIMUM NOTICE REQUIRED FOR INSPECTIONS

SPECIAL CONDITIONS

PLANS ON FILE
PER FLOT PLAN
45 FBY PLASTER DEVELOPMENT CO., INC

I HEREBY DECLARE THAT I AM THE LEGAL OWNER OF THE ABOVE PROPERTY

OWNER

BY CW BRUBAKER

AGENT

I hereby certify that I have reviewed this application and the proposed plans and have found that the proposed development meets the requirements of the City of Las Vegas Flood Hazard Reduction Ordinance for the issuance of this Development Permit

LAND DEVELOPMENT AND FLOOD CONTROL ENGINEER

DATE 4/19/93DATE 4/20/93DATE 4/15/93

ELECTRICAL

FEE

RECEPTACLE	SWITCH	50
EACH LIGHT FIXTURE OR SOCKET		40
SPECIAL OUTLET APPLIANCE ETC		80
SERVICE/PANEL SUB/3 40 200A/6 70 400A/13 85		
A/C UNIT OR MOTORS	3 40	
MISC		
2310 2432	TOTAL	81 00

PLUMBING	FEE
WATER DISTRIBUTION	6 70
SEWER SYSTEM NEW OR MODIFICATION	11 05
FIXTURES WATER SOFTENER H/W HEATER	2 25
GARBAGE DISPOSAL WASHER	2 25
FUEL PIPING	6 70
IRRIGATION SYSTEM	8 90
MISC	
2310 2433	TOTAL
AIR CONDITIONING	FEE
NEW UNIT 3 TON = 10 00 OVER = 18 20	
FURNACE TO 100 000/10 00 OVER/12 20	
VAPORATIVE COOLER	7 20
VENTILATION FAN	2 65
2310 2435	TOTAL
	61 00

1113 2437 ZONING	20 00
2310 2431 PLAN REVIEW	10 00
2310 2401 BLDG PERMIT	406 00
7143 2973 SEWER CONNECTION	1100 00
6122 3352 TORTOISE	
2897 PIF	
88100 1232 TRANSPORT	500 00
TOTAL FEES	2259.00


RECEIPT

MUST BE MACHINE VALIDATED

PERMIT NO

Permit Expires 180 Days After Abandonment of Work

PACIFIC DRIVE

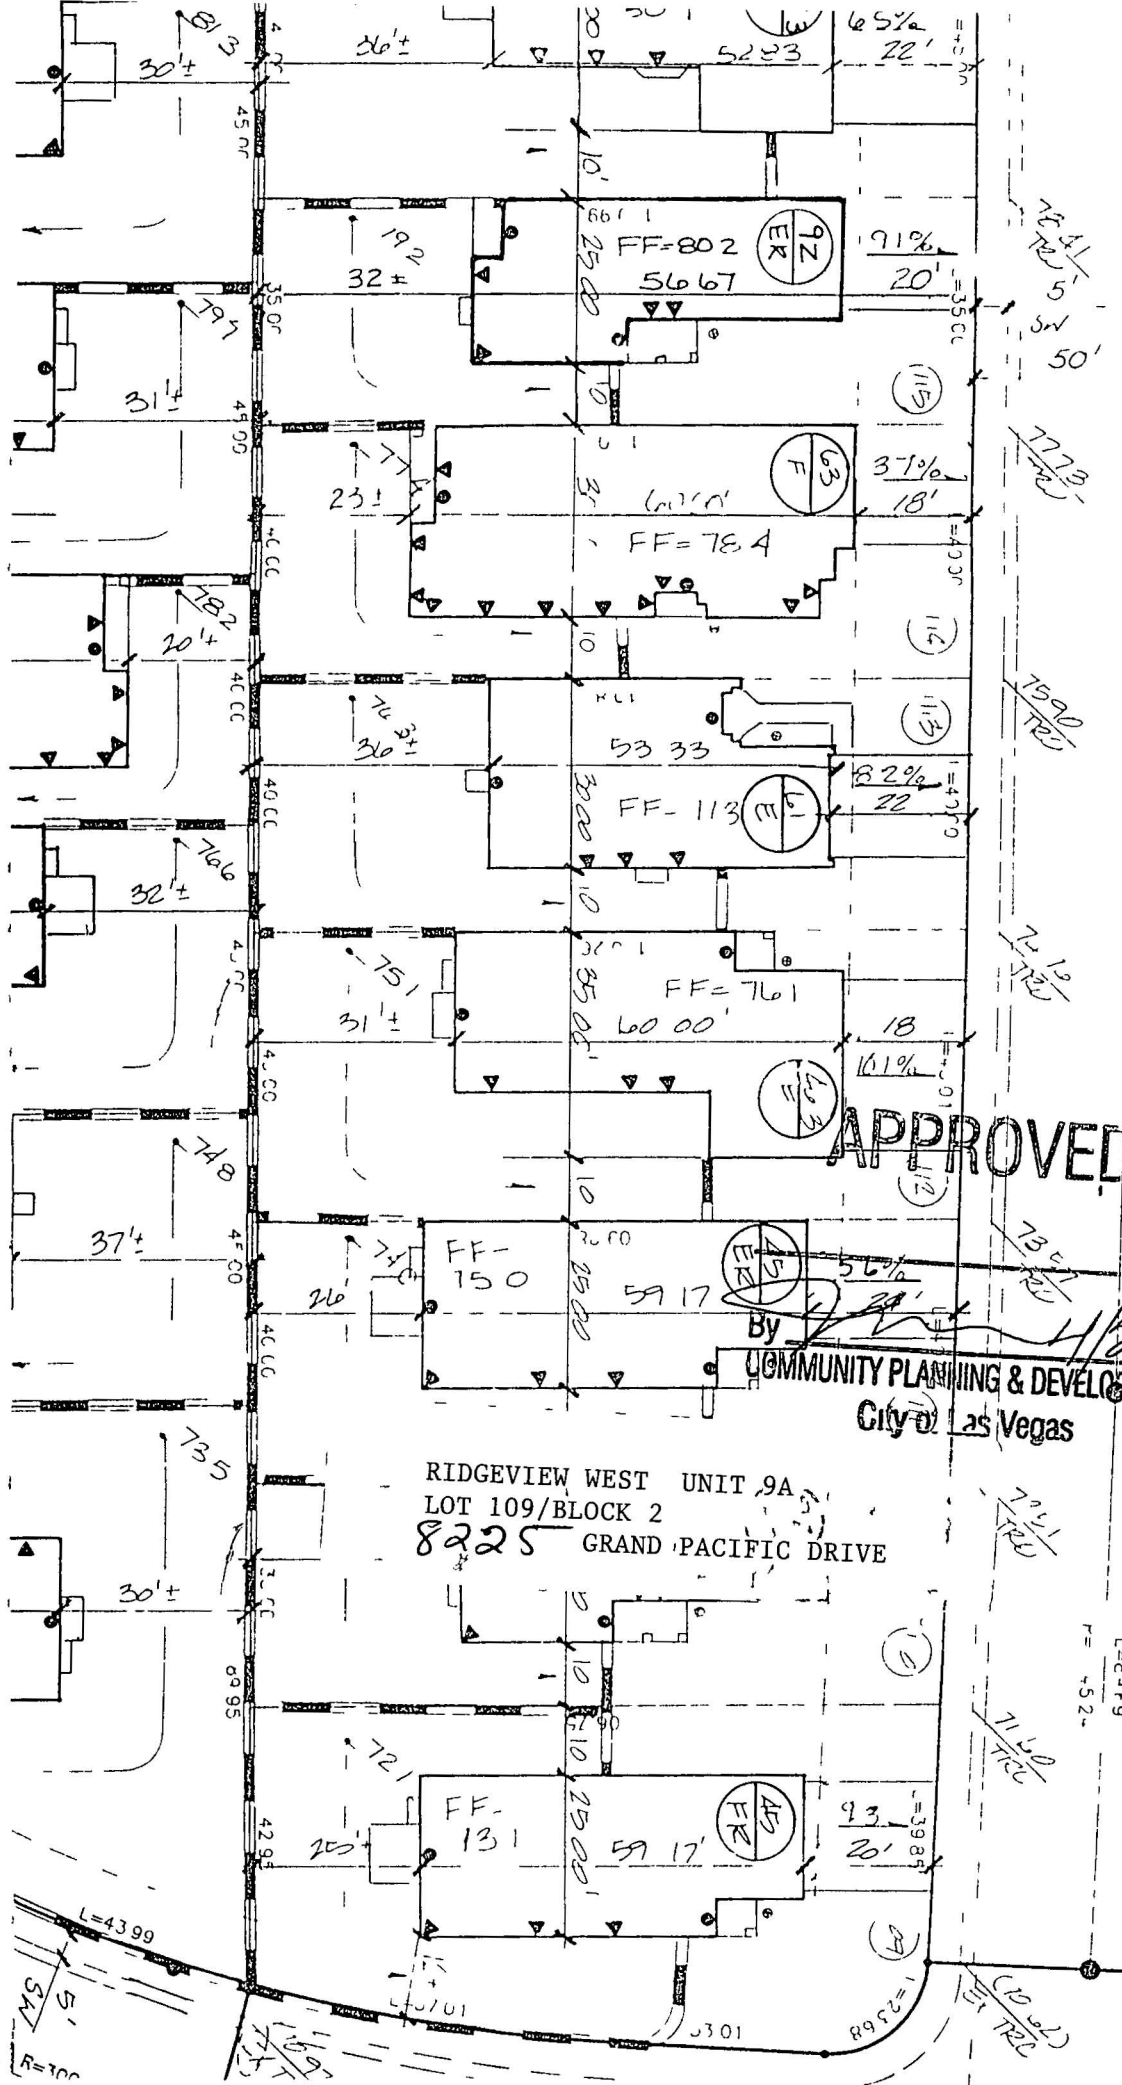

APPROVED

By [Signature]
COMMUNITY PLANNING & DEVELOPMENT
City of Las Vegas

RIDGEVIEW WEST UNIT 9A
LOT 109/BLOCK 2
8225 GRAND PACIFIC DRIVE

