

CITY OF LAS VEGAS, NEVADA

DEPARTMENT OF BUILDING AND SAFETY
PHONE 386-6251

PERMIT NO. 1-106572

PLUMBING PERMIT

LOG NO. & AREA

M-3608

CONST. VAL. \$

ADDRESS OF
CONSTRUCTION

1628 Stonehaven

OWNER

W.W. Anderson

PHONE

CONTRACTOR

Active Plumbing

STATE

LICENSE NO. 30599

CITY

LICENSE NO. GR# 118160

LOT(s)

BLOCK

SUBDIVISION

ZONE

PROPOSED CONSTRUCTION:

adding gas line

USE:

PLUMBING
PERMIT NO.Approval for the work under this permit will be given only after refuse
and debris have been removed from job site and public right of way.

UNITS	DESCRIPTION	FEE	TOTAL
PERMIT ISSUANCE			
1	For Issuing Each Permit	10.00	10
	For Issuing Each Supplemental Permit	4.50	
FIXTURE CHARGE			
	Bathub, Shower, Lavatory, Toilet, Urinal	EA. 2.00	
	Floor Drain, Floor Sink, Wash Tray, Sink	EA. 2.00	
	Garbage Disposal, Clothes Washer, Dishwasher (residential)	EA. 2.00	
	Garbage Disposal (commercial)	EA. 8.00	
	Clothes Washer, Dishwasher (commercial)	EA. 2.00	
	Clothes Dryer (gas) (venting)	2.00	
	Dental Unit	8.00	
	Drinking Fountain	2.00	
	Refrigerator - Ice Maker, Water Dispenser	2.00	
	Any other water using equipment, Attached Coffee Makers, Ice Makers	2.00	
1	Hot Water Heater (Gas or Electric)	EA. 2.00	2
SEWER SYSTEM			
	New, Replacement, Modification, or Any Drainage Work	10.00	
	Grease or Sand Trap or Interceptor	2.00	
	Trailer Trap (rental parks)	5.00	
WATER SOFTENERS			
	Non Permanent Type (rental)	2.00	
	Permanent Type (connected to drain)	2.00	
WATER DISTRIBUTION SYSTEM			
	Single Family Dwelling	6.00	
	Multi-Family Dwelling	6.00	
	Plus Each Dwelling Unit	3.00	
	Commercial Building per floor	3.00	
	Plus Each Unit (leased space or office)	2.00	
	Hotel or Motel	8.00	
	Plus Each Unit	3.00	
	Trailer Park	30.00	
	Plus Each Space	2.00	
	Irrigation Single Family Dwelling	8.00	
	Irrigation Commercial Fee Based on Building Code Valuation Chart		
	Construction Valuation		

UNITS	DESCRIPTION	FEE	TOTAL
FUEL PIPING SYSTEM			
1	Single Family Dwelling	6.00	6
	Multi-Family Dwelling	10.00	
	Plus Each Unit	2.00	
	Commercial Building (per floor)	6.00	
	Plus Each Unit (leased space or office)	6.00	
	Medium Pressure System (Plan Check)	12.00	
	Each Gas Appliance (Any Type)	2.00	
	Steam Boilers	5.00	
SOLAR ENERGY SYSTEMS			
	Collectors (including piping) (per collector)	5.00	
	Storage Tanks (each)	5.00	
PIPELINE CONTRACT			
	For Onsite Sewer, Gas or Water Contract Value. Fee based on Building Code Permit Valuation Chart.		
OTHER INSPECTIONS AND FEES:			
	Inspections outside of normal business hours (minimum charge—three hours)	25.00 per hour	
	Under provisions of Table 3-A of the Uniform Building Code, work which has been inspected once and not approved may be subject to a Reinspection Fee not less than \$30.00 per each inspection during business hours.	30.00 each	
	Additional plan review required by changes. Additions to or revisions to approved plans (minimum charge two hours).	30.00 per hour	
	Plumbing permit fees may be computed the same as building permit fees by using the cost of installation for valuation amount when such work is not included in the above schedule.		
	Construction Valuation		

FOR INSPECTIONS
CALL 799-2071SEWER # 7114-3654
CONNECTION

FIXTURES X 05/15/91

FEE

2310-2403
PERMIT
FEE 18.00TOTAL
FEES

RECEIPT

0002

PLBG 18.00

CHEK 18.00

4340A000 09:33

I hereby certify that I have carefully examined and read the above application; that the same is true and correct; and that the work herein described is to be done in accordance with all the provisions of the applicable Ordinances of the City of Las Vegas, Nevada and the State Laws, whether herein specified or not.

SIGNED

CONTRACTOR

MASTER CARD NO.

BY

Registered Master Plumber, Spec. Contr. or Owner

BUILDING DEPT.

DATE

PERMIT NO.

W.W. Anderson
1628 Stone Haven Dr.

11-26-72
FED PAC CO. P. O. BOX 431 - STANTON - CALIF

Total Length is 63' from meter to A.C. unit

12' gas for
A.C. unit

3/4"

1"

1"

3/4" for Res
oven

3/4" for
Range

1"

1/4"

1/2" for
Clothes
Dryer

1/2"

for
Water
Heater

Range = 65,000 Btus

Clothes Dryer = 35,000

A.C. Unit = 100,000

Oven Res. = 25,000

Water heater = 50,000

Total Btus = 275,000

Total CFH = 250


PLANS APPROVED
MECHANICAL
Building & Safety Dept.
City of Las Vegas, Nevada

BY SB DATE 5-15-91

Does Not Include Electrical Construction
or Off-Site Improvements
Make No Change Without Approval
Approval of Plan is not a
Permit to Violate Any Ordinance

Gas Piping sized from Chart # 12-3 70' mark

Min size for supply is 1 1/2"

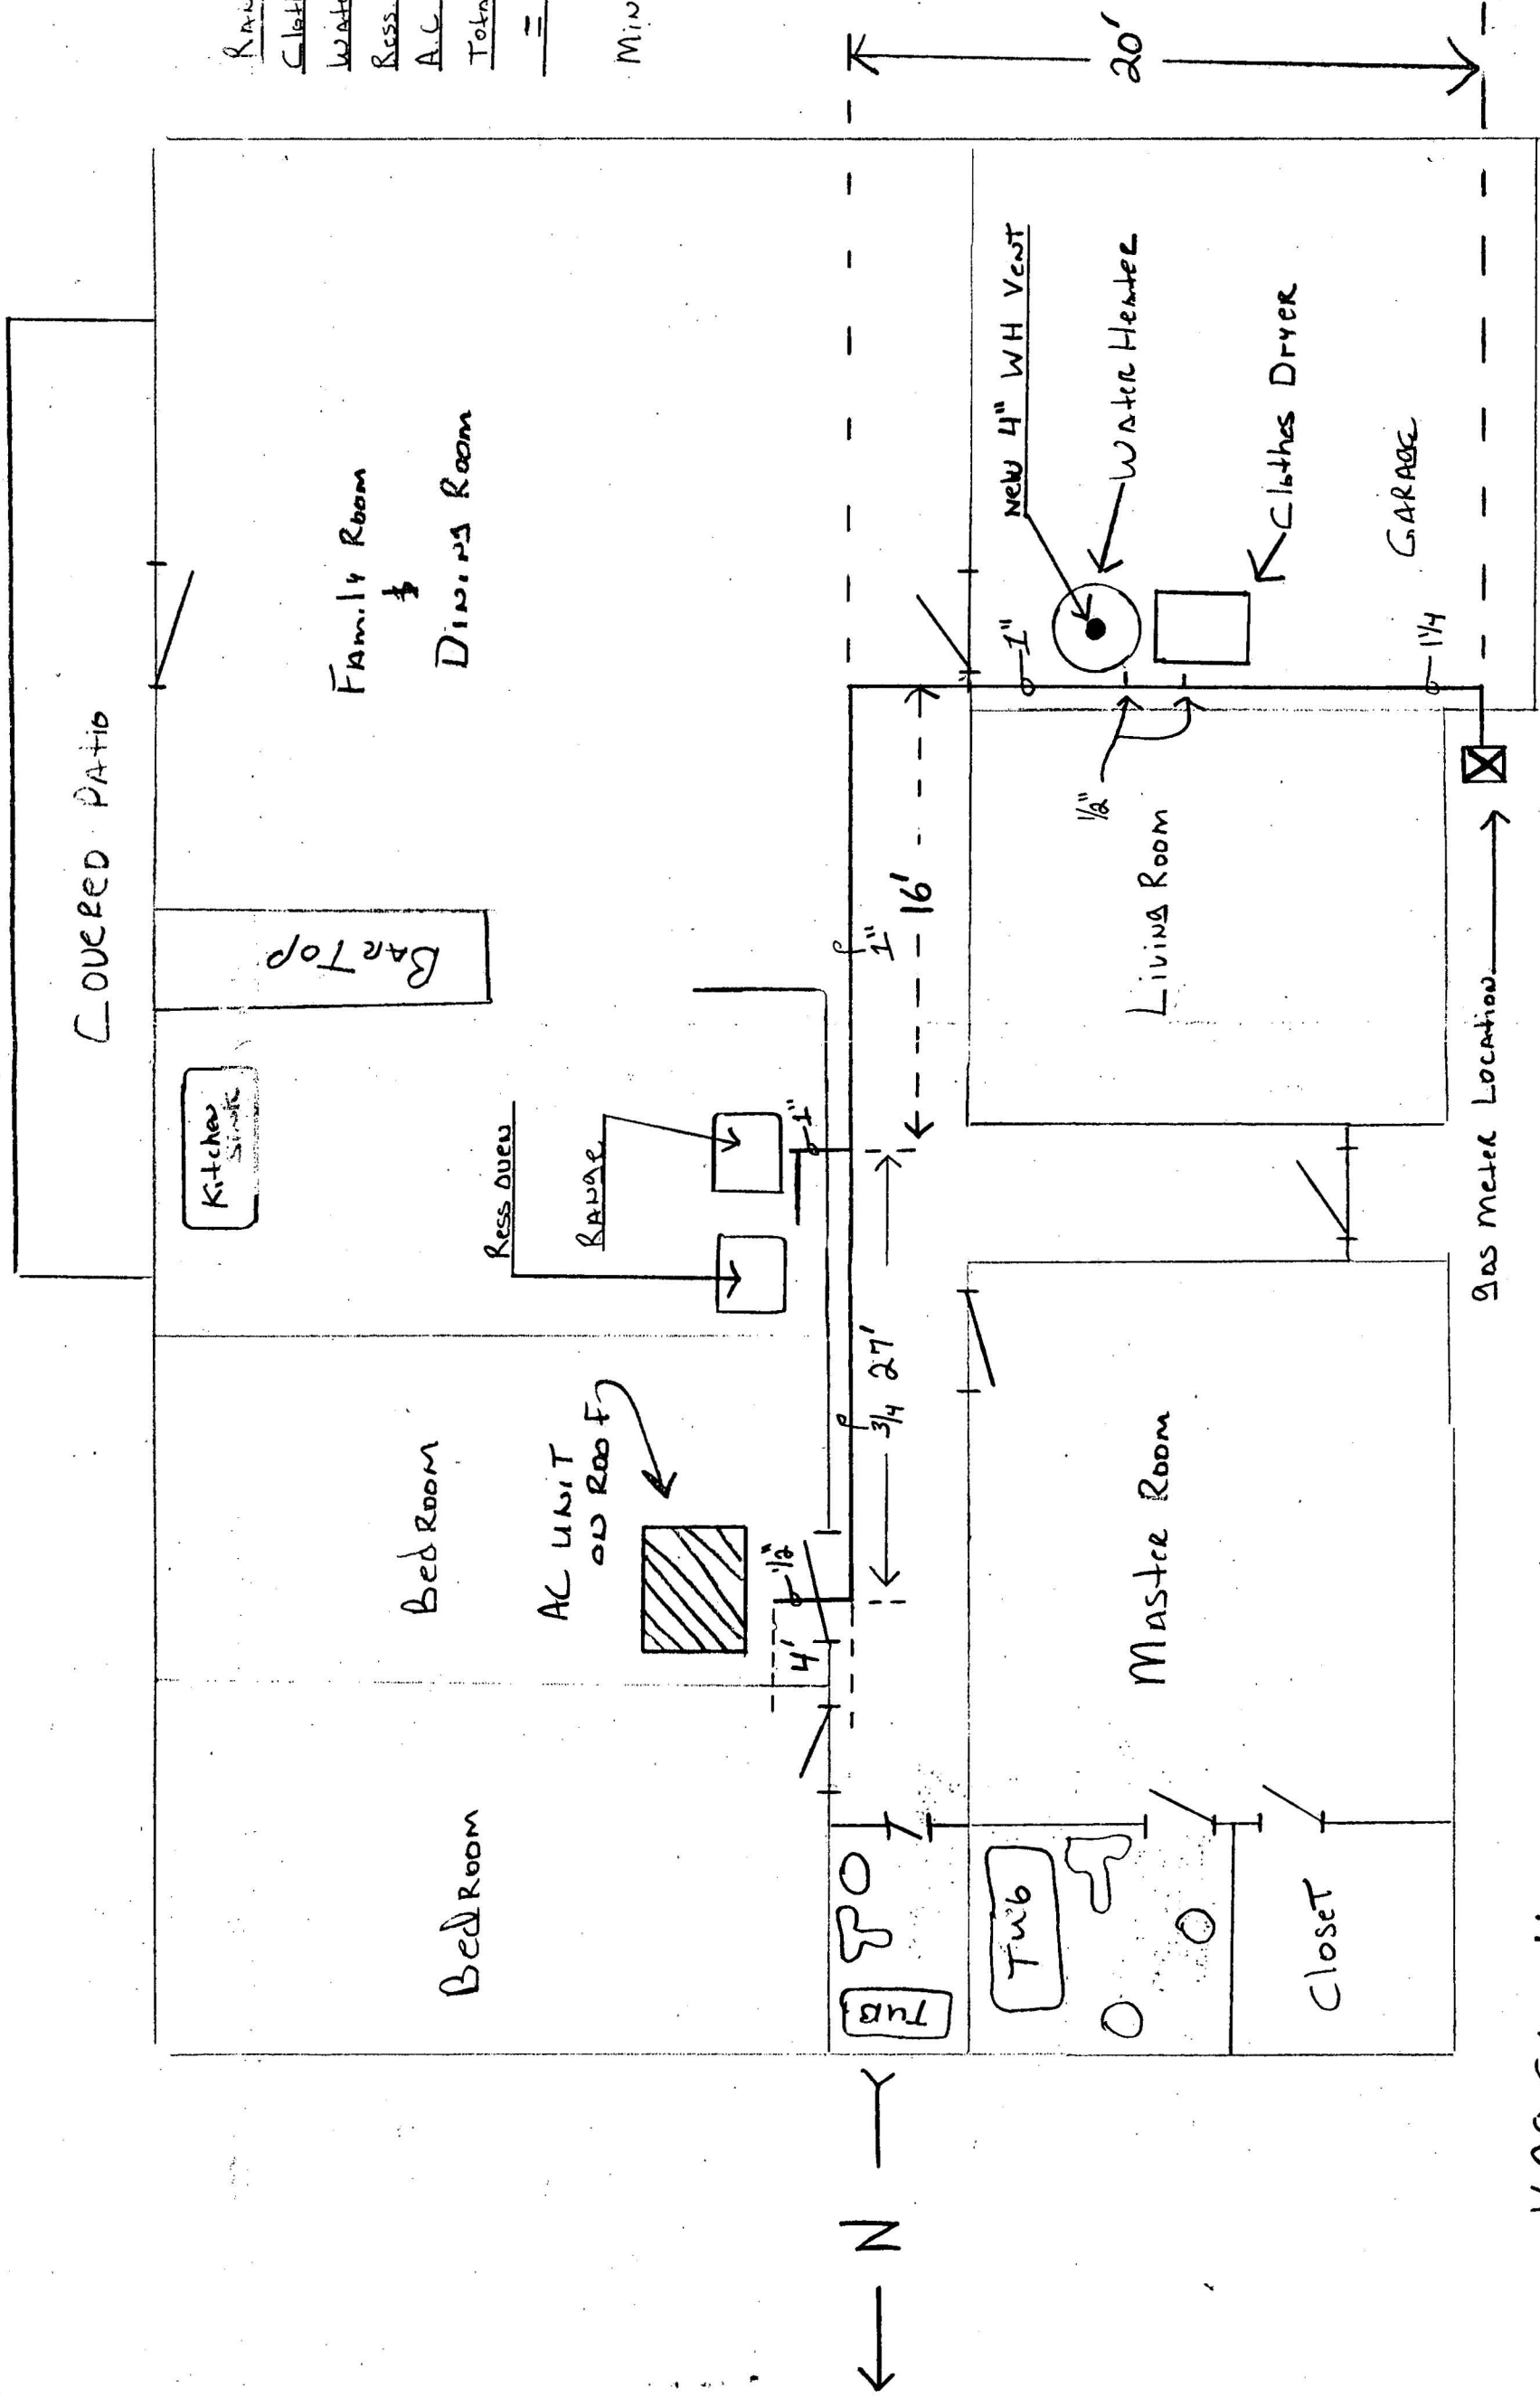

Range = 65,000 BTUs
 Clothes Dryer = 35,000 BTUs
 Water Heater = 50,000 BTUs
 Res. Oven = 25,000 BTUs
 A.C. Unit = 100,000 BTUs
 Total BTUs = 275,000 BTUs
 = 250 CFH

Min size for supply line is 1 1/4"

1628 Stone Haven
Owner is WW Anderson

Total Length from meter to A.C. unit is 67'
 Gas Piping Sized from Table 12-3 70' column



PERMIT
NUMBER

INSPECTION
NUMBER

JOB ADDRESS

LOT NO.

BLOCK NO.

SUBDIVISION NAME

FIRE DEPT. MAP NO.

JOB PHONE

CALL-IN DATE

CALL-IN TIME

SCHEDULE DATE

INSPECTOR NO.

INSPECTOR NAME

INSPECTION
REQUESTED

ATTN:

*This address was
Given as wood Heaven
it should read
Stone Heaven*

*Please correct file Address
Change
please change file*

☐ PARTIAL
INSPECTION

☐ PARTIAL
APPROVAL (P)

PARTIAL DESCRIPTION

☐ APPROVED
(A)

☐ STOP
WORK (S)

☐ COMMENTS
(C)

☐ TEMPORARY
APPROVAL (T)

UNTIL

☐ HOLD
(H)

☐ REJECTED (R)

REINSPECTION REQUIRED CALL 799-2071

☐ REFEE (F)

REINSPECTION FEE REQUIRED PAY AT CITY HALL
3RD FLOOR - 400 S STEWART STREET

☐ PERMIT
REQUIRED

INSPECTOR
SIGNATURE

INSPECTION DATE

☐ PROJECT
COMPLETE

BRING HARD CARD WITH FIRE, QUALITY CONTROL & PLANNING APPROVALS
SIGNED OFF TO BLDG & SAFETY FOR C. OF O. ISSUANCE (Commercial Only)

IF YOU HAVE ANY QUESTIONS ON THIS INSPECTION, YOU MAY
CALL THE INSPECTOR FROM 7:00 A.M. - 7:15 A.M. OR 2:45 P.M. - 3:00 P.M. AT

☐	PERMIT NUMBER	106572	INSPECTION NUMBER	
JOB ADDRESS 1628 Woodhaver Stone Haven				
LOT NO.		BLOCK NO.	SUBDIVISION NAME	
FIRE DEPT. MAP NO.	JOB PHONE 438-3357	CALL-IN DATE	CALL-IN TIME	SCHEDULE DATE 5/16/91
INSPECTOR NO. 83.		INSPECTOR NAME		
INSPECTION REQUESTED 423 Final Gas				

1st thing Thurs Am. per 45

423 Issued Gas Tag
440 R/R water heater

☐ PARTIAL INSPECTION	☐ PARTIAL APPROVAL (P)	PARTIAL DESCRIPTION		
☒ APPROVED (A)	☐ STOP WORK (S)	☐ COMMENTS (C)	☐ TEMPORARY APPROVAL (T) — UNTIL	☐ HOLD (H)
☐ REJECTED (R)	REINSPECTION REQUIRED - CALL 799-2071			☐ PERMIT REQUIRED
☐ REFEE (F)	REINSPECTION FEE REQUIRED - PAY AT CITY HALL 3RD FLOOR - 400 E. STEWART STREET.			
INSPECTOR SIGNATURE JW Lehy		INSPECTION DATE 5-16-91		
☐ PROJECT COMPLETE	BRING HARD CARD WITH FIRE, QUALITY CONTROL & PLANNING APPROVALS SIGNED OFF TO BLDG & SAFETY FOR C. OF ISSUANCE (Commercial Only)			
IF YOU HAVE ANY QUESTIONS ON THIS INSPECTION, YOU MAY CALL THE INSPECTOR FROM 7:00 A.M. - 7:15 A.M. OR 2:45 P.M. - 3:00 P.M. AT				