

CITY OF LAS VEGAS, NEVADA

DEPARTMENT OF BUILDING AND SAFETY
PHONE 386-6251

FOR INFO



65442

NO.

91-129470

BUILDING PERMIT

FOR: Single Family Dwelling, Remodel
Additions, Misc. Residential Construction

LOG NO. & AREA P-178 DATE June 3, 1991 CONST. VAL. \$ 46,800.00

ADDRESS OF CONSTRUCTION 6405 Grove Hill Lane OWNER Lewis Homes of Nevada PHONE 736-8960

LOT(s) 1041 BLOCK Q SUBDIVISION Rainbow-Vista Festival 13-C-7 ZONE RCL

PROPOSED CONSTRUCTION Single Family Residence USE Dwelling

THIS PERMIT FOR BLDG. ☒ A/C ☒ ELEC. ☒ PLBG. ☒ OTHER PERMITS REQD.: FENCE ☐ OFF SITE ☐ SWIM POOL ☐

FLOOR AREA BSMT 182 1ST 782 2ND 814 GARAGE 406 PORCH 21 TOTAL 1835

CONTRACTOR Lewis Homes of Nevada STATE LICENSE NO. 14761 CITY LICENSE NO. 8707 2023

ARCHITECT Lewis Homes of Nevada ENGINEER G.C. Wallace

MASTER PLUMBER/CONTRACTOR _____ MASTER ELECTRICIAN/CONTRACTOR _____

OTHER INSPECTIONS AND FEES

- 1 Inspections outside of normal business hours = \$30.00 per hour (minimum charge three hours)
- 2 Re-inspection fee during normal business hours assessed under provisions of TABLE 3-A of the Uniform Building Code = \$30.00 per hour
- 3 Inspections during normal business hours for which no fee is specifically indicated = \$30.00 per hour (minimum charge one half hour)
- 4 Additional plan review required by changes, additions, or revisions to approved plans = \$30.00 per hour (minimum charge two hours)

CONDITIONS OF THE PERMIT:

- 1 I agree to call the City Building Department for inspections before concrete is poured, before rough wiring, electrical, plumbing, framing is covered. Also for air conditioning, dry wall and sheathing inspection.
- 2 I agree that when the job is completed that I will call for final inspection before occupancy.
- 3 I agree to perform all construction in accordance with City Ordinances and Building Codes.
- 4 The Contractor's signature below denotes authority from the owner to sign in his behalf and that the owner is aware of all requirements of this application and permit. Separate permits must be taken out for work outlined above this agreement.
- 5 I have read and understand the contents of this application and permit, I hereby state that the information I have supplied on this application is true and correct.
- 6 Approval for the work under this permit will be given only after refuse and debris have been removed from job site and public right of way.
- 7 24 HOUR MINIMUM NOTICE REQUIRED FOR INSPECTIONS.

SPECIAL CONDITIONS:

PLAN #: 6-229-M1

SEE PLOT PLAN

BY Sandy Norskog OWNER

BY Sandy Norskog-Project Coordinator AGENT

I hereby certify that I have reviewed this application and the proposed plans and have found that the proposed development meets the requirements of the City of Las Vegas Flood Hazard Reduction Ordinance for the issuance of this Development Permit.

LAND DEVELOPMENT AND FLOOD CONTROL ENGINEER

PLANNING DEPT


BUILDING DEPT

PLUMBING		FEE	ELECTRICAL		FEE
WATER DISTRIBUTION	6.00		RECEPTACLE _____ SWITCH _____	.40	
SEWER SYSTEM - NEW OR MODIFICATION	10.00		EACH LIGHT FIXTURE OR SOCKET _____	30	
FIXTURES - WATER SOFTENER, H.W. HEATER	2.00		SPECIAL OUTLET, APPLIANCE ETC	70	
GARBAGE DISPOSAL - WASHER	2.00		SERVICE/PANEL - SUB/3 00-200A/6 00-400A/12 50		
FUEL PIPING	6.00		A/C UNIT OR MOTORS	3.00	
IRRIGATION SYSTEM	8.00		2310 - 2432 TOTAL		
MISC			MISC		
2310 - 2433 TOTAL			2310 - 2431 ISSUANCE FEE	625.00	
AIR CONDITIONING		FEE	7143 - 2973 SEWER CONNECTION	10.00	
NEW UNIT - 3 TON = 9.00 OVER = 16.50			2310 - 2431 PLAN REVIEW FEE	313.00	
FURNACE TO 100,000/9 00 OVER/11 00			2310 - 2431 BLDG. PERMIT FEE	923.00	
VAPORATIVE COOLER	6.50		TOTAL FEES	948.00	
VENTILATION FAN	2.35				
2310 - 2435 TOTAL					

RECEIPT

PERMIT NO. _____
MUST BE MACHINE VALIDATED

Permit Expires 180 Days After Abandonment of Work

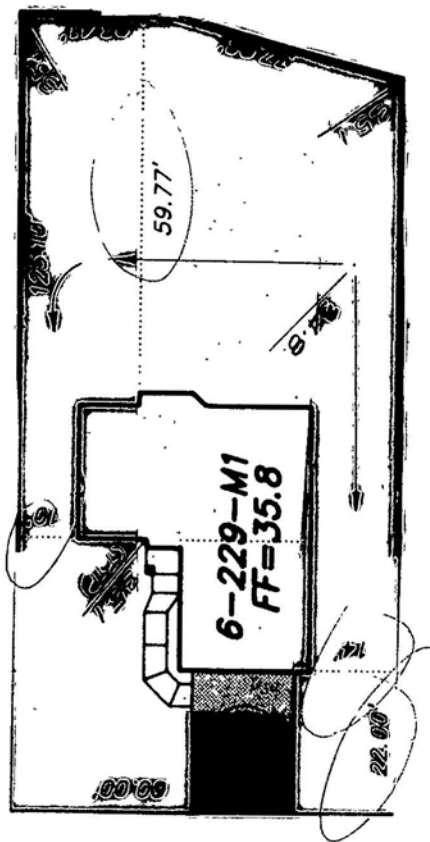

PLOT PLAN APPROVED
 By [Signature] 12/10/91
 COMMUNITY PLANNING & DEVELOPMENT
 City of Las Vegas

PLOT PLAN

LEWIS HOMES OF NEVADA

SUBDIVISION Rainbow Vista No. 13 **PHASE:** _____

Lot: 1041/2 **Address:** 6405 Grove Hill Lane

Refer to plot plan for model number.

CITY OF LAS VEGAS, NEVADA

PERMIT NO.

91-129470

DEPARTMENT OF BUILDING AND SAFETY
PHONE 386-6251

FOR INSPECTIONS, CALL 799-2071

BUILDING PERMIT

FOR: Single Family Dwelling, Remodel
Additions, Misc. Residential ConstructionLOG-NO. & AREA P-178 f DATE June 3, 1991 CONST. VAL. \$ 46,800.00ADDRESS OF CONSTRUCTION 6405 Grove Hill Lane OWNER Lewis Homes of Nevada PHONE 736-8960LOT(s) 1041 BLOCK Q SUBDIVISION Rainbow-Vista Festival 13-C-7 ZONE RCLPROPOSED CONSTRUCTION Single Family Residence USE DwellingTHIS PERMIT FOR BLDG. ☒ A/C ☒ ELEC. ☒ PLBG ☒ OTHER PERMITS REQD.: FENCE ☐ OFF SITE ☐ SWIM POOL ☐FLOOR AREA BSMT 182 1ST 814 2ND 814 GARAGE 406 PORCH 21 TOTAL 1535CONTRACTOR Lewis Homes of Nevada STATE LICENSE NO. 14761 CITY LICENSE NO. 8707 2023ARCHITECT Lewis Homes of Nevada ENGINEER G.C. WallaceMASTER PLUMBER/
CONTRACTOR _____ MASTER ELECTRICIAN/
CONTRACTOR _____

OTHER INSPECTIONS AND FEES

- 1 Inspections outside of normal business hours = \$30.00 per hour (minimum charge three hours)
- 2 Re-inspection fee during normal business hours assessed under provisions of TABLE 3-A of the Uniform Building Code = \$30.00 per hour
- 3 Inspections during normal business hours for which no fee is specifically indicated = \$30.00 per hour (minimum charge one half hour)
- 4 Additional plan review required by changes, additions, or revisions to approved plans = \$30.00 per hour (minimum charge two hours)

CONDITIONS OF THE PERMIT:

1. I agree to call the City Building Department for inspections before concrete is poured, before rough wiring, electrical, plumbing, framing is covered. Also for air conditioning, drywall and sheathing inspection
2. I agree that when the job is completed that I will call for final inspection before occupancy
3. I agree to perform all construction in accordance with City Ordinances and Building Codes.
4. The Contractor's signature below denotes authority from the owner to sign in his behalf and that the owner is aware of all requirements of this application and permit. Separate permits must be taken out for work outlined above this agreement.
5. I have read and understand the contents of this application and permit, I hereby state that the information I have supplied on this application is true and correct.
6. Approval for the work under this permit will be given only after refuse and debris have been removed from job site and public right of way
7. 24 HOUR MINIMUM NOTICE REQUIRED FOR INSPECTIONS.

BY _____
I HEREBY DECLARE THAT I AM THE LEGAL OWNER OF THE ABOVE PROPERTY OWNERBY Sandy Norskog
Sandy Norskog-Project Coordinator AGENT

I hereby certify that I have reviewed this application and the proposed plans and have found that the proposed development meets the requirements of the City of Las Vegas Flood Hazard Reduction Ordinance for the issuance of this Development Permit.

LAND DEVELOPMENT AND FLOOD CONTROL ENGINEER _____ DATE 12/9/91PLANNING DEPT _____ DATE 12/10/91BUILDING DEPT _____ DATE 12/3/91

SPECIAL CONDITIONS

PLAN #: 6-229-M1

SEE PLOT PLAN

RECEIPT

PLUMBING		FEE	ELECTRICAL		FEE
WATER DISTRIBUTION	6.00		RECEPTACLE _____ SWITCH _____		40
SEWER SYSTEM - NEW OR MODIFICATION	10.00		EACH LIGHT FIXTURE OR SOCKET _____		30
FIXTURES - WATER SOFTENER, H.W. HEATER	2.00		SPECIAL OUTLET, APPLIANCE ETC		70
GARBAGE DISPOSAL - WASHER	2.00		SERVICE/PANEL - SUB/3 00-200A/6.00-400A/12.50		
FUEL PIPING	6.00		A.C. UNIT OR MOTORS	3.00	
IRRIGATION SYSTEM	8.00		2310 - 2432	TOTAL	
MISC			MISC		
2310 - 2433	TOTAL				
AIR CONDITIONING		FEE	2310 - 2431 ISSUANCE FEE		
NEW UNIT - 3 TON = 9.00 OVER = 16.50			7143 - 2973 SEWER CONNECTION		625.00
FURNACE TO 100,000/9.00 OVER/11.00			2310 - 2431 PLAN REVIEW FEE		10.00
VAPORATIVE COOLER	6.50		2310 - 2431 BLDG PERMIT FEE		313.00
VENTILATION FAN	2.35				948.00
2310 - 2435	TOTAL		TOTAL FEES		

PERMIT NO. _____
MUST BE MACHINE VALIDATED

Permit Expires 180 Days After Abandonment of Work