

2225 BRADY ST.

LOT 52 BK 2 GREATER LAS VEGAS ADDN #3 UNIT 5-A ZONE R-1

D. Gatewood 1-29-79

1968
CITY OF LAS VEGAS, NEVADA

LOG NO. & AREA T-15/2

CONST. VAL. \$ 15,238.00

DEPARTMENT OF BUILDING & SAFETY

APPLICATION & BUILDING PERMIT — for:

Dwellings, Duplexes, Misc. Residential Const.

ADDRESS OF CONSTRUCTION: 2225 Brady Street

OWNER: Nevada Western Development Corp.,
Formerly Mortgage Services, Inc.

LOT(s) 52 BLOCK 2 SUBDIVISION Greater Las Vegas Addn. 3, Unit 5-A ZONE: R-1

Existing structure on lot: Dwelling ☒ Accessory bldg. ☐ Vacant lot ☐ Other ☐

PROPOSED CONSTRUCTION: Single family dwelling with garage USE: Residence

MATERIALS OF CONSTRUCTION: Wood frame ☒ Concrete Block ☐ Reinforced Concrete ☐ Steel Frame ☐

SQUARE FEET OF FLOOR AREAS: 1st _____ 2nd _____ 3rd _____ Other _____ TOTAL SQ. FT. 1362 + 306


FIRE ZONE: 1 2 3 Occupancy Group A B C D E F G H I J 1-2-3-4-5. CONST. TYPE: I II III IV V

ARCHITECT: None ENGINEER: Voorheis-Trindle NO. of UNITS _____ NO. of STORIES _____

Plans Submitted: Yes ☒ No ☐ Calculations Submitted Yes ☒ No ☐ Sewer Fee Req'd. Yes ☐ No ☐

CONTRACTOR: Robert Shaw STATE LICENSE # R 9440 CITY LICENSE # C11-916-2-12446

ADD'L. PERMITS REQ'D: Air Cond. ☐ Elec. ☐ Plumbing ☐ Signs ☐ Paving ☐ Fence ☐ Public Walks ☐ Curb-gutters ☐
Incinerators ☐ Fire Sprinkling System ☐

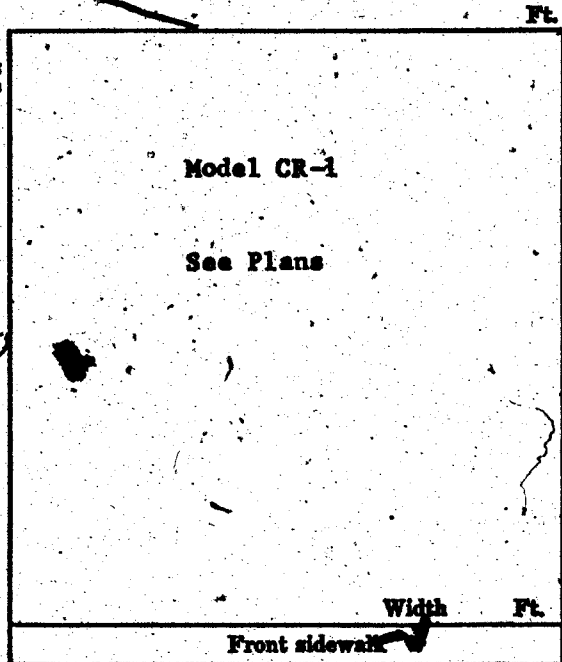

CONDITIONS OF THE PERMIT:

1. I agree to call the City Building Department for inspections before concrete is poured, before rough wiring, electrical, plumbing, framing is covered. Also for Air conditioning, sheet-rock and sheathing inspection.
2. I agree that when the job is completed that I will call for final inspection before occupancy.
3. I agree to perform all construction in accordance with City Ordinances and Building Codes.
4. The Contractor's signature below denotes authority from the owner to sign in his behalf and that the owner is aware of all requirements of this application and permit. Separate permits must be taken out for work outlined above this agreement.
5. I have read and understand the contents of this application and permit; I hereby state that the information I have supplied on this application is true and correct.

SIGNED: Robert Shaw Contractor

BY: R. Shaw Agent or Owner

CLARK COUNTY HEALTH DEPT.

LAS VEGAS FIRE DEPARTMENT

RECEIPT

083 \$854.00 - 8

CITY OF LAS VEGAS
DEPT. OF
BUILDING & SAFETY

MUST BE MACHINE VALIDATED

24 MAY 68

PLANNING DEPT: [Signature] Date: 5-24-68

ENGINEERING DEPT: [Signature] Date: 5-24-68

BUILDING DEPT: [Signature] Date: 5-24-68

#1285 O PERMIT NO: 41999 PERMIT FEE \$ 54.00

G. Gatewood 1-29-79

CITY OF LAS VEGAS, NEVADA
DEPARTMENT OF BUILDING & SAFETY

SEWER CONNECTION FEE: \$

RECEIPT
for
SEWER CONNECTION FEE

JOB ADDRESS: 2225 Brady Street OWNER'S NAME: Nevada Western Development Corp.
LOT 52 BLOCK 2 SUBDIVISION Greater Las Vegas Addn. 3. Unit 5-A

QUANTITY	OCCUPANCY	UNIT FEE	AMOUNT
1	Sewer Conn. - S. F. D.	150.00	150.00
TOTAL		150.00	
Less Credit*			
TOTAL FEE \$		150.00	

*Credit for existing sewer is applied to the new sewer connection fee based on previous type of occupancy and only when the new occupancy requires an additional fee.
This receipt does not authorize the owner or his representative to start any work without obtaining a plumbing permit.

J. W. ...
DEPARTMENT OF BUILDING & SAFETY DATE 5-24-68

#12070 RECEIPT NO. 22702 SEWER FEE \$ 150.00
73102

Receipt

100 150.00 - 3

CITY OF LAS VEGAS
DEPT. OF
BUILDING & SAFETY

Must be machine validated
2-2-68

23.30

D. Gatewood 1-29-79

CITY OF LAS VEGAS, NEVADA
DEPARTMENT OF BUILDING & SAFETY

PERMIT FEE \$ 20.00
APPLICATION & PERMIT FOR PLUMBING

JOB ADDRESS: 2225 Brady

OWNER'S
NAME: Robert Shaw

LOT 52 BLOCK 2 SUBDIVISION Brigida Bldg. type: SFD ☒ APT ☐ COMM

Circle: New bldg; Old bldg; Addn; Remodel; Pool; Wtr. Sftner; Lawn Sprkr; Other

CONTRACTOR: Cox Plumbing

State Lic. # 7576 City Lic. # 40100

QUANTITY	FIXTURE OR INSTALLATION	Unit Price	AMOUNT
1	Bath tub	1.00	1.00
	Clothes dryer (gas)	1.00	
1	Clothes washer	1.00	1.00
	Dental unit	1.00	
	Dishwasher	1.00	
	Drinking fountain	1.00	
	Fire sprinkling - underground piping	5.00	
	Fire sprinkling - distribution piping per each foot	.01	
	Fire sprinkling heads - per each head	.10	
1	Floor drain \$1.00 Floor sink	1.00	
	Gas appliance (any type)	1.00	
1	Gas piping system - single family dwelling	3.00	3.00
	Gas piping system - multiple family \$3 per each unit plus	1.00	
	Gas piping system - commercial bldg. per each floor	3.00	
	Grease trap	1.00	
	Irrigation system	4.00	
2	Lavatory	1.00	2.00
	Minimum fee for any permit	4.00	
1	Piping, Drainage	4.00	4.00
	Sewer replacement	4.00	
	Septic disposal system - Health Dept. approval required	4.00	
1	Shower	1.00	1.00
1	Sink - kitchen type	1.00	1.00
	Swimming pool - private - wading pool	8.00	
	Swimming pool - public - semi-public	12.00	
2	Toilet	1.00	
	Urinal	1.00	
1	Water distribution system, single family dwelling	4.00	4.00
	Water distribution system multiple dwg. \$4 + each unit	1.00	
	Water distribution system, Group "A" thru "G" per each floor	4.00	
	Water distribution system, Group "H" (hotel) \$4 + per bath*	.50	
1	Water heater (gas) (electrical)	1.00	1.00
	Water using equipment	1.00	
	Water softener nonpermanent type	4.00	
	Water softener permanent (connected to drainage)	5.00	
	Wash tray	1.00	

I hereby certify that I have carefully examined & read the above application; that the same is true & correct; and the work herein described is to be done in accordance with the provisions of City of Las Vegas Ordinances & State Laws, whether herein specified or not. * As defined in City Code and Ordinances.

SIGNED: Orde Cox Date: 8/5/68
Registered Plumber Spec. Cont'r Owner

Engineering Dept. Date Building Department Date
Sewer Conn. Fees
Paid in Engr. Dept. PERMIT NO. 24498 PERMIT FEE \$20.00
23.10 #12870

TOTAL FEE \$ 20.00

RECEIPT

3238 \$020.00 -
CITY OF LAS VEGAS
DEPT. OF
BUILDING & SAFETY
Must be machine validated
- 5 AUG 68

D. Gatewood 1-29-79

CITY OF LAS VEGAS, NEVADA

DEPARTMENT OF BUILDING & SAFETY - ELECTRICAL APPLICATION & PERMIT

ADDRESS OF
CONSTRUCTION: 2225 Brady

OWNER'S
NAME: Nevada Western

LOT(S) BLOCK SUBDIVISION Type of bldg. SFD ☐ Apt. ☐ Comm. ☐

Check Proper Construction: New Bldg. ☒ Addn. ☐ Remodel ☐ Temporary Pole ☐ Old Bldg. ☐

CONTRACTOR'S NAME: Cadenbach Electric

STATE
LICENSE # 8016

CITY
LICENSE # 09013

NUMBER	FIXTURE OR INSTALLATION	UNIT PRICE	
10	Fixture or sockets	.15	1.50
47	Light, receptacle or switch outlet	.20	9.40
	Wall or ceiling space heater	.35	
	Blast coil heater per kilowatt	.35	
1	Garbage grinder outlet	.35	.35
1	Dishwasher outlet	.35	.35
	Clothes dryer outlet	.35	
1	Automatic clothes washer	.35	.35
	Electric range outlet	.35	
	Electric water heater outlet	.35	
	Mercury arc lamp and equipment	.35	
2	Special purpose outlet	.35	.70
	X-ray unit and its appurtenances	5.00	
	Watts of festoon lighting (Watts) First 3,000 watts	4.00	
	for each additional thousand watts	1.50	
	Horsepower - all motors first horsepower or less	1.75	
	for each additional horsepower	.35	
	Temporary power and lights (temporary pole)	4.00	
1	Electric service (including any single meter socket)	3.00	3.00
	for each additional socket	.35	
1	Air conditioning service	1.50	1.50
	amps		
	Each KW (KVA) Generator (Transformer) (Welder) KW (KVA)	2.00	
	First 100 KVA - For each additional KW (KVA)	.01	
	Special inspection per hour	4.00	
	Speaker outlets	.15	
	Signal or Alarm outlets	.15	
	Amplifiers	.50	
	Control panels	.25	
	T. V. outlets - master system only	.15	
	Radio outlets	.15	
	Main control racks	1.00	
	T. V. and Radio antennas - master system only	.75	
	Minimum fee for any permit	4.00	
	Total fee		17.15

I hereby certify that I have carefully examined and read the above application; that the same is true and correct; and that the work herein described is to be done in accordance with all the provisions of the applicable Ordinances of the City of Las Vegas, Nevada and State laws whether herein specified or not.

SIGNED

MASTER ELECTRICIAN (TECHNICIAN) (OWNER)

Date 8/19/68

BUILDING DEPARTMENT

Date 8/20/68

#1286

PERMIT NO. 26135

PERMIT FEE: \$ 17.15

RECEIPT

3852 \$017.15 - 6

CITY OF LAS VEGAS

DEPT. OF
BUILDING & SAFETY
MUST BE MACHINE VALIDATED

20 AUG 68

D. Gatewood 1-29-79

PERMIT FEE \$ 7.00

CITY OF LAS VEGAS, NEVADA
DEPARTMENT OF BUILDING & SAFETY
ADDRESS OF

APPLICATION & PERMIT FOR
AIR CONDITIONING

CONSTRUCTION: 2225 Brady St., Las Vegas, Nevada OWNER'S NAME: Mortgage Services, Inc.

CIRCLE: New bldg Old bldg; Add'n; Remodel; TYPE OF BLDG: SFD APT. COMM.
Clark County Air Conditioning STATE CITY

CONTRACTOR'S NAME: ~~XXXXXXXXXXXX~~ LICENSE #8133A LICENSE # 1655

UNITS	HEATERS	PRICE	FEE	UNITS	GAS	PRICE	FEE
	Unit Heaters (floor, suspended & wall)	\$2.00			Gas piping system 1 to 5 outlets	\$3.00	
	Floor Furnace	\$3.00			Gas piping system over 5 outlets (per outlet)	.20	
	Forced Air or Gravity Type under 100,000 BTU's	\$7.00			Swimming pool heater	\$4.00	
	Steam or hot water heating system under 15 outlets (Boiler Excluded)	\$8.00			VENTS		
	Steam or hot water heating system 15 to 30 outlets (Boiler excluded)	\$10.00			Combustion products vent other than a chimney	\$1.00	
	Each outlet over 30	.50			Residential kitchen or bathroom vent each	.25	
	Radiant type heating system under 1000 sq.ft. to be heated	\$ 8.00			Commercial Hood	\$4.00	
	Radiant type heating system 1000 to 2000 sq. ft. to be heated	\$10.00			Ventilation system not a portion of any heating or air conditioning system up to \$1,000 valuation	\$5.00	
	Each additional 500 sq.ft. over 2000 sq. ft.	.50			BOILER		
	AIR CONDITIONING				Boiler installation 15 H.P. and under	\$5.00	
	Heat pump or refrigerant 3 tons or less.	\$4.00			Boiler installation over 15 H.P.	\$10.00	
	Heat pump or refrigerant 3 tons to 10 tons	\$6.00			REPAIR		
	Each addn.ton over 10 ton	.50			Inspection of alteration or replacement of any mechanical cooling equipment which is a portion of any air conditioning system	\$3.00	
1	Refrigeration system 3 ton or less	\$5.00	5.00		DUCT WORK (each opening) ONLY	.25	2.00
	Refrigeration system 3 to 10 ton	\$7.00			WATER TOWER	\$4.00	
	Each addn.ton over 10 ton	.50			MINIMUM PERMIT FEE	\$4.00	
	Evaporative cooler 5 outlets and under	\$3.00			TOTAL PERMIT FEE	\$7.00	
	Evaporative cooler 5 to 10 outlets	\$5.00					
	Each addn..outlet over 10	.25					

I hereby certify that I have carefully examined & read the above application; that the same is true & correct; & that the work herein described is to be done in accordance with all the provisions of the applicable Ordinances of the City of Las Vegas and the State laws, whether herein specified or not.

SIGNED: [Signature] DATE: 8/21/68
BUILDING DEPARTMENT
#1289 PERMIT NO. 16516 PERMIT FEE \$ 7.00

CITY OF LAS VEGAS
DEPT. OF
BUILDING & SAFETY

Must be machine validated

21 AUG 68

23.05

M. Gatewood 1-29-79

CITY OF LAS VEGAS, NEVADA

LOG NO. & AREA _____

CONST. VAL: 135⁰⁰

DEPARTMENT OF BUILDING & SAFETY

APPLICATION & BUILDING PERMIT — for:
Fence, Wall, Retaining Wall.

ADDRESS OF CONSTRUCTION: 2225 Brady Street

OWNER: Nevada Western Development Corp.

LOT(s) 52 BLOCK 2 SUBDIVISION Greater Las Vegas Addr. 3, Unit 5-A ZONE: R-1

Materials of Construction: Block ☒ Concrete ☐ Wire ☐ Wood ☐ Other ☐ Yes No

PLANS: ☐ ☒

ARCHITECT: _____ ENGINEER: _____ CALCS: ☐ ☒


CONTRACTOR: Ernie Black STATE LICENSE # 9721 CITY LICENSE # C11197

TOTAL SQUARE FEET: _____ TOTAL LINEAL FEET: 40
(40' High)

Remarks:

CONDITIONS OF THE PERMIT:

1. Any type of retaining wall must be engineered by a Civil or Structural Engineer.
2. If a home owner takes out the Building Permit and if the owner sublets the work to a Contractor, then the Contractor must take out the permit and pay for it.
3. No fence or wall can be built on City property or rights-of-way, but this is not intended to preclude construction within utility easements if utilities will not be damaged or made inaccessible.
4. The fence or wall shall not enclose any water meter, light standard, or fire alarm box and shall not come closer than 24" from the nearest fire hydrant outlet.
5. Department Inspectors must approve footings before concrete is poured and block wall reinforcing before grouting is done.
6. Maximum height of any wall or fence is 6', side and rear yards; 4' maximum in front yard with the vertical surface above the height of 2' — 50% open and further that fencing within 25' of the intersection of curb faces on corner and through lots is limited to a maximum height of 30".
7. I must not obstruct required onsite parking space (1 space for each dwelling unit) by the erection of this fence or wall.
8. By the signing of this application I herewith agree to the requirements outlined above.

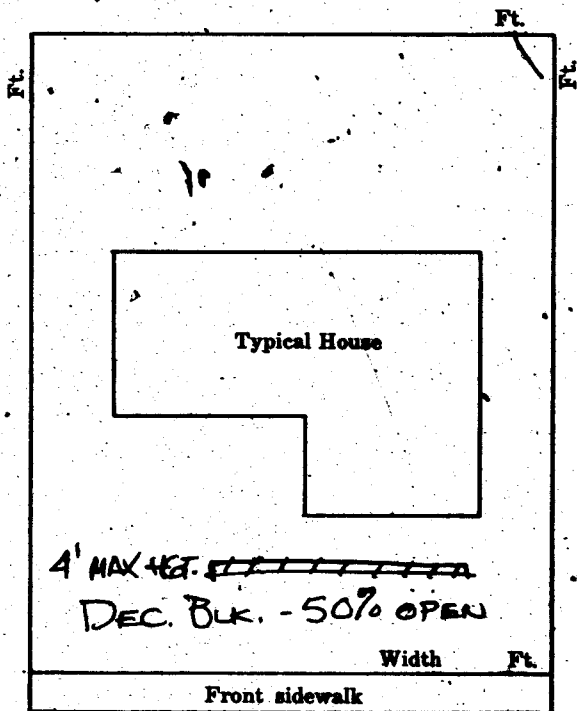

SIGNED: E. Black DATE: _____
CONTRACTOR ☒ AGENT ☐ OWNER ☐

PLANNING DEPT: [Signature] Date: 10-5-68

ENGINEERING DEPT: _____ Date: _____

BUILDING DEPT: [Signature] Date: 10-16-68

#1285

PERMIT NO: 44851 PERMIT FEE: 4.00

RECEIPT
6573 \$004.00 - 8
CITY OF LAS VEGAS
DEPT. OF BUILDING & SAFETY
MUST BE MACHINE VALIDATED
16 OCT 68

W. Gatewood 1-29-79

CITY OF LAS VEGAS, NEVADA

LOG NO. & AREA _____

CONST. VAL \$ 100.

DEPARTMENT OF BUILDING & SAFETY

APPLICATION & BUILDING PERMIT — for:
Fence, Wall, Retaining Wall.

ADDRESS OF CONSTRUCTION: 2225 Brady

OWNER: Robt. Slawson Carst.

LOT(s) 52 BLOCK 2 SUBDIVISION Greater LV add 3 Unit 5A ZONE: R-1.

Materials of Construction: Block ☐ Concrete ☐ Wire ☐ Wood ☒ Other ☐

Yes No

PLANS: ☐ ☐

ARCHITECT: _____

ENGINEER: _____

CALCS: ☐ ☐

CONTRACTOR: Fortuna Fencing


STATE LICENSE # 5906 A CITY LICENSE # 8489

TOTAL SQUARE FEET: 450 TOTAL LINEAL FEET: 75

Remarks: _____

CONDITIONS OF THE PERMIT:

1. Any type of retaining wall must be engineered by a Civil or Structural Engineer.
2. If a home owner takes out the Building Permit and if the owner sublets the work to a Contractor, then the Contractor must take out the permit and pay for it.
3. No fence or wall can be built on City property or rights-of-way, but this is not intended to preclude construction within utility easements if utilities will not be damaged or made inaccessible.
4. The fence or wall shall not enclose any water meter, light standard, or fire alarm box and shall not come closer than 24" from the nearest fire hydrant outlet.
5. Department Inspectors must approve footings before concrete is poured and block wall reinforcing before grouting is done.
6. Maximum height of any wall or fence is 6', side and rear yards; 4' maximum in front yard with the vertical surface above the height of 2' — 50% open and further that fencing within 25' of the intersection of curb faces on corner and through lots is limited to a maximum height of 30".
7. I must not obstruct required onsite parking space (1 space for each dwelling unit) by the erection of this fence or wall.
8. By the signing of this application I herewith agree to the requirements outlined above.

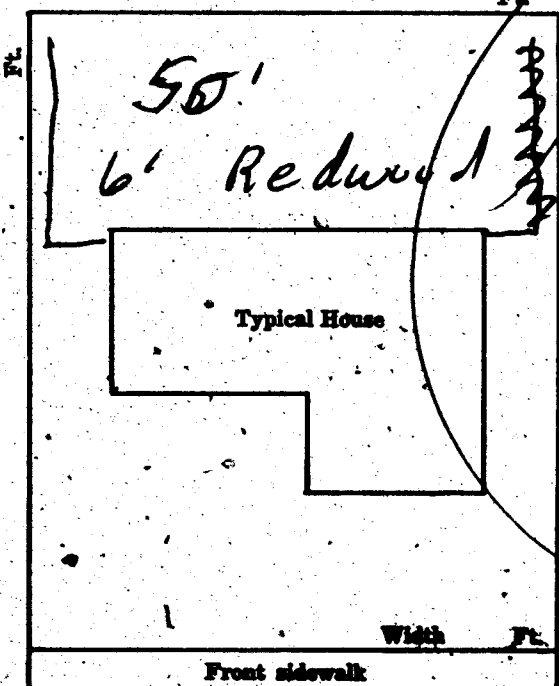

SIGNED: R. M. Gordon CONTRACTOR ☒ AGENT ☐ OWNER ☐

DATE: 10/28/68

PLANNING DEPT: _____

Date: 10-28-68

ENGINEERING DEPT: _____

Date: _____

BUILDING DEPT: _____

Date: 10-28-68

#1285

PERMIT NO: 4497

PERMIT FEE \$ 300

RECEIPT

7048 \$003.00 - 8
CITY OF LAS VEGAS
DEPT. OF
BUILDING & SAFETY

MUST BE MACHINE VALIDATED

28 OCT 68

D. Gatewood 1-29-79

CITY OF LAS VEGAS, NEVADA

LOG NO. & AREA

DEPARTMENT OF BUILDING & SAFETY

CONST. VAL. \$

600

APPLICATION & BUILDING PERMIT — for:
Dwellings, Duplexes, Misc. Residential Const.

ADDRESS OF CONSTRUCTION: 2225 BRADY

OWNER: STEVE FULMER

LOT(s) 52 BLOCK 2 SUBDIVISION 400 3 UNITS-A ZONE: R-1

Existing structure on lot: Dwelling ☒ - Accessory bldgs. ☐ Vacant lot ☐ Other ☐

PROPOSED CONSTRUCTION: FIREPLACE USE:

MATERIALS OF CONSTRUCTION: Wood Frame ☐ Concrete Block ☐ Reinforced Concrete ☐ Steel Frame ☐

SQ. FEET OF FLOOR AREAS: 1st 2nd 3rd Other TOTAL SQ. FT.


FIRE ZONE: 1 2 3 Occupancy Group 1 J 1 - 2 CONST. TYPE I II III IV V

ARCHITECT: ENGINEER: NO. of UNITS NO. of STORIES

Plans Submitted: Yes ☐ No ☐ Calculations Submitted: Yes ☐ No ☐ Sewer Fee Req'd. Yes ☐ No ☐

CONTRACTOR: OWNER STATE LICENSE CITY LICENSE

ADD'L. PERMITS REQ'D: Air Cond. ☐ Elec. ☐ Plumbing ☐ Signs ☐ Paving ☐ Fence ☐ Public Walks ☐ Curb-gutters ☐
Incinerators ☐ Fire Sprinkling System ☐

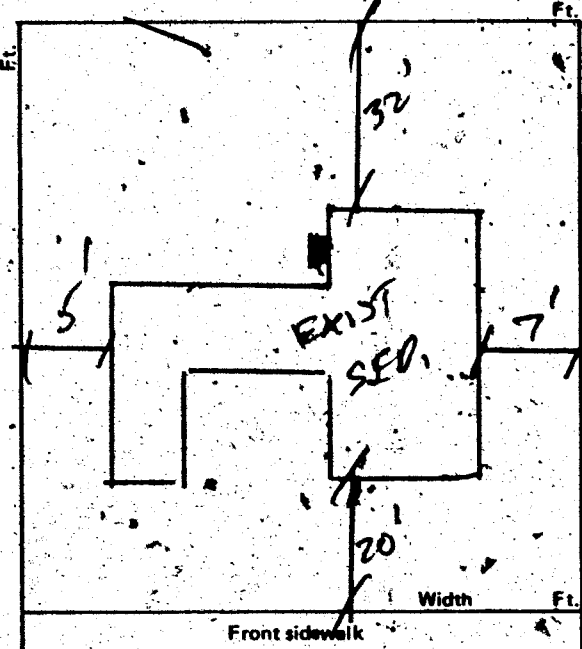

CONDITIONS OF THE PERMIT:

1. I agree to call the City Building Department for inspections before concrete is poured, before rough wiring, electrical, plumbing, framing is covered. Also for air conditioning, sheet-rock and sheetrock inspection.
2. I agree that when the job is completed that I will call for final inspection before occupancy.
3. I agree to perform all construction in accordance with City Ordinances and Building Codes.
4. The Contractor's signature below denotes authority from the owner to sign in his behalf and that the owner is aware of all requirements of this application and permit. Separate permits must be taken out for work outlined above this agreement.
5. I have read and understand the contents of this application and permit; I hereby state that the information I have supplied on this application is true and correct.

Approval for the work under this permit will be given only after refuse and debris have been removed from job site and public right of way.

SIGNED: Steve Fulmer Contractor

BY: Agent or Owner

CLARK COUNTY HEALTH DEPT.

LAS VEGAS FIRE DEPARTMENT

PLANNING DEPT.: Date: 12/1/75

PUBLIC WORKS DEPT.: Date: 12/1/75

BUILDING DEPT.: Date: 800

12850 PERMIT NO.: 5131 PERMIT FEE \$

RECEIPT

3806 \$008.00 - 8

CITY OF LAS VEGAS
DEPT. OF
BUILDING & SAFETY

MUST BE MACHINE VALIDATED

- 2 FEB 75

Angela L. Jackson 2/25/80

DEPARTMENT OF BUILDING & SAFETY
CITY OF LAS VEGAS, NEVADA

KARDEX CARD
FENCE & RETAINING
WALLS

OWNER Robert Shaw Cont. ADDRESS 2225 Brady DATE 10/29/68

CONTRACTOR FORTUNE FENCING PERMIT NO. 44971

LOT 52 BLOCK 2 SUBDIVISION Greater L. V. #3

Wood fence

Fence (wire, wood, etc.)

Walls (masonry, rock, etc.)

Location

Location

Final Inspection 10/11/68

Footings

Wall Steel 1st 2d 3d

Final Inspection

Retaining Wall (masonry)

Retaining Wall (concrete)

Location

Location

Footings

Footings

Wall Steel 1st 2d 3d

Wall Steel 1st 2d 3d

Bond Beam 1st 2d 3d

Final Inspection

Final Inspection

23.14 B

ADDRESS 2225 Brady

LOG NO.

AREA

DEPT. of BLDG. & SAFETY - CITY of LAS VEGAS, NEVADA

OWNER Steve Fulmer

ADDRESS 2225 Brady

DATE 12-1-75

GEN. CONT. Owner

TYPE OF STRUCTURE Fireplace

PERMIT NO. 5131

LEGAL DESCRIPTION

L 52 B 2 Gr. L.V. Add Su

BUILDING	MECHANICAL	ELECTRICAL
Investigation	Plumbing Cont.	Temp. pole cont.
Location & Footing	Permit No. _____ Date _____	Permit No. _____ Date _____
Stem Wall	Heat & Vent. A/C Cont.	Inspection _____ Date _____
Concrete Slab Floor	Permit No. _____ Date _____	Electrical Cont.
Floor Framing	Sewer Cont.	Permit No. _____ Date _____
Fireplace Footing	Permit No. _____ Date _____	Fixtures Cont.
Chimney Steel	Rough Soil	Permit No. _____ Date _____
Vert. Steel Reinf.	Rough Water	Slab _____
Horiz. Steel Reinf.	Top-Out	Rough _____
Roof Sheathing	Rough Gas	Final Rough
Framing	A/C Rough Duct	Final Fixtures
Backing for siding	Ref. Rough Piping	Final Electrical
Ext. Lath	Final Plumbing	
Ext. Scratch	Final Gas	Temporary Service
Ext. Brown	Final Air Cond.	
Int. Lath	Final Refrig.	
Int. Brown	Final Sewer	
Drywall	Final Septic Tank	
Permit No.		
Final Building		
Appr. for Occu.		

INSPECTOR:

DATE

APPROVED FOR OCCUPANCY & METER

PLEASE NOTE REMARKS ON REVERSE SIDE

2225 Brady

LOG #

AREA #

Angela L. Jackson 2/20/80

DEPARTMENT OF BUILDING & SAFETY
CITY OF LAS VEGAS, NEVADA

KARDEX CARD
FENCE & RETAINING
WALLS

OWNER Nevada Western Dev. Address 2225 Brady DATE 10/16/68

CONTRACTOR Ernie Smith PERMIT NO. 44857

LOT 52 BLOCK 2 SUBDIVISION Gr. L.V. Add #3

Block fence

Fence (wire, wood, etc.)	Walls (masonry, rock, etc.)
Retaining Wall (masonry)	Retaining Wall (concrete)
Location	Location
Footings	Footings
Wall Steel 1st 2d 3d	Wall Steel 1st 2d 3d
Bond Beam 1st 2d 3d	Final Inspection
Final Inspection	

23.14 B

ADDRESS 2225 Brady LOG NO. AREA

DEPT. OF BLDG. & SAFETY—CITY OF LAS VEGAS, NEVADA
OWNER NEV. WESTERN DEV. CORP. ADDRESS 2225 BRADY ST. DATE 5-24-68
GEN. CONTR. ROBERT SHAW TYPE OF STRUCTURES F.D. WITH
PERMIT NO. 41999 LEGAL DESCRIPTION Lot 52, Blk. 2, GLV. ADD. #3, UNIT 5-A GAR.

BUILDING	MECHANICAL	ELECTRICAL
INTERIOR	FINAL PLUMBING <i>168-22-68</i>	TEMPORARY SERVICE
EXTERIOR	FINAL GAS <i>168-19-68</i>	
DRYWALL <i>169-4-68</i>	FINAL AIR COND. <i>168-12-68</i>	
LATHING	FINAL REFRIG. <i>168-12-68</i>	
BACKING (SIDING)	FINAL SEWER <i>168-12-68</i>	
PLASTER SCRATCH	FINAL SEPTIC TANK	
PLASTER BROWN		
URBAN REDEVELOPMENT APPROVAL		

APPROVED FOR OCCUPANCY & METER

INSPECTOR

DATE

PLEASE NOTE REMARKS ON REVERSE SIDE

2225 BRADY ST.

LOG # T-15/2 AREA #

23.04