

5712 CABRILLO CR.

LOT 35 BLK 2 TWIN LAKES VILLAGE 14-A ZONE R-1

L. Gatewood 2-5-79

CITY OF LAS VEGAS, NEVADA
DEPARTMENT OF BUILDING & SAFETY
APPLICATION & BUILDING PERMIT
for FENCE, WALL, RETAINING WALL

PERMIT FEE: \$ 400.00
CONSTRUCTION
VALUATION: \$ 348.00
INSPECTION
VALUATION: \$ 276.00

ADDRESS OF
CONSTRUCTION: 5712 Phill

OWNER'S
NAME: First National

OWNER'S
ADDRESS:

Lot (s) 35 Block 2 Subdivision TRIN LAKES VILLAGE #14A Zone R-1

Materials of Concrete

Construction: Block () Concrete () Wire () Wood (X) Other ()

Total Square Feet:

Total Lineal Feet 276' 8 1/2" / 6 1/2"

CONTRACTOR'S NAME: J. M. D. D.

STATE

CITY

LICENSE # 827

LICENSE # 1432-1

Architect's Name:


PLANS SUBMITTED:

Yes No

Engineer's Name:

CALCULATIONS:

Yes No

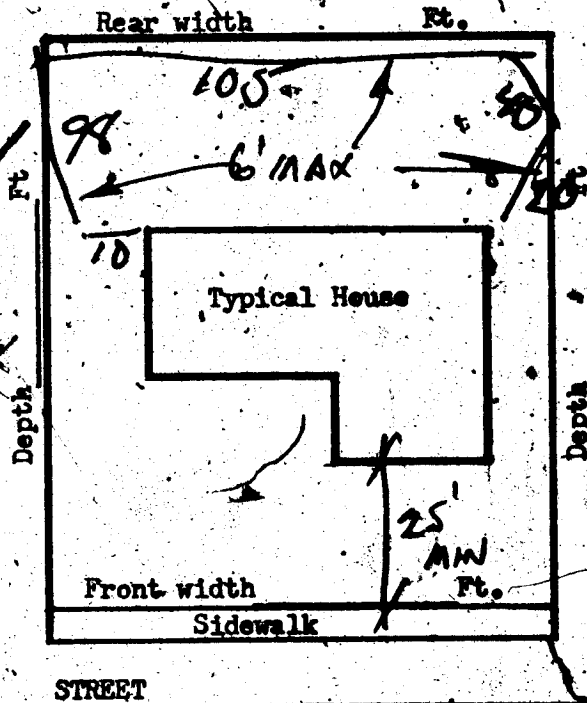

I understand that any portion of this (fence) (wall) constructed or erected on City property or right-of-way will be removed from said location at my expense upon request received from the City of Las Vegas, Nevada. I understand that the (fence) (wall) shall not enclose water meter, light standard, fire alarm box & shall not come closer than two (2') feet in any direction from any fire hydrant. I further state that I am familiar with effective Ordinances of the City of Las Vegas, Nevada & effective Statutes of the State of Nevada covering construction and use of the above type; I agree to perform said construction in conformity therewith. I further agree that issuance of a permit on above application will not excuse me from conforming with said Ordinances and Statutes, despite any errors on the part of the Building Inspector or Engineer in checking plans and applications herewith submitted. I have read and understand the contents of above application & permit; I hereby state that same are true and correct.

SIGN HERE: By: J. M. D. D. Date: 7/5/66

APPROVED BY: J. M. D. D. DATE: 7/5/66
PLANNING DEPT. & CODE ASSISTANCE

FIRE DEPARTMENT DATE

ENGINEERING DEPARTMENT DATE

BUILDING & SAFETY DEPARTMENT DATE

#1285

PERMIT NO. 34326

PERMIT FEE \$ 400.00

504 RECORD - 8

CITY OF LAS VEGAS
DEPT. OF
BUILDING & SAFETY

Not be taken valid

G. Gatewood 2-5-79

PERMIT FEE \$ 4.00

CITY OF LAS VEGAS, NEVADA
DEPARTMENT OF BUILDING & SAFETY
ADDRESS OF

APPLICATION & PERMIT FOR
AIR CONDITIONING

CONSTRUCTION: 5712 Cabrillo Circle

OWNER'S NAME: FIRST WESTERN SAVINGS

CIRCLE: New bldg; Old bldg; Add'n; Remodel; TYPE OF BLDG. SFD

APT. COMM. CITY C-11-317-2

CONTRACTOR'S NAME: RED DAVIS CO.

STATE LICENSE # 8951

LICENSE # 09426

UNITS	HEATERS	PRICE	FEE	UNITS	GAS	PRICE	FEE
	Unit Heaters (floor, suspended & wall)	\$2.00			Gas piping system 1 to 5 outlets	\$3.00	
	Floor Furnace	\$3.00			Gas piping system over 5 outlets (per outlet)	.20	
	Forced Air or Gravity Type under 100,000 BTU's	\$7.00			Swimming pool heater	\$4.00	
	Steam or hot water heating system under 15 outlets (Boiler Excluded)	\$8.00			VENTS		
	Steam or hot water heating system 15 to 30 outlets (Boiler excluded)	\$10.00			Combustion products vent other than a chimney	\$1.00	
	Each outlet over 30	.50			Residential kitchen or bathroom vent each	.25	
	Radiant type heating system under 1000 sq.ft. to be heated	\$ 8.00			Commercial Hood	\$4.00	
	Radiant type heating system 1000 to 2000 sq. ft. to be heated	\$10.00			Ventilation system not a portion of any heating or air conditioning system up to \$1,000 valuation	\$5.00	
	Each additional 500 sq.ft. over 2000 sq. ft.	.50			BOILER		
	AIR CONDITIONING				Boiler installation 15 H.P. and under	\$5.00	
1	Heat pump or refrigerant 3 tons or less.	\$4.00	4.00		Boiler installation over 15 H.P.	\$10.00	
	Heat pump or refrigerant 3 tons to 10 tons	\$6.00			REPAIR		
	Each addn. ton over 10 ton	.50			Inspection of alteration or replacement of any mechanical cooling equipment which is a portion of any air conditioning system	\$3.00	
	Refrigeration system 3 ton or less	\$5.00			DUCT WORK (each opening) ONLY	.25	
	Refrigeration system 3 to 10 ton	\$7.00			WATER TOWER	\$4.00	
	Each addn. ton over 10 ton	.50			MINIMUM PERMIT FEE	\$4.00	
	Evaporative cooler 5 outlets and under	\$3.00			TOTAL PERMIT FEE	\$4.00	
	Evaporative cooler 5 to 10 outlets	\$5.00					
	Each addn. outlet over 10	.25					

I hereby certify that I have carefully examined & read the above application; that the same is true & correct; & that the work herein described is to be done in accordance with all the provisions of the applicable Ordinances of the City of Las Vegas and the State laws, whether herein specified or not.

SIGNED: [Signature]

DATE: Nov. 3, 1966

Air Conditioning Contractor

DATE: Nov. 3, 1966

BUILDING DEPARTMENT

#1289

PERMIT NO. 14239

PERMIT FEE \$ 4.00

957 5004.00 - 4
CITY OF LAS VEGAS
DEPT. OF BUILDING & SAFETY
Must be machine validated

661 RECEIPT \$003.00 - 8
CITY OF LAS VEGAS
DEPT. OF
BUILDING & SAFETY
Must be machine validated
- 7 NOV 66

L. Gatewood 2-5-79

PERMIT FEE \$ 4.00

CITY OF LAS VEGAS - DEPARTMENT OF BUILDING & SAFETY - ELECTRICAL APPLICATION & PERMIT

ADDRESS OF CONSTRUCTION: 5712 Caballo Cr

OWNER'S NAME: First Western

LOT (S) BLOCK SUBDIVISION

Type of bldg. SFD ☐ Apt ☐ Comm ☐

Check Proper Construction: New Bldg ☐ Addn. ☐ Remodel ☐ Temporary Pole ☐ Old Bldg ☐

CONTRACTOR'S NAME Robert Ellis

STATE LICENSE # CITY LICENSE #

NUMBER	FIXTURE OR INSTALLATION	UNIT PRICE
	Fixture or sockets	.15
	Light, receptacle or switch outlet	.20
	Wall or ceiling space heater	.35
	Blast coil heater per kilowatt	.35
	Garbage grinder outlet	.35
	Dishwasher outlet	.35
	Clothes dryer outlet	.35
	Automatic clothes washer	.35
	Electric range outlet	.35
	Electric water heater outlet	.35
	Mercury arc lamp and equipment	.35
	Special purpose outlet	.35
	X-ray unit and its appurtenances	5.00
	Watts of festoon lighting (Watts) First 3,000 watts	4.00
	for each additional thousand watts	1.50
	Horsepower - all motors first horsepower or less	1.75
	for each additional horsepower	.35
	Temporary power and lights (temporary pole)	4.00
	Electric service (including any single meter socket)	3.00
	for each additional socket	.35
	Air conditioning service amps	1.50
	Each KW (KVA) Generator (Transformer) (Welder) KW (KVA)	2.00
	First 100 KVA - For each additional KW (KVA)	.01
	Special inspection per hour	4.00
	Speaker outlets	.15
	Signal or Alarm outlets	.15
	Amplifiers	.50
	Control panels	.25
	T.V. outlets - master system only	.15
	Radio outlets	.15
	Main control racks	1.00
	T.V. and Radio antennas - master system only	.75
	Minimum fee for any permit	4.00
	Total fee	\$ <u>42.00</u>

I hereby certify that I have carefully examined and read the above application; that the same is true and correct; and that the work herein described is to be done in accordance with all the provisions of the applicable Ordinances of the City of Las Vegas, Nevada and State laws whether herein specified or not.

SIGNED:

R. D. Waugh Date: 11/4/66
Master (Electrician) (Technician) (Owner)

BUILDING DEPARTMENT

Date: 11-7-66

660 5004.00 - 6

CITY OF LAS VEGAS
DEPT. OF
BUILDING & SAFETY

Must be machine validated

L. Gatewood 2-5-79

CITY OF LAS VEGAS, NEVADA
DEPARTMENT OF BUILDING & SAFETY

PERMIT FEE \$4.00
APPLICATION & PERMIT FOR
PLUMBING

JOB ADDRESS: 5712 Abille
OWNER'S NAME: Ernest W. Latham, Sr. & L. L. Latham, Jr.

LOT 35 BLOCK 2 SUBDIVISION 14-A Bldg. type: SFD X APT COMM
Circle: New bldg; Old bldg; Add'n; Remodel; Pool; Wtr. Sftner; Lawn Sprkr; Other

CONTRACTOR: City & County Plumbing State Lic. #8863 City Lic. #51

QUANTITY	FIXTURE OR INSTALLATION	Unit Price	AMOUNT
	Bathtub	1.00	
	Clothes dryer (gas)	1.00	
	Clothes washer	1.00	
	Dental unit	1.00	
	Dishwasher	1.00	
	Drinking fountain	1.00	
	Fire sprinkling - underground piping	5.00	
	Fire sprinkling - distribution piping per each foot	.01	
	Fire sprinkling heads - per each head	.10	
	Floor drain \$1.00 Floor sink	1.00	
	Gas appliance (any type)	1.00	
	Gas piping system - single family dwelling	3.00	
	Gas piping system - multiple family \$3 per each unit plus	1.00	
	Gas piping system - commercial bldg. per each floor	3.00	
	Grease trap	1.00	
	Irrigation system	4.00	
	Lavatory	1.00	
	Minimum fee for any permit	4.00	4.00
	Piping, Drainage	4.00	
	Sewer replacement	4.00	
	Septic disposal system - Health Dept. approval required	4.00	
	Shower	1.00	
	Sink - kitchen type	1.00	
	Swimming pool - private - wading pool	8.00	
	Swimming pool - public - semi-public	12.00	
	Toilet	1.00	
	Urinal	1.00	
	Water distribution system, single family dwelling	4.00	
	Water distribution system multiple dwg. \$4 + each unit	1.00	
	Water distribution system, Group "A" thru "G" per each floor	4.00	
	Water distribution system, Group "H" (hotel) \$4 + per bath*	.50	
	Water heater (gas) (electric)	1.00	
	Water using equipment	1.00	
	Water softener nonpermanent type	4.00	
	Water softener permanent (connected to drainage)	5.00	
	Wash tray	1.00	

TOTAL FEE \$ 4.00

I hereby certify that I have carefully examined & read the above application; that the same is true & correct; and the work herein described is to be done in accordance with the provisions of City of Las Vegas Ordinances & State Laws, whether herein specified or not. * As defined in City Code and Ordinances.

SIGNED: C. Thomas Mayline Date: 11-7-66
Registered Plumber, Spec. Cont'r, Owner

Engineering Dept. Date Building Department Date
Sewer Conn. Fee \$
Paid in Engr. Dept. PERMIT NO. 20206 PERMIT FEE \$ 4.00
23.10 #1287

RECEIPT
\$004.00 - 7
CITY OF LAS VEGAS
DEPT. OF BUILDING & SAFETY
Must be machine validated
- 8 NOV 66

G. Gatewood 2-5-79

CITY OF LAS VEGAS, NEVADA

LOG NO. & AREA

CONST. VAL. 110

DEPARTMENT OF BUILDING & SAFETY

APPLICATION FOR BUILDING PERMIT - For: Fence, Wall, Retaining Wall.

ADDRESS OF CONSTRUCTION:

5712 CARRILLO CIRCLE

OWNER:

14 Western

LOT(s)

35

BLOCK

2

SUBDIVISION

TLV

14-A

ZONE: R-1

Materials of Construction:

Block

Concrete

Wire

Wood

Other

Yes No

PLANS: ☐ ☐

ARCHITECT

ENGINEER

CALCS: ☐ ☐

CONTRACTOR:

American Fence

STATE

LICENSE #

1581

CITY

LICENSE #

7594

TOTAL SQUARE FEET:


TOTAL LINEAL FEET:

55

Remarks:

CONDITIONS OF THE PERMIT:

1. Any type of retaining wall must be engineered by a Civil or Structural Engineer.
2. If a home owner takes out the Building Permit and if the owner sublets the work to a Contractor, then the Contractor must take out the permit and pay for it.
3. No fence or wall can be built on City property or rights-of-way, but this is not intended to preclude construction within utility easements if utilities will not be damaged or made inaccessible.
4. The fence or wall shall not enclose any water meter, light standard, or fire alarm box and shall not come closer than 24" from the nearest fire hydrant outlet.
5. Department Inspectors must approve footings before concrete is poured and block wall reinforcing before grouting is done.
6. Maximum height of any wall or fence is 6', side and rear yards; 4' maximum in front yard with the vertical surface above the height of 2' - 50% open and further that fencing within 25' of the intersection of curb faces on corner and through lots is limited to a maximum height of 30".
7. I must not obstruct required onsite parking space (1 space for each dwelling unit) by the erection of this fence or wall.
8. By the signing of this application I herewith agree to the requirements outlined above.

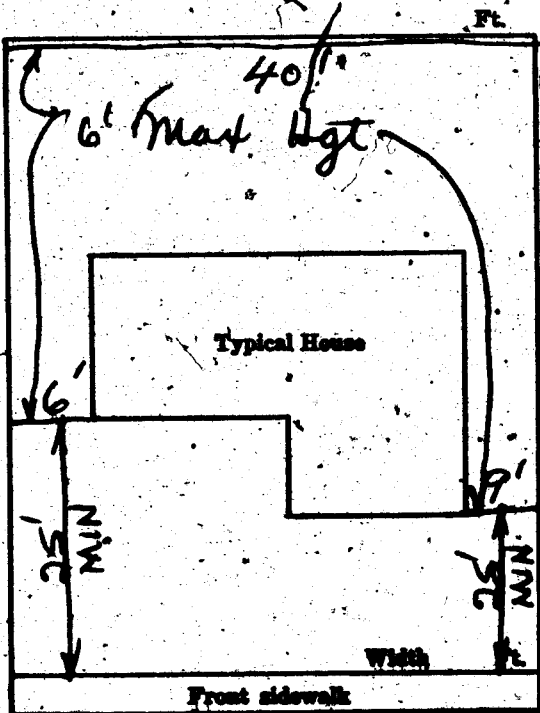

SIGNED:

A. Anderson

DATE:

9/18/68

CONTRACTOR ☐ AGENT ☒ OWNER ☐

PLANNING DEPT:

D.B.

Date:

9-19-68

ENGINEERING DEPT:

Date:

BUILDING DEPT:

L.H.

Date:

9-20-68

01295

PERMIT NO: 44386

PERMIT FEE \$

400

RECEIPT

5272 \$004.00 - 8

CITY OF LAS VEGAS

DEPT. OF BUILDING & SAFETY

MUST BE MACHINE VALIDATED

20 SEP 68

Therese Kynakes 3.2.81

Red Davis A/c 14239 11-3-66

DEPT. of BLDG & SAFETY—CITY of LAS VEGAS, NEVADA
OWNER Delta Const Corp ADDRESS 5712 Carbillo Cr DATE 3-4-64
GEN CONT. Same TYPE OF STRUCTURE SPD
PERMIT NO 26297 LEGAL DESCRIPTION Lot 35 Block 2 Twin Lakes 14A

BUILDING		MECHANICAL		ELECTRICAL	
URBAN REDEVELOPMENT APPROVAL	FINAL SEPTIC TANK				
FINAL BLDG					
DATE <u>4-15</u>					

APPROVED FOR OCCUPANCY & METER _____ INSPECTOR _____ DATE _____
PLEASE NOTE REMARKS ON REVERSE SIDE
5712 Carbillo Cr. q
LOG # _____ AREA # _____ 23.04
T3 3

DEPARTMENT OF BUILDING & SAFETY
CITY OF LAS VEGAS, NEVADA
OWNER First Western ADDRESS 5712 Carbillo DATE 7/5/66
CONTRACTOR T & M PERMIT NO. 31376

KARDEX CARD
FENCE & RETAINING
WALLS

Fence (wire, wood, etc.)		Walls (masonry, rock, etc.)	
Location	Location	Location	Location
Final Inspection	Final Inspection	Footings	Footings
		Wall Steel 1st	Wall Steel 1st
		2d	2d
		3d	3d
		Final Inspection	Final Inspection
Retaining Wall (masonry)		Retaining Wall (concrete)	
Location	Location	Location	Location
Footings	Footings	Footings	Footings
Wall Steel 1st	Wall Steel 1st	Wall Steel 1st	Wall Steel 1st
2d	2d	2d	2d
3d	3d	3d	3d
Bond Beam 1st	Bond Beam 1st	Bond Beam 1st	Bond Beam 1st
2d	2d	2d	2d
3d	3d	3d	3d
Final Inspection	Final Inspection	Final Inspection	Final Inspection

Theresa Kynakas 3-2-81

DEPT. of BLDG & SAFETY - CITY of LAS VEGAS, NEVADA

OWNER First Western Savings ADDRESS 5712 Cabrillo Circle DATE 11/7/66

GEN CONT. Clifford Blacker TYPE OF STRUCTURE Comp SED

PERMIT NO. 35122 LEGAL DESCRIPTION L 35 B 2 Twin Lakes 14A

BUILDING		MECHANICAL		ELECTRICAL	
LOCATION		PLUMBING CONT.		TEMP POLE CONT.	
FIREPLACE PTS.		PERMIT NO. <u>21206</u>	DATE <u>11/7/66</u>	PERMIT NO.	DATE
FOUNDINGS		HEAT & VENT. AC CONT.	<u>14239</u>	INSPECTION	DATE
FOUNDATION WALL		PERMIT NO.	DATE	ELECTRICAL CONT.	DATE
FLOOR FRAMING		SEWER CONT.		PERMIT NO. <u>22052</u>	DATE <u>11/7/66</u>
SLAB		PERMIT NO.	DATE	FIXTURES CONT.	DATE
CHIMNEY STEEL (FIREPLACE)		ROUGH SOIL		PERMIT NO.	DATE
WALL STEEL		ROUGH WATER		SLAB	
COLUMN STEEL		TOP-OUT		ROUGH	
BEAM STEEL		ROUGH GAS		FINAL ROUGH	
FRAMING		AC ROUGH DUCT		FINAL FIXTURE	
ROOF SHEATHING		REF. ROUGH PIPING		FINAL ELECTRICAL	
INTERIOR		FINAL PLUMBING	<u>11/7/66</u>	TEMPORARY SERVICE	
EXTERIOR		FINAL GAS			
DRYWALL		FINAL AIR COND.	<u>11/7/66</u>	MISCELLANEOUS	
LATHING		FINAL REFRIG.			
BACKING (SIDING)		FINAL SEWER		GRADING & DRAINAGE	
MASTER		FINAL SEPTIC TANK		ON-SITE PARKING SPACES	
BROWN				END APPROVAL OF	
URBAN REDEVELOPMENT APPROVAL				OFF-SITE IMPROVEMENTS	
FINAL BLDG	<u>11/7/66</u>				

INSPECTOR _____ DATE _____

APPROVED FOR OCCUPANCY & METER _____

PLEASE NOTE REMARKS ON REVERSE SIDE 5712 Cabrillo Circle LOG # _____ AREA # _____ 23.04

DEPARTMENT OF BUILDING & SAFETY
CITY OF LAS VEGAS, NEVADA

KARDEX CARD
FENCE & RETAINING
WALLS

OWNER 1st Western ADDRESS 5712 Cabrillo Circle DATE 9/20/68

CONTRACTOR American PERMIT NO. 44376

LOT 35 BLOCK 2 SUBDIVISION Twin Lakes Village 14-A
Wood

Fence (wire, wood, etc.)	Walls (masonry, rock, etc.)
Location _____	Location _____
Final Inspection <u>11/21/68</u>	Footings _____
	Wall Steel 1st _____ 2d _____ 3d _____
	Final Inspection _____
Retaining Wall (masonry)	Retaining Wall (concrete)
Location _____	Location _____
Footings _____	Footings _____
Wall Steel 1st _____ 2d _____ 3d _____	Wall Steel 1st _____ 2d _____ 3d _____
Bond Beam 1st _____ 2d _____ 3d _____	Final Inspection _____
Final Inspection _____	