

2613 AMARILLO

LOT 29 BLK 7 LAS VERDES HGTS 6 UNIT 3 ZONE R-1

2 Jones 12-20-78

CITY OF LAS VEGAS, NEVADA
DEPARTMENT OF BUILDING AND SAFETY
APPLICATION FOR FENCE, WALL OR
RETAINING WALL

LOG NO. _____

AREA: _____

KARDEX CARD: _____

TELEPHONE: _____

CONSTRUCTION

VALUATION: 316

INSPECTION

VALUATION: 410

PERMIT FEE: 500

PERMIT NUMBER: 33194

DATE: 3-31-66

ADDRESS OF
CONSTRUCTION: 2613 Amargillo

OWNER'S

NAME: C. W. Williams Jr.

OWNER'S

ADDRESS: 2613 Amargillo

Lot (s): 29

Block: 7

Subdivision: Las Vegas Heights, 6 Unit

Zone: R-1

Materials of Concrete

Construction: Block Concrete Wire Wood Other

Total Square Feet: 1230

Total Linear Feet: 295

CONTRACTOR'S NAME: Quinn

STATE

LICENSE # _____

CITY

LICENSE# _____

Architect's Name: _____

Engineer's Name: _____

PLANS SUBMITTED: Yes _____ No _____

CALCULATIONS: Yes No _____

Street Name: AMARGILLO ST.

Front Yard: 61.00 Feet

I understand that any portion of this (fence) (wall) constructed or erected on City property or right-of-way will be removed from said location at my expense upon request received from the City of Las Vegas, Nevada. I understand that the (fence) (wall) shall not enclose water meter, light standard, fire alarm box and shall not come closer than two (2') feet in any direction from any fire hydrant. I further state that I am familiar with effective Ordinances of the City of Las Vegas, Nev. and effective Statutes of the State of Nevada covering construction and use of above type; I agree to perform said construction in conformity therewith. I further agree that issuance of a permit on above application will not excuse me from conforming with said Ordinances and Statutes, despite any errors on the part of the Building Inspector or Engineer in checking plans and applications herewith submitted.

I have read and understand the contents of above application; I hereby state that same are true and correct.

SIGN HERE: C. W. Williams Jr.
By: _____


APPROVED BY: [Signature] DATE: 3/31/66
PLANNING DEPT. & CODE ASSISTANCE

FIRE DEPARTMENT DATE: _____

ENGINEERING DEPT. DATE: _____

BUILDING & SAFETY DEPT. DATE: 3-31-66

Side Yard Length: 111.97 feet

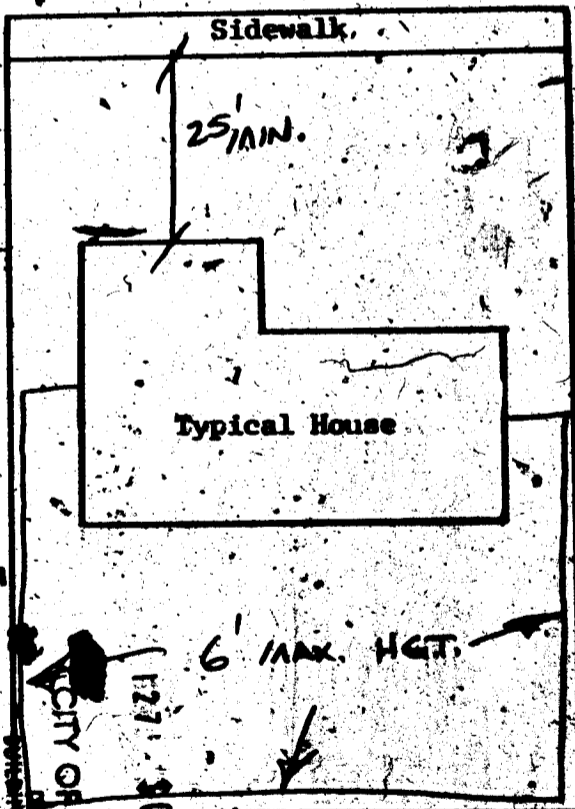

Side Yard Length: 112.57 feet

Rear Yard: 127' 00\"

Feet: 00' 00\"

29.14

Note: Owner or Contractor call for all inspections required.

These Remarks 11-3-80

DEPT. OF BLDG & SAFETY - CITY OF LAS VEGAS, NEVADA

OWNER McMackin ADDRESS 2613 Amarillo DATE 7/18/63
GENERAL CONT. D. L. Bradley TYPE OF STRUCTURE int remodel
PERMIT NO. 21037 LEGAL DESCRIPTION

BUILDING		MECHANICAL	ELECTRICAL
LOCATION		PLUMBING CONT.	TEMP. POLE CONT.
FIREPLACE ETC.		PERMIT NO. _____ DATE _____	PERMIT NO. _____ DATE _____
FOOTINGS		HEAT & VENT. AC CONT.	INSPECTION _____ DATE _____
FOUNDATION WALL		PERMIT NO. _____ DATE _____	ELECTRICAL CONT.
FLOOR FRAMING		SEWER CONT.	PERMIT NO. _____ DATE _____
SLAB		PERMIT NO. _____ DATE _____	FIXTURES CONT.
CHIMNEY STEEL (FIREPLACE)		ROUGH SOIL	PERMIT NO. _____ DATE _____
WALL STEEL		ROUGH WATER	SLAB
COLUMN STEEL		TOP CHIT	ROUGH
BEAM STEEL		ROUGH GAS	FINAL ROUGH
FRAMING		AC ROUGH DUCT	FINAL FIXTURE
ROOF SHEATHING	INTERIOR _____ EXTERIOR _____	REF ROUGH PIPING	FINAL ELECTRICAL
DRYWALL		FINAL PLUMBING	TEMPORARY SERVICE
LATHING		FINAL GAS	
BACKING (SIDING)		FINAL AIR COND.	
PLASTER (SCRATCH)		FINAL REFRM.	MISCELLANEOUS
PLASTER BROWN		FINAL SEWER	GRADING & DRAINAGE _____
URBAN REDEVELOPMENT APPROVAL		FINAL SEPTIC TANK	ON-SITE PARKING SPACES _____
FINAL BLDG #11	DATE 6-7-64		ENG. APPROVAL OF _____
			OFF-SITE IMPROVEMENTS _____

APPROVED FOR OCCUPANCY & METER _____ INSPECTOR _____ DATE _____
PLEASE NOTE REMARKS ON REVERSE SIDE LOG # _____ AREA # _____ 23.04

2613 Amarillo

DEPARTMENT OF BUILDING & SAFETY
CITY OF LAS VEGAS, NEVADA

KARDEX CARD
FENCE & RETAINING
WALLS

OWNER C. W. Williams Jr. ADDRESS 2613 Amarillo DATE 4/1/66

CONTRACTOR Owner PERMIT NO. 33194

LOT 29 BLOCK 7 SUBDIVISION Las Verdes Heights #8
Concrete block fence

Fence (wire, wood, etc.)	Walls (masonry, rock, etc.)
Location _____	Location 2613-7-66
Final Inspection _____	Footing 2613-7-66
	Wall Steel 1st 2d 3d
	Final Inspection 2613-7-66
Retaining Wall (masonry)	Retaining Wall (concrete)
Location _____	Location _____
Footing _____	Footing _____
Wall Steel 1st 2d 3d	Wall Steel 1st 2d 3d
Bond Beam 1st 2d 3d	Final Inspection _____
Final Inspection _____	

23.14 B

ADDRESS 2613 Amarillo

LOG NO. _____

AREA _____

These Remarks 11-3-80

DEPT. of BLDG. & SAFETY - CITY of LAS VEGAS, NEVADA

OWNER Durgo Corp. ADDRESS 2613 Amarillo DATE 2/26/63
GEN CONT D. L. Bradley TYPE OF STRUCTURE SFD
PERMIT NO 16613 LEGAL DESCRIPTION Lot 29 Blk 7 Las Vegas #6-2

BUILDING		MECHANICAL	ELECTRICAL
LOCATION		PLUMBING CONT.	TEMP POLE CONT.
FIREPLACE FTG		PERMIT NO.	PERMIT NO.
FOUNDINGS		HEAT & VENT. AC CONT.	INSPECTION
FOUNDATION WALL		PERMIT NO.	DATE
FLOOR FRAMING		SEWER CONT.	ELECTRICAL CONT.
SLAB		PERMIT NO.	PERMIT NO.
CHIMNEY STEEL (FIREPLACE)		ROUGH SOIL	DATE
WALL STEEL		ROUGH WATER	FEATURES CONT.
COLUMN STEEL		TOP-OUT	PERMIT NO.
BEAM STEEL		ROUGH GAS	DATE
FRAMING		AC ROUGH DUCT	SLAB
ROOF SHEATHING		REF. ROUGH PIPING	ROUGH
	INTERIOR	FINAL PLUMBING	FINAL ROUGH
DRYWALL		FINAL GAS	FINAL FIXTURE
LATHING		FINAL AIR COND.	FINAL ELECTRICAL
BACKING (SIDING)		FINAL REFRIG.	TEMPORARY SERVICE
PLASTER SCRATCH		FINAL SEWER	MISCELLANEOUS
URBAN REDEVELOPMENT APPROVAL		FINAL SEPTIC TANK	GRADING & DRAINAGE
FINAL BLDG			ON-SITE PARKING SPACES
			ENG. APPROVAL OF
			OFF-SITE IMPROVEMENTS

APPROVED FOR OCCUPANCY & METER [Signature] INSPECTOR [Signature] DATE 2-17-63
 PLEASE NOTE REMARKS ON REVERSE SIDE 3282 LOG # 7-04 AREA # 4
 2613 Amarillo T-21