

559 Airshire Ct

CITY OF LAS VEGAS, NEVADA

LOG NO. & AREA _____

DEPARTMENT OF PUBLIC SERVICES
DIVISION OF BUILDING & SAFETY

APPLICATION & BUILDING PERMIT - for:
Fence, Wall, Retaining Wall.

CONST. VAL. \$ 1320

ADDRESS OF CONSTRUCTION: 359 Airshire Ct.

OWNER: Wright, Robert

LOT(s) 112

BLOCK 2

SUBDIVISION Diamond Beach

ZONE R-1

Materials of Construction:

Block ☒

Concrete ☐

Wire ☐

Wood ☐

Other ☐

Yes

No

PLANS: ☐

CALCS: ☐

ARCHITECT: _____

ENGINEER: _____

CONTRACTOR: Owner

STATE LICENSE # 360

CITY

LICENSE # 60


TOTAL SQUARE FEET: 128

TOTAL LINEAL FEET: 32

Remarks:

CONDITIONS OF THE PERMIT:

- Any type of retaining wall must be engineered by a Civil or Structural Engineer.
- If a home owner takes out the Building Permit and if the owner sublets the work to a Contractor, then the Contractor must take out the permit and pay for it.
- No fence or wall can be built on City property or rights-of-way, but this is not intended to preclude construction within utility easements, if utilities will not be damaged or made inaccessible.
- The fence or wall shall not enclose any water meter, light standard, or fire alarm box and shall not come closer than 24" from the nearest fire hydrant outlet.
- Department Inspectors must approve footings before concrete is poured and block wall reinforcing before grouting is done.
- Maximum height of any wall or fence is 6' side and rear yards; 4' maximum in front yard with the vertical surface above the height of 2' - 50% open.
- I must not obstruct required onsite parking space (2 spaces for each dwelling unit) by the erection of this fence or wall.
- By the signing of this application I herewith agree to the requirements outlined above.

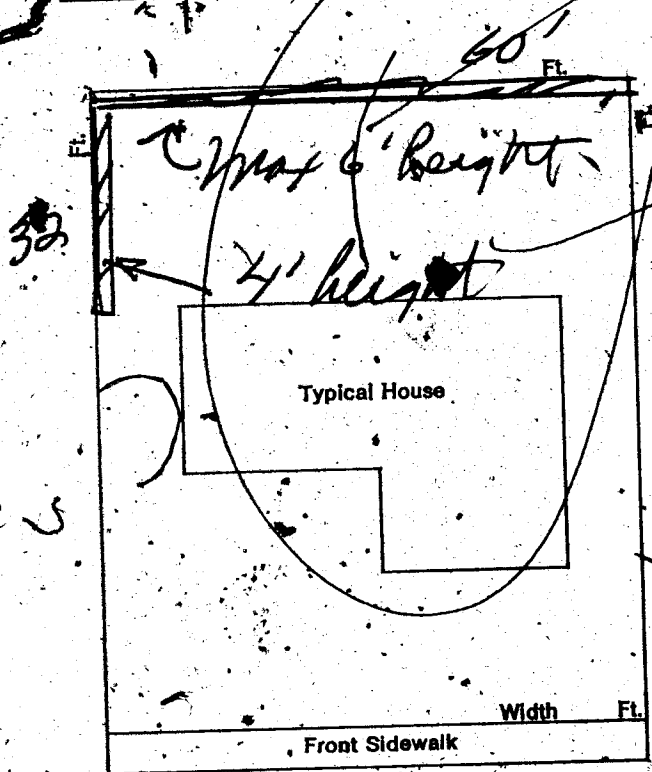

1 TON \$ 00
WALL \$ 32.50
STL \$ 32.50
TOTL \$ 32.50
CASH \$ 40.00
CHG \$ 10.00
DATE: 4/14/81

SIGNED: _____

CONTRACTOR ☐

AGENT ☐

OWNER ☒
CITY OF LAS VEGAS
DIV. OF BUILDING & SAFETY

PLANNING DEPT: _____

Date: 4/14/81

PUBLIC WORKS DEPT: _____

Date: 4-14-81

BUILDING DIVISION: _____

Date: 4/14/81

PERMIT NO: 0309

PERMIT FEE \$ 32.50

04/14/81 RECEIPT

MUST BE MACHINE VALIDATED

FENCE & RETAINING WALLS			
OWNER		DATE	
Wright, Robert		4/14/81	
ADDRESS			
559 Airshire Ct.			
CONTRACTOR		PERMIT NO.	FINAL INSPECTION
owner		0369	
LOT	BLOCK	SUBDIVISION	
12	2	Diamondhead	
SQ. FT.		AREA	
FENCES (wire, wood, block, & retaining walls)			
1	Location		
2	Footing		
3	Wall Steel		
	1st	2nd	
	Bond Beam		
	1st	2nd	
	Final		
Specify Type Of Fence			
TS 561681			
