

208 Bahama Rd.

LOT 20 BLK 5 CHARLESTON RAINBOW #14-B ZONE R-1

S. Baybert 1-19-79

CITY OF LAS VEGAS, NEVADA

LOG NO. & AREA 1304 CONST. VAL. 38280
DEPARTMENT OF BUILDING & SAFETY APPLICATION & BUILDING PERMIT for:

8-05 ADDRESS OF CONSTRUCTION: 208 Bahama Road OWNER: SPROUL HOMES OF NEVADA
Dwellings, Duplexes, Misc. Residential Const.

LOT(S) 20 BLOCK 5 SUBDIVISION Charleston Rainbow Unit No. 14-B ZONE: R-1

Existing structure on lot: Dwelling Accessory bldg. Vacant lot Other

PROPOSED CONSTRUCTION: Single Family Dwelling USE: Same

MATERIALS OF CONSTRUCTION: Wood Frame Concrete Block Reinforced Concrete Steel Frame

SQ. FEET OF FLOOR AREAS: 1st 1632 2nd 484 3rd 484 Other 484 TOTAL SQ. FT. 2116


FIRE ZONE: 1-3 Occupancy Group 1-2 CONST. TYPE I II III IV V

ARCHITECT: _____ ENGINEER: _____ NO. OF UNITS 1 NO. OF STORIES 1

Plans Submitted: Yes No Calculations Submitted: Yes No Sewer Fee Req'd.: Yes No

CONTRACTOR: SPROUL HOMES OF NEVADA STATE LICENSE # 60118 CITY LICENSE # 6427

ADD'L. PERMITS REQ'D.: Air Cond. Elec. Plumbing Signs Parking Fence Public Walks Curb-gutters
Incinerators Fire Sprinkling System

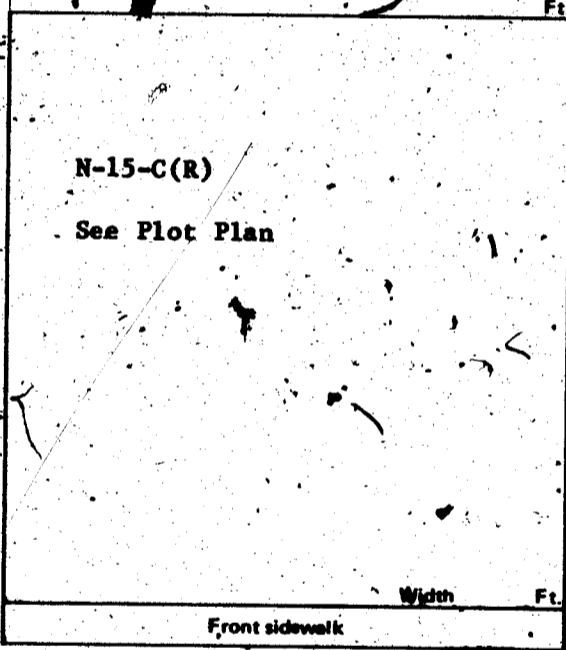

CONDITIONS OF THE PERMIT:

1. I agree to call the City Building Department for inspections before concrete is poured, before rough wiring, electrical, plumbing, framing is covered. Also for air conditioning, sheet-rock and sheathing inspection.
2. I agree that when the job is completed that I will call for final inspection before occupancy.
3. I agree to perform all construction in accordance with City Ordinances and Building Codes.
4. The Contractor's signature below denotes authority from the owner to sign in his behalf, and that the owner is aware of all requirements of this application and permit. Separate permits must be taken out for work outlined above this agreement.
5. I have read and understand the contents of this application and permit; I hereby state that the information I have supplied on this application is true and correct.

Approval for the work under this permit will be given only after refuse and debris have been removed from job site and public right of way.

SIGNED: SPROUL HOMES OF NEVADA Contractor

BY: John E. ... Agent or Owner

CLARK COUNTY HEALTH DEPT. Date: _____

LAS VEGAS FIRE DEPARTMENT Date: _____

PLANNING DEPT.: [Signature] Date: 11-10-76

PUBLIC WORKS DEPT.: ARV Date: 11-19-76

BUILDING DEPT.: WRJ Date: 11/10/76

12850 PERMIT NO.: 5577 PERMIT FEE \$ 73 140.00

RECEIPT
709 \$140.00 - 8

CITY OF LAS VEGAS
DEPT. OF BUILDING & SAFETY

MUST BE MACHINE VALIDATED
11-10-76

S. Seybert 1-19-79

CITY OF LAS VEGAS, NEVADA
DEPARTMENT OF BUILDING & SAFETY

RECEIPT
FOR
SEWER CONNECTION FEE

JOB ADDRESS: 208 Babara Road OWNER'S NAME: SPROUL HOMES OF NEVADA
LOT 20 BLOCK 5 SUBDIVISION Charleston Rainbow 14-B

QUANTITY	OCCUPANCY	UNIT FEE	AMOUNT
1	Sewer Connection Fee for SFD		\$150.00

PAID BY: Sproul Homes of Nev

TOTAL 150.00
Less Credit
TOTAL FEE \$ 150.00

*Credit for existing sewer is applied to the new sewer connection fee based on previous type of occupancy and only when the new occupancy requires an additional fee.

This receipt does not authorize the owner or his representative to start any work without obtaining a plumbing permit.

DEPARTMENT OF BUILDING & SAFETY DATE 1/19/79

RECEIPT NO. 3652 SEWER FEE \$ 150.00

73107

RECEIPT
686 \$150.00 - 3
CITY OF LAS VEGAS
DEPARTMENT OF BUILDING & SAFETY
MUST BE MACHINE VALIDATED
1/19/79

S. Seybert 1-19-79

CITY OF LAS VEGAS, NEVADA

20-5

DEPARTMENT OF BUILDING & SAFETY - APPLICATION AND PERMIT FOR PLUMBING

ADDRESS OF CONSTRUCTION: 208 BAHAMA RD. OWNER'S NAME: SPRAWL HOMES, INC.

CIRCLED: New Bldg. Add'n.; Remodel; TYPE OF BLDG. SFD APT. PUBLIC COMM.

CONTRACTOR'S NAME: UNITED PLMBG. STATE LICENSE # 1295 CITY LICENSE # 904

UNITS	DESCRIPTION	FEE	TOTAL
1	Bathtub	1.00	1-
1	Shower	1.00	1-
2	Lavatory	1.00	2-
2	Toilet	1.00	2-
	Urinal	1.00	
	Floor Drain	1.00	
	Floor Sink	1.00	
	Wash Tray	1.00	
X	Sink	1.00	1-
	Garbage Disposal	1.00	
	Garbage Disposal (comm.)	3.00	
	Clothes Dryer (gas)	1.00	
1	Clothes Washer	1.00	1-
	Clothes Washer (comm.)	5.00	
	Dishwasher	1.00	
	Dishwasher (commercial)	5.00	
	Dental Unit	10.00	
	Drinking Fountain	1.00	
	Any Water using Equipment	1.00	
1	Water Heater (gas) (elect.)	1.00	1-
1	Sewer System - New, Replacement, or any Drainage System	4.00	4-
	Grease or Sand Trap	2.00	
	Trailer Trap	2.00	
	Septic Disposal System	4.00	
WATER SOFTENERS			
	Nonpermanent Type	4.00	
	Permanent Type (connected to Drainage)	5.00	
SWIMMING POOLS			
	Private or Wading Pool	10.00	
	Public or Semi-public	20.00	

UNITS	DESCRIPTION	FEE	TOTAL
WATER DISTRIBUTION SYSTEM			
1	Single Family Dwelling	4.00	4-
	Multiple Family Dwelling plus each unit	4.00	
		2.00	
	Bldg. Group "A" thru "G" per each floor	6.00	
	Hotel or Motel plus each bath	4.00	
		1.50	
	Trailer Park plus each space	20.00	
		1.00	
	Irrigation	4.00	
GAS PIPING SYSTEM			
1	Single Family Dwelling	3.00	3-
	Multiple Family Dwelling plus each unit	6.00	
		1.00	
	Commercial Bldg. per floor plus each unit	3.00	
		3.00	
	Gas Appliance (any type)	1.00	
AUTOMATIC FIRE EXTINGUISHING SYSTEM			
	Underground Piping	10.00	
	Distribution Piping ea. ft.	.01	
	Sprinkler Head each	.10	
	In Range Hood and Vent	5.00	
DRY STANDPIPE SYSTEM			
	Piping	50.00	
	Each Outlet	1.00	
WET STANDPIPE SYSTEM			
	Piping	5.00	
	Fire Hose Cabinet	1.00	
MINIMUM PERMIT FEE 4.00			
PIPELINE CONTRACTOR, SECT. 14-B.P.F. \$			
TOTAL PERMIT FEE \$ 20-			

I hereby certify that I have carefully examined and read the above application; that the same is true and correct; and that the work herein described is to be done in accordance with all the provisions of the applicable Ordinances of the City of Las Vegas, Nevada and the State Laws, whether herein specified or not.

Approval for the work under this permit will be given only after refuse and debris have been removed from job site and public right of way.

Signed: J. P. [Signature] Date: 11-15-76
 Registered Master Plumber, Spec. Cont'r. or Owner
 Building Department: N.M. Date: 11-18-76
 Permit No. 3762 Permit Fee \$ 20.00

#12870

RECEIPT

967 \$020.00 - 7

CITY OF LAS VEGAS
 DEPT. OF BUILDING & SAFETY

MUST BE MACHINE VALIDATED
 1 2 3 4 5 6

S. Seybert 1-19-79

CITY OF LAS VEGAS, NEVADA

DEPARTMENT OF BUILDING & SAFETY - ELECTRICAL APPLICATION & PERMIT

ADDRESS OF CONSTRUCTION: 208 Bahama Road OWNER'S NAME: Sorouh 14b

CIRCLE: New Bldg.; Add'n.; Remodel? TYPE OF BLDG.: SFD. APT. PUBLIC COMM.

CONTRACTOR'S NAME: Roberto Electric STATE LICENSE #: 4528 CITY LICENSE #: 3392

NUMBER	FIXTURE OR INSTALLATION	UNIT PRICE	TOTAL
	Rm addition, carport or garage enclosure	4.00	
	Temporary power	4.00	
67	Light, receptacle or switch outlet	.20	13.40
	Wall or ceiling space heater	.35	
1	Garbage grinder outlet	.35	.35
	Dishwasher outlet	.35	
	Clothes dryer outlet	.35	
	Automatic clothes washer	.35	
1	Electric range outlet	.35	4.35
	Electric water heater outlet	.35	
	Special purpose outlet	.35	
	X-ray unit and its appurtenances	5.00	
	Watts of festoon lighting (Watts) First 3,000 watts for each additional thousand watts	4.00 1.50	
	Horsepower each motor first horsepower or less for each additional horsepower	1.75 .35	
1	Electric service (including any single meter socket) for each additional socket	3.00 .35	3.00
1	Air conditioning service	1.50	1.50
	Each KW(KVA) Generator (Transformer, Welder) First 100 KVA for each additional KW(KVA)	2.00 .01	
	Speaker, signal or alarm outlet	.15	
	Amplifiers	.50	
	Control panels	.25	
	Main control racks	1.00	
	T.V. and radio antennas-master system only	.75	
	Minimum fee for any permit	4.00	
	TOTAL FEE		18.60

Approval for the work under this permit will be given only after refuse and debris have been removed from job site and public right of way.

I hereby certify that I have carefully examined and read the above application; that the same is true and correct; and that the work herein described is to be done in accordance with all the provisions of the applicable Ordinances of the City of Las Vegas, Nevada and State laws whether herein specified or not.

SIGNED: GD Waugh DATE: _____
 MASTER (ELECTRICIAN) (TECHNICIAN) (OWNER)
 BUILDING DEPARTMENT: NM DATE: 11-19-76
 #12860 PERMIT NO.: 2785 PERMIT FEE: \$ 18.60

RECEIPT
 1976 \$018.60 - 6
 CITY OF LAS VEGAS
 DEPARTMENT OF BUILDING & SAFETY
 MUST BE MACHINE VALIDATED

S. Seibert 1-19-79

CITY OF LAS VEGAS, NEVADA
DEPARTMENT OF BUILDING & SAFETY - AIR CONDITIONING APPLICATION & PERMIT

ADDRESS OF CONSTRUCTION: 208 Bahama Road OWNER'S NAME: Sproul Homes

CIRCLE: Addition; Remodel; New Bldg TYPE OF BLDG.: SED APT. COMM. PUBLIC

CONTRACTOR'S NAME: Gearing A/C STATE LICENSE # 6058 CITY LICENSE # 7618

UNITS	DESCRIPTION	FEE	TOTAL	UNITS	DESCRIPTION	FEE	TOTAL
	Unit heater - floor, wall or suspended	4.00			EVAPORATIVE COOLERS:		
	FOR EACH FORCED-AIR OR GRAVITY-TYPE FURNACE OR BURNER INCLUDING DUCTS AND VENT ATTACHED TO SUCH APPLIANCES:				5 outlets or under	3.00	
	Up to and including 100,000 B.t.u.'s	4.00			Over 5 and up to and including 10'	5.00	
	Over 100,000 B.t.u.'s	6.00			Each additional outlet over 10'	.25	
	FOR EACH HEATING APPLICATION, REFRIGERATION UNIT, COMFORT COOLING AND HEATING UNIT, ABSORPTION UNIT, COMPRESSOR OR BOILER:				VENTILATION:		
	Up to and including 3 ton or horsepower, or absorption system up to and including 100,000 B.t.u.'s	4.00			For each fan connected to a single duct	1.00	
1	Over 3 ton or 3 horsepower up to and including 10, or absorption system over 100,000 B.t.u.'s up to and including 250,000 B.t.u.'s	3 1/2 7.00	7.00		For each commercial or industrial ventilation system	5.00	
	Over 10 ton or 10 horsepower up to and including 30, or absorption system over 250,000 B.t.u.'s up to and including 1,000,000 B.t.u.'s	12.00			For each commercial kitchen hood	5.00	
	Over 30 ton or 30 horsepower up to and including 50, or absorption system over 1,000,000 B.t.u.'s up to and including 1,700,000 B.t.u.'s	20.00			MISCELLANEOUS:		
	Over 50 ton or 50 horsepower, or absorption system over 1,700,000 B.t.u.'s	30.00			For each water cooling tower	8.00	
	FOR EACH AIR HANDLING UNIT INCLUDING DUCTS ATTACHED THERETO:			3	Duct work only - each opening	.25	.75
	Up to and including 10,000 CFM	2.00			For installation or relocation of each commercial or industrial incinerator	15.00	
	Over 10,000 CFM	4.00			Gas piping related to the air cond. work in single family dwelling only	3.00	
					For each appliance, piece of equipment, any mechanical work or alteration or replacement not included in this schedule, the permit fee shall be computed the same as building permit fees by using the cost of installation for the valuation amount.		
					FOR THE ISSUANCE OF EACH PERMIT		3.00
					TOTAL PERMIT FEES \$	10.75	

I hereby certify that I have carefully examined and read the above application; that the same is true and correct; and that the work herein described is to be done in accordance with all the provisions of the applicable Ordinances of the City of Las Vegas, Nevada and the State Laws, whether herein specified or not.

Approval for the work under this permit will be given only after refuse and debris have been removed from job site and public right of way.

SIGNED E.E. Gearing (gn) Date 12-10-76
 Air Conditioning Contractor - Owner

BUILDING DEPARTMENT NM Date 12-10-76

PERMIT NO. 1341 PERMIT FEE \$ 10.75

134-01-224

RECEIPT

2014 \$010.75 -

CITY OF LAS VEGAS

MUST BE MACHINE VALIDATED

S. Seibert 1-19-79

5-16

CITY OF LAS VEGAS, NEVADA

CONST. VAL. \$ 1650.00

LOG NO. & AREA DEPARTMENT OF BUILDING & SAFETY

APPLICATION & BUILDING PERMIT - for: Fence, Wall, Retaining Wall.

ADDRESS OF CONSTRUCTION: 208 BANANA

OWNER: DAVID SCHURSTEIN

LOT(s) 20 BLOCK 5 SUBDIVISION

Perimeter 14-13 ZONE R-1

Materials of Construction: Block Concrete Wire Wood Other

PLANS: Yes No

ARCHITECT: ENGINEER: CALCS: Yes No

CONTRACTOR: PREFAB CONCRETE PRODUCTS

STATE LICENSE # 13859

CITY LICENSE # C-11-14635


TOTAL SQUARE FEET: 1180

TOTAL LINEAL FEET: 180

Remarks:

CONDITIONS OF THE PERMIT:

1. Any type of retaining wall must be engineered by a Civil or Structural Engineer.
2. If a home owner takes out the Building Permit and if the owner sublets the work to a Contractor, then the Contractor must take out the permit and pay for it.
3. No fence or wall can be built on City property or rights-of-way, but this is not intended to preclude construction within utility easements if utilities will not be damaged or made inaccessible.
4. The fence or wall shall not enclose any water meter, light standard, or fire alarm box and shall not come closer than 24" from the nearest fire hydrant outlet.
5. Department inspectors must approve footings before concrete is poured and block wall reinforcing before grouting is done.
6. Maximum height of any wall or fence is 6', side and rear yards; 4' maximum in front yard with the vertical surface above the height of 2' - 50% open.
7. I must not obstruct required onsite parking space (2 spaces for each dwelling unit) by the erection of this fence or wall.
8. By the signing of this application I herewith agree to the requirements outlined above.

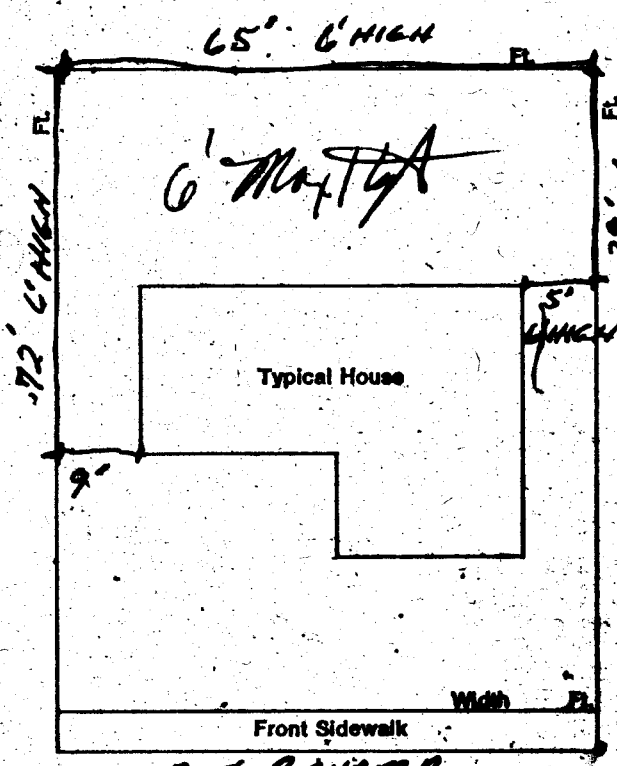

SIGNED: PREFAB CONCRETE PRODUCTS DATE: 3-7-77
CONTRACTOR AGENT OWNER

PLANNING DEPT: Date: 3-7-77
PUBLIC WORKS DEPT: Date:
BUILDING DEPT: Date: 3/7/77
#12850 PERMIT NO: 1160 PERMIT FEE \$ 15

RECEIPT
6282 \$015.00 - 8
CITY OF LAS VEGAS
MUST BE MACHINE VALIDATED

Theresa Kyriakos 12-2-80

DIVISION of BUILDING & SAFETY - CITY of LAS VEGAS, NEVADA
OWNER Sproul Homes ADDRESS 208 Bahama Road DATE 11-10-76
GEN. CONT. Sproul
PERMIT NO. 5577 LEGAL DESCRIPTION L 20 B 5 Charleston Rainbow nit 14 B TYPE OF STRUCTURE Sfd w fp

BUILDING	MECHANICAL	ELECTRICAL
Investigation	Plumbing Cont. <u>United</u>	Temp. pole cont.
Location & Footing <u>SC 11-22-76</u>	Permit No. <u>3762</u> Date <u>11-18-77</u>	Permit No. _____ Date _____
Stem Wall <u>SC 11-1-76</u>	Heat & Vent. A/C Cont. <u>Geering</u>	Inspection _____ Date _____
Concrete Slab Floor <u>SC 12-8-76</u>	Permit No. <u>1341</u> Date <u>12-9-77</u>	Electrical Cont. <u>Palumbo</u>
Floor Framing	Sewer Cont. <u>Sproul Homes</u>	Permit No. <u>2785</u> Date <u>11-19-76</u>
Fireplace Footing <u>SC 12-8-76</u>	Permit No. <u>3652</u> Date _____	Fixtures Cont. _____
Chimney Steel	Rough Soil <u>KW 12-6-76</u>	Permit No. _____ Date _____
Vert. Steel Reinf.	Rough Water <u>KW 12-6-76</u>	Slab _____
Horiz. Steel Reinf.	Top Out <u>KW 1-9-77</u>	Rough <u>VP 1-5-77</u>
Roof Sheathing <u>SC 1-4-77</u>	Rough Gas <u>KW 1-4-77</u>	Final Rough _____
Framing <u>SC 1-9-77</u>	A/C Rough Duct <u>KW 1-4-77</u>	Final Fixture _____
Backing for siding	Ref. Rough Piping	Final Electrical <u>VP 3-77</u>
Ext. Lath	Final Plumbing <u>KW 2-2-77</u>	Temporary Service _____
Ext. Scratch	Final Gas <u>KW 2-9-77</u>	MISCELLANEOUS
Ext. Brown	Final Air Cond. <u>KW 2-2-77</u>	Grading & Drainage _____
Int. Lath	Final Refrig. _____	On Site Parking Spaces _____ App. _____
Int. Brown	Final Sewer _____	Eng. Approval of _____
Drywall <u>SC 1-19-77</u>	Final Septic Tank _____	Off Site Improvements _____
Insulation		
Final Building		
Appr. for Occu.		

INSPECTOR: _____

DATE _____

APPROVED FOR OCCUPANCY & METER

SC 2-3-77

PLEASE NOTE REMARKS ON REVERSE SIDE

208 Bahama Road

LOG # _____

AREA # _____

T 30-114

DEPARTMENT OF BUILDING & SAFETY
CITY OF LAS VEGAS, NEVADA

KARDEX CARD
FENCE & RETAINING
WALLS

OWNER David Schnurstein ADDRESS 208 Bahama DATE 3-7-77

CONTRACTOR Pre Fab Concrete PERMIT NO. 1160

LOT _____ BLOCK _____ SUBDIVISION Pre Fab Concrete

Fence (wire, wood, etc.)	Walls (masonry, rock, etc.)
Location _____	Location <u>SC 3-17-77</u>
Final Inspection _____	Footing <u>SC 3-17-77</u>
	Wall Steel 1st _____ 2d _____ 3d _____
	Final Inspection _____
Retaining Wall (masonry)	Retaining Wall (concrete)
Location _____	Location _____
Footing _____	Footing _____
Wall Steel 1st _____ 2d _____ 3d _____	Wall Steel 1st _____ 2d _____ 3d _____
Bond Beam 1st _____ 2d _____ 3d _____	Final Inspection _____
Final Inspection _____	

23.14 B

ADDRESS 208 Bahama

LOG NO. _____

AREA _____