

1820 BLACKHAWK RD.

LOT 18 BLK 14 KINGSWOOD #4 ZONE R-1

S. Seybert 1-24-78

CITY OF LAS VEGAS, NEVADA

LOG NO. & AREA

T-32-3

CONST. VAL. \$262.08

DEPARTMENT OF PUBLIC SERVICES
DIVISION OF BUILDING AND SAFETY

APPLICATION & BUILDING PERMIT for:
Dwelling, Duplexes, Misc. Residential Const.

ADDRESS OF CONSTRUCTION 1820 Blackhawk Road

OWNER Chism Homes, Inc.

LOT 18 BLOCK 14 SUBDIVISION Kingswood Estates #4 ZONE R-1

Existing structure on lot: Dwelling ☐ Accessory Bldgs ☐ Vacant Lot ☒ Other ☐

PROPOSED CONSTRUCTION S.F. Dwelling w/F.P. USE Resident

MATERIALS OF CONSTRUCTION: Wood frame ☒ Concrete Block ☐ Reinforced Concrete ☐ Steel Frame ☐

SQUARE FEET OF FLOOR AREAS: 1st 1014 2nd Entry 123 Other 464 TOTAL SQ. FT. 1600


FIRE ZONE: 3 Occupancy, Group R-3 & M1 CONST. TYPE: V-N

ARCHITECT: ENGINEER: NO. of UNITS 1 NO. of STORIES 1

Plans Submitted: Yes ☒ No ☐ Calculations Submitted: Yes ☐ No ☒ Sewer Fee Req'd: Yes ☒ No ☐

CONTRACTOR Chism Homes, Inc. STATE LICENSE # 7834 C-11-466-2-04918

ADD'L PERMITS REQ'D: Air Cond ☒ Elec ☒ Plumbing ☒ Signs ☐ Paving ☐ Fence ☐ Public Walks ☐ Curb gutters ☐
Incinerators ☐ Fire Sprinkling System ☐

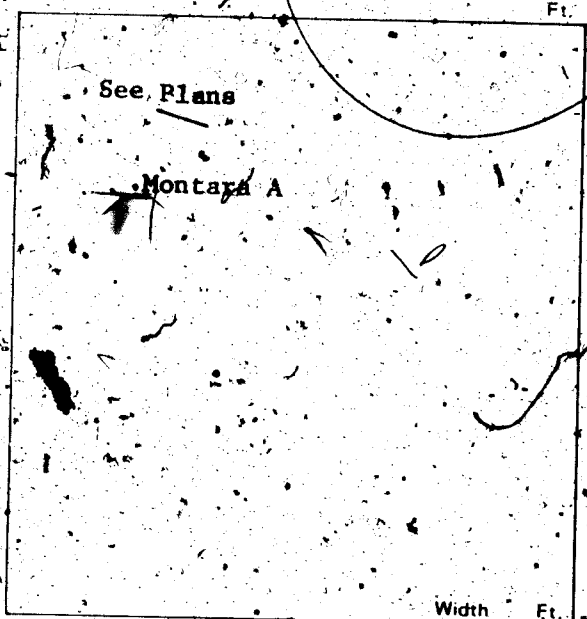

CONDITIONS OF THE PERMIT

- I agree to call the City Building Department for inspections before concrete is poured, before rough wiring, electrical, plumbing, framing is covered. Also for Air conditioning, drywall and sheathing inspection.
- I agree that when the job is completed that I will call for final inspection before occupancy.
- I agree to perform all construction in accordance with City Ordinances and Building Codes.
- The Contractor's signature below denotes authority from the owner to sign in his behalf and that the owner is aware of all requirements of this application and permit. Separate permits must be taken for all work outlined above this agreement.
- I have read and understand the contents of this application and permit, I hereby state that the information I have supplied on this application is true and correct.

Approval for the work under this permit will be given only after refuse and debris have been removed from job site and public right of way.

SIGNED Chism Homes, Inc. Contractor
BY Ronald K. Chism Agent or Owner

PLANNING DEPT. Date 5-27-78

PUBLIC WORKS DEPT. Charles Lusk Date 5/18/78

BUILDING DIVISION: Date 5-16-78

PERMIT NO. 6436-1534 PERMIT FEE \$ 117.-

154-01-220

RECEIPT

MUST BE MACHINE VALIDATED

CITY OF LAS VEGAS, NEVADA

LOG NO. & AREA

T-32-3

CONST. VAL. \$ 262-08

DEPARTMENT OF PUBLIC SERVICES
DIVISION OF BUILDING AND SAFETY

APPLICATION & BUILDING PERMIT for:
Dwelling, Duplexes, Misc. Residential Const.

ADDRESS OF
CONSTRUCTION

1820 Blackhawk Road

OWNER: Chism Homes, Inc.

LOT#

18

BLOCK

14

SUBDIVISION

Kingswood Estates #4

ZONE: R-1

Existing structure on lot:

Dwelling ☐

Accessory Bldgs ☐

Vacant Lot ☒

Other ☐

PROPOSED CONSTRUCTION

S.F. Dwelling w/F.P.

USE: Resident

MATERIALS OF CONSTRUCTION

Wood frame ☒

Concrete Block ☐

Reinforced Concrete ☐

Steel Frame ☐

SQUARE FEET OF FLOOR AREAS: 1st

1014

2nd

3rd Entry 122

Other 464

TOTAL SQ. FT. 1600

FIRE ZONE:

3

Occupancy, Group

R-3 & M1

CONST. TYPE

V-N

ARCHITECT

ENGINEER

NO. of UNITS 1

NO. of STORIES 1

Plans Submitted:

Yes ☒ No ☐

Calculations Submitted

Yes ☐ No ☒

Sewer Fee Req'd

Yes ☒ No ☐

CONTRACTOR

Chism Homes, Inc.

STATE

LICENSE #

7834

CITY

LICENSE # C-11-466-2-04918

ADD'L PERMITS REQ'D

Air Cond ☒

Elec ☒

Plumbing ☒

Signs ☐

Paving ☐

Fence ☐

Public Walks ☐

Curb gutters ☐

Incinerators ☐

Fire Sprinkling System ☐

CONDITIONS OF THE PERMIT

- I agree to call the City Building Department for inspections before concrete is poured, before rough wiring, electrical, plumbing, framing is covered. Also for Air conditioning, drywall and sheathing inspection.
- I agree that when the job is completed that I will call for final inspection before occupancy.
- I agree to perform all construction in accordance with City Ordinances and Building Codes.
- The Contractor's signature below denotes authority from the owner to sign in his behalf and that the owner is aware of all requirements of this application and permit. Separate permits must be taken for all work outlined above this agreement.
- I have read and understand the contents of this application and permit, I hereby state that the information I have supplied on this application is true and correct.

Approval for the work under this permit will be given only after refuse and debris have been removed from job site and public right of way.

SIGNED

Chism Homes, Inc.

Contractor

BY

Ronald K. Chism

Agent or Owner

See Plans

Montana A

Width Ft.

Front property line

PLANNING DEPT.

Date

5-27-78

PUBLIC WORKS DEPT.

Date

5/18/78

BUILDING DIVISION

Date

5-16-78

PERMIT NO.

6436-15 3/4

PERMIT FEE \$

117.-

154-01-220

RECEIPT

MUST BE MACHINE VALIDATED

CITY OF LAS VEGAS, NEVADA

DEPARTMENT OF BUILDING & SAFETY - APPLICATION AND PERMIT FOR PLUMBING

ADDRESS OF CONSTRUCTION: **1820 Blackhawk Road**

OWNER'S NAME: **Chism Homes, Inc.**

CIRCLE: New Bldg. Add'n. Remodel. TYPE OF BLDG.: SFD. APT. PUBLIC COMM.

11 902-2-

CONTRACTOR'S NAME: **Suhrise Plumbing, Inc.** STATE LICENSE # **12672A** CITY LICENSE # **13790**

UNITS	DESCRIPTION	FEE	TOTAL
1	Bathtub	1.00	1.00
1	Shower	1.00	1.00
2	Lavatory	1.00	2.00
2	Toilet	1.00	2.00
	Urinal	1.00	
	Floor Drain	1.00	
	Floor Sink	1.00	
	Wash Tray	1.00	
1	Sink	1.00	1.00
1	Garbage Disposal	1.00	1.00
	Garbage Disposal (comm.)	3.00	
1	Clothes Dryer (gas)	1.00	1.00
1	Clothes Washer	1.00	1.00
1	Clothes Washer (comm.)	5.00	
1	Dishwasher	1.00	1.00
	Dishwasher (commercial)	5.00	
	Dental Unit	10.00	
	Drinking Fountain	1.00	
	Any Water using Equipment	1.00	
1	Water Heater (gas) (elect.)	1.00	1.00
1	Sewer System - New, Replacement, or any Drainage System	4.00	4.00
	Grease or Sand Trap	2.00	
	Trailer Trap	2.00	
	Septic Disposal System	4.00	
WATER SOFTENERS			
	Nonpermanent Type	4.00	
	Permanent Type (connected to Drainage)	5.00	
SWIMMING POOLS			
	Private or Wading Pool	10.00	
	Public or Semi-public	20.00	

UNITS	DESCRIPTION	FEE	TOTAL
WATER DISTRIBUTION SYSTEM			
1	Single Family Dwelling	4.00	4.00
	Multiple Family Dwelling plus each unit	2.00	
	Bldg. Group "A" thru "G" per each floor	6.00	
	Hotel or Motel plus each bath	1.50	
	Trailer Park plus each space	20.00	
	Irrigation	4.00	
GAS PIPING SYSTEM			
1	Single Family Dwelling	3.00	3.00
	Multiple Family Dwelling plus each unit	1.00	
	Commercial Bldg. per floor plus each unit	3.00	
4	Gas Appliance (any type)	1.00	4.00
AUTOMATIC FIRE EXTINGUISHING SYSTEM			
	Underground Piping	10.00	
	Distribution Piping ea. ft.	.01	
	Sprinkler Head each	.10	
	In Range Hood and Vent	5.00	
DRY STANDPIPE SYSTEM			
	Piping	50.00	
	Each Outlet	1.00	
WET STANDPIPE SYSTEM			
	Piping	5.00	
	Fire Hose Cabinet	1.00	
MINIMUM PERMIT FEE			
		4.00	
PIPELINE CONTRACTOR, SECT. 14 B.P.F. \$			
TOTAL PERMIT FEE \$			27.00

I hereby certify that I have carefully examined and read the above application; that the same is true and correct; and that the work herein described is to be done in accordance with all the provisions of the applicable Ordinances of the City of Las Vegas, Nevada and the State Laws, whether herein specified or not.

Approval for the work under this permit will be given only after refuse and debris have been removed from job site and public right of way.

Signed Richard P. Edwards Date: 6-26-78
Registered Master Plumber, Spec. Contractor, or Owner

Building Department

Date: 6-26-78

Permit No. 7411-8

Permit Fee \$ 27.00

#12870

RECEIPT

MUST BE MACHINE VALIDATED

8. Seybert 1-27-79

CITY OF LAS VEGAS, NEVADA

DEPARTMENT OF PUBLIC SERVICES - AIR CONDITIONING APPLICATION & PERMIT DIVISION OF BUILDING AND SAFETY

ADDRESS OF CONSTRUCTION: 1820 BLACKHAWK ROAD

OWNER'S NAME: CHISM HOMES

CIRCLE: Addition; Remodel; New Bldg. TYPE OF BLDG. SFD APT. COMM. PUBLIC

CONTRACTOR'S NAME: CARL'S AIR CONDITIONING STATE AND SHEET METAL INC. CITY LICENSE # 8370-B LICENSE # 230-2-10793

UNITS	DESCRIPTION	FEE	TOTAL	UNITS	DESCRIPTION	FEE	TOTAL
	Unit heater - floor, wall, or suspended	4.00			EVAPORATIVE COOLERS		
	FOR EACH FORCED AIR, OR GRAVITY-TYPE FURNACE OR BURNER INCLUDING DUCTS AND VENT ATTACHED TO SUCH APPLIANCES:				5 outlets or under	3.00	
	Up to and including 100,000 B.t.u.'s	4.00			Over 5 and up to and including 10	5.00	
	Over 100,000 B.t.u.'s	6.00			Each additional outlet over 10	.25	
	FOR EACH HEATING APPLICATION, REFRIGERATION UNIT, COMFORT COOLING AND HEATING UNIT, ABSORPTION UNIT, COMPRESSOR OR BOILER:				VENTILATION		
	Up to and including 3 ton or horsepower, or absorption system up to and including 100,000 B.t.u.'s	4.00		1	For each fan connected to a single duct	1.00	1.00
	Over 3 ton or 3 horsepower up to and including 10, or absorption system over 100,000 B.t.u.'s up to and including 250,000 B.t.u.'s	7.00	7.00		For each commercial or industrial ventilation system	5.00	
	Over 10-ton or 10 horsepower up to and including 30, or absorption system over 250,000 B.t.u.'s up to and including 1,000,000 B.t.u.'s	12.00			For each commercial kitchen hood	5.00	
	Over 30-ton or 30 horsepower up to and including 50, or absorption system over 1,000,000 B.t.u.'s up to and including 1,700,000 B.t.u.'s	20.00			MISCELLANEOUS		
	Over 50-ton or 50 horsepower, or absorption system over 1,700,000 B.t.u.'s	30.00			For each water cooling tower	8.00	
	FOR EACH AIR HANDLING UNIT INCLUDING DUCTS ATTACHED THERETO			7	Duct work only - each opening	.25	1.75
	Up to and including 10,000 CFM	2.00			For installation or relocation of each commercial or industrial incinerator	15.00	
	Over 10,000 CFM	4.00			Gas piping related to the air cond. work in single family dwelling only	3.00	
					For each appliance, piece of equipment, any mechanical work or alteration or replacement not included in this schedule, the permit fee shall be computed the same as building permit fees by using the cost of installation the valuation amount.		
					FOR THE ISSUANCE OF EACH PERMIT		3.00
					TOTAL PERMIT FEES	12.75	

I hereby certify that I have carefully examined and read the above application; that the same is true and correct, and that the work herein described is to be done in accordance with all the provisions of the applicable Ordinances of the City of Las Vegas, Nevada and the State Laws, whether herein specified or not.

Approval for the work under this permit will be given only after refuse and debris have been removed from job site and public right of way.

SIGNED

Carl Butler / *[Signature]* Date 8-14-78

Air Conditioning Contractor - Owner

BUILDING DIVISION

Date

8-7-78

PERMIT NO.

8541-16

PERMIT FEE \$

12.75

RECEIPT

MUST BE MACHINE VALIDATED

#12890

CITY OF LAS VEGAS, NEVADA

DEPARTMENT OF PUBLIC SERVICES—ELECTRICAL APPLICATION & PERMIT DIVISION OF BUILDING AND SAFETY

ADDRESS OF CONSTRUCTION: 1820 Blackhawk OWNER'S NAME: Chism Homes
CIRCLE: (New Bldg.) Add'n. Remodel TYPE OF BLDG.: SFD APT. PUBLIC COMM.
CONTRACTOR'S NAME: Electrical Systems STATE LICENSE # 14718 CITY LICENSE # 14422

NUMBER	FIXTURE OR INSTALLATION	UNIT PRICE	TOTAL
	Rm addition, carport or garage enclosure	4.00	
	Temporary power	4.00	
40	Light, receptacle or switch outlet	.20	8.00
	Wall or ceiling space heater	.35	
1	Garbage grinder outlet	.35	.35
1	Dishwasher outlet	.35	.35
1	Clothes dryer outlet	.35	.35
1	Automatic clothes washer	.35	.35
	Electric range outlet	.35	
	Electric water heater outlet	.35	
	Special purpose outlet	.35	
	X-ray unit and its appurtenances	5.00	
	Watts of festoon lighting (Watts) First 3,000 watts for each additional thousand watts	4.00 1.50	
	Horsepower each motor first horsepower or less for each additional horsepower	1.75 .35	
1	Electric service (including any single meter socket) for each additional socket	3.00 .35	3.00
1	Air conditioning service	1.50	1.50
	Each KW(KVA) Generator (Transformer, Welder) First 100 KVA for each additional KW(KVA)	2.00 .01	
	Speaker, signal or alarm outlet	.15	
	Amplifiers	.50	
	Control panels	.25	
	Main control racks	1.00	
	T.V. and radio antennas-master system only	.75	
	Minimum fee for any permit	4.00	
	TOTAL FEE		13.90

Approval for the work under this permit will be given only after refuse and debris have been removed from job site and public right of way.

I hereby certify that I have carefully examined and read the above application; that the same is true and correct; and that the work herein described is to be done in accordance with all the provisions of the applicable Ordinances of the City of Las Vegas, Nevada and State laws whether herein specified or not.

SIGNED: George D. Diller DATE 9/14/78
MASTER (ELECTRICIAN) (TECHNICIAN) (OWNER)
BUILDING DIVISION: M.S. DATE 9-14-78
PERMIT NO. 9482-16 PERMIT FEE: \$ 13.90

RECEIPT

MUST BE MACHINE VALIDATED

17-13

CITY OF LAS VEGAS, NEVADA

LOG NO. & AREA

CONST. VAL. 195

DEPARTMENT OF PUBLIC SERVICES
DIVISION OF BUILDING & SAFETYAPPLICATION & BUILDING PERMIT - for:
Fence, Wall, Retaining Wall.ADDRESS OF
CONSTRUCTION:

1820 Blackhawk

OWNER:

Minkner, Brad

LOT(s)

18

BLOCK

14

SUBDIVISION

KINGSWOOD ESTATES NO 5

ZONE

R-1

Materials of Construction:

Block ☒Concrete ☐Wire ☐Wood ☐Other ☐

Yes No

PLANS: ☐ ☐

ARCHITECT:

ENGINEER:

CALCS: ☐ ☐

CONTRACTOR:

Owner

STATE
LICENSE #CITY
LICENSE #

TOTAL SQUARE FEET: 198


TOTAL LINEAL FEET: 33

Remarks:

33' x 6' block

CONDITIONS OF THE PERMIT:

1. Any type of retaining wall must be engineered by a Civil or Structural Engineer.
2. If a home owner takes out the Building Permit and if the owner sublets the work to a Contractor, then the Contractor must take out the permit and pay for it.
3. No fence or wall can be built on City property or rights-of-way, but this is not intended to preclude construction within utility easements if utilities will not be damaged or made inaccessible.
4. The fence or wall shall not enclose any water meter, light standard, or fire alarm box and shall not come closer than 24" from the nearest fire hydrant outlet.
5. Department inspectors must approve footings before concrete is poured and block wall reinforcing before grouting is done.
6. Maximum height of any wall or fence is 6', side and rear yards; 4' maximum in front yard with the vertical surface above the height of 2' - 50% open.
7. I must not obstruct required onsite parking space (2 spaces for each dwelling unit) by the erection of this fence or wall.
8. By the signing of this application I herewith agree to the requirements outlined above.

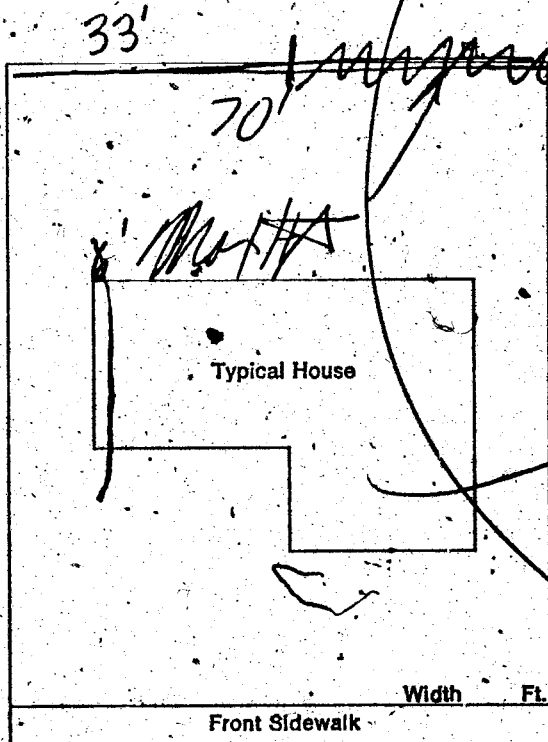

SIGNED:

[Signature]

DATE: 10-31-79

CONTRACTOR ☐AGENT ☐OWNER ☒

PLANNING DEPT:

[Signature]

Date:

10-30-79

PUBLIC WORKS DEPT:

Date:

BUILDING DIVISION:

Date:

11/1/79

#12850

PERMIT NO:

8044-1

PERMIT FEE \$

7.00

RECEIPT

MUST BE MACHINE VALIDATED

CITY OF LAS VEGAS, NEVADA

LOG NO. & AREA

DEPARTMENT OF PUBLIC SERVICES
DIVISION OF BUILDING & SAFETY

APPLICATION & BUILDING PERMIT - for:
Fence, Wall, Retaining Wall.

CONST. VAL. \$ 645.00

ADDRESS OF CONSTRUCTION:

1820 Blackhawk

OWNER:

Brad Milner

LOT(s)

18

BLOCK

14

SUBDIVISION

Kingsman Estates No. 4

ZONE

R-1

Materials of Construction:

Block ☒

Concrete ☐

Wire ☐

Wood ☐

Other ☐

Yes

No

PLANS:

☐

☐

CALCS:

☐

☐

ARCHITECT:

ENGINEER:

CONTRACTOR:

Quix

STATE

LICENSE #

CITY

LICENSE #

TOTAL SQUARE FEET

258


TOTAL LINEAL FEET:

43

Remarks:

CONDITIONS OF THE PERMIT:

- Any type of retaining wall must be engineered by a Civil or Structural Engineer.
- If a home owner takes out the Building Permit and if the owner sublets the work to a Contractor, then the Contractor must take out the permit and pay for it.
- No fence or wall can be built on City property or rights-of-way, but this is not intended to preclude construction within utility easements if utilities will not be damaged or made inaccessible.
- The fence or wall shall not enclose any water meter, light standard, or fire alarm box and shall not come closer than 24" from the nearest fire hydrant outlet.
- Department Inspectors must approve footings before concrete is poured and block wall reinforcing before grouting is done.
- Maximum height of any wall or fence is 6', side and rear yards; 4' maximum in front yard with the vertical surface above the height of 2' - 50% open.
- I must not obstruct required onsite parking space (2 spaces for each dwelling unit) by the erection of this fence or wall.
- By the signing of this application I herewith agree to the requirements outlined above.

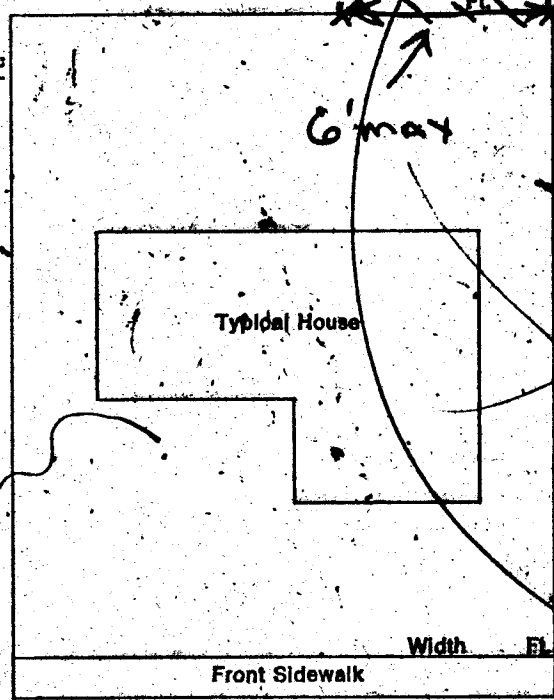

SIGNED:

CONTRACTOR ☒

AGENT ☐

DATE:

12/18/79

WALL \$ 9.00

STI \$ 2.00

TOTAL RECEIPT

CHEK \$ 9.00

AMOUNT SR#001/01

CITY - LAS VEGAS

BLDG. & SAFETY

12/18/79

PLANNING DEPT. ☒

Date:

12/18/79

PUBLIC WORKS DEPT. ☐

Date:

12/18/79

BUILDING DIVISION: Jonie

Date:

12/18/79

#12850

PERMIT NO:

9039

PERMIT FEE \$

9.00

MUST BE MACHINE VALIDATED

VEGAS, NEVADA

CONST. VAL. \$ 645.00

APPLICATION & BUILDING PERMIT - for:
Fence, Wall, Retaining Wall.

OWNER: Brad Milner

Estates No. 4

ZONE R-1

Wire ☒ Wood ☐ Other ☐ X

Yes No

PLANS: ☐ ☐

CALCS: ☐ ☐

STATE CENSE # 258 CITY LICENSE # 43

TOTAL SQUARE FEET: 258 TOTAL LINEAL FEET: 43

CONDITIONS OF THE PERMIT:

Any type of retaining wall must be engineered by a Civil or Structural Engineer.

If a home owner takes out the Building Permit and if the owner sublets the work to a Contractor, then the Contractor must take out the permit and pay for it.

No fence or wall can be built on City property or rights-of-way, but this is not intended to preclude construction within utility easements if utilities will not be damaged or made inaccessible.

The fence or wall shall not enclose any water meter, light standard, or fire alarm box and shall not come closer than 24" from the nearest fire hydrant outlet.

Department inspectors must approve footings before concrete is poured and block wall reinforcing before grouting is done.

Maximum height of any wall or fence is 6', side and rear yards; 4' maximum in front yard with the vertical surface above the height of 2' — 50% open.

It must not obstruct required onsite parking space (2 spaces for each dwelling unit) by the erection of this fence or wall.

By the signing of this application I herewith agree to the requirements outlined above.

SIGNED: Brad Milner DATE: 12/18/79

CONTRACTOR ☒ AGENT ☐

1.000 \$.00
WALL \$ 9.00
STI \$ 8.00

Date: 12-18-79

Date: 12-18-79

Date: 12/18/79

PERMIT FEE \$ 9.00

TOTAL RECEIPT
CHECK \$ 9.00
R#9039 SR#001/01
CITY - LAS VEGAS
BLDG. & SAFETY
12/18/79

MUST BE MACHINE VALIDATED

2 Gloria Dalewood 3-12-80

CITY OF LAS VEGAS, NEVADA

CONST. VAL. \$ 3025.00

LOG NO. & AREA

DEPARTMENT OF BUILDING & SAFETY

APPLICATION & BUILDING PERMIT - for:
Fence, Wall, Retaining Wall.

ADDRESS OF CONSTRUCTION 1820 Blackhawk OWNER Brad Milner

LOT 18 BLOCK 14 SUBDIVISION Kingswood Det H 4 ZONE R-1

Material of Construction: Block ☒ Concrete ☐ Wire ☐ Wood ☐ Other ☐ PLANS ☐ CALC. ☐


ARCHITECT _____ ENGINEER _____

CONTRACTOR Cramer STATE LICENSE # 1062 CITY LICENSE # 223

TOTAL SQUARE FEET 1062 TOTAL LINEAL FEET 223

CONDITIONS OF THE PERMIT

1. Any type of retaining wall must be engineered by a Civil or Structural Engineer.
2. If a home owner takes out the Building Permit and if the owner sublets the work to a Contractor, then the Contractor must take out the permit and pay for it.
3. No fence or wall can be built on City property or rights-of-way but this is not intended to preclude construction within utility easements if utilities will not be damaged or made inaccessible.
4. The fence or wall shall not enclose any water meter, light standard, or fire alarm box and shall not come closer than 24" from the nearest fire hydrant outlet.
5. Department inspectors must approve footings before concrete is poured, and block wall reinforcing before ground is done.
6. Maximum height of any wall or fence is 6' side and rear yards, 4' maximum in front yard with the vertical surface above the height of 2' - 50% open.
7. It must not obstruct required on-site parking space (1 space for each dwelling unit) by the erection of this fence or wall.
8. By the signing of this application I herewith agree to the requirements outlined above.

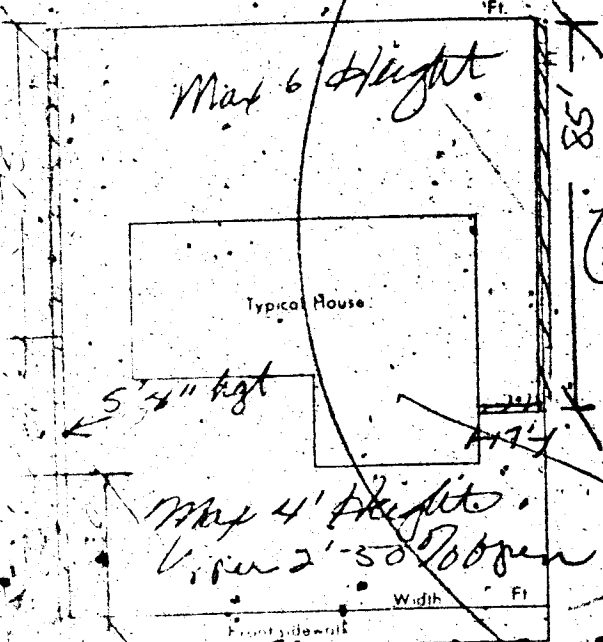

1820 Blackhawk

SIGNED: Brad Milner DATE: 2/4/80
CONTRACTOR ☐ ARCHITECT ☒

PLANNING DEPT: J. Brown Date: 2/4/80

WORKS DEPT: [Signature] Date: 2/4/80

BUILDING DEPT: [Signature] Date: 2/4/80

PERMIT NO. 0019 PERMIT FEE \$ 2400

RECEIPT
TOTAL \$ 24.00
CASH \$ 24.00
#0019 SR#001/01
CITY - LAS VEGAS
BLDG. & SAFETY
02/04/80

MUST BE MACHINE VALIDATED

Permit No. 19-81

FENCE & RETAINING WALLS

FENCE & RETAINING WALLS

DATE

OWNER

OWNER

12-18-78

CONTRACTOR

PERMIT NO.

FINAL INSPECTION

OWNER

FINAL INSPECTION

Owner

DIVISION OF BUILDING & SAFETY - CITY OF LAS VEGAS, NEVADA

BLOCK

SUBDIVISION

OWNER Chism Homes

ADDRESS 1821 Blackhawk Road

DATE 12-18-78

GEN. CONT. Same

BLOCK

ESTATES #5

TYPE OF STRUCTURE SBD-W-EP

PERMIT NO. 6436-4

14 Kingswood

LEGAL DESCRIPTION

L17-B 10 Kingswood Estates #4

LOG	BUILDING	AREA	MECHANICAL	ELECTRICAL
Investigation			Plumbing Cont. Sunrise	Temp. 1986 wire, wood, block, & retaining walls
Location & Footing	4-7-18-78		Permit No. 7381-21	Permit No. 7381-21

Specify Type Of Fence

INSPECTOR

DATE

APPROVED FOR OCCUPANCY & METER

2-1-33

DIV. OF BLDG. & SAFETY
CITY OF LAS VEGAS
REV. 10-78

RECORD SYSTEMS
ON 48055
L.A.S. 11.8 A

PLEASE NOTE REMARKS ON REVERSE SIDE

1821 Blackhawk Road LOG

AREA

T 32-3

74-114

FENCE & RETAINING WALLS

OWNER

1821 Blackhawk

DATE

2-4-80

ADDRESS

1821 Blackhawk

CONTRACTOR

Owner

PERMIT NO.

0019

FINAL INSPECTION

Blk wall

LOT

18

BLOCK

14 Kingswood Etc. #4

SUBDIVISION

LOG

AREA

FENCES (wire, wood, block, & retaining walls)

Location

Footing

Final








