

3408 Avalon Ave

LOT 4 BLK 4 TWIN LAKES ESTATES #6D ZONE R-1

D. Gatewood 1-18-79

1969

CITY OF LAS VEGAS, NEVADA
DEPARTMENT OF BUILDING AND SAFETY
APPLICATION FOR FENCE, WALL OR
RETAINING WALL

LOG NO. _____

AREA: _____

KARDEX CARD: _____

TELEPHONE: _____

CONSTRUCTION VALUATION: \$ 29500
INSPECTION VALUATION: \$ 23200

PERMIT FEE: \$ 400

PERMIT NUMBER: 28170

DATE: Oct. 26 1964

ADDRESS OF CONSTRUCTION: 3408 Avalon

OWNER'S NAME: Helen Dragon

Lot (s) 4 Block 4 Subdivision TWIN LAKES ESTATES #6A Zone: R-1


Materials of Concrete Construction: Block () Concrete () Wire (X) Wood () Other ()

Total Square Feet: _____ Total Lineal Feet: 232

CONTRACTOR'S NAME: Bonded Builders STATE LICENSE # 6920C CITY LICENSE # 3546

Architect's Name: _____ PLANS SUBMITTED: Yes _____ No _____
Engineer's Name: _____ CALCULATIONS: Yes _____ No _____

Street Name: _____
Front Yard: _____ Feet

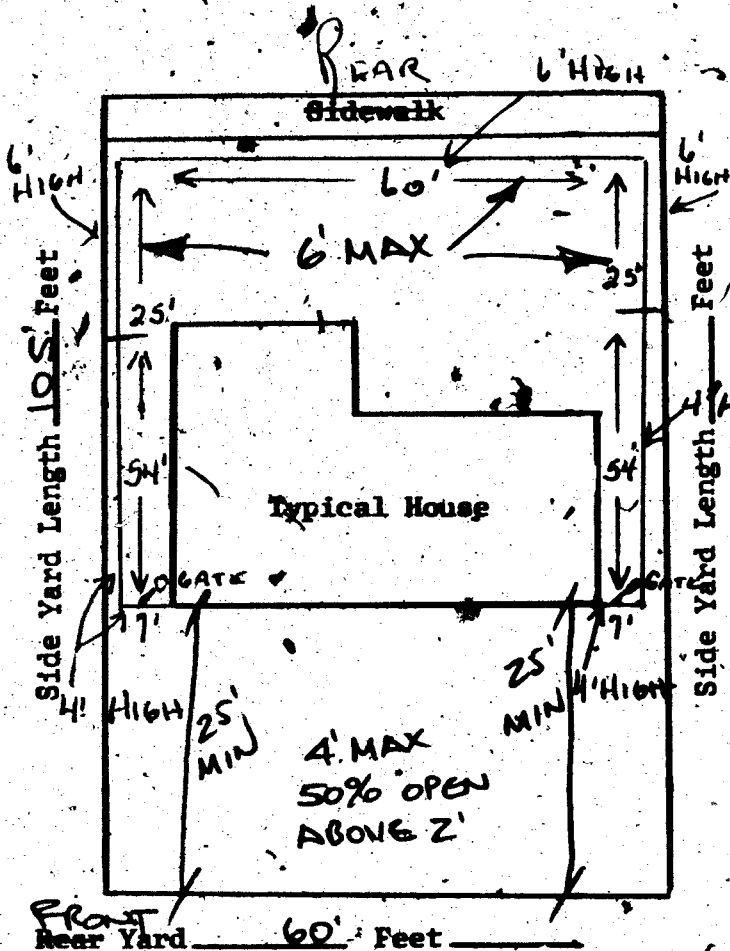

I understand that any portion of this (fence) (wall) constructed or erected on City property or right-of-way will be removed from said location at my expense upon request received from the City of Las Vegas, Nevada. I understand that the (fence) (wall) shall not enclose water meter, light standard, fire alarm box and shall not come closer than two(2') feet in any direction from any fire hydrant. I further state that I am familiar with effective Ordinances of the City of Las Vegas, Nev. and effective Statutes of the State of Nevada covering construction and use of above type; I agree to perform said construction in conformity therewith. I further agree that issuance of a permit on above application will not excuse me from conforming with said Ordinances and Statutes, despite any errors on the part of the Building Inspector or Engineer in checking plans and applications herewith submitted.

I have read and understand the contents of above application; I hereby state that same are true and correct.

SIGN HERE: _____
By: _____

APPROVED BY: _____
PLANNING DEPT. & CODE ASSISTANCE DATE: _____

FIRE DEPARTMENT DATE: _____

ENGINEERING DEPT. DATE: _____

BUILDING & SAFETY DEPT. DATE: _____

Note: Owner or Contractor must call for all inspections required.

CITY OF LAS VEGAS
DEPT. OF
BUILDING & SAFETY
6462, \$004.00 207L
2-6 OCT 64

Theresa Kynaker 12-2-80

DEPARTMENT OF BUILDING & SAFETY
CITY OF LAS VEGAS, NEVADA

KARDEX CARD
FENCE & RETAINING
WALLS

OWNER Nelson Gragson ADDRESS 3408 Avalon DATE 10-27-64

CONTRACTOR Bonded Builders PERMIT NO. 28170

LOT 4 BLOCK 4 SUBDIVISION Twin Lakes Est #6A Wire fence

Fence (wire, wood, etc.)	Walls (masonry, rock, etc.)
Location _____	Location _____
Final Inspection <u>10-27-64</u>	Footings _____
	Wall Steel 1st _____ 2d _____ 3d _____
	Final Inspection _____
Retaining Wall (masonry)	Retaining Wall (concrete)
Location _____	Location _____
Footings _____	Footings _____
Wall Steel 1st _____ 2d _____ 3d _____	Wall Steel 1st _____ 2d _____ 3d _____
Bond Beam 1st _____ 2d _____ 3d _____	Final Inspection _____
Final Inspection _____	

23.14 B

ADDRESS 3408 Avalon LOG NO. _____ AREA _____