

2105 Ash Street

LOT 23 BLK 1 GTBSON & JONES ZONE R-1

2. Gatewood 1-17-79

Alona Ealy 11-25-80


CITY OF LAS VEGAS, NEVADA

LOG NO. & AREA _____ CONST. VAL. 436
 DEPARTMENT OF BUILDING & SAFETY APPLICATION & BUILDING PERMIT for
 Fence, Wall, Retaining Wall.
 ADDRESS OF CONSTRUCTION: 2105 Ash OWNER: HAMILTON
 LOT(s) 23 BLOCK 1 SUBDIVISION Gibson Jaones add ZONE B-1
 Materials of Construction: Block ☒ Concrete ☐ Wire ☐ Wood ☐ Other ☐ Yes ☐ No ☒
 ARCHITECT: _____ ENGINEER: _____ PLANS: ☐ ☒
 CONTRACTOR: Ace Masonry Serv. STATE LICENSE # 10432 CITY LICENSE # _____ CALCS: ☐ ☒
 TOTAL SQUARE FEET: 436 TOTAL LINEAL FEET: 100

Remarks:

CONDITIONS OF THE PERMIT:

- Any type of retaining wall must be engineered by a Civil or Structural Engineer.
- If a home owner takes out the Building Permit and if the owner sublets the work to a Contractor, then the Contractor must take out the permit and pay for it.
- No fence or wall can be built on City property or rights-of-way, but this is not intended to preclude construction within utility easements if utilities will not be damaged or made inaccessible.
- The fence or wall shall not enclose any water meter, light standard, or fire alarm box and shall not come closer than 24" from the nearest fire hydrant outlet.
- Department inspectors must approve footings before concrete is poured and block wall reinforcing before grouting is done.
- Maximum height of any wall or fence is 6', side and rear yards; 4' maximum in front yard with the vertical surface above the height of 2' - 50% open.
- I must not obstruct required onsite parking space (2 spaces for each dwelling unit) by the erection of this fence or wall.
- By the signing of this application I herewith agree to the requirements outlined above.

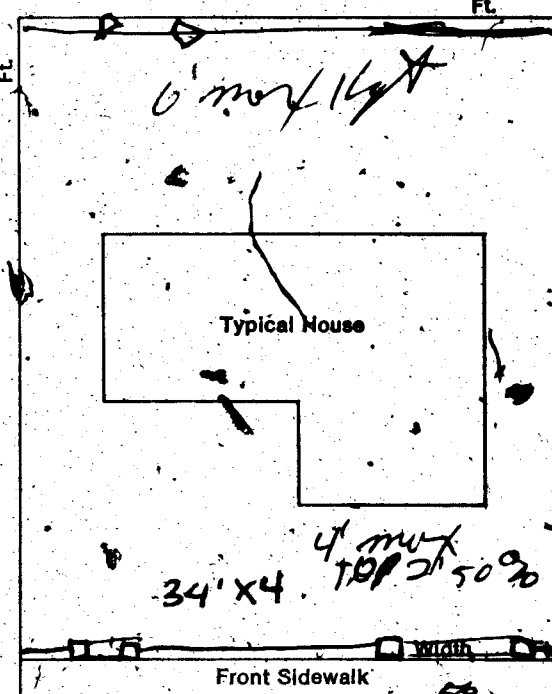

SIGNED: [Signature] DATE: _____
 CONTRACTOR ☒ AGENT ☐ OWNER ☐

PLANNING DEPT: JBA Date: 3-23-73

PUBLIC WORKS DEPT: _____ Date: _____

BUILDING DEPT: H.T. Eller Date: 3-23-73

#12850 PERMIT NO: 10036 PERMIT FEE: 72

RECEIPT

2976 \$007.00 - 8

CITY OF LAS VEGAS

DEPT. OF BUILDING & SAFETY

MUST BE MACHINE VALIDATED

23 MAR 73

DEPARTMENT OF BUILDING & SAFETY
 CITY OF LAS VEGAS, NEVADA

KARDEX CARD
 FENCE & RETAINING WALLS

OWNER Hamilton ADDRESS 2105 Ash DATE 3-23-73
 CONTRACTOR Ace Masonry PERMIT NO. 10036
 LOT 23 BLOCK 1 SUBDIVISION Gibson Jaones add block fence

Fence (wire, wood, etc.)	Walls (masonry, rock, etc.)
Location _____	Location <u>3-23-73</u>
Final Inspection _____	Footings <u>3-23-73</u>
	Wall Steel 1st _____ 2d _____ 3d _____
	Final Inspection <u>3-23-73</u>
Retaining Wall (masonry)	Retaining Wall (concrete)
Location _____	Location _____
Footings _____	Footings _____
Wall Steel 1st _____ 2d _____ 3d _____	Wall Steel 1st _____ 2d _____ 3d _____
Bond Beam 1st _____ 2d _____ 3d _____	Final Inspection _____
Final Inspection _____	

23.14 B ADDRESS 2105 Ash LOG NO. _____ AREA _____

Aloria Ealy 11-25-80

DEPARTMENT OF BUILDING & SAFETY
CITY OF LAS VEGAS, NEVADA

KARDEX CARD
FENCE & RETAINING
WALLS

OWNER Hamilton ADDRESS 2105 Ash DATE 3-23-73

CONTRACTOR Are Masonry PERMIT NO. 10036

LOT 23 BLOCK 1 SUBDIVISION Gibson Jaones add block fence

Fence (wire, wood, etc.)	Walls (masonry, rock, etc.)
Location _____	Location <u>SC 3-23-73</u>
Final Inspection _____	Footings <u>SC 3-23-73</u>
	Wall Steel 1st _____ 2d _____ 3d _____
	Final Inspection <u>2 B 7-14-73</u>
Retaining Wall (masonry)	Retaining Wall (concrete)
Location _____	Location _____
Footings _____	Footings _____
Wall Steel 1st _____ 2d _____ 3d _____	Wall Steel 1st _____ 2d _____ 3d _____
Bond Beam 1st _____ 2d _____ 3d _____	Final Inspection _____
Final Inspection _____	

23.14 B

ADDRESS 2105 Ash LOG NO. _____ AREA _____