

309 Avalon Circle

LOT 6 BLK 5 TWIN LAKES ESTATES 6A ZONE R-1

D. Gatewood 1-18-79

CITY OF LAS VEGAS, NEVADA

DEPARTMENT OF PUBLIC SERVICES—ELECTRICAL APPLICATION & PERMIT DIVISION OF BUILDING AND SAFETY

ADDRESS OF CONSTRUCTION: 309 AVAION CR OWNER'S NAME: Wm Donahoe

CIRCLE: New Bldg; Add'n.; Remodel; TYPE OF BLDG: SFD. APT. PUBLIC COMM.

CONTRACTOR'S NAME: Owner STATE LICENSE # CITY LICENSE #

NUMBER	FIXTURE OR INSTALLATION	UNIT PRICE	TOTAL
	Arm addition, carport or garage enclosure	4.00	
	Temporary power	4.00	
	Light, receptacle or switch outlet	.20	
	Wall or ceiling space heater	.35	
	Garbage grinder outlet	.35	
	Dishwasher outlet	.35	
	Clothes dryer outlet	.35	
	Automatic clothes washer	.35	
	Electric range outlet	.35	
	Electric water heater outlet	.35	
	Special purpose outlet	.35	
	X-ray unit and its appurtenances	5.00	
	Watts of festoon lighting (Watts) First 3,000 watts for each additional thousand watts	4.00 1.50	
	Horsepower each motor first horsepower or less for each additional horsepower	1.75 .35	
	Electric service (including any single meter socket) for each additional socket	3.00 .35	
	Air conditioning service	1.50	
	Each KW(KVA) Generator (Transformer, Welder) First 100 KVA for each additional KW(KVA)	2.00 .01	
	Speaker, signal or alarm outlet	.15	
	Amplifiers	.50	
	Control panels	.25	
	Main control racks	1.00	
	T.V. and radio antennas-master system only	.75	
	Minimum fee for any permit	4.00	
	TOTAL FEE		

Approval for the work under this permit will be given only after refuse and debris have been removed from job site and public right of way.

I hereby certify that I have carefully examined and read the above application; that the same is true and correct; and that the work herein described is to be done in accordance with all the provisions of the applicable Ordinances of the City of Las Vegas, Nevada and State laws whether herein specified or not.

SIGNED

MASTER (ELECTRICIAN) (TECHNICIAN) (OWNER)

DATE 2-22-78

BUILDING DIVISION: MM

DATE 2-22-78

PERMIT NO. 3848-1

PERMIT FEE: \$ 4.00

RECEIPT

MUST BE MACHINE VALIDATED

D. Gatewood 1-18-79

CITY OF LAS VEGAS, NEVADA

LOG NO. & AREA

DEPARTMENT OF PUBLIC SERVICES
DIVISION OF BUILDING AND SAFETY

APPLICATION & BUILDING PERMIT for:
Dwellings, Duplexes, Misc. Residential Const.

CONST. VAL. \$

3950⁰⁰

ADDRESS OF
CONSTRUCTION

309 AVAION Circle

OWNER:

Wm Donahoe

LOT(s)

6

BLOCK

5

SUBDIVISION

TWIN LAKES RESIDES #10A ZONE A-1

Existing structure on lot:

Dwelling ☒

Accessory Bldg. ☐

Vacant Lot ☐

Other ☐

PROPOSED CONSTRUCTION:

Rm Addition for Fire place & DINING ROOM

MATERIALS OF CONSTRUCTION:

Wood Frame ☐

Concrete Block ☐

Reinforced Concrete ☐

Steel Frame ☐

SQUARE FEET OF FLOOR AREAS:

1st

2nd

3rd

Other

TOTAL SQ. FT.

315

FIRE ZONE:

Occupancy Group

CONST. TYPE:

ARCHITECT:

ENGINEER:

NO. of UNITS

NO. of STORIES

Plans Submitted:

Yes ☐

No ☐

Calculations Submitted

Yes ☐

No ☐

Sever Fee Req'd.

Yes ☐

No ☐

CONTRACTOR:

OWNERS

STATE
LICENSE #

CITY
LICENSE #

ADD'L. PERMITS REQ'D:

Air Cond. ☐

Elec. ☒

Plumbing ☐

Signs ☐

Paving ☐

Fence ☐

Public Walks ☐

Curb-gutters ☐

Incinerators ☐

Fire Sprinkling System ☐

CONDITIONS OF THE PERMIT:

1. I agree to call the City Building Department for inspections before concrete is poured, before rough wiring, electrical, plumbing, framing is covered. Also for Air conditioning, drywall and sheathing inspection.
2. I agree that when the job is completed that I will call for final inspection before occupancy.
3. I agree to perform all construction in accordance with City Ordinances and Building Codes.
4. The Contractor's signature below denotes authority from the owner to sign in his behalf and that the owner is aware of all requirements of this application and permit. Separate permits must be taken out for work outlined above this agreement.
5. I have read and understand the contents of this application and permit; I hereby state that the information I have supplied on this application is true and correct.

Approval for the work under this permit will be given only after refuse and debris have been removed from job site and public right of way.

SIGNED:

BY:

Edaine K. Donahoe

Contractor

Agent or Owner

INSTR \$ 0.00

350 \$ 24.00

ELEC \$ 4.00

STL \$ 28.00

STL \$ 28.00

TOTL \$ 28.00

CHEK \$ 28.00

ANZONO SR#001/01

CITY - LAS VEGAS

BLDG. & SAFETY

02/23/78

PLANNING DEPT.

Date:

2-22-78

PUBLIC WORKS DEPT.

Date:

2/24/78

BUILDING DIVISION:

Date:

2-22-78

PERMIT NO.:


3848

PERMIT FEE:

24.00

154-01-220

MUST BE MACHINE VALIDATED

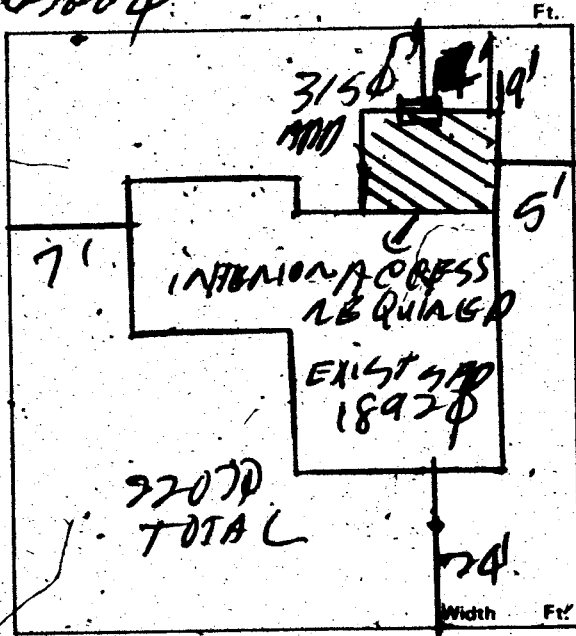

Luba Collins 12-19-84

OWNER <u>WM. DONAHUE</u>		ADDRESS <u>309 AVA-GN CIR.</u>	
DATE <u>2-22-78</u>		GEN. CONT. <u>OWNER</u>	
TYPE OF STRUCTURE <u>ROOM ADD & F/P</u>		PERMIT NO. <u>3848</u>	
LEGAL DESCRIPTION <u>L-6, B-E TWIN LAKES #6A</u>		LOG # <u> </u> AREA # <u> </u>	
APPROVED FOR OCCUPANCY & METER			
BUILDING		MECHANICAL	
Investigation		Plumbing Cont.	
Location & Footing		Permit No. <u> </u> Date <u> </u>	
Concrete Slab Floor		Heat & Vent. A/C Cont.	
Fireplace Footing		Permit No. <u> </u> Date <u> </u>	
Chimney Steel		Sewer Cont.	
Vert. Steel Reinf.		Permit No. <u> </u> Date <u> </u>	
Horiz. Steel Reinf.		Rough Soil	
Framing		Rough Water	
Ext. Lath		Top Out	
Ext. Brown		Rough Gas	
Drywall		A/C Rough Duct	
Final Building		Final Plumbing	
Appr. for Occu.		Final Gas	
ELECTRICAL		Final Air Cond.	
Temp. Pole Cont.		Final Sewer	
Permit No. <u> </u> Date <u> </u>		REMARKS	
Inspection <u> </u> Date <u> </u>			
Electrical Cont. <u>Owner</u>			
Permit No. <u>3848-1</u> Date <u>2-22-78</u>			
Rough		PLEASE NOTE ADDITIONAL REMARKS ON REVERSE SIDE.	
Final Rough		DIV. OF BLDG. & SAFETY CITY OF LAS VEGAS REV. 10-78	
Final Electrical		2-1-31	
Temporary Service		E-Z-WAY SYSTEMS NEWARK OH 43055 LITHO IN U.S.A.	