

4609 ALYSE WAY

LOT 12 BLK 1 STEWART PLACE UNIT 3 ZONE R-1

CITY OF LAS VEGAS, NEVADA

LOG NO. & AREA

DEPARTMENT OF PUBLIC SERVICES
DIVISION OF BUILDING AND SAFETY

APPLICATION & BUILDING PERMIT for:
Dwellings, Duplexes, Misc. Residential Const.

CONST. VAL. \$ 29,370⁰⁰

ADDRESS OF CONSTRUCTION: 4609 Alyse Way

OWNER: DASCO, INC.

LOT(s) 12 BLOCK 1 SUBDIVISION Stewart Place Unit 3 ZONE R-1

Existing structure on lot: Dwelling ☐ Accessory Bldgs. ☐ Vacant Lot ☒ Other ☐

PROPOSED CONSTRUCTION: Framed Stucco Use: S.F.D.

MATERIALS OF CONSTRUCTION: Wood Frame ☒ Concrete Block ☐ Reinforced Concrete ☐ Steel Frame ☐

SQUARE FEET OF FLOOR AREAS: 1st 1268 2nd 341 3rd 1629 TOTAL SQ. FT. 1629

FIRE ZONE 3 Occupancy Group 1 J CONST. TYPE: V

ARCHITECT: Earl Kaltenbach ENGINEER: VTN NO. of UNITS 1 NO. of STORIES 1

Plans Submitted: Yes ☒ No ☐ Calculations Submitted: Yes ☒ No ☐ Sewer Fee Req'd.: Yes ☐ No ☐

CONTRACTOR: DASCO, INC.

STATE LICENSE # 9778A

CITY LICENSE # C11-281-2-05733

ADD'L. PERMITS REQ'D.: Air Cond. ☒ Elec. ☒ Plumbing ☒ Signs ☐ Paving ☒ Fence ☐ Public Walks ☒ Curb-gutters ☒
Incinerators ☐ Fire Sprinkling Systems ☐


CONDITIONS OF THE PERMIT:

1. I agree to call the City Building Department for inspections before concrete is poured, before rough wiring, electrical, plumbing, framing is covered. Also for Air conditioning, drywall and sheathing inspection.
2. I agree that when the job is completed that I will call for final inspection before occupancy.
3. I agree to perform all construction in accordance with City Ordinances and Building Codes.
4. The Contractor's signature below denotes authority from the owner, to sign in his behalf and that the owner is aware of all requirements of this application and permit. Separate permits must be taken out for work outlined above this agreement.
5. I have read and understand the contents of this application and permit; I hereby state that the information I have supplied on this application is true and correct.

Approval for the work under this permit will be given only after refuse and debris have been removed from job site and public right of way.

SIGNED: DASCO, INC. Contractor

BY: [Signature] Agent or Owner

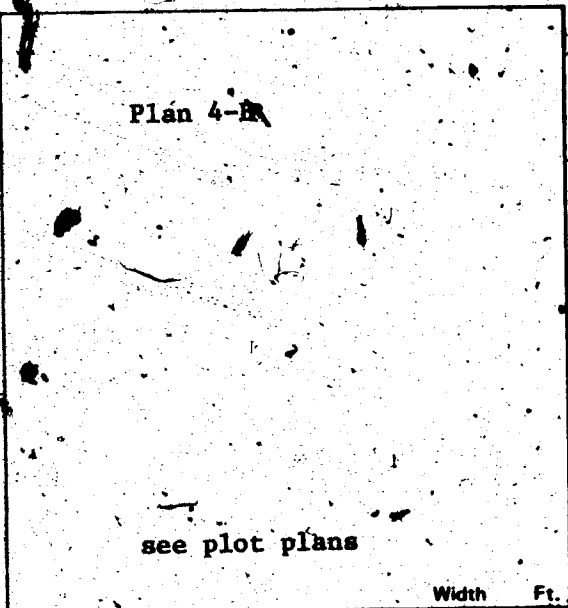

PLANNING DEPT. [Signature]

Date: 6-14-77

PUBLIC WORKS DEPT. [Signature]

Date: 6-15-77

BUILDING DIVISION [Signature]

Date: 6-15-77

154-01-220

PERMIT NO. 3305

PERMIT FEE \$116.00

RECEIPT

2971 \$1116.00

CITY OF LAS VEG

MUST BE MAINTAINED & VALIDATED

20 JUN 77

CITY OF LAS VEGAS, NEVADA

DEPARTMENT OF BUILDING & SAFETY — APPLICATION AND PERMIT FOR PLUMBING

ADDRESS OF
CONSTRUCTION: 4609 ALYSE WAYOWNER'S
NAME: DASCO, INC.

CIRCLE: New Bldg.; Add'n; Remodel; TYPE OF BLDG. SFD APT. PUBLIC COMM.

CONTRACTOR'S NAME: FREMONT PLUMBING, INC. STATE
LICENSE # 10035A CITY
LICENSE # 8014

UNITS	DESCRIPTION	FEE	TOTAL
1	Bathtub	1.00	1.00
1	Shower	1.00	1.00
2	Lavatory	1.00	2.00
2	Toilet	1.00	2.00
	Urinal	1.00	
	Floor Drain	1.00	
	Floor Sink	1.00	
	Wash Tray	1.00	
1	Sink	1.00	1.00
1	Garbage Disposal	1.00	1.00
	Garbage Disposal (comm.)	3.00	
	Clothes Dryer (gas)	1.00	
1	Clothes Washer	1.00	1.00
	Clothes Washer (comm.)	5.00	
	Dishwasher	1.00	
	Dishwasher (commercial)	5.00	
	Dental Unit	10.00	
	Drinking Fountain	1.00	
	Any Water using Equipment	1.00	
1	Water Heater (gas) (elect.)	1.00	1.00
1	Sewer System — New, Replacement, or any Drainage System	4.00	4.00
	Grease or Sand Trap	2.00	
	Trailer Trap	2.00	
	Septic Disposal System	4.00	
WATER SOFTENERS			
	Nonpermanent Type	4.00	
	Permanent Type (connected to Drainage)	5.00	
SWIMMING POOLS			
	Private or Wading Pool	10.00	
	Public or Semi-public	25.00	

UNITS	DESCRIPTION	FEE	TOTAL
WATER DISTRIBUTION SYSTEM			
1	Single Family Dwelling	4.00	4.00
	Multiple Family Dwelling plus each unit	4.00 2.00	
	Bldg. Group "A" thru "G" per each floor	6.00	
	Hotel or Motel plus each bath	4.00 1.50	
	Trailer Park plus each space	20.00 1.00	
	Irrigation	4.00	
GAS PIPING SYSTEM			
1	Single Family Dwelling	3.00	3.00
	Multiple Family Dwelling plus each unit	6.00 1.00	
	Commercial Bldg. per floor plus each unit	3.00 3.00	
2	Gas Appliance (any type)	1.00	2.00
AUTOMATIC FIRE EXTINGUISHING SYSTEM			
	Underground Piping	10.00	
	Distribution Piping ea. ft.	.01	
	Sprinkler Head each	.10	
	In Range Hood and Vent	5.00	
DRY STANDPIPE SYSTEM			
	Piping	50.00	
	Each Outlet	1.00	
WET STANDPIPE SYSTEM			
	Piping	5.00	
	Fire Hose Cabinet	1.00	
	MINIMUM PERMIT FEE	4.00	
PIPELINE CONTRACTOR; SECT. 14-B.P.F. \$			
TOTAL PERMIT FEE \$			23.00

I hereby certify that I have carefully examined and read the above application; that the same is true and correct; and that the work herein described is to be done in accordance with all the provisions of the applicable Ordinances of the City of Las Vegas, Nevada, and the State Laws, whether herein specified or not.

Signed: L. E. Cannon
REGISTERED MASTER PLUMBER, SPEC. CONTR. OR OWNER

Date: 7-6-77

Building Department: NPN

Date: 7-11-77

#12870

Permit No. 2414

Permit Fee 123.00

RECEIPT

4113 \$023.00 - 7

CITY OF LAS VEGAS

DEPT. OF
BUILDING & SAFETY

MUST BE MACHINE VALIDATED

11-11-77

CITY OF LAS VEGAS, NEVADA

DEPARTMENT OF PUBLIC SERVICES - ELECTRICAL APPLICATION & PERMIT DIVISION OF BUILDING AND SAFETY

ADDRESS OF CONSTRUCTION: 4609 Alysa Way

OWNER'S NAME: DASCO, Inc.

CIRCLE: New Bldg. Add'n.; Remodel;

TYPE OF BLDG.: SFD. APT. PUBLIC COMM.

CONTRACTOR'S NAME: ANDERSON ELECTRIC

STATE LICENSE # 10997

CITY LICENSE # 070-2-00150

NUMBER	FIXTURE OR INSTALLATION	UNIT PRICE	TOTAL
	Rm addition; carport or garage enclosure	4.00	
	Temporary power	4.00	
52	Light, receptacle or switch outlet	.20	10.40
	Wall or ceiling space heater	.35	
1	Garbage grinder outlet	.35	.35
1	Dishwasher outlet	.35	.35
	Clothes dryer outlet	.35	
	Automatic clothes washer	.35	
	Electric range outlet	.35	
	Electric water heater outlet	.35	
	Special purpose outlet	.35	
	X-ray unit and its appurtenances	5.00	
	Watts of festoon lighting (Watts) First 3,000 watts for each additional thousand watts	4.00 1.50	
	Horsepower each motor first horsepower or less for each additional horsepower	1.75 .35	
1	Electric service (including any single meter socket) for each additional socket	3.00 .35	3.00
1	Air conditioning service	1.50	1.50
	Each KW(KVA) Generator (Transformer, Welder) First 100 KVA for each additional KW(KVA)	2.00 .01	
1	Speaker, signal or alarm outlet	1.15	1.15
	Amplifiers	.50	
	Control panels	.25	
	Main control racks	1.00	
	T.V. and radio antennas-master system only	.75	
	Minimum fee for any permit	4.00	
	TOTAL FEE		15.75

Approval the work under this permit will be given only after refuse and debris have been removed from job site and public right of way.

I hereby certify that I have carefully examined and read the above application; that the same is true and correct; and that the work herein described is to be done in accordance with all the provisions of the applicable Ordinances of the City of Las Vegas, Nevada and State laws whether herein specified or not.

SIGNED Anderson MASTER (ELECTRICIAN) (TECHNICIAN) (OWNER) 465

DATE 6/12/77

BUILDING DIVISION: 102

DATE 8-15-77

PERMIT NO.: 3450

PERMIT FEE: 15.75

RECEIPT

\$015.75 - 6

CITY OF LAS VEGAS

DEPT. OF BUILDING & SAFETY
MUST BE MACHINE VALIDATED

CITY OF LAS VEGAS, NEVADA

DEPARTMENT OF BUILDING & SAFETY - AIR CONDITIONING APPLICATION & PERMIT

ADDRESS OF CONSTRUCTION: 609 Alvey Way
Lot: 12 Bldg: 1

OWNER'S NAME: Dasco, Inc.

CIRCLE: Addition; Remodel; New Bldg

TYPE OF BLDG: SFD APT. COMM. PUBLIC

CONTRACTOR'S NAME: Certified Air Cond. Co.

STATE LICENSE # 11191

CITY LICENSE # 11417

UNITS	DESCRIPTION	FEE	TOTAL
	Unit heater - floor, wall or suspended	4.00	
FOR EACH FORCED-AIR OR GRAVITY-TYPE FURNACE OR BURNER INCLUDING DUCTS AND VENT ATTACHED TO SUCH APPLIANCES:			
	Up to and including 100,000 B.t.u.'s	4.00	
	Over 100,000 B.t.u.'s	6.00	
FOR EACH HEATING APPLICATION, REFRIGERATION UNIT, COMFORT COOLING AND HEATING UNIT, ABSORPTION UNIT, COMPRESSOR OR BOILER:			
	Up to and including 3 ton or horsepower, or absorption system up to and including 100,000 B.t.u.'s	4.00	
1	Over 3 ton or 3 horsepower up to and including 10, or absorption system over 100,000 B.t.u.'s up to and including 250,000 B.t.u.'s	7.00	7.00
	Over 10 ton or 10 horsepower up to and including 30, or absorption system over 250,000 B.t.u.'s up to and including 1,000,000 B.t.u.'s	12.00	
	Over 30 ton or 30 horsepower up to and including 50, or absorption system over 1,000,000 B.t.u.'s up to and including 1,700,000 B.t.u.'s	20.00	
	Over 50 ton or 50 horsepower, or absorption system over 1,700,000 B.t.u.'s	30.00	
FOR EACH AIR HANDLING UNIT INCLUDING DUCTS ATTACHED THERETO:			
	Up to and including 10,000 CFM	2.00	
	Over 10,000 CFM	2.00	

UNITS	DESCRIPTION	FEE	TOTAL
EVAPORATIVE COOLERS:			
	5 outlets or under	3.80	
	Over 5 and up to and including 10	5.00	
	Each additional outlet over 10	.25	
VENTILATION:			
	For each fan connected to a single duct	1.00	
	For each commercial or industrial ventilation system	5.00	
	For each commercial kitchen hood	5.00	
MISCELLANEOUS:			
	For each water cooling tower	8.00	
1	Duct work only - each opening	.25	.25
	For installation or relocation of each commercial or industrial incinerator	15.00	
	Gas-piping related to the air cond. work in single family dwelling only	3.00	
	For each appliance, piece of equipment, any mechanical work or alteration or replacement not included in this schedule, the permit fee shall be computed the same as building permit fees by using the cost of installation for the valuation amount.		
FOR THE ISSUANCE OF EACH PERMIT			3.00
TOTAL PERMIT FEES			10.25

I hereby certify that I have carefully examined and read the above application; that the same is true and correct; and that the work herein described is to be done in accordance with all the provisions of the applicable Ordinances of the City of Las Vegas, Nevada and the State Laws, whether herein specified or not.

Approval for the work under this permit will be given only after refuse and debris have been removed from job site and public right of way.

SIGNED

W. Lowe
Air Conditioning Contractor - Owner

Date

8-26-77

BUILDING DEPARTMENT

Date

8-29-77

PERMIT NO.

1146

PERMIT FEE \$

10.25

#12890

RECEIPT

7174 \$010.25 -

CITY OF LAS VEGAS

DEPT. OF BUILDING & SAFETY

MUST BE MACHINE VALIDATED

29-88-11

CITY OF LAS VEGAS, NEVADA

DEPARTMENT OF PUBLIC SERVICES—APPLICATION AND PERMIT FOR PLUMBING DIVISION OF BUILDING AND SAFETY

ADDRESS OF CONSTRUCTION: 4609 Alysc Way OWNER'S NAME: DASCO

CIRCLE: New Bldg.; Add'n.; Remodel; TYPE OF BLDG.: SFD. APT. PUBLIC COMM.

CONTRACTOR'S NAME: Simon Properties, Inc. STATE LICENSE # 13452 CITY LICENSE # C11-776

UNITS	DESCRIPTION	FEE	TOTAL
	Bathtub	1.00	
	Shower	1.00	
	Lavatory	1.00	
	Toilet	1.00	
	Urinal	1.00	
	Floor Drain	1.00	
	Floor Sink	1.00	
	Wash Tray	1.00	
	Sink	1.00	
	Garbage Disposal	1.00	
	Garbage Disposal (comm.)	3.00	
	Clothes Dryer (gas)	1.00	
	Clothes Washer	1.00	
	Clothes Washer (comm.)	5.00	
	Dishwasher	1.00	
	Dishwasher (commercial)	5.00	
	Dental Unit	10.00	
	Drinking Fountain	1.00	
	Any Water using Equipment	1.00	
	Water Heater (gas) (elect.)	1.00	
	Sewer System—New, Replacement, or any Drainage System	4.00	
	Grease or Sand Trap	2.00	
	Trailer Trap	2.00	
	Septic Disposal System	4.00	
WATER SOFTENERS			
	Nonpermanent Type	4.00	
	Permanent Type (connected to Drainage)	5.00	
SWIMMING POOLS			
	Private or Wading Pool	10.00	
	Public or Semi-public	20.00	

UNITS	DESCRIPTION	FEE	TOTAL
WATER DISTRIBUTION SYSTEM			
	Single Family Dwelling	4.00	
	Multiple Family Dwelling plus each unit	4.00 2.00	
	Commercial Bldg. per floor	6.00	
	Hotel or Motel plus each bath	4.00 1.50	
	Trailer Park plus each space	20.00 1.00	
	Irrigation	4.00	4.00
GAS PIPING SYSTEM			
	Single Family Dwelling	3.00	
	Multiple Family Dwelling plus each unit	6.00 1.00	
	Commercial Bldg. per floor plus each unit	3.00 3.00	
	Gas Appliance (any type)	1.00	
AUTOMATIC FIRE EXTINGUISHING SYSTEM			
	Underground Piping	10.00	
	Distribution Piping ea. ft.	.01	
	Sprinkler Head each	.10	
	In Range Hood and Vent	5.00	
DRY STANDPIPE SYSTEM			
	Piping	50.00	
	Each Outlet	1.00	
WET STANDPIPE SYSTEM			
	Piping	5.00	
	Fire Hose Cabinet	1.00	
	MINIMUM PERMIT FEE	4.00	
PIPELINE CONTRACTOR, SECT. 14-B.P.F.S.			
TOTAL PERMIT FEE \$			490

I hereby certify that I have carefully examined and read the above application; that the same is true and correct; and that the work herein described is to be done in accordance with all the provisions of the applicable Ordinances of the City of Las Vegas, Nevada and the State Laws, whether herein specified or not.

Approval for the work under this permit will be given only after refuse and debris have been removed from job site and public right of way.

Signed: [Signature] Date: 12-12-77
Registered Master Plumber, Spec. Contr'r. or Owner

Building Division: 24 Date: 12-13-77

Permit No. 2175-56 Permit Fee \$ 4-

154-01-222

RECEIPT

MUST BE MACHINE VALIDATED

L. Collins 12-19-78

13-02

CITY OF LAS VEGAS, NEVADA

LOG NO. & AREA

DEPARTMENT OF PUBLIC SERVICES
DIVISION OF BUILDING & SAFETY

APPLICATION & BUILDING PERMIT - for:
Fence, Wall, Retaining Wall.

CONST. VAL. \$

351.00

ADDRESS OF
CONSTRUCTION:

4609 ALYSE

OWNER:

D45C0

LOT(S)

12

BLOCK

1

SUBDIVISION

STAGAT Place # 3

ZONE

A-1

Materials of Construction:

Block ☒

Concrete ☒

Wire ☐

Wood ☐

Other ☐

PLANS: ☐

Yes ☐

No ☐

ARCHITECT:

ENGINEER:

CALCS: ☐

Yes ☐

No ☐

CONTRACTOR:

C. E. Davis

STATE

LICENSE #

12381

CITY

LICENSE #

5-11-12927

TOTAL SQUARE FEET:

234


TOTAL LINEAL FEET:

39

Remarks:

CONDITIONS OF THE PERMIT:

1. Any type of retaining wall must be engineered by a Civil or Structural Engineer.
2. If a home owner takes out the Building Permit and if the owner sublets the work to a Contractor, then the Contractor must take out the permit and pay for it.
3. No fence or wall can be built on City property or rights-of-way, but this is not intended to preclude construction within utility easements if utilities will not be damaged or made inaccessible.
4. The fence or wall shall not enclose any water meter, light standard, or fire alarm box and shall not come closer than 24" from the nearest fire hydrant outlet.
5. Department Inspectors must approve footings before concrete is poured and block wall reinforcing before grouting is done.
6. Maximum height of any wall or fence is 6', side and rear yards; 4' maximum in front yard with the vertical surface above the height of 2' - 50% open.
7. I must not obstruct required onsite parking space (2 spaces for each dwelling unit) by the erection of this fence or wall.
8. By the signing of this application I herewith agree to the requirements outlined above.

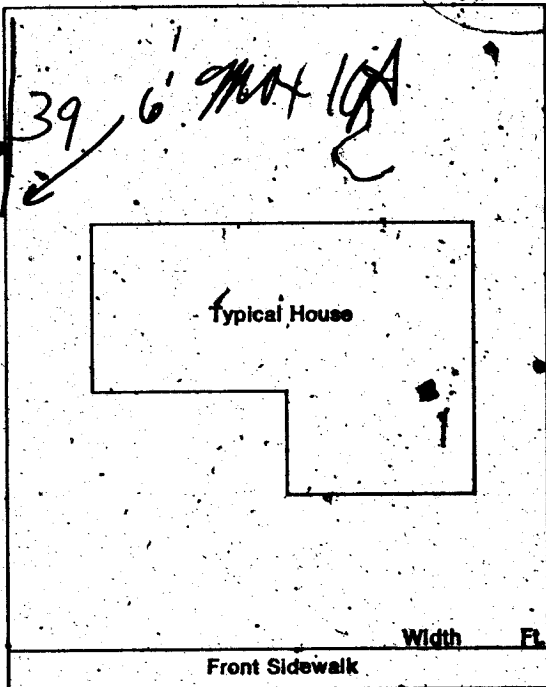

SIGNED:

Charles E. Davis

DATE:

1-11-78

CONTRACTOR ☐

AGENT ☐

OWNER ☐

PLANNING DEPT:

Date:

1-11-78

PUBLIC WORKS DEPT:

Date:

1-11-78

BUILDING DIVISION:

Date:

1-11-78

#12850

PERMIT NO:

2803-5

PERMIT FEE \$

6.00

RECEIPT

MUST BE MACHINE VALIDATED

L. Collins 12-19-78

CITY OF LAS VEGAS, NEVADA

DEPARTMENT OF PUBLIC SERVICES—ELECTRICAL APPLICATION & PERMIT DIVISION OF BUILDING AND SAFETY

ADDRESS OF
CONSTRUCTION:

4609 Alyse Way

OWNER'S
NAME:

Dawey Doolen

CIRCLE: New Bldg. Add'n. Remodel:

TYPE OF BLDG.: SFD. APT. PUBLIC COMM.

CONTRACTOR'S NAME:

Owner

STATE
LICENSE #

CITY
LICENSE #

NUMBER	FIXTURE OR INSTALLATION	UNIT PRICE	TOTAL
	Rm addition, carport or garage enclosure	4.00	
	Temporary power	4.00	
	Light, receptacle or switch outlet	.20	
	Wall or ceiling space heater	.35	
	Garbage grinder outlet	.35	
	Dishwasher outlet	.35	
	Clothes dryer outlet	.35	
	Automatic clothes washer	.35	
	Electric range outlet	.35	
	Electric water heater outlet	.35	
	Special purpose outlet	.35	
	X-ray unit and its appurtenances	5.00	
	Watts of festoon lighting (Watts) First 3,000 watts for each additional thousand watts	4.00 1.50	
	Horsepower each motor first horsepower or less for each additional horsepower	1.75 .35	
	Electric service (including any single meter socket) for each additional socket	3.00 .35	
	Air conditioning service	1.50	
	Each KW(KVA) Generator (Transformer, Welder) First 100 KVA for each additional KW(KVA)	2.00 .01	
	Speaker, signal or alarm outlet	.15	
	Amplifiers	.50	
	Control panels	.25	
	Main control racks	1.00	
	T.V. and radio antennas-master system only	.75	
	Minimum fee for any permit	4.00	
	TOTAL FEE		

Approval for the work under this permit will be given only after refuse
and debris have been removed from job site and public right of way.

I hereby certify that I have carefully examined and read the above application; that the same is true and correct; and that the work herein
described is to be done in accordance with all the provisions of the applicable Ordinances of the City of Las Vegas, Nevada and State laws
whether herein specified or not.

SIGNED

MASTER (ELECTRICIAN) (TECHNICIAN) (OWNER)

DATE

BUILDING DIVISION

DATE

PERMIT NO.

PERMIT FEE

RECEIPT

MUST BE MACHINE VALIDATED

154-01-221

CITY OF LAS VEGAS, NEVADA

LOG NO. & AREA

CONST. VAL. \$

DEPARTMENT OF PUBLIC SERVICES
DIVISION OF BUILDING AND SAFETY

APPLICATION & BUILDING PERMIT - for:
Dwellings, Duplexes, Misc. Residential Const.

ADDRESS OF
CONSTRUCTION:

OWNER:

LOT(s)

BLOCK

SUBDIVISION

ZONE

Existing structure on lot:

Dwelling

Accessory Bldg.

Vacant Lot

Other

PROPOSED CONSTRUCTION:

USE:

MATERIALS OF CONSTRUCTION:

Wood Frame

Concrete Block

Reinforced Concrete

Steel Frame

SQUARE FEET OF FLOOR AREAS:

1st

2nd

3rd

Other

TOTAL SQ. FT.

FIRE ZONE:

Occupancy Group

CONST. TYPE:

ARCHITECT:

ENGINEER:

NO. of UNITS

NO. of STORIES

Plans Submitted:

Yes

No

Calculations Submitted:

Yes

No

Sewer Fee Req'd.

Yes

No

CONTRACTOR:

STATE
LICENSE #

CITY
LICENSE #

ADD'L PERMITS REQ'D:

Air Cond.

Elec.

Plumbing

Signs

Paving

Fence

Public Walks

Curb-gutters

Incinerators

Fire Sprinkling System

CONDITIONS OF THE PERMIT:

- I agree to call the City Building Department for inspections before concrete is poured, before rough wiring, electrical, plumbing, framing is covered. Also for Air conditioning, drywall and sheathing inspection.
- I agree that when the job is completed that I will call for final inspection before occupancy.
- I agree to perform all construction in accordance with City Ordinances and Building Code.
- The Contractor's signature below denotes authority from the owner to sign in his behalf and that the owner is aware of all requirements of this application and permit. Separate permits must be taken out for work outlined above this agreement.
- I have read and understand the contents of this application and permit; I hereby state that the information I have supplied on this application is true and correct.

Approval for the work under this permit will be given only after refuse and debris have been removed from job site and public right of way.

SIGNED:

Contractor


BY:

INANC \$.00
SFD \$ 11.00
ELEC \$ 4.00
STL \$ 15.00
STL \$ 15.00
TOTL \$ 15.00
CASH \$ 15.00

RECEIPT
R#4415 SR#001/01
CITY - LAS VEGAS
BLDG. & SAFETY

03/15/78

MUST BE MACHINE VALIDATED

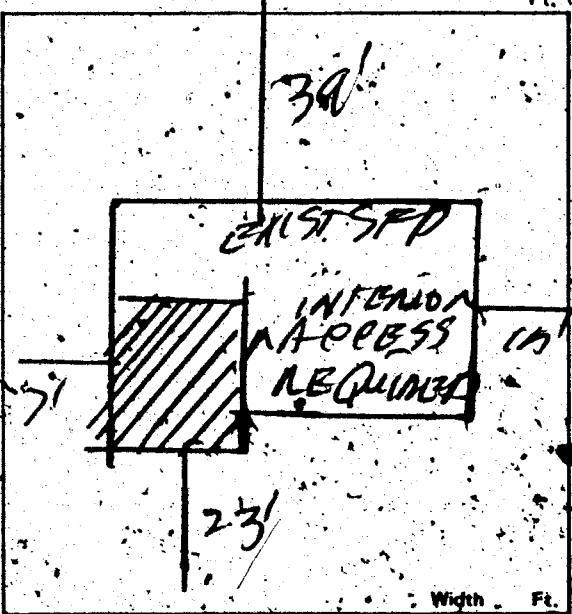

Front property line

PLANNING DEPT:

Date:

PUBLIC WORKS DEPT:

Date:

BUILDING DIVISION:

Date:

PERMIT NO.:

PERMIT FEE \$

154-01-220

These Rifunkos 11-3-80

DIVISION of BUILDING & SAFETY - CITY of LAS VEGAS, NEVADA

OWNER - Dasco Inc. ADDRESS 4609 Alyse Way DATE 6-15-77
GEN. CONT. - Same TYPE OF STRUCTURE SFD
PERMIT NO. 3305 LEGAL DESCRIPTION L 12 B 1 Stewart Place Unit # 3

BUILDING	MECHANICAL	ELECTRICAL
Investigation	Plumbing Cont. Dasco, Inc. Permit No. 2414 Date 7-11-77	Temp. pole cont. Permit No. Date
Location & Footing BW 7-14-77	Heat & Vent. A/C Cont. 1146 Date 8-29-77	Inspection Date
Stem Wall BW 7-26-77	Sewer Cont. Dasco Inc. Permit No. 2119 Date	Electrical Cont. Anderson 3-15-80 8-16-77
Concrete Slab Floor BW 8-8-77	Rough Soil WEP 8-2-77	Fixtures Cont. Permit No. Date
Floor Framing	Rough Water WEP 8-4-77	Slab
Fireplace Footing	Top Out	Rough IB 9-28-77
Chimney Steel	Rough Gas BF 9-26-77	Final Rough
Vert. Steel Reinf.	A/C Rough Duct BF 9-26-77	Final Fixture
Horiz. Steel Reinf.	Ref. Rough Piping	Final Electrical BF 8-12-77
Roof Sheathing	Final Plumbing BF 12-7-77	Temporary Service
Framing RP 10-11-77	Final Gas BF 12-8-77	MISCELLANEOUS
Backing for siding	Final Air Cond BF 12-1-77	Grading & Drainage
Ext. Lath RP 10-15-77	Final Refrig.	On Site Parking Spaces App.
Ext. Scratch BW 9-28-77	Final Sewer WEP 8-4-77	Eng. Approval of
Ext. Brown	Final Septic Tank	Off Site Improvements
Int. Lath		
Int. Brown		
Drywall RP 12-3-77		
Insulation		
Final Building R 8-12-77		
Appr. for Occu.		

INSPECTOR:

DATE

APPROVED FOR OCCUPANCY & METER

PLEASE NOTE REMARKS ON REVERSE SIDE

4609 Alyse Way

LOG #

AREA #

T15-2

76-11-4

Department of Building & Safety
City of Las Vegas, Nevada

Special Kardex
Elec. only, Plbg. only, A.C. only

Owner Dasco Address 4609 Alyse Way Date 12-12-77
Contractor Permit No.
Lot Block Subdivision

Electric Only	Plumbing Only	Heat & Vent. A/C Only
Contractor	Contractor Simor Properties	Contractor
Permit No.	Permit No. 2175-56	Permit No.
Slab	Rough Soil	A/C Rough Duct
Rough Elec.	Rough Water	Ref. Ro. Piping
Final Rough	Top Out	Rough Gas
Final Fixture	Rough Gas	Final Refrig.
Final Elec.	Final Plbg. 5-12-77	Final A/C
Temp. Service	Final Gas	Final Gas
	Final Sewer	
	Final Septic Tank	

23.06D Address 4609 Alyse Way

Log No. Sprinkler

Area

Theresa KYRIAKOS 2-2-81

OWNER DOOLEN DEWEY		ADDRESS 4609 ALYSE WAY	
DATE 3/14/78		GEN. CONT. OWNER	
TYPE OF STRUCTURE ENC. GARAGE		PERMIT NO. 4415	
STEWART PL #3 L-12 B-1		FINAL INSPECTION	
LEGAL DESCRIPTION		LOG # AREA #	
APPROVED FOR OCUPANCY & METER			
BUILDING		MECHANICAL	
Investigation		Plumbing Cont.	
Location & Footing		Permit No. Date	
Concrete Slab Floor		Heat & Vent. A/C Cont.	
Fireplace Footing		Permit No. Date	
Chimney Steel		Sewer Cont.	
Vert. Steel Reinf.		Permit No. Date	
Horiz. Steel Reinf.		Rough Soil	
Framing B.M. 4/6/78		Rough Water	
Ext. Bath		Top Out	
Ext. Brown		Rough Gas	
Drywall V.H. 4/19/78		A/C Rough Duct	
Final Building 1-23-80		Final Plumbing	
Appt. for Occu.		Final Gas	
ELECTRICAL		Final Air Cond.	
Temp. Pole Cont.		Final Sewer	
Permit No. Date		REMARKS	
Inspection Date		FINAL Bldg 1-23-80	
Electrical Cont.		DO NOT REMOVE	
Permit No. Date		PLEASE SEE ADDITIONAL REMARKS ON REVERSE SIDE.	
Rough L.J. 4/6/78		DIV. OF BLDG. & SAFETY	
Final Rough		CITY OF LAS VEGAS	
Final Electrical L.G. 4/19/78		REV 10-78	
Temporary Service		E-WAY SYSTEMS	
		NEWARK OH 43055	
		LITHO IN U.S.A.	

DATE 1/11/78	
ADDRESS 4609 ALYSE	
CONTRACTOR J. F. DAVIS	PERMIT NO. 2803-5
FINAL INSPECTION	SUBDIVISION
BLOCK FENCE	AREA
FENCES (wire, wood, block, & retaining walls)	
Location	
Footing	
Wall Steel	
1st	2nd
Bond Beam	
1st	2nd
Final	1/23/80
Specify Type Of Fence	
DIV. OF BLDG. & SAFETY	
CITY OF LAS VEGAS	
REV 10-78	