6417 Bamboo Place

LOT 33 BLK 11 JADE PARK #3 ZONE RMH

S. Gatewood 1-18-79

715

CITY OF LAS VEGAS, NEVADA

LOG NO. & AREA _____ CONST. VAL. $ 987.—

DEPARTMENT OF PUBLIC SERVICES
DIVISION OF BUILDING & SAFETY

APPLICATION & BUILDING PERMIT — for:
Fence, Wall, Retaining Wall.

ADDRESS OF CONSTRUCTION: 6417 Bamboo Place OWNER: Home Savings

LOT(s) 33 BLOCK 11 SUBDIVISION Jade Park 3 ZONE RMA

Materials of Construction: Block ☒ Concrete ☐ Wire ☐ Wood ☐ Other ☐

	Yes	No
PLANS:	☐	☐
CALCS:	☐	☐

ARCHITECT: _____ ENGINEER: Turegun & Ass.

CONTRACTOR: Anthony & Son Masonary STATE LICENSE # 13917 CITY LICENSE # _____

TOTAL SQUARE FEET: 658 TOTAL LINEAL FEET: 153

Remarks:
48'x6'
45'x5'
20'x4'
20'x3'

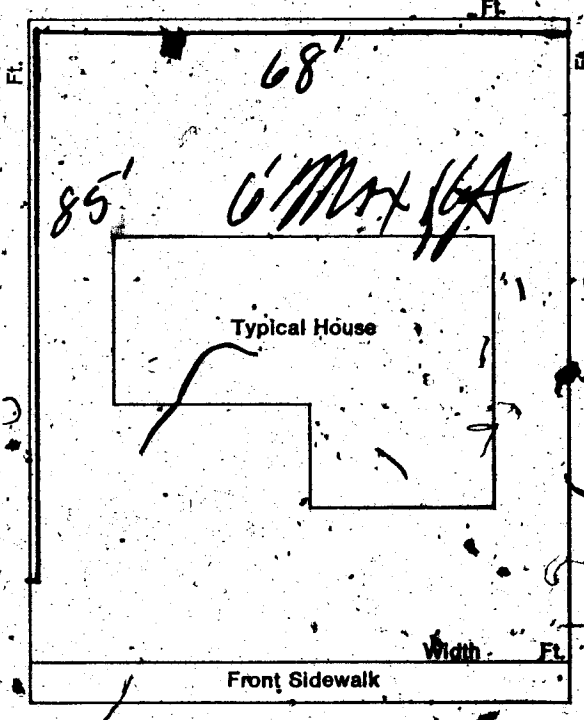

CONDITIONS OF THE PERMIT:

1. Any type of retaining wall must be engineered by a Civil or Structural Engineer.
2. If a home owner takes out the Building Permit and if the owner sublets the work to a Contractor, then the Contractor must take out the permit and pay for it.
3. No fence or wall can be built on City property or rights-of-way, but this is not intended to preclude construction within utility easements if utilities will not be damaged or made inaccessible.
4. The fence or wall shall not enclose any water meter, light standard, or fire alarm box and shall not come closer than 24" from the nearest fire hydrant outlet.
5. Department Inspectors must approve footings before concrete is poured and block wall reinforcing before grouting is done.
6. Maximum height of any wall or fence is 6, side and rear yards; 4' maximum in front yard with the vertical surface above the height of 2' — 50% open.
7. I must not obstruct required onsite parking space (2 spaces for each dwelling unit) by the erection of this fence or wall.
8. By the signing of this application I herewith agree to the requirements outlined above.

SIGNED: _____ DATE: _____
CONTRACTOR ☒ AGENT ☐ OWNER ☐

PLANNING DEPT: _____ Date: 1-6-78

PUBLIC WORKS DEPT: _____ Date: 1/19/78

BUILDING DIVISION: _____ Date: 1-19-78

#12850 PERMIT NO: 3435 PERMIT FEE $ 12.—

RECEIPT

MUST BE MACHINE VALIDATED

S. Gatewood 1-18-79

CITY OF LAS VEGAS, NEVADA

5-11

LOG NO. & AREA T-1 CONST. VAL. $ 2500

DEPARTMENT OF PUBLIC SERVICES
DIVISION OF BUILDING AND SAFETY

APPLICATION & BUILDING PERMIT — for:
Dwellings, Duplexes, Misc. Residential Const.

ADDRESS OF CONSTRUCTION: 6417 Bamboo Place OWNER: HOME SERVICE CORP.

LOT(s) 33 BLOCK 11 SUBDIVISION JADE PARK #3 ZONE RMA

Existing structure on lot: Dwelling ☐ Accessory Bldgs. ☐ Vacant Lot ☒ Other ☐

PROPOSED CONSTRUCTION: MOBILE HOME ESTATES LOT USE: RES

MATERIALS OF CONSTRUCTION: Wood Frame ☐ Concrete Block ☐ Reinforced Concrete ☐ Steel Frame ☐

SQUARE FEET OF FLOOR AREAS: 1st _____ 2nd _____ 3rd _____ Other _____ TOTAL SQ. FT. 0000

FIRE ZONE: _____ Occupancy Group _____ CONST. TYPE: _____

ARCHITECT: _____ ENGINEER: TURNER & ASSOCIATES NO. of UNITS _____ NO. of STORIES _____

Plans Submitted: Yes ☒ No ☐ Calculations Submitted Yes ☐ No ☐ Sewer Fee Req'd. Yes ☒ No ☐

CONTRACTOR: SUN HOME BUILDERS, INC. STATE LICENSE # 6660 CITY LICENSE # C11 444 2 06059

ADD'L. PERMITS REQ'D.: Air Cond. ☐ Elec. ☐ Plumbing ☐ Signs ☐ Paving ☐ Fence ☐ Public Walks ☐ Curb-gutters ☐ Incinerators ☐ Fire Sprinkling System ☐

Ft. / Ft. / Ft. / Width Ft.

G.B.G PLANS

Front property line

CONDITIONS OF THE PERMIT:

1. I agree to call the City Building Department for inspections before concrete is poured, before rough wiring, electrical, plumbing, framing is covered. Also for Air conditioning, drywall and sheathing inspection.
2. I agree that when the job is completed that I will call for final inspection before occupancy.
3. I agree to perform all construction in accordance with City Ordinances and Building Codes.
4. The Contractor's signature below denotes authority from the owner to sign in his behalf and that the owner is aware of all requirements of this application and permit. Separate permits must be taken out for work outlined above this agreement.
5. I have read and understand the contents of this application and permit; I hereby state that the information I have supplied on this application is true and correct.

Approval for the work under this permit will be given only after refuse and debris have been removed from job site and public right of way.

SIGNED: SUN HOME BUILDERS, INC. Contractor

BY: Ray R Bandley Agent or Owner

R. R. Bandley, Executive Vice President

PLANNING DEPT.: [signature] Date: 1-6-78

PUBLIC WORKS DEPT.: Charles Funk Date: 1/11/78

BUILDING DIVISION: [signature] Date: 1-19-78

PERMIT NO.: 304410 PERMIT FEE $ 18.—

154-01-220

RECEIPT

MUST BE MACHINE VALIDATED

G. Gatewood 1-18-79

21-04

CITY OF LAS VEGAS, NEVADA

LOG NO. & AREA _____ CONST. VAL. $ _____

DEPARTMENT OF PUBLIC SERVICES
DIVISION OF BUILDING AND SAFETY

APPLICATION & BUILDING PERMIT.— for:
Dwellings, Duplexes, Misc. Residential Const.

ADDRESS OF CONSTRUCTION: 6417 BAMBOO PLACE OWNER: CHESTER R. GRAY

LOT(s) 33 BLOCK 11 SUBDIVISION JADE PARK #3 ZONE: R-MH

Existing structure on lot: Dwelling ☐ Accessory Bldgs. ☐ Vacant Lot ☒ Other ☐

PROPOSED CONSTRUCTION: Mobile Home USE: _____

MATERIALS OF CONSTRUCTION: Wood Frame ☐ Concrete Block ☐ Reinforced Concrete ☐ Steel Frame ☐

SQUARE FEET OF FLOOR AREAS: 1st _____ 2nd _____ 3rd _____ Other _____ TOTAL SQ. FT. _____

FIRE ZONE: _____ Occupancy Group _____ CONST. TYPE: _____

ARCHITECT: _____ ENGINEER: _____ NO. of UNITS _____ NO. of STORIES _____

Plans Submitted: Yes ☐ No ☐ Calculations Submitted Yes ☐ No ☐ Sewer Fee Req'd. Yes ☐ No ☐

CONTRACTOR: OWNER STATE LICENSE # _____ CITY LICENSE # _____

ADD'L. PERMITS REQ'D.: Air Cond. ☐ Elec. ☐ Plumbing ☐ Signs ☐ Paving ☐ Fence ☐ Public Walks ☐ Curb-gutters ☐
Incinerators ☐ Fire Sprinkling System ☐

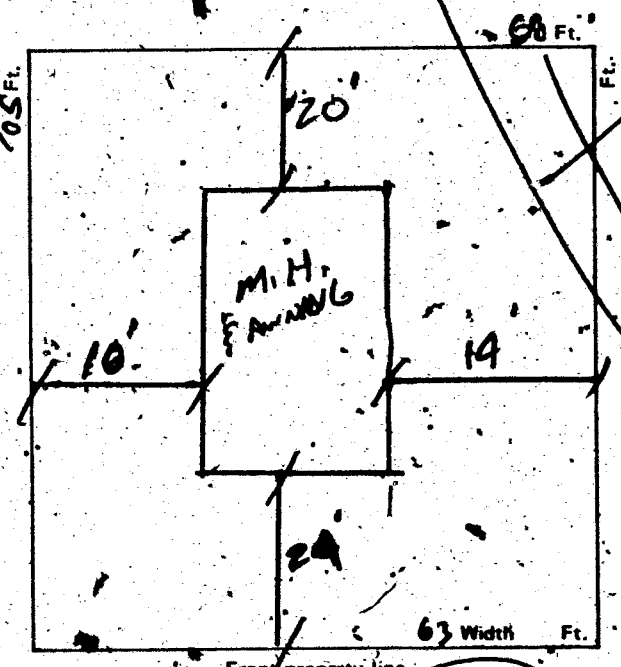

CONDITIONS OF THE PERMIT:

1. I agree to call the City Building Department for inspections before concrete is poured, before rough wiring, electrical, plumbing, framing is covered. Also for Air conditioning, drywall and sheathing inspection.
2. I agree that when the job is completed, I will call for final inspection before occupancy.
3. I agree to perform all construction in accordance with City Ordinances and Building Codes.
4. The Contractor's signature below denotes authority from the owner to sign in his behalf and that the owner is aware of all requirements of this application and permit. Separate permits must be taken out for work outlined above this agreement.
5. I have read and understand the conditions of this approval and permit; I hereby state that the information supplied on this application is true and correct.

UMC $ .00
SFD $ 10.00
PLMB $ 4.00
ELEC $ 4.00
BTL $ 18.00
TOTAL $ 36.00
CHEK $ 18.00
PB0221 SP0001
CITY OF LAS VEGAS
BLDG. & SAFETY
10/17/78

Approval for the work under this permit will be given only after refuse and debris have been removed from and around public right of way.

SIGNED: Chester R Gray Contractor

BY: _____ Agent or Owner

★ SUBJECT TO 3:00 PM CK INSPECTION

★ PLANNING DEPT.: _____ Date: 10/16/78

PUBLIC WORKS DEPT.: _____ Date: 10-16-78

BUILDING DIVISION: B.D. Date: 10-16-78

PERMIT NO.: 10221 PERMIT FEE $ 10.00

154-01-220

RECEIPT

MUST BE MACHINE VALIDATED

S Gatewood : 1-18-79

CITY OF LAS VEGAS, NEVADA

DEPARTMENT OF PUBLIC SERVICES—ELECTRICAL APPLICATION & PERMIT
DIVISION OF BUILDING AND SAFETY

ADDRESS OF CONSTRUCTION: 6417 Bamboo Place OWNER'S NAME: Chester R Gray

CIRCLE: New Bldg. Add'n. Remodel; TYPE OF BLDG.: SFD. APT. PUBLIC COMM.

CONTRACTOR'S NAME: Owner STATE LICENSE # CITY LICENSE #

NUMBER	FIXTURE OR INSTALLATION	UNIT PRICE	TOTAL
	Rm addition, carport or garage enclosure	4.00	
	Temporary power	4.00	
	Light, receptacle or switch outlet	.20	
	Wall or ceiling space heater	.35	
	Garbage grinder outlet	.35	
	Dishwasher outlet	.35	
	Clothes dryer outlet	.35	
	Automatic clothes washer	.35	
	Electric range outlet	.35	
	Electric water heater outlet	.35	
	Special purpose outlet	.35	
	X-ray unit and its appurtenances	5.00	
	Watts of festoon lighting (Watts) First 3,000 watts for each additional thousand watts	4.00 1.50	
	Horsepower-each motor first horsepower or less for each additional horsepower	1.75 .35	
1	Electric service (including any single meter socket) for each additional socket	3.00 .35	3.00
	Air conditioning service	1.50	
	Each KW(KVA) Generator (Transformer, Welder) First 100 KVA for each additional KW(KVA)	2.00 .01	
	Speaker, signal or alarm outlet	.15	
	Amplifiers	.50	
	Control panels	.25	
	Main control racks	1.00	
	T.V. and radio antennas-master system only	.75	
	Minimum fee for any permit	4.00	
	TOTAL FEE		4.00

Approval for the work under this permit will be given only after refuse and debris have been removed from job site and public right of way.

I hereby certify that I have carefully examined and read the above application; that the same is true and correct; and that the work herein described is to be done in accordance with all the provisions of the applicable Ordinances of the City of Las Vegas, Nevada and State laws whether herein specified or not.

SIGNED Chester R Gray DATE
(MASTER ELECTRICIAN) (TECHNICIAN) (OWNER)

BUILDING DIVISION: B.D. DATE 10-16-78

PERMIT NO.: 10221-1 PERMIT FEE:$ 4.00

154-01-221

RECEIPT

MUST BE MACHINE VALIDATED

G. Gatewood 1-18-79

CITY OF LAS VEGAS, NEVADA

DEPARTMENT OF PUBLIC SERVICES—APPLICATION AND PERMIT FOR PLUMBING

DIVISION OF BUILDING AND SAFETY

ADDRESS OF CONSTRUCTION: 6417 Bamboo Place OWNER'S NAME: Chester R. Gray

CIRCLE: New Bldg.; Add'n.; Remodel; TYPE OF BLDG.: SFD. APT. PUBLIC COMM.

CONTRACTOR'S NAME: Owner STATE LICENSE # _____ CITY LICENSE # _____

UNITS	DESCRIPTION	FEE	TOTAL
	Bathtub	1.00	
	Shower	1.00	
	Lavatory	1.00	
	Toilet	1.00	
	Urinal	1.00	
	Floor Drain	1.00	
	Floor Sink	1.00	
	Wash Tray	1.00	
	Sink	1.00	
	Garbage Disposal	1.00	
	Garbage Disposal (comm.)	3.00	
	Clothes Dryer (gas)	1.00	
	Clothes Washer	1.00	
	Clothes Washer (comm.)	5.00	
	Dishwasher	1.00	
	Dishwasher (commercial)	5.00	
	Dental Unit	10.00	
	Drinking Fountain	1.00	
	Any Water using Equipment	1.00	
	Water Heater (gas) (elect.)	1.00	
	Sewer System—New, Replacement, or any Drainage System	4.00	
	Grease or Sand Trap	2.00	
	Trailer Trap	2.00	
	Septic Disposal System	4.00	
	WATER SOFTENERS		
	Nonpermanent Type	4.00	
	Permanent Type (connected to Drainage)	5.00	
	SWIMMING POOLS		
	Private or Wading Pool	10.00	
	Public or Semi-public	20.00	

UNITS	DESCRIPTION	FEE	TOTAL
	WATER DISTRIBUTION SYSTEM		
	Single Family Dwelling	4.00	
	Multiple Family Dwelling plus each unit	4.00 2.00	
	Commercial Bldg. per floor	6.00	
	Hotel or Motel plus each bath	4.00 1.50	
	Trailer Park plus each space	20.00 1.00	
	Irrigation	4.00	
	GAS PIPING SYSTEM		
	Single Family Dwelling	3.00	
	Multiple Family Dwelling plus each unit	6.00 1.00	
	Commercial Bldg. per floor plus each unit	3.00 3.00	
	Gas Appliance (any type)	1.00	
	AUTOMATIC FIRE EXTINGUISHING SYSTEM		
	Underground Piping	10.00	
	Distribution Piping ea. ft.	.01	
	Sprinkler Head each	.10	
	In Range Hood and Vent	5.00	
	DRY STANDPIPE SYSTEM		
	Piping	50.00	
	Each Outlet	1.00	
	WET STANDPIPE SYSTEM		
	Piping	5.00	
	Fire Hose Cabinet	1.00	
	MINIMUM PERMIT FEE	4.00	
	PIPELINE CONTRACTOR; SECT. 14-B.P.F. $		
	TOTAL PERMIT FEE $		Fee

I hereby certify that I have carefully examined and read the above application; that the same is true and correct; and that the work herein described is to be done in accordance with all the provisions of the applicable Ordinances of the City of Las Vegas, Nevada and the State Laws, whether herein specified or not.

Approval for the work under this permit will be given only after refuse and debris have been removed from job site and public right of way.

Signed Chester R. Gray Date: _____
Registered Master Plumber, Spec. Contr. or Owner

Building Division: B.D. Date: 10-16-78

Permit No. 10221-2 Permit Fee $ 4.00

154-01-222

RECEIPT

MUST BE MACHINE VALIDATED

S. Gatewood 1-18-79

CITY OF LAS VEGAS, NEVADA

77-058

LOG NO. & AREA _____ CONST. VAL. $ 600.00

DEPARTMENT OF PUBLIC SERVICES
DIVISION OF BUILDING AND SAFETY

APPLICATION & BUILDING PERMIT — for:
Dwellings, Duplexes, Misc. Residential Const.

ADDRESS OF CONSTRUCTION: 6417 Bonaso Pl. OWNER: Chester R. Gray

LOT(s) 33 BLOCK 11 SUBDIVISION Jade Park #3 ZONE R-1A

Existing structure on lot: Dwelling ☐ Accessory Bldgs. ☐ Vacant Lot ☐ Other ☐

PROPOSED CONSTRUCTION: Storage Shed 10x12 USE: STORAGE

MATERIALS OF CONSTRUCTION: Wood Frame ☒ Concrete Block ☐ Reinforced Concrete ☐ Steel Frame ☐

SQUARE FEET OF FLOOR AREAS: 1st _____ 2nd _____ 3rd _____ Other _____ TOTAL SQ. FT. 120

FIRE ZONE: 1 Occupancy Group _____ CONST. TYPE: _____

ARCHITECT: _____ ENGINEER: _____ NO. of UNITS _____ NO. of STORIES _____

Plans Submitted: Yes ☐ No ☐ Calculations Submitted Yes ☐ No ☐ Sewer Fee Req'd. Yes ☐ No ☐

CONTRACTOR: Owner STATE LICENSE # _____ CITY LICENSE # _____

ADD'L. PERMITS REQ'D.: Air Cond. ☐ Elec. ☐ Plumbing ☐ Signs ☐ Paving ☐ Fence ☐ Public Walks ☐ Curb-gutters ☐ Incinerators ☐ Fire Sprinkling System ☐

BLDG $ 1.00
SFD $ 8.00
WALL $ 6.00
STL $ 14.00
TOTL $ 14.00
CHEK $ 14.00
PAID 12/01/78 SPW001 01
CITY OF LAS VEGAS
BLDG. & SAFETY

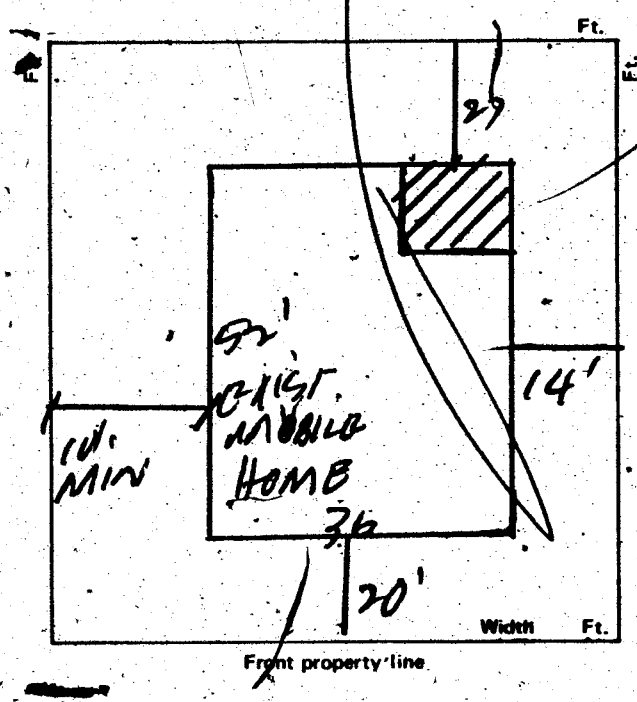

CONDITIONS OF THE PERMIT:

1. I agree to call the City Building Department for inspection before concrete is poured, before rough wiring, electrical, plumbing, trusses is covered. Also for Air conditioning, drywall and sheathing inspection.
2. I agree that when the job is completed that I will call for final inspection before occupancy.
3. I agree to perform all construction in accordance with City Ordinances and Building Codes.
4. The Contractor's signature below denotes authority from the owner to sign in his behalf and that the owner is aware of all requirements of this application and permit. Separate permits must be taken out for work outlined above this agreement.
5. I have read and understand the contents of this application and permit; I hereby state that the information I have supplied on this application is true and correct.

Approval for the work under this permit will be given only after refuse and debris have been removed from job site and public right of way.

SIGNED: _____ Contractor

BY: Chester R Gray Agent or Owner

PLANNING DEPT.: _____ Date: 11-30-78

PUBLIC WORKS DEPT.: _____ Date: 11-30-78

BUILDING DIVISION: M. S. Date: 4/30/78

PERMIT NO.: 11231 PERMIT FEE $ 8.00

154-01-220

RECEIPT

MUST BE MACHINE VALIDATED

S. Gatewood 1-18-79

CITY OF LAS VEGAS, NEVADA

27-09

LOG NO. & AREA

CONST. VAL. $ 323.50

DEPARTMENT OF PUBLIC SERVICES
DIVISION OF BUILDING & SAFETY

APPLICATION & BUILDING PERMIT – for:
Fence, Wall, Retaining Wall

ADDRESS OF CONSTRUCTION: 6417 Bamboo Pl. OWNER: Chester R. Gray

LOT(s) 33 BLOCK 11 SUBDIVISION Jade Park #3 ZONE: RMA

Materials of Construction: Block ☒ Concrete ☐ Wire ☐ Wood ☐ Other ☒ Iron

	Yes	No
PLANS:	☐	☐
CALCS:	☐	☐

ARCHITECT: ENGINEER:

CONTRACTOR: owner STATE LICENSE #: CITY LICENSE #:

TOTAL SQUARE FEET: 249 TOTAL LINEAL FEET: 83'

Remarks:
1' brick iron
3' x 83'

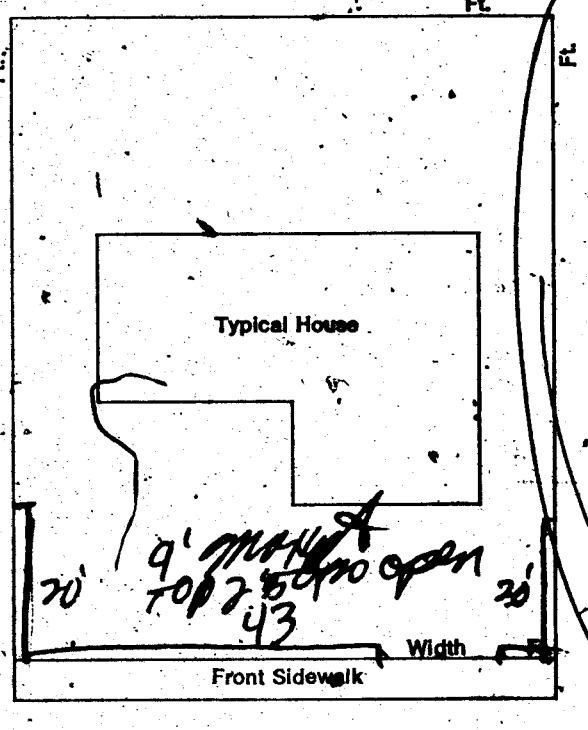

CONDITIONS OF THE PERMIT:

1. Any type of retaining wall must be engineered by a Civil or Structural Engineer.
2. If a home owner takes out the Building Permit and if the owner sublets the work to a Contractor, then the Contractor must take out the permit and pay for it.
3. No fence or wall can be built on City property or rights-of-way, but this is not intended to preclude construction within utility easements if utilities will not be damaged or made inaccessible.
4. The fence or wall shall not enclose any water meter, light standard, or fire alarm box and shall not come closer than 24" from the nearest fire hydrant outlet.
5. Department Inspectors must approve footings before concrete is poured and block wall reinforcing before grouting is done.
6. Maximum height of any wall or fence is 6', side and rear yards; 4' maximum in front yard with the vertical surface above the height of 2' — 50% open.
7. I must not obstruct required onsite parking space (2 spaces for each dwelling unit) by the erection of this fence or wall.
8. By the signing of this application I herewith agree to the requirements outlined above.

SIGNED: Chester R Gray DATE:

CONTRACTOR ☐ AGENT ☐ OWNER ☒

PLANNING DEPT: N/A Date: 11-30-78

PUBLIC WORKS DEPT: 886 Date: 11-30-78

BUILDING DIVISION: M-S Date: 4/30/79

#12850 PERMIT NO: 11231-1 PERMIT FEE $ 6.00

RECEIPT

MUST BE MACHINE VALIDATED

Lot Tenon

DIVISION of BUILDING & SAFETY – CITY of LAS VEGAS, NEVADA

OWNER Chester R Gray ADDRESS 6417 Bamboo Place DATE 10-16-78

GEN. CONT. Owner TYPE OF STRUCTURE Mobile Home

PERMIT NO. 10221 LEGAL DESCRIPTION L-33 B-11 Jade Park #3

BUILDING		MECHANICAL		ELECTRICAL	
Investigation		Plumbing Cont. Owner		Temp. pole cont.	
Location & Footing		Permit No. 10221-2	Date 10-16-78	Permit No.	Date
Stem Wall		Heat & Vent. A/C Cont.		Inspection	Date
Concrete Slab Floor		Permit No.	Date	Electrical Cont. Owner	
Floor Framing		Sewer Cont.		Permit No. 10221-1	Date 10-16-78
Fireplace Footing		Permit No.	Date	Fixtures Cont.	
Chimney Steel		Rough Soil		Permit No.	Date
Vert. Steel Reinf.		Rough Water		Slab	
Horiz. Steel Reinf.		Top-Out		Rough	
Roof Sheathing		Rough Gas		Final Rough	
Framing		A/C Rough Duct		Final Fixture	
Backing for siding		Ref. Rough Piping		Final Electrical	
Ext. Lath		Final Plumbing			
Ext. Scratch		Final Gas		Temporary Service	
Ext. Brown		Final Air Cond.		**MISCELLANEOUS**	
Int. Lath		Final Refrig.			
Int. Brown		Final Sewer		Grading & Drainage	
Drywall		Final Septic Tank		On-Site Parking Spaces	App.
Insulation				Eng. Approval of	
Final Building 12-6-78				Off Site Improvements	
Appr. for Occu.					

INSPECTOR DATE

APPROVED FOR OCCUPANCY & METER

PLEASE NOTE REMARKS ON REVERSE SIDE 6417 Baboo Place LOG # AREA # 76-11-4

DEPARTMENT OF BUILDING & SAFETY
CITY OF LAS VEGAS, NEVADA

KARDEX CARD
FENCE & RETAINING WALLS

OWNER Home Savings ADDRESS 6417 Bamboo Place, DATE 1-20-78

CONTRACTOR Anthony & Son Masonry PERMIT NO. 3135-9

LOT BLOCK SUBDIVISION block fence

Fence (wire, wood, etc.)	Walls (masonry, rock, etc.)
Location SC 1-25-78	Location RP 1-10-78
Final Inspection	Footing RP 1-10-78
	Wall Steel 1st 2d 3d
	Final Inspection SC 1-25-78

Retaining Wall (masonry)	Retaining Wall (concrete)
Location	Location
Footing	Footing
Wall Steel 1st 2d 3d	Wall Steel 1st 2d 3d
Bond Beam 1st 2d 3d	Final Inspection
Final Inspection	

23.14 B ADDRESS 6417 Bamboo Place LOG NO. AREA

Circle Tucson

DIVISION of BUILDING & SAFETY — CITY of LAS VEGAS, NEVADA

OWNER Home Service Corp ADDRESS 6417 Bamboo Place DATE 1-23-78

GEN. CONT. Sun Home Builders TYPE OF STRUCTURE Mobile Home Estates

PERMIT NO. 3044-10 LEGAL DESCRIPTION L 33 B 11 Jade Park

BUILDING		MECHANICAL		ELECTRICAL	
Investigation		Plumbing Cont.		Temp. pole cont.	
Location & Footing		Permit No.	Date	Permit No.	Date
Stem Wall		Heat & Vent. A/C Cont.		Inspection	Date
Concrete Slab Floor		Permit No.	Date	Electrical Cont.	
Floor Framing		Sewer Cont. Sun Home Builders		Permit No.	Date
Fireplace Footing		Permit No. 3043	Date	Fixtures Cont.	
Chimney Steel		Rough Soil		Permit No.	Date
Vert. Steel Reinf.		Rough Water		Slab	
Horiz. Steel Reinf.		Top-Out		Rough	
Roof Sheathing		Rough Gas		Final Rough	
Framing		A/C Rough Duct		Final Fixture	
Backing for siding		Ref. Rough Piping		Final Electrical	
Ext. Lath		Final Plumbing BMG 2-2-78		Temporary Service	
Ext. Scratch.		Final Gas		MISCELLANEOUS	
Ext. Brown		Final Air Cond.			
Int. Lath		Final Refrig.		Grading & Drainage	
Int. Brown		Final Sewer		On-Site Parking Spaces	App.
Drywall		Final Septic Tank		Eng. Approval of	
Insulation				Off-Site Improvements	
Final Building					
Appr. for Occu.					

INSPECTOR: E Clark DATE 7-11-79

APPROVED FOR OCCUPANCY & METER

PLEASE NOTE REMARKS ON REVERSE SIDE 6417 Bamboo Place LOG # AREA # T1-3 76 11-4

Therese Kyriakos 2-4-81

FENCE & RETAINING WALLS

OWNER Chester R. Gray DATE 11-30-78

ADDRESS 6417 Bamboo Place

CONTRACTER	PERMIT NO.	FINAL INSPECTION
Owner	11231-1	

LOT	BLOCK	SUBDIVISION
33	11	Jade Park #3

LOG # AREA

FENCES (wire, wood, block, & retaining walls)

1	Location	
2	Footing	
3	Wall Steel	1st / 2nd
4	Bond Beam	1st / 2nd
5	Final 1-31-80 V.H.	

Specify Type Of Fence

2-1-33 DIV OF BLDG & SAFETY CITY OF LAS VEGAS REV 10-78

OWNER Chester R. Gray ADDRESS 6417 Bamboo Pl

DATE 11-30-78 GEN. CONT. Owner

TYPE OF STRUCTURE Storage Shed PERMIT NO. 11231 FINAL INSPECTION

LEGAL DESCRIPTION L-33 B-11 Jade Park #3 LOG # AREA #

APPROVED FOR OCUPANCY & METER

BUILDING	MECHANICAL
Investigation	Plumbing Cont.
Location & Footing	Permit No. Date
Concrete Slab Floor	Heat & Vent. A/C Cont.
Fireplace Footing	Permit No. Date
Chimney Steel	Sewer Cont.
Vert. Steel Reinf.	Permit No. Date
Horiz. Steel Reinf.	Rough Soil
Framing	Rough Water
Ext. Lath	Top-Out
Ext. Brown	Rough Gas
Drywall	A/C Rough Duct
Final Building 1-31-80 V.H.	Final Plumbing
Appr. for Occu.	Final Gas
ELECTRICAL	Final Air Cond.
Temp. Pole Cont.	Final Sewer
Permit No. Date	**REMARKS**
Inspection Date	
Electrical Cont.	
Permit No. Date	
Rough	PLEASE NOTE ADDITIONAL REMARKS ON REVERSE SIDE.
Final Rough	DIV OF BLDG & SAFETY CITY OF LAS VEGAS REV 10-78
Final Electrical	2-1-31 E-Z-WAY SYSTEMS © NEWARK OH 43055 LITHO IN U.S.A.
Temporary Service	