

816 Alhambra

Lot 9 Blk 3 Town & Country ESt

Heers KYRIAKOS NO 24-80

DEPT. of BLDG & SAFETY—CITY of LAS VEGAS, NEVADA

OWNER Frank Deaton ADDRESS 816 Alhambra DATE 12-9-63
GEN CONT Same TYPE OF STRUCTURE blk fence
PERMIT NO. 22868 LEGAL DESCRIPTION Lot 9 Blk 3 Town & Country Est

BUILDING		MECHANICAL		ELECTRICAL	
LOCATION		PLUMBING CONT.		TEMP POLE CONT.	
FIREPLACE FTG		PERMIT NO.	DATE	PERMIT NO.	DATE
FOOTINGS		HEAT & VENT. CONT.		INSPECTION	DATE
FOUNDATION WALL		PERMIT NO.	DATE	ELECTRICAL CONT.	
FLOOR FRAMING		SEWER CONT.		PERMIT NO.	DATE
SLAB		PERMIT NO.	DATE	FIXTURES CONT.	
CHIMNEY STEEL (FIREPLACE)		ROUGH SOIL		PERMIT NO.	DATE
WALL STEEL		ROUGH WATER		SLAB	
COLUMN STEEL		TOP-OUT		ROUGH	
BEAM STEEL		ROUGH GAS		FINAL ROUGH	
FRAMING		AC ROUGH DUCT		FINAL FIXTURE	
ROOF SHEATHING		REF ROUGH PIPING		FINAL ELECTRICAL	
INTERIOR		FINAL PLUMBING		TEMPORARY SERVICE	
DRYWALL		FINAL GAS			
LATHING		FINAL AIR COND.			
BACKING (SIDING)		FINAL REFRIG.			
PLASTER		FINAL SEWER			
SCRATCH		FINAL SEPTIC TANK			
BROWN					
URBAN REDEVELOPMENT APPROVAL					
FINAL BLDG	<u>ALC</u>				
DATE	<u>6-4-69</u>				

APPROVED FOR OCCUPANCY & METER

INSPECTOR

DATE

PLEASE NOTE REMARKS ON REVERSE SIDE

816 Alhambra

LOG #

AREA #

23.04

DEPT. of BLDG & SAFETY—CITY of LAS VEGAS, NEVADA

OWNER Heers Bros ADDRESS 816 Alhambra DATE 1-1-62
GEN CONT Same TYPE OF STRUCTURE S. F. Dwel & Garage
PERMIT NO. 11610 LEGAL DESCRIPTION Lot 9 Blk 3 Town & Country Estates

BUILDING		MECHANICAL		ELECTRICAL	
LOCATION		PLUMBING CONT.		TEMP POLE CONT.	
FIREPLACE FTG		PERMIT NO.	DATE	PERMIT NO.	DATE
FOOTINGS		HEAT & VENT. AC CONT.		INSPECTION	DATE
FOUNDATION WALL		PERMIT NO.	DATE	ELECTRICAL CONT.	
FLOOR FRAMING		SEWER CONT.		PERMIT NO.	DATE
SLAB		PERMIT NO.	DATE	FIXTURES CONT.	
CHIMNEY STEEL (FIREPLACE)		ROUGH SOIL		PERMIT NO.	DATE
WALL STEEL		ROUGH WATER		SLAB	
COLUMN STEEL		TOP-OUT		ROUGH	
BEAM STEEL		ROUGH GAS		FINAL ROUGH	
FRAMING		AC ROUGH DUCT		FINAL FIXTURE	
ROOF SHEATHING		REF ROUGH PIPING		FINAL ELECTRICAL	
INTERIOR		FINAL PLUMBING		TEMPORARY SERVICE	
DRYWALL		FINAL GAS			
LATHING		FINAL AIR COND.			
BACKING (SIDING)		FINAL REFRIG.			
PLASTER		FINAL SEWER			
SCRATCH		FINAL SEPTIC TANK			
BROWN					
URBAN REDEVELOPMENT APPROVAL					
FINAL BLDG	<u>17</u>				
DATE	<u>2-29-63</u>				

APPROVED FOR OCCUPANCY & METER

INSPECTOR

DATE

PLEASE NOTE REMARKS ON REVERSE SIDE

816 Alhambra

LOG #

AREA #


23.04

T-74

1

CITY OF LAS VEGAS, NEVADA
Department of Building and Safety

CERTIFICATE OF INSPECTION

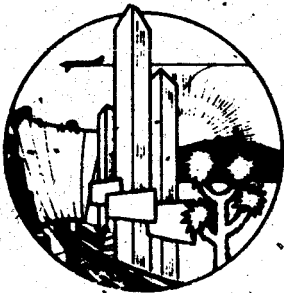

Address 816 AlHambra

Owner _____

Legal _____

Date May 13, 1986

This certificate issued pursuant to the requirements of Section 306 of the
UNIFORM BUILDING CODE certifying that at the time of this issuance
the improvements on this property were in compliance with CITY OF LAS
VEGAS, HOUSING, BUILDING, ELECTRICAL, PLUMBING and MECH-
ANICAL CODES

DIRECTOR
Department of Building & Safety

Joseph A. Silvestri

This Certificate does not include conditions subject to normal maintenance.

No. 090772

Fee \$ 25.00

RECEIPT

Must be machine validated

12850

JACKIE B

5/19/86

MAYOR BILL BRIARE
COUNCILMEN
RON LURIE
PAUL J. CHRISTENSEN
AL LEVY
BOB NOLEN
CITY ATTORNEY
GEORGE F. OGILVIE
CITY MANAGER
ASHLEY HALL



CITY of LAS VEGAS

BUILDING INSPECTION REPORT OF REQUIREMENTS FOR COMPLIANCE WITH CITY OF LAS VEGAS' BUILDING CODES AND ZONING ORDINANCE:

ADDRESS 816 ALHAMBRA

OWNER _____

DATE 5-13-86

PERMITS REQUIRED

BLDG. NONE

ELEC. "

PLBG. "

A.C. "

CORRECTIONS TO BE MADE

BLDG. NONE

ELEC. "

PLBG. "


A.C. "

MISC. "

REMARKS _____

INSPECTOR Ren J. [Signature]

#60

 

CERTIFICATE OF INSPECTION

APPROVED ☒ DATE 5-13-86

DISAPPROVED ☐ DATE _____

(Call for reinspection
at 386-6251)



CITY OF LAS VEGAS, NEVADA

LOG NO. & AREA _____ DATE 05-0-233-009 CONST. VAL. \$ 3528.00

DEPARTMENT OF BUILDING AND SAFETY PHONE 386-6251

ADDRESS OF CONSTRUCTION 816 Alhambra Dr. OWNER Donna J. Kiepper PHONE NO. 732-7006

LOT(S) 9 BLOCK 3 SUBDIVISION THAN & COUNTRY EAT ZONE R-1

PROPOSED CONSTRUCTION Patio Cover USE _____

THIS PERMIT FOR 9152 BLDG. ☐ A/C ☐ ELEC. ☐ PLBG. ☐ OTHER PERMITS RECD.: FENCE ☐ OFF SITE ☐ SWIM POOL ☐

FLOOR AREA BSM ☐ 1ST ☐ 2ND ☐ GARAGE ☐ PORCH 504 TOTAL 504

CONTRACTOR owner STATE LICENSE NO. _____ CITY LICENSE NO. _____

ARCHITECT _____ ENGINEER _____

MASTER PLUMBER/CONTRACTOR _____ MASTER ELECTRICIAN/CONTRACTOR _____

OTHER INSPECTIONS AND FEES

1. Inspections outside of normal business hours = \$30.00 per hour (minimum charge three hours).
2. Re-inspect in fee during normal business hours assessed under provisions of TABLE 3-A of the Uniform Building Code = \$30.00 per hour.
3. Inspections during normal business hours for which no fee is specifically indicated = \$30.00 per hour (minimum charge one-half hour).
4. Additional plan review required by changes, additions or revisions to approved plans = \$30.00 per hour (minimum charge two hours).

CONDITIONS OF THE PERMIT:


1. I agree to call the City Building Department for inspections before concrete is poured, before rough wiring, electrical, plumbing, framing is covered. Also for air conditioning, drywall and sheathing inspection.
2. I agree that when the job is completed that I will call for final inspection before occupancy.
3. I agree to perform all construction in accordance with City Ordinances and Building Codes.
4. The Contractor's signature below denotes authority from the owner to sign in his behalf and that the owner is aware of all requirements of this application and permit. Separate permits must be taken out for work outlined above this agreement.
5. I have read and understand the contents of this application and permit. I hereby state that the information I have supplied on this application is true and correct.
6. Approval for the work under this permit will be given only after refuse and debris have been removed from job site and public right of way.
7. 24 HOUR MINIMUM NOTICE REQUIRED FOR INSPECTIONS.

BY: Donna Kiepper OWNER

I HEREBY DECLARE THAT I AM THE LEGAL OWNER OF THE ABOVE PROPERTY.

BY: _____ AGENT

I hereby certify that I have reviewed this application and the proposed plans and have found that the proposed development meets the requirements of the City of Las Vegas Flood Hazard Reduction Ordinance for the issuance of this Development Permit.

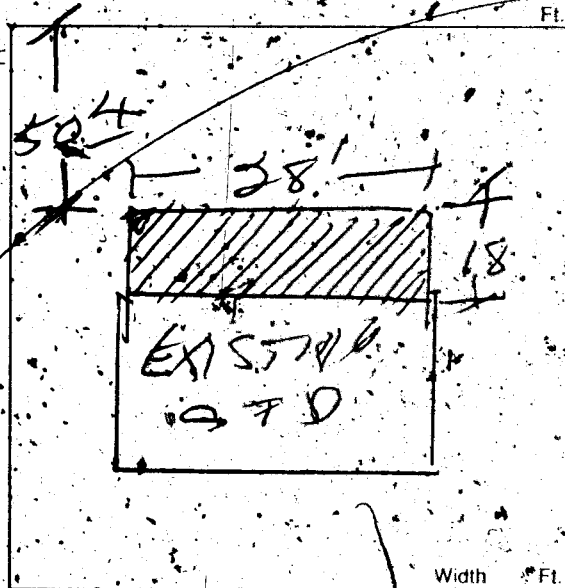

FOR INSPECTIONS
CALL 799-2071

CITY DEVELOPMENT AND FLOOD CONTROL ENGINEER

DATE

PLANNING DEPT.

DATE

BUILDING DEPT.

DATE

PLUMBING		FEE	ELECTRICAL		FEE
WATER DISTRIBUTION	6.00		RECEPTACLE _____ SWITCH _____		.40
SEWER SYSTEM - NEW OR MODIFICATION	10.00		EACH LIGHT FIXTURE OR SOCKET		.30
FIXTURES - WATER SOFTENER, H.W. HEATER	2.00		SPECIAL OUTLET, APPLIANCE ETC.		.70
GARBAGE DISPOSAL - WASHER	2.00		SERVICE/PANEL - SUB/3.00 - 200A/6.00 - 400A/12.50		
FUEL PIPING	6.00		A.C. UNIT OR MOTORS		3.00
IRRIGATION SYSTEM	8.00		2310 - 2402	TOTAL	
MISC.			MISC.		
2310 - 2403	TOTAL		2310 - 2401 ISSUANCE FEE		
AIR CONDITIONING		FEE	7114 - 3654 SEWER CONNECTION		
NEW UNIT - 3 TON = 9.00 OVER = 16.50			2310 - 2401 PLAN REVIEW FEE		
FURNACE TO 100,000/9.00 OVER/11.00			2310 - 2401 BLDG. PERMIT FEE		<u>53.40</u>
VAPORATIVE COOLER	6.50		TOTAL FEES		<u>53.40</u>
VENTILATION FAN	2.35				
2310 - 2405	TOTAL				

RECEIVED 003**

SFD 53.40
CHK 53.40
9132A000 12:55

PERMIT NO. _____
MUST BE MACHINE VALIDATED

Permit Expires 180 Days After Abandonment of Work

Debbie Ingham 3-29-87

OWNER	Donna Kiepper	ADDRESS	816 Alhambra Dr.
DATE	6-17-87	GEN. CONT.	owner
BUILD. TYPE	patio cover	PERMIT No.	9132
LEGAL	SEE APPLICATION	LOG No.	
BUILDING		MICCHANICAL	
Pt. Loc. & Ft. ☐		Plumbing Cont.	
Location & Footing ☐		Permit No.	Date
Stemwall ☐		A/C Cont.	
Concrete Slab Floor ☐		Permit No.	Date
Chimney Steel ☐		Sewer Fee	
Hearthplace Footing ☐		Irrig. Cont.	
Vert. Steel Reinf. ☐		Permit No.	Date
Horiz. Steel Reinf. ☐		Hood Cont.	
Roof Sheathing		Permit No.	Date
Insulation		Rough Soil ☐	
Framing		Rough Water ☐	
Ext. Lath		Tap-Out	
Ext. Scratch		Rough Gas	
Ext. Brower		A/C Rough Duct.	
Drywall		Final Plumbing	
Final Building <i>6/27/88</i>		Final Gas	
Appr. for Occu. Final Building		Final Air Cond.	
		Final Sewer	
ELECTRICAL		ELECTRICAL	
Electrical Cont.		Rough Hood ☐	
Permit No.	Date	Final Hood ☐	
PT Rough		Final Irrig.	
Ground Electrode		ELECTRICAL	
Temporary Power		Temp. Pole Cont.	
Meter Tag		Permit No.	Date
Final Electrical		Inspection	Date