

328 ALEXANDER AVE.

LOT 26 BLK ! KASPER PARK #1 R-1 ZONE SFD

Dickinson 12-5-78

CITY OF LAS VEGAS, NEVADA

LOG NO. & AREA

CONST. VAL. \$ 234.00

DEPARTMENT OF BUILDING & SAFETY

APPLICATION & BUILDING PERMIT — for:
Fence, Wall, Retaining Wall.

ADDRESS OF CONSTRUCTION: 328 Alexander Ave

OWNER: U. Charles Noble

LOT(s) 26 BLOCK 1 SUBDIVISION

Kasper Pk. #1

ZONE: R-1

Materials of Construction: Block ☒ Concrete ☐ Wire ☒ Wood ☐ Other ☐

Yes No
PLANS: ☐ ☐
CALCS: ☐ ☐

ARCHITECT:

ENGINEER:

CONTRACTOR: Self

STATE
LICENSE #

CITY
LICENSE #


TOTAL SQUARE FEET:

TOTAL LINEAL FEET: 117'

Remarks:

CONDITIONS OF THE PERMIT:

1. Any type of retaining wall must be engineered by a Civil or Structural Engineer.
2. If a home owner takes out the Building Permit and if the owner sublets the work to a Contractor, then the Contractor must take out the permit and pay for it.
3. No fence or wall can be built on City property or rights-of-way, but this is not intended to preclude construction within utility easements if utilities will not be damaged or made inaccessible.
4. The fence or wall shall not enclose any water meter, light standard, or fire alarm box and shall not come closer than 24" from the nearest fire hydrant outlet.
5. Department Inspectors must approve footings before concrete is poured and block wall reinforcing before grouting is done.
6. Maximum height of any wall or fence is 6', side and rear yards; 4' maximum in front yard with the vertical surface above the height of 2' — 50% open and further that fencing within 25' of the intersection of curb face on corner and through lots is limited to a maximum height of 30".
7. I must not obstruct required onsite parking space (1 space for each dwelling unit) by the erection of this fence or wall.
8. By the signing of this application I herewith agree to the requirements outlined above.

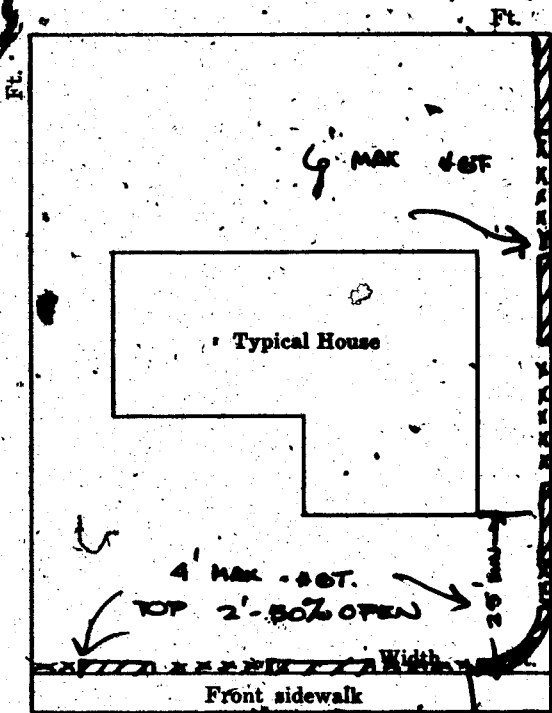

30" MAX HGT.
25' FROM INTERSE. OF CURB FACES

SIGNED:

Check Date: _____

CONTRACTOR ☐ AGENT ☐ OWNER ☐

PLANNING DEPT:

Date: 4-15-68

ENGINEERING DEPT:

Date:

BUILDING DEPT:

J. Wenzl

Date: 4-15-68

#1285

PERMIT NO:

41324

PERMIT FEE \$

400

RECEIPT

2013 \$800.00 - 8

CITY OF LAS VEGAS

DEPT. OF
BUILDING & SAFETY

MUST BE MACHINE VALIDATED

1-5-68

Dicky Jones 12-5-78

1968
CITY OF LAS VEGAS, NEVADA

LOG NO. AREA _____ CONST. VAL. \$ 100.

DEPARTMENT OF BUILDING & SAFETY, APPLICATION & BUILDING PERMIT — for:
Fence, Wall, Retaining Wall.

ADDRESS OF CONSTRUCTION: 328 Alexander Ave OWNER: V. Charles Noble

LOT(s) 26 BLOCK 1 SUBDIVISION Kosper Pk. #1 ZONE: B-1

Materials of Construction: Block ☒ Concrete ☐ Wire ☐ Wood ☐ Other ☐ Yes No
PLANS: ☐ ☐

ARCHITECT: _____ ENGINEER: _____ CALCS: ☐ ☐


CONTRACTOR: Self STATE LICENSE # _____ CITY LICENSE # _____

TOTAL SQUARE FEET: _____ TOTAL LINEAL FEET: 52

Remarks:

CONDITIONS OF THE PERMIT:

1. Any type of retaining wall must be engineered by a Civil or Structural Engineer.
2. If a home owner takes out the Building Permit and if the owner sublets the work to a Contractor, then the Contractor must take out the permit and pay for it.
3. No fence or wall can be built on City property or rights-of-way, but this is not intended to preclude construction within utility easements if utilities will not be damaged or made inaccessible.
4. The fence or wall shall not enclose any water meter, light standard, or fire alarm box and shall not come closer than 24" from the nearest fire hydrant outlet.
5. Department Inspectors must approve footings before concrete is poured and block wall reinforcing before grouting is done.
6. Maximum height of any wall or fence is 6', side and rear yards; 4' maximum in front yard with the vertical surface above the height of 2' — 50% open and further that fencing within 25' of the intersection of curb faces on corner and through lots is limited to a maximum height of 30".
7. I must not obstruct required onsite parking space (1 space for each dwelling unit) by the erection of this fence or wall.
8. By the signing of this application I herewith agree to the requirements outlined above.

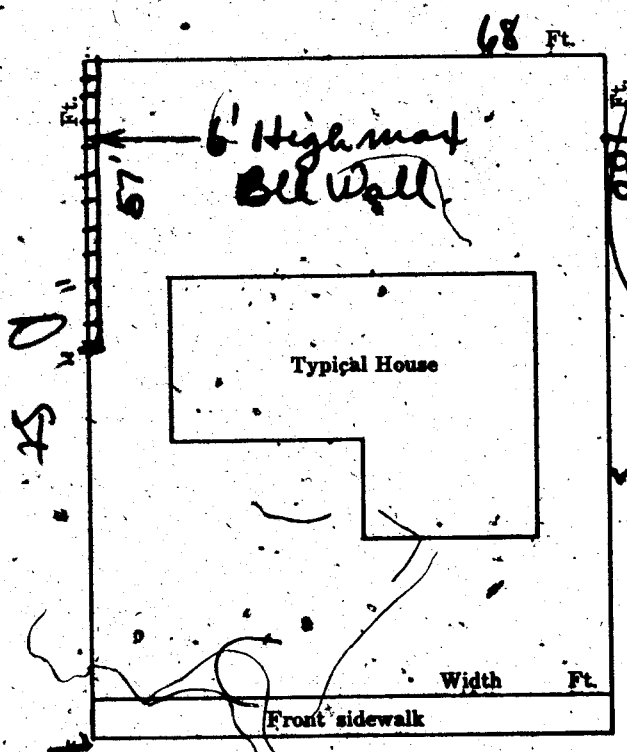

328 Alexander

SIGNED: V. Charles Noble DATE: 5-31-68
CONTRACTOR ☐ AGENT ☐ OWNER ☒

PLANNING DEPT: DLB Date: 5-31-68
ENGINEERING DEPT: _____ Date: _____
BUILDING DEPT: H. T. Eller Date: 5-31-68
PERMIT NO: 42077 PERMIT FEE: 3.00

RECEIPT
\$1005.00 - 8
CITY OF LAS VEGAS
DEPT. OF
BUILDING & SAFETY
MUST BE MACHINE VALIDATED
- 3 JUN 68

2144 Jones 12-5-78

CITY OF LAS VEGAS, NEVADA

LOG NO. & AREA

DEPARTMENT OF BUILDING & SAFETY

CONST. VAL. \$

2780.00

APPLICATION & BUILDING PERMIT - for
Dwelling, Duplexes, Mkt. Residential Const.

ADDRESS OF CONSTRUCTION: 328 Alexander Ave

OWNER:

Charles Noble

LOT(s) 26 BLOCK 1 SUBDIVISION Kasper Pk. #1 ZONE: R-1

Existing structure on lot: Dwelling ☒ Accessory bldg. ☐ Vacant lot ☐ Other ☐

PROPOSED CONSTRUCTION: Basement

USE: Storage for S.F.R.

MATERIALS OF CONSTRUCTION: Wood Frame ☐ Concrete Block ☒ Reinforced Concrete ☒ Steel Frame ☐

SQUARE FEET OF FLOOR AREAS: 1st 360 2nd 3rd Other TOTAL SQ. FT. 1360


FIRE ZONE: 1 2 3 Occupancy Group A B C D E F G H I J-1-2-3-4-5 CONST. TYPE: I II III IV V

ARCHITECT: ENGINEER: NO. of UNITS NO. of STORIES

Plans Submitted: Yes ☒ No ☐ Calculations Submitted: Yes ☐ No ☐ Sewer Fee Req'd: Yes ☐ No ☐

CONTRACTOR: Owner STATE LICENSE # CITY LICENSE #

ADD'L. PERMITS REQ'D: Air Cond. ☐ Elec. ☒ Plumbing ☐ Signs ☐ Paving ☐ Fence ☐ Public Walks ☐ Curb-gutters ☐
Incinerators ☐ Fire Sprinkling System ☐

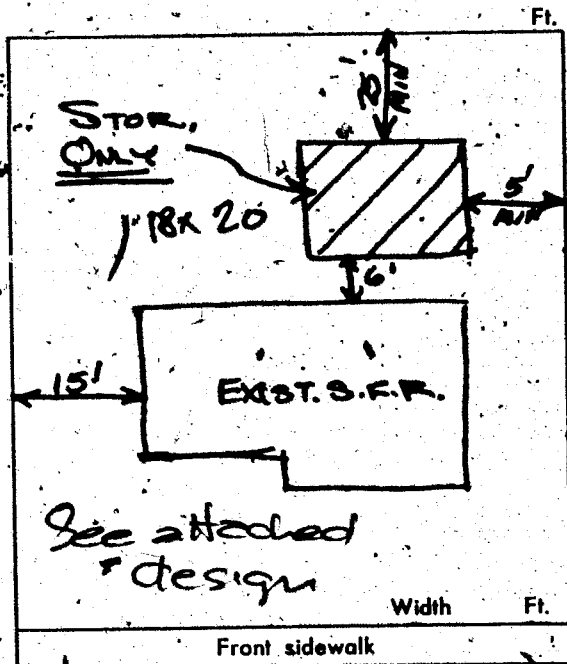

CONDITIONS OF THE PERMIT:

- I agree to call the City Building Department for inspections before concrete is poured, before rough wiring, electrical, plumbing, framing is covered. Also for Air conditioning, sheet-rock and sheathing inspection.
- I agree that when the job is completed that I will call for final inspection before occupancy.
- I agree to perform all construction in accordance with City Ordinances and Building Codes.
- The Contractor's signature below denotes authority from the owner to sign in his behalf and that the owner is aware of all requirements of this application and permit. Separate permits must be taken out for work outlined above this agreement.
- I have read and understand the contents of this application and permit; I hereby state that the information I have supplied on this application is true and correct.

SIGNED: Charles Noble Contractor

BY: Agent or Owner

CLARK COUNTY HEALTH DEPT.

LAS VEGAS FIRE DEPARTMENT

PLANNING DEPT: Date: 4-28-69

PUBLIC WORKS DEPT: Date: 4-28-69

BUILDING DEPT: Date: 4-28-69

#12850 PERMIT NO: 47275 PERMIT FEE \$ 15.00

RECEIPT

453 \$0.15.00 - 8

CITY OF LAS VEGAS
DEPT. OF
BUILDING & SAFETY

MUST BE MACHINE VALIDATED
29 APR 69

CITY OF LAS VEGAS, NEVADA

DEPARTMENT OF BUILDING & SAFETY - ELECTRICAL APPLICATION & PERMIT

ADDRESS OF CONSTRUCTION: 328 Alexander Ave

OWNER'S NAME: Charles Noble

CIRCLE: New Bldg. Add'n. Remodel TYPE OF BLDG.: SFD. APT. PUBLIC COMM.

CONTRACTOR'S NAME:

STATE LICENSE #

CITY LICENSE #

NUMBER	FIXTURE OR INSTALLATION	UNIT PRICE	
	Fixture or sockets	.15	
✓	Light, receptacle or switch outlet	.20	2 DP
	Wall or ceiling space heater	.35	
	Blast coil heater per kilowatt	.35	
	Garbage grinder outlet	.35	
	Dishwasher outlet	.35	
✓	Clothes dryer outlet	.35	3.5
	Automatic clothes washer	.35	
	Electric range outlet	.35	
	Electric water heater outlet	.35	
	Mercury arc lamp and equipment	.35	
	Special purpose outlet	.35	
	X-ray unit and its appurtenances	5.00	
	Watts of festoon lighting (Watts) First 3,000 watts	4.00	
	for each additional thousand watts	1.50	
	Horsepower - all motors first horsepower or less	1.75	
	for each additional horsepower	.35	
	Temporary power and lights (temporary pole)	4.00	
	Electric service (including any single meter socket)	3.00	
	for each additional socket	.35	
	Air conditioning service amps	1.50	
	Each KW (KVA) Generator (Transformer) (Welder) KW (KVA)	2.00	
	First 100 KVA - For each additional KW (KVA)	.01	
	Special inspection per hour	4.00	
	Speaker outlets	.15	
	Signal or Alarm outlets	.15	
	Amplifiers	.50	
	Control panels	.25	
	T. V. outlets - master system only	.15	
	Radio outlets	.15	
	Main control racks	1.00	
	T. V. and Radio antennas - master system only	.75	
✓	Minimum fee for any permit	4.00	
	Total fee		40.00

I hereby certify that I have carefully examined and read the above application; that the same is true and correct; and, that the work herein described is to be done in accordance with all the provisions of the applicable Ordinances of the City of Las Vegas, Nevada and State laws whether herein specified or not.

SIGNED Charles Noble

MASTER (ELECTRICIAN) (TECHNICIAN) (OWNER)

DATE

BUILDING DEPARTMENT J. W. Wynn

DATE 4-29-69

*12860

PERMIT NO.

27883

PERMIT FEE: \$

192

RECEIPT

67 \$004.00 - 6

CITY OF LAS VEGAS

DEPT. OF
BUILDING & SAFETY
MUST BE MACHINE VALIDATED

3-0 APR 69

CITY OF LAS VEGAS, NEVADA

LOG NO. & AREA

DEPARTMENT OF BUILDING & SAFETY

APPLICATION & BUILDING PERMIT - for:
Dwellings, Duplexes, Misc. Residential Const.

ADDRESS OF
CONSTRUCTION:

328 Alexander

OWNER:

Charles Noble

LOT(s)

26

BLOCK

4

SUBDIVISION

East Park

ZONE:

R1

Existing structure on lot:

Dwelling ☒

Accessory bldgs. ☐

Vacant lot ☐

Other ☐

PROPOSED CONSTRUCTION:

Carport Roof

USE:

MATERIALS OF CONSTRUCTION:

Wood Frame ☐

Concrete Block ☐

Reinforced Concrete ☐

Steel Frame ☐

SQUARE FEET OF FLOOR AREAS:

1st

2nd

3rd

Other

TOTAL SQ. FT.

200

FIRE ZONE:

1 2 3

Occupancy Group

A

B

C

D

E

F

G

H

I

J-1

2-3

4-5

CONST. TYPE:

I

II

III

IV

V

ARCHITECT:

ENGINEER:

V. Paley

NO. of UNITS

NO. of STORIES

Plans Submitted:

Yes ☐

No ☐

Calculations Submitted

Yes ☐

No ☐

Sewer Fee Req'd.

Yes ☐

No ☐

CONTRACTOR:

AIR-VENT

STATE

LICENSE #

10399

CITY

LICENSE #

CL-2657

ADD'L. PERMITS REQ'D:

Air Cond. ☐

Elec. ☐

Plumbing ☐

Signs ☐

Paving ☐

Fence ☐

Public Walks ☐

Curb-gutters ☐

Incinerators ☐

Fire Sprinkling System ☐

CONDITIONS OF THE PERMIT:

1. I agree to call the City Building Department for inspections before concrete is poured, before rough wiring, electrical, plumbing, framing is covered. Also for Air conditioning, sheet-rock and sheathing inspection.
2. I agree that when the job is completed that I will call for final inspection before occupancy.
3. I agree to perform all construction in accordance with City Ordinances and Building Codes.
4. The Contractor's signature below denotes authority from the owner to sign in his behalf and that the owner is aware of all requirements of this application and permit. Separate permits must be taken out for work outlined above this agreement.
5. I have read and understand the contents of this application and permit; I hereby state that the information I have supplied on this application is true and correct.

SIGNED:

Air Vent Quieting Co.

Contractor

BY:

Charles Noble

Agent or Owner

Date

CLARK COUNTY HEALTH DEPT.

Date

LAS VEGAS FIRE DEPARTMENT

PLANNING DEPT:

[Signature]

Date:

6/4/71

PUBLIC WORKS DEPT:

Date:

BUILDING DEPT:

[Signature]

Date:

6-4-71

*12850

PERMIT NO:

60675

PERMIT FEE \$

RECEIPT

083

\$006.00

CITY OF LAS VEGAS

DEPT. OF
BUILDING & SAFETY

MUST BE MACHINE VALIDATED

Gloria Ealy 10-23-80

DEPT. of BLDG & SAFETY—CITY of LAS VEGAS, NEVADA
OWNER CHAS. U. NOBLE ADDRESS 328 ALEXANDER DATE 11-15-62
GEN. CONT. Same TYPE OF STRUCTURE encl carport
PERMIT NO. 13950 LEGAL DESCRIPTION

BUILDING		MECHANICAL		ELECTRICAL	
LOCATION		PLUMBING CONT.		TEMP. POLE CONT.	
FIREPLACE FTG.		PERMIT NO.	DATE	PERMIT NO.	DATE
FOOTINGS		HEAT & VENT. AC CONT.		INSPECTION	DATE
FOUNDATION WALL		PERMIT NO.	DATE	ELECTRICAL CONT.	
STEM WALL		SEWER CONT.		PERMIT NO.	DATE
FLOOR FRAMING		PERMIT NO.	DATE	FIXTURES CONT.	
SLAB		ROUGH SOIL		PERMIT NO.	DATE
CHIMNEY STEEL (FIREPLACE)		ROUGH WATER		SLAB	
WALL STEEL		TOP-OUT		ROUGH	
COLUMN STEEL		ROUGH GAS		FINAL ROUGH	
BEAM STEEL		AC ROUGH DUCT		FINAL FIXTURE	
STEEL FABRICATION		REF. ROUGH PIPING		TEMPORARY SERVICE	
FRAMING		FINAL PLUMBING			
ROOF SHEATHING		FINAL GAS		MISCELLANEOUS	
INTERIOR		FINAL AIR COND.		URBAN REDEVELOPMENT APPROVAL	
EXTERIOR		FINAL REFRIG.		☐	
DRYWALL		FINAL SEWER		GRADING & DRAINAGE	
LATHING		FINAL SEPTIC TANK		ON-SITE PARKING SPACES	
BACKING (SIDING)				ENG. APPROVAL OF	
PLASTER				OFF-SITE IMPROVEMENTS	
SCRATCH					
BROWN					
FINAL BLDG	DATE <u>2-28-64</u>				

APPROVED FOR OCCUPANCY _____ INSPECTOR _____ DATE _____
APPROVED FOR METER _____
PLEASE NOTE REMARKS ON REVERSE SIDE. LOG # _____ AREA # _____ 23.04

328 Alexander

DEPT. of BLDG & SAFETY—CITY of LAS VEGAS, NEVADA
OWNER Charles Noble ADDRESS 328 Alexander DATE 6-4-71
GEN. CONT. Air-Vent TYPE OF STRUCTURE carport roof
PERMIT NO. 60675 LEGAL DESCRIPTION L26 B 4 Kasper Park # 1

BUILDING		MECHANICAL		ELECTRICAL	
LOCATION		PLUMBING CONT.		TEMP. POLE CONT.	
FIREPLACE FTG.		PERMIT NO.	DATE	PERMIT NO.	DATE
FOOTINGS		HEAT & VENT. AC CONT.		INSPECTION	DATE
FOUNDATION WALL		PERMIT NO.	DATE	ELECTRICAL CONT.	
FLOOR FRAMING		SEWER CONT.		PERMIT NO.	DATE
SLAB		PERMIT NO.	DATE	FIXTURES CONT.	
CHIMNEY STEEL (FIREPLACE)		ROUGH SOIL		PERMIT NO.	DATE
WALL STEEL		ROUGH WATER		SLAB	
COLUMN STEEL		TOP-OUT		ROUGH	
BEAM STEEL		ROUGH GAS		FINAL ROUGH	
FRAMING		AC ROUGH DUCT		FINAL FIXTURE	
ROOF SHEATHING		REF. ROUGH PIPING		FINAL ELECTRICAL	
INTERIOR		FINAL PLUMBING			
EXTERIOR		FINAL GAS		TEMPORARY SERVICE	
DRYWALL		FINAL AIR COND.			
LATHING		FINAL REFRIG.		MISCELLANEOUS	
BACKING (SIDING)		FINAL SEWER		GRADING & DRAINAGE	
PLASTER		FINAL SEPTIC TANK		ON-SITE PARKING SPACES	
SCRATCH				ENG. APPROVAL OF	
BROWN				OFF-SITE IMPROVEMENTS	
URBAN REDEVELOPMENT APPROVAL					
FINAL BLDG	DATE				

APPROVED FOR OCCUPANCY & METER Office 1-4-71 INSPECTOR _____ DATE _____
PLEASE NOTE REMARKS ON REVERSE SIDE. 328 Alexander LOG # _____ AREA # _____ 23.04

Gloria Ealy 10-23-80

DEPARTMENT OF BUILDING & SAFETY
CITY OF LAS VEGAS, NEVADA

KARDEX CARD
FENCE & RETAINING
WALLS

OWNER U. CHARLES NOBLE ADDRESS 328 ALEXANDER AVE. DATE 4-15-68
CONTRACTOR SAME PERMIT NO. 41326
LOT 26 BLOCK 1 SUBDIVISION Kasper Pk. #1

WIRE FENCE	
Fence (wire, wood, etc.)	Walls (masonry, rock, etc.)
Location <u>328 Alexander Ave</u>	Location _____
Final Inspection <u>WCS 4-29-68</u>	Footings _____
	Wall Steel 1st _____ 2d _____ 3d _____
	Final Inspection _____
Retaining Wall (masonry)	
Retaining Wall (concrete)	
Location _____	Location _____
Footings _____	Footings _____
Wall Steel 1st _____ 2d _____ 3d _____	Wall Steel 1st _____ 2d _____ 3d _____
Bond Beam 1st _____ 2d _____ 3d _____	Final Inspection _____
Final Inspection _____	

23.14 B ADDRESS 328 ALEXANDER AVE LOG NO. _____ AREA _____

DEPARTMENT OF BUILDING & SAFETY
CITY OF LAS VEGAS, NEVADA

KARDEX CARD
FENCE & RETAINING
WALLS

OWNER U. Charles Noble ADDRESS 328 Alexander DATE 8/13/64
CONTRACTOR Bruni Construction PERMIT NO. 27539
LOT 26 BLOCK 4 SUBDIVISION Kasper Park #1

Walls (masonry, rock, etc.)	
Fence (wire, wood, etc.)	Walls (masonry, rock, etc.)
Location _____	Location <u>49 8-17-64</u>
Final Inspection _____	Footings <u>49 8-17-64</u>
	Wall Steel 1st <u>8-17-64</u> 2d _____ 3d _____
	Final Inspection <u>Plumb 8-17-64</u>
Retaining Wall (masonry)	
Retaining Wall (concrete)	
Location _____	Location _____
Footings _____	Footings _____
Wall Steel 1st _____ 2d _____ 3d _____	Wall Steel 1st _____ 2d _____ 3d _____
Bond Beam 1st _____ 2d _____ 3d _____	Final Inspection _____
Final Inspection _____	

23.14 B ADDRESS 328 Alexander LOG NO. _____ AREA _____

Gloria Caly 10-23-80

DEPT. of BLDG. & SAFETY - CITY of LAS VEGAS, NEVADA
OWNER Charles Noble ADDRESS 328 Alexander DATE 4/28/69
GEN. CONT. Owner TYPE OF STRUCTURE Basement
PERMIT NO. 47275 LEGAL DESCRIPTION L 26 B 1 Kasper Park #1

BUILDING		MECHANICAL		ELECTRICAL	
LOCATION		PLUMBING CONT.		TEMP. POLE CONG.	
FIREPLACE FTS		PERMIT NO.	DATE	PERMIT NO.	DATE
FOOTINGS		HEAT & VENT. AC CONT.		INSPECTION	
FOUNDATION WALL		PERMIT NO.	DATE	ELECTRICAL CONT.	
FLOOR FRAMING		SEWER CONT.		PERMIT NO.	DATE
SLAB		PERMIT NO.	DATE	FIXTURES CONT.	
CHIMNEY STEEL (FIREPLACE)		ROUGH SOIL		PERMIT NO.	DATE
WALL STEEL		ROUGH WATER		SLAB	
COLUMN STEEL		TOP-OUT		ROUGH	
BEAM STEEL		ROUGH GAS		FINAL ROUGH	
FRAMING		AC ROUGH DUCT		FINAL FIXTURE	
ROOF SHEATHING		REF. ROUGH PIPING		FINAL ELECTRICAL	
INTERIOR		FINAL PLUMBING		TEMPORARY SERVICE	
EXTERIOR		FINAL GAS		MISCELLANEOUS	
DRYWALL		FINAL AIR COND.		GRAVING & DRAINAGE	
LATHING		FINAL REFRIG.		ON-SITE PARKING SPACES	
BACKING (SIDING)		FINAL SEWER		ENG. APPROVAL OF	
PLASTER		FINAL SEPTIC TANK		OFF-SITE IMPROVEMENTS	
SCRATCH					
BROWN					
URBAN REDEVELOPMENT APPROVAL					
FINAL BLDG					
DATE					

APPROVED FOR OCCUPANCY & METER DB 4-2-70 INSPECTOR DATE
PLEASE NOTE REMARKS ON REVERSE SIDE 328 Alexander LOG # AREA # 23.04

DEPARTMENT OF BUILDING & SAFETY
CITY OF LAS VEGAS, NEVADA

KARDER CARD
FENCE & RETAINING
WALLS

OWNER V. C. NOBLE ADDRESS 328 Alexander DATE 6/3/68
CONTRACTOR OWNER PERMIT NO. 42077

LOT 26 BLOCK 1 SUBDIVISION Kasper Park
Block fence

Fence (wire, wood, etc.)	Walls (masonry, rock, etc.)
Location	Location
Final Inspection	Footings <u>WP 6-3-68</u>
	Wall Steel 1st <u>WP 6-21-68</u> 2d <u>WP 6-21-68</u> 3d <u>WP 6-21-68</u>
	Final Inspection <u>WP 6-21-68</u>
Retaining Wall (masonry)	Retaining Wall (concrete)
Location	Location
Footings	Footings
Wall Steel 1st <u>2d</u> 3d	Wall Steel 1st <u>2d</u> 3d
Beam 1st <u>2d</u> 3d	Final Inspection
Final Inspection	

23.14 B: ADDRESS 328 Alexander LOG NO. AREA

Gloria Ealy 10-23-80

DEPT. of BLDG. & SAFETY— CITY of LAS VEGAS, NEVADA			
OWNER, <u>RALPH ENGELSTAD</u>	ADDRESS <u>328 Alexander Ave.</u>	DATE <u>June 7, 1961</u>	
GEN. CONT. <u>R. Engelstad Const. Co.</u>		TYPE OF STRUCTURE <u>S.F. Dwl.</u>	
PERMIT NO. <u>5061</u>	LEGAL DESCRIPTION <u>Lot 26 Block 4 Kasper Park Unit #1</u>		
URBAN REDEVELOPMENT APPROVAL			

APPROVED FOR OCCUPANCY DATE 7-1-61
APPROVED FOR METER DATE 7-1-61
REMARKS ON REVERSE SIDE
328 Alexander Ave. Log# T-20 AREA# 3 23.04
DATE June 7, 1961