

6313 Dayton Ave:

DEPT. of BLDG & SAFETY - CITY of LAS VEGAS, NEVADA

OWNER Howard Garn Hirschi ADDRESS 6313 Dayton Ave. DATE 2-11-71
 GEN CONT. Owner TYPE OF STRUCTURE enclose pati
 PERMIT NO. 57133 LEGAL DESCRIPTION L 22 B 4 Chas Heights 40 B

BUILDING		MECHANICAL	ELECTRICAL
LOCATION		PLUMBING CONT.	TEMP. POLE CONT.
FIREPLACE FTE.		PERMIT NO. _____ DATE _____	PERMIT NO. _____ DATE _____
FOOTINGS		HEAT & VENT. AC CONT.	INSPECTION _____ DATE _____
FOUNDATION WALL		PERMIT NO. _____ DATE _____	ELECTRICAL CONT. <u>Owner</u>
FLOOR FRAMING		SEWER CONT.	PERMIT NO. <u>32955</u> DATE <u>2-4-70</u>
SLAB		PERMIT NO. _____ DATE _____	FIXTURES CONT.
CHIMNEY STEEL (FIREPLACE)		ROUGH SOIL	PERMIT NO. _____ DATE _____
WALL STEEL		ROUGH WATER	SLAB
COLUMN STEEL		TOP-OUT	ROUGH <u>PM 3-31-71</u>
BEAM STEEL		ROUGH GAS	FINAL ROUGH
FRAMING		AC ROUGH DUCT	FINAL FIXTURE
ROOF SHEATHING	INTERIOR _____ EXTERIOR _____	REF. ROUGH PIPING	FINAL ELECTRICAL
DRYWALL		FINAL PLUMBING	TEMPORARY SERVICE
LATHING		FINAL GAS	
BACKING (SIDING)		FINAL AIR COND.	MISCELLANEOUS
PLASTER	SCRATCH _____ BROWN _____	FINAL REFRIG.	GRADING & DRAINAGE
URBAN REDEVELOPMENT APPROVAL		FINAL SEWER	ON-SITE PARKING SPACES _____ APP. _____
FINAL BLDG _____ DATE _____		FINAL SEPTIC TANK	ENG APPROVAL OF _____
			OFF-SITE IMPROVEMENTS

APPROVED FOR OCCUPANCY METER 419-22-71 INSPECTOR _____ DATE _____

PLEASE NOTE REMARKS ON REVERSE SIDE

6313 Dayton Ave.

LOG #

AREA #

23.04

DEPT. of BLDG & SAFETY - CITY of LAS VEGAS, NEVADA

OWNER SPROUL HOMES INC. ADDRESS 6313 DAYTON AVE. DATE 2-11-62
 GEN CONT. SAME TYPE OF STRUCTURE S. F. DWELLING
 PERMIT NO. 1691 LEGAL DESCRIPTION Lot 22, Blk. 4, Chas. Hts. 40-B

BUILDING		MECHANICAL	ELECTRICAL
LOCATION		PLUMBING CONT.	TEMP. POLE CONT.
FIREPLACE FTE.		PERMIT NO. <u>5734</u> DATE <u>6-10-62</u>	PERMIT NO. _____ DATE _____
FOOTINGS		HEAT & VENT. AC CONT. <u>Hummer</u>	INSPECTION _____ DATE _____
FOUNDATION WALL		PERMIT NO. <u>5734</u> DATE <u>8-2-62</u>	ELECTRICAL CONT.
STEM WALL		SEWER CONT.	PERMIT NO. <u>1131</u> DATE _____
FLOOR FRAMING		PERMIT NO. <u>5734</u> DATE <u>6-6-62</u>	FIXTURES CONT.
SLAB		ROUGH SOIL	PERMIT NO. <u>1131</u> DATE _____
CHIMNEY STEEL (FIREPLACE)		ROUGH WATER	SLAB
WALL STEEL		TOP-OUT	ROUGH <u>Miller 8-2-62</u>
COLUMN STEEL		ROUGH GAS	FINAL ROUGH
BEAM STEEL		AC ROUGH DUCT	FINAL FIXTURE
STEEL FABRICATION		REF. ROUGH PIPING	TEMPORARY SERVICE
FRAMING		FINAL PLUMBING <u>Miller 8-2-62</u>	MISCELLANEOUS
ROOF SHEATHING	INTERIOR _____ EXTERIOR _____	FINAL GAS	URBAN REDEVELOPMENT APPROVAL
DRYWALL	<u>459-50</u>	FINAL AIR COND. <u>Miller 10-1-62</u>	<input type="checkbox"/>
LATHING		FINAL REFRIG.	GRADING & DRAINAGE
BACKING (SIDING)		FINAL SEWER	ON-SITE PARKING SPACES _____ APP. _____
PLASTER	SCRATCH _____ BROWN _____	FINAL SEPTIC TANK	ENG APPROVAL OF _____
FINAL BLDG _____ DATE _____			OFF-SITE IMPROVEMENTS

APPROVED FOR OCCUPANCY Miller 8-28-62 INSPECTOR _____ DATE _____

APPROVED FOR METER Miller 8-28-62

PLEASE NOTE REMARKS ON REVERSE SIDE

LOG # T-29

AREA # 4

23.04

6313 DAYTON AVE.

6313 DAYTON AVE.

L22 B-4 Char Hgts 40-B Zone R-1

G. Gatewood 9-2-79

CITY OF LAS VEGAS, NEVADA

LOG NO. & AREA

DEPARTMENT OF BUILDING & SAFETY

1977

CONST. VAL. \$

1000.00

APPLICATION & BUILDING PERMIT - for:

Dwellings, Duplexes, Misc. Residential Const.

ADDRESS OF CONSTRUCTION:

6313 DAYTON AVE.

OWNER:

HOWARD GARN HIRSCHI

LOT:

22

BLOCK

4

SUBDIVISION

CHAS HCTS 90-B

ZONE: R-1

Existing structure on lot:

Dwelling

Accessory bldgs.

Vacant lot.

Other

PROPOSED CONSTRUCTION:

Fill in Front PATIO

USE: Living Room

MATERIALS OF CONSTRUCTION:

Wood Frame

Concrete Block

Reinforced Concrete

Steel Frame

SQUARE FEET OF FLOOR AREAS:

1st

2nd

3rd

Other

TOTAL SQ. FT.

340

FIRE ZONE:

1 2 3

Occupancy Group

A

B

C

D

E

F

G

H

I

J-1-2-3-4-5

CONST. TYPE:

I

II

III

IV

V

ARCHITECT:

ENGINEER:

NO. of UNITS

NO. of STORIES

Plans Submitted:

Yes

No

Calculations Submitted:

Yes

No

Sewer Fee Req'd.

Yes

No

CONTRACTOR:

OWNER

STATE

LICENSE #

CITY

LICENSE #

ADD'L. PERMITS REQ'D:

Asphalt

Elec.

Plumbing

Signs

Paving

Fence

Public Walks


Curb-gutters

Incinerators

Fire Sprinkling System

CONDITIONS OF THE PERMIT:

1. I agree to call the City Building Department for inspections before concrete is poured, before rough wiring, electrical, plumbing, framing is covered. Also for Air conditioning, sheet-rock and sheathing inspection.
2. I agree that when the job is completed that I will call for final inspection before occupancy.
3. I agree to perform all construction in accordance with City Ordinances and Building Codes.
4. The Contractor's signature below denotes authority from the owner to sign in his behalf and that the owner is aware of all requirements of this application and permit. Separate permits must be taken out for work outlined above this agreement.
5. I have read and understand the contents of this application and permit; I hereby state that the information I have supplied on this application is true and correct.

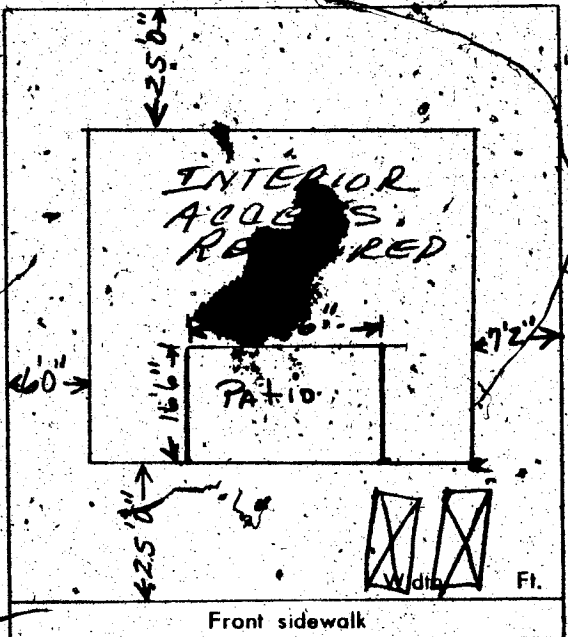

SIGNED:

OWNER

Contractor

BY:

Howard G. Hirschi

Agent or Owner

CLARK COUNTY HEALTH DEPT.

Date

LAS VEGAS FIRE DEPARTMENT

Date

PLANNING DEPT.

me

Date:

2-11-77

PUBLIC WORKS DEPT.

Date:

BUILDING DEPT.

R. P. P.

Date:

2-11-77

#12850

PERMIT NO:

57133

PERMIT FEE \$

1200

RECEIPT

3414 \$012.00

CITY OF LAS VEGAS DEPT. OF BUILDING & SAFETY

MUST BE MACHINE VALIDATED 2 FEB 77

G. Gatewood 9-2-79

CITY OF LAS VEGAS, NEVADA

DEPARTMENT OF BUILDING & SAFETY - ELECTRICAL APPLICATION & PERMIT

ADDRESS OF CONSTRUCTION: 6313 Dayton Ave. OWNER'S NAME: HOWARD G. HIRSCHI

CIRCLE: New Bldg.; Addn; Remodel; TYPE OF BLDG.: SPD. APD. PUBLIC COMM.

CONTRACTOR'S NAME: OWNER STATE LICENSE: CITY LICENSE:

NUMBER	FIXTURE OR INSTALLATION	UNIT PRICE
	Fixture or sockets	.15
	Light, receptacle or switch outlet	.20
	Wall or ceiling space heater	.35
	Blast coil heater per kilowatt	.35
	Garbage grinder outlet	.35
	Dishwasher outlet	.35
	Clothes dryer outlet	.35
	Automatic clothes washer	.35
	Electric range outlet	.35
	Electric water heater outlet	.35
	Mercury arc lamp and equipment	.35
	Special purpose outlet	.35
	X-ray unit and its appurtenances	5.00
	Watts of festoon lighting (Watts) First 3,000 watts for each additional thousand watts	4.00 1.50
	Horsepower - all motors first horsepower or less for each additional horsepower	1.75 .35
	Temporary power and lights (temporary pole)	4.00
	Electric service (including any single meter socket) for each additional socket	3.00 .35
	Air conditioning service amps	1.50
	Each KW (KVA) Generator (Transformer) (Welder) KW (KVA) First 100 KVA - For each additional KW (KVA)	2.00 .01
	Special inspection per hour	4.00
	Speaker outlets	.15
	Signal or Alarm outlets	.15
	Amplifiers	.50
	Control panels	.25
	T. V. outlets - master system only	.15
	Radio outlets	.15
	Main control racks	1.00
	T. V. and Radio antennas - master system only	.75
	Minimum fee for any permit	4.00
	Total fee	

I hereby certify that I have carefully examined and read the above application; that the same is true and correct; and that the work herein described is to be done in accordance with all the provisions of the applicable Ordinances of the City of Las Vegas, Nevada and State laws whether herein specified or not.

SIGNED: Howard G. Hirschi DATE: 2-7-71
MASTER (ELECTRICIAN) (TECHNICIAN) (OWNER)

BUILDING DEPARTMENT: [Signature] DATE: 2-7-71

PERMIT NO. 32955 PERMIT FEE: \$4.00

RECEIPT

3415 \$004.00 - 6

CITY OF LAS VEGAS
DEPT. OF BUILDING & SAFETY

MUST BE MACHINE VALIDATED

102 FEB 71

G. Gatewood 4-24-79

15-06

CITY OF LAS VEGAS, NEVADA

LOG NO. & AREA

CONST. VAL. \$ 3020

DEPARTMENT OF PUBLIC SERVICES
DIVISION OF BUILDING & SAFETY

APPLICATION & BUILDING PERMIT for:
Fence, Wall, Retaining Wall.

ADDRESS OF CONSTRUCTION: 6313 Dayton Ave

OWNER: GARY HIRSCH

LOT(s) 27 BLOCK 4 SUBDIVISION CHAR. HTS 40-13

ZONE: R1

Materials of Construction: Block Concrete Wire Wood Other

Yes No
PLANS:
CALCS:

ARCHITECT:

ENGINEER:

CONTRACTOR: Owner

STATE LICENSE #


CITY LICENSE #

TOTAL SQUARE FEET: TOTAL LINEAL FEET: 500.5

Remarks: 172.5' x 6' Block
88' x 2' Block

CONDITIONS OF THE PERMIT:

- Any type of retaining wall must be engineered by a Civil or Structural Engineer.
- If a home owner takes out the Building Permit and if the owner orders the work to a Contractor, then the Contractor must take out the permit and pay for it.
- No fence or wall can be built on City property or rights-of-way, but this is not intended to preclude construction within utility easements if utilities will not be damaged or made inaccessible.
- The fence or wall shall not enclose any water meter, light standard, or fire alarm box and shall not come closer than 24" from the nearest fire hydrant outlet.
- Department Inspectors must approve footings before concrete is poured and block wall reinforcing before grouting is done.
- Maximum height of any wall or fence is 6', side and rear yards: 4' maximum in front yard with the vertical surface above the height of 2' - 50% open.
- Must not obstruct required onsite parking space (2 spaces for each dwelling unit) by the erection of this fence or wall.
- By the signing of this application I herewith agree to the requirements outlined above.

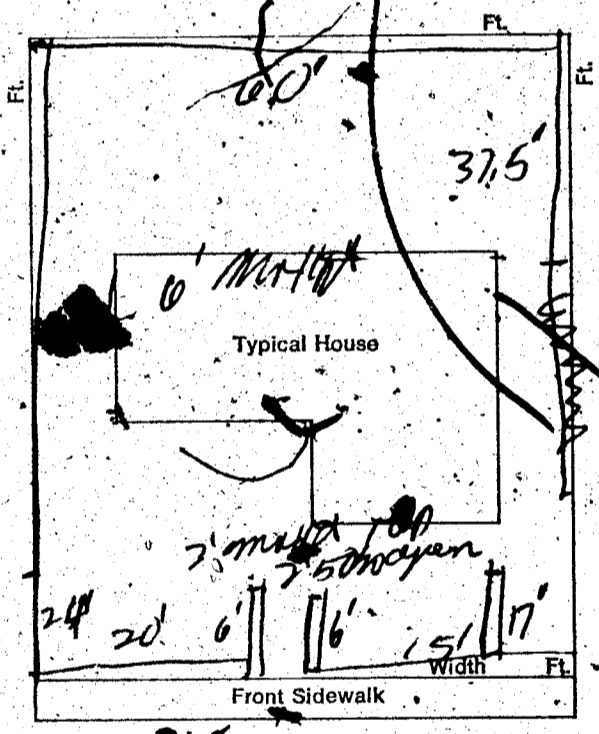

1. DEW.	\$	00
WALL	\$	24.00
STL	\$	24.00
TOTL	\$	24.00
DATES		24.00
PERMITS		24.00

SIGNED: Gary Hirsch
CONTRACTOR AGENT OWNER

PLANNING DEPT: Date: 4-13-79

PUBLIC WORKS DEPT: Date: 4/13/79

BUILDING DIVISION: Date: 4-13-79

#12850 PERMIT NO: 3016 PERMIT FEE \$ 24.00

RECEIPT
CITY - LAS VEGAS
BLDG. & SAFETY
04/16/79

MUST BE MACHINE VALIDATED

FENCE & RAILROAD		
NAME <i>John Harrell</i>		
ADDRESS <i>6323 Dayton Ave</i>		
CONTRACTOR <i>Coner</i>	JOB NO. <i>3016</i>	FINAL INSPECTOR <i>(Block wall)</i>
LOT <i>22</i>	BLOCK <i>4</i>	SUBDIVISION <i>Charleston 64-13</i>
CITY		AREA
- FENCES (wire, wood, block, & retaining walls)		
Location	<i>79 5-10-77</i>	
Footings	<i>79 5-10-77</i>	
Wall Steel		
IM		
Board Feet		
Final	<i>BM 3-26-80</i>	
Specify Type Of Fence		

DEPT. of BLDG & SAFETY—CITY of LAS VEGAS, NEVADA

OWNER Garn Hirschi

ADDRESS 6313 Dayton

DATE 3/12/63

GEN. CONT. owner

TYPE OF STRUCTURE wood fence

PERMIT NO. 18979

LEGAL DESCRIPTION

BUILDING		MECHANICAL	ELECTRICAL
LOCATION		PLUMBING CONT.	TEMP. POLE CONT.
FIREPLACE FTS.		PERMIT NO. _____ DATE _____	PERMIT NO. _____ DATE _____
FOOTINGS		HEAT & VENT. AC CONT.	INSPECTION _____ DATE _____
FOUNDATION WALL		PERMIT NO. _____ DATE _____	ELECTRICAL CONT.
FLOOR FRAMING		SEWER CONT.	PERMIT NO. _____ DATE _____
SLAB		PERMIT NO. _____ DATE _____	FIXTURES CONT.
CHIMNEY STEEL (FIREPLACE)		ROUGH SOIL	PERMIT NO. _____ DATE _____
WALL STEEL		ROUGH WMBER	SLAB
COLUMN STEEL		TOP-OUT	ROUGH
BEAM STEEL		ROUGH GAS	FINAL ROUGH
FRAMING		AC ROUGH DUCT	FINAL FIXTURE
ROOF SHEATHING	INTERIOR _____ EXTERIOR _____	REF. ROUGH PIPING	FINAL ELECTRICAL
DRYWALL		FINAL PLUMBING	TEMPORARY SERVICE
LATHING		FINAL GAS	
BACKING (SIGNS)		FINAL AIR COND.	MISCELLANEOUS
PLASTER	SCRATCH _____ BROWN _____	FINAL REFRIG.	GRADING & DRAINAGE _____
URBAN REDEVELOPMENT APPROVAL		FINAL SEWER	ON-SITE PARKING SPACES _____ APP. _____
		FINAL SEPTIC TANK	ENG. APPROVAL OF _____
FINAL BLDG. _____ DATE <u>3/12/63</u>			OFF-SITE IMPROVEMENTS _____

APPROVED FOR OCCUPANCY & METER _____ DIRECTOR _____ DATE _____

PLEASE NOTE REMARKS ON REVERSE SIDE

LOS: #

AREA #

2304

6313 Dayton