

6280 BURRO RD

Mariame Francis 6-22-84

CITY OF LAS VEGAS, NEVADA

LOG NO. & AREA _____ DATE _____ PHONE # _____
CONST. VAL. \$ _____

DEPARTMENT OF BUILDING AND SAFETY 01C-0801013 DEVELOPMENT PERMIT AND BUILDING PERMIT
PHONE 386-6251 FOR: Dwellings, Duplexes, Misc. Residential Const.

ADDRESS OF CONSTRUCTION: 6280 BURRO RD OWNER: Bill C. Hirschi

CONTRACTOR: Owner STATE LICENSE NO. _____ CHASE NO. _____

LOT(s): 1/4 SEC 26 T19 S R60E BLOCK _____ SUBDIVISION _____

PROPOSED CONSTRUCTION: MH - While building SFD ZONE: R-E

BUILDING PERMIT NO. 1773 ELECTRIC PERMIT NO. _____ PLUMBING PERMIT NO. _____
USE: Residential

ADD'L. PERMITS REQ'D.: Air Cond. ☐ Elec. ☐ Plumbing ☐ Signs ☐ Paving ☐ Fence ☐
Incinerators ☐ Fire Sprinkling System ☐ Off-Site Permit ☐

MATERIALS OF CONSTRUCTION: Wood Frame ☐ Concrete Block ☐ Reinforced Concrete ☐ Steel Frame ☐

SQUARE FEET OF FLOOR AREAS: 1st _____ 2nd _____ 3rd _____ Other _____ TOTAL SQ. FT. _____

ARCHITECT: _____ ENGINEER: _____ NO. of UNITS _____ NO. of STORIES _____

OTHER INSPECTIONS AND FEES

1. Inspections outside of normal business hours = \$25.00 per hour (minimum charge three hours).
2. Re-inspection fee during normal business hours assessed under provisions of TABLE 3-A of the Uniform Building Code = \$15.00 each.
3. Inspections during normal business hours for which no fee is specifically indicated = \$15.00 per hour (minimum charge one half hour).
4. Additional plan review required by changes, additions or revisions at approved plans = \$25.00 per hour (minimum charge two hours).

CONDITIONS OF THE PERMIT:

1. I agree to call the City Building Department for inspections before concrete is poured, before rough wiring, electrical, plumbing, framing is covered. Also for air conditioning, drywall and sheathing inspection.
2. I agree that when the job is completed that I will call for final inspection before occupancy.
3. I agree to perform all construction in accordance with City Ordinances and Building Codes.
4. The Contractor's signature below denotes authority from the owner to sign in his behalf and that the owner is aware of all requirements of this application and permit. Separate permits must be taken out for work outlined above this agreement.
5. I have read and understand the contents of this application and permit. I hereby state that the information I have supplied on this application is true and correct.

Approval for the work under this permit will be given only after refuse and debris have been removed from job site and public right of way.

SIGNED: [Signature] CONTRACTOR

BY: _____ AGENT/OWNER


LICENSE DEPT: _____ DATE: 6/19/84
PLANNING DEPT: _____ DATE: _____

BUILDING DEPT: _____ DATE: _____

I hereby certify that I have reviewed this application and the proposed plans and have found that the proposed development meets the requirements of the City of Las Vegas Flood Hazard Reduction Ordinance for the issuance of this Development Permit.

[Signature] 6/19/84
LAND DEVELOPMENT AND FLOOD CONTROL ENGINEER DATE

Permit Expires 180 Days After Abandonment of Work

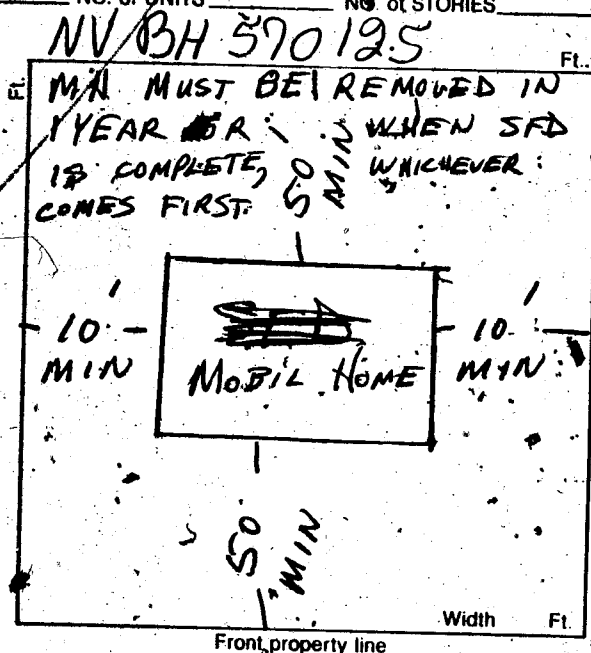

RECEIPT	
SEWER CONNECTION FEE	0.00
# 7114-3654	
FIXTURES 11 SFD	40.00
TOTAL	40.00
FEE	
PLAN REVIEW	
FEE 04-19-84 1773 R010001 1111 T10:39	40.00
PERMIT FEE	
TOTAL FEES	120.00

MUST BE MACHINE VALIDATED.

Michelle Francis

7-9-84

OWNER Bill C. Hirschi		ADDRESS 6280 Burro Rd.	
DATE 6-20-84		GEN. CONT. Owner	
TYPE OF STRUCTURE M/H white bldg. sfd		PERMIT No. 1773	
LEGAL DESCRIPTION SEE APPLICATION		LOG No. AREA No.	
APPROVED FOR OCCUPANCY & METER			
BUILDING		MECHANICAL	
Location & Footing		Plumbing Cont.	
Concrete Slab Floor		Permit No. Date	
Fireplace/Footing		Htg./Vt./A.C. Cont.	
Chimney Steel		Permit No. Date	
Vert. Steel Reinf.		Sewer Cont.	
Horiz. Steel Reinf.		Permit No. Date	
Framing		Rough Soil	
Ext. Lath		Rough Water	
Roof Sheathing		Top-Out	
Ext. Brown		Rough Gas	
Insulation		A/C Rough Duct	
Drywall		Final Plumbing	
Final Building 05945-84		Final Gas	
Appr. for Occ.		Final Air Cond.	
ELECTRICAL		Final Sewer	
Temp. Pole cont.		REMARKS	
Permit No. Date			
Inspection Date			
Electrical Cont.			
Permit No. Date			
Rough		PLEASE NOTE ADDITIONAL REMARKS ON REVERSE SIDE	
Final Electrical		DEPT OF BLDG & SAFETY CITY OF LAS VEGAS REV. 82-3-29	
Temporary Service			