

4617 FULTON PLACE

Dona Fluealy

3-17-83

CITY OF LAS VEGAS, NEVADA

030-142-007

LOG NO. & AREA

CONST. VAL. \$

9021.00

DEPARTMENT OF PUBLIC SERVICES
DIVISION OF BUILDING AND SAFETYAPPLICATION & BUILDING PERMIT — for:
Dwellings, Offices, Misc. Residential Const.

CONSTRUCTION

4611 Factor Rd.

OWNER

Karlton, C.W.

LOT

532

BLOCK

227

SUBDIVISION

Hedge Park #3

ZONE

R-1

Existing structure on lot:

Dwelling ☒Accessory Bldgs. ☐Vacant Lot ☐Other ☐

PROPOSED CONSTRUCTION

Rem add. w/FRP

USE

family home

MATERIALS OF CONSTRUCTION:

Wood Frame ☒Concrete Block ☐Reinforced Concrete ☐Steel Frame ☐

SQUARE FEET OF FLOOR AREAS:

1st

306

2nd

3rd

Other

TOTAL SQ. FT.

306

FIRE ZONE:

Occupancy Group

CONST. TYPE:

I-N

ARCHITECT

ENGINEER

NO. of UNITS

NO. of STORIES

Plans Submitted:

Yes ☐No ☒

Calculations Submitted:

Yes ☐No ☒

Sewer Reg. Req'd.

Yes ☐No ☒

CONTRACTOR

Dinner

STATE LICENSE #

CITY LICENSE #

ADD'L PERMITS REQ'D.

Air Cond. ☐Elev. ☐Numbering ☐Signs ☐Paving ☐Fence ☐Public Walks ☐Curb-gutters ☐Incinerators ☐Fire Sprinkling System ☐

CONDITIONS OF THE PERMIT:

- I agree to call the City Building Department for inspections before concrete is poured, before rough wiring, electrical plumbing, framing is covered. Also for Air conditioning, drywall and finishing inspection.
 - I agree that when the job is completed that I will call for final inspection before occupancy.
 - I agree to perform all construction in accordance with City Ordinances and Building Codes.
 - The Contractor's signature below gives authority to the owner to sign in his behalf, and that the owner is aware of all requirements of this application and permit. Separate permits must be marked out for work outlined above this agreement.
 - I have read and understand the contents of this application and permit, hereby state that the information is true and correct.
- Approval for the work under permit will be given only after refuse and debris have been removed from job site and proper right of way. Separate permits are required for work within the public right of way.

SFD \$ 80.50
ELEC \$ 16.50
STE \$ 97.00
TOTAL \$ 194.00
CITY OF LAS VEGAS
BLDG & SAFETY
03/16/83


SIGNED

Karlton W. Karlton

Contractor

BY

Agent or Owner

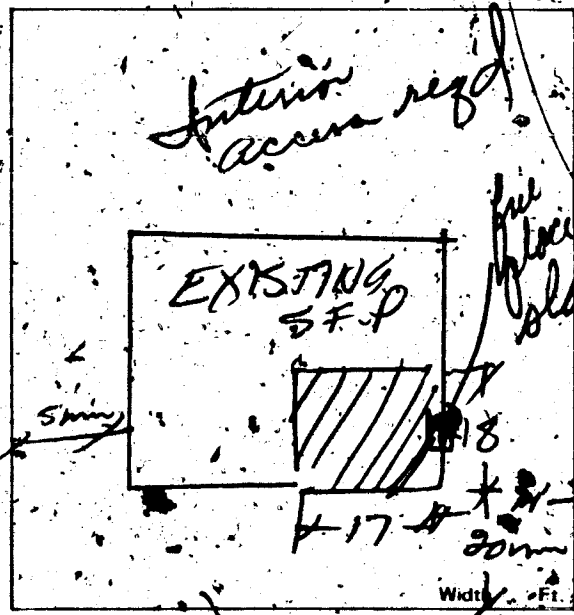

PLANNING DEPT.

Date:

3/15/83

PUBLIC WORKS DEPT.

Date:

3/15/83

BUILDING DIVISION:

Date:

3/15/83

2300-2401

PERMIT NO.

8134

PERMIT FEE \$

80.50

RECEIPT

MUST BE MACHINE VALIDATED

Dona H. H. 3-17-83

CITY OF LAS VEGAS, NEVADA

DEPARTMENT OF BUILDING AND SAFETY-ELECTRICAL APPLICATION & PERMIT

PHONE NO. 270-7328

ADDRESS OF CONSTRUCTION: 4617 Fulton St

OWNER'S NAME: C.W. Boulton

CIRCLE: Addition Remodel New Bldg TYPE OF BLDG: SFD / APT. COMM. PUBLIC

CONTRACTOR'S NAME: Owen

STATE LICENSE #

CITY LICENSE #

UNITS	DESCRIPTION	FEE	TOTAL
1	PERMIT ISSUANCE		
	For Issuing Each Permit	10.00	10.00
	Supplemental Fee	4.50	
	APPLIANCE CHARGE		
	Receptacle Switch 2	.40	3.20
1	Each Light Fixture or Socket	.30	3.00
	EACH OUTLET FOR: Dishwasher, Garbage Grinder, Trash Compactor, G.F.L., Clothes Washer, Dryer, Electric Range, Ovens, Smoke Detector, Special Purpose, Water Heater, Space Heater, Blast Coil Heater (PER K.W.), Mercury Lamp, Quartz Lamp, Sodium Lamp	.70	
	X-Ray Unit	10.00	
	Area Lighting (First 3,000 Watts)	5.00	
	Each Additional 1,000 Watts	3.00	
	Motors (1/2 H.P. And Over) Transformers Welders, Generators		
	First H.P. For each Unit	3.00	
	First KVA For Each Unit	.50	
	Each Additional H.P. or KVA	.30	
	Temporary Power or Pole	6.00	
	Electric Service (Incl'd First Meter)	6.00	
	Up to 200 AMP		
	400 AMP And 600 AMP	12.50	
	Over 600 AMP To 1200 AMP	25.00	
	Over 1200 AMP	50.00	
	Each Additional Meter Socket	.50	

UNITS	DESCRIPTION	FEE	TOTAL
	Sub Panel (Each)	3.00	
	Swimming Pool (Residential)	20.00	
	Swimming Pool (Semi-Public)	30.00	
	Spas	8.00	
	Recreational Vehicle Spaces (Each)	3.00	
	Busways-Trolley or Plug-in (Ea. 100 Ft.)	3.00	
	All Misc. Electric		
1	Permanent A/C Unit (Pkg. Units)	3.00	3.00
	Each Air Handler	1.00	
	LOW VOLTAGE INSTALLATIONS		
	Speaker Outlets (Each)	.30	
	Signal or Alarm Outlets (Each)	.30	
	Amplifiers	2.00	
	Control Panel	.50	
	TV Master System	.30	
	Telephone or Computer Outlet	.30	
	Starter Permit		
	Contract Price or Cost of Installation		
	Misc.		
	CONDUIT ONLY		
	TOTAL PERMIT FEE \$	16.50	

Electrical permit fees may be computed the same as building permit fees by using the cost of installation for valuation amount when such work is not included in the above schedule.

FOR BUILDING DEPARTMENT USE ONLY

Plans submitted: ☐ yes ☐ no	Occupancy type: _____	Type of Construction _____	Square Footage _____
Received by PAC: _____	Date: _____	Valuation (declared) \$ _____	
Review by Plans Check: _____	Date: _____	Fee calculated \$ _____	
Issued by _____	Date: _____	Other Fees (226) \$ _____	
	Check ☐ Cash ☐	Total Fees \$ _____	

- Other inspections and fees:
1. Inspections outside of normal business hours = \$25.00 per hour (minimum charge two hours).
2. Re-inspection fee during normal business hours assessed under provisions of TABLE 3-A of the Uniform Building Code = \$15.00 per hour.
3. Inspections during normal business hours for which no fee is specifically indicated = \$15.00 per hour (minimum charge one half hour).
4. Additional plan review required by changes, additions or revisions to approved plans = \$15.00 per hour (minimum charge one half hour).
5. Electrical code book assessment (minimum \$10.00).

Approval for the work under this permit will be given only after refuse and debris have been removed from job site and public right of way.

I hereby certify that I have carefully examined and read the above application; that the same is true and correct; and that the work herein described is to be done in accordance with all the provisions of the applicable Ordinances of the City of Las Vegas, Nevada and the State Laws, whether herein specified or not. City Master Card No. _____

SIGNED: C.W. Boulton Date: _____
Master (Electrician) (Technician) (Owner)

BUILDING DIVISION

PERMIT NO. 8134-1 PERMIT FEE \$ 16.50

2360-2402 (3/82)

RECEIPT

JACKIE B.

2-6-86

OWNER C.W. Paulton ADDRESS 4617 Fulton Pl.

DATE 3-15-83 GEN. CONT. Owner

TYPE OF STRUCTURE Y.M. Add: 8134 FINAL INSPECTION

LEGAL DESCRIPTION 1/2 22 Fulton LOG NO. AREA NO.

APPROVED FOR OCCUPANCY & METER

BUILDING

MECHANICAL

Investigation	Plumbing Cont.
Location & Plotting	Permit No. Date
Concrete Slab Floor	Heat & Vent. A/C Cont.
Fireplace Footing	Permit No. Date
Chimney Steel	Sewer Cont.
Vert. Steel Reinf.	Permit No. Date
Horiz. Steel Reinf.	Rough Soil
Framing	Rough Water
Ext. Lath	Top-Out
Ext. Brown	Rough Gas
Drywall	A/C Rough Duct
Final Building	Final Plumbing
Appr. for Occu.	Final Gas

ELECTRICAL

Temp. Pole Cont.	Final Air Cond.
Permit No. Date	Final Sewer
Inspection Date	REMARKS
Electrical Cont. Owner	OK Permit # 87779
Permit No. 8134-1	Owner
Rough	3-15-83
Final Rough	PLEASE NOTE ADDITIONAL REMARKS ON REVERSE SIDE.
Final Electrical	DEPT. OF BLDG. & SAFETY
Temporary Service	CITY OF LAS VEGAS
	REV: 82-3-29