

429 Falcon Lane

L-10 B-1 Sub Char Hgts Est Tr#1 Z-R-1

Glenn Saterwaal May 16, 1967

1967
CITY OF LAS VEGAS, NEVADA

LOG NO. & AREA

CONST. VAL. \$

1,000.00

DEPARTMENT OF BUILDING & SAFETY

APPLICATION & BUILDING PERMIT — for:
Dwellings, Duplexes, Misc. Residential Const.

ADDRESS OF
CONSTRUCTION:

429 Falcon Lane

OWNER: Don & Phyllis Fuller

LOT(s)

BLOCK

SUBDIVISION

Char. Est. Tr. # 1

ZONE

R-1

Existing structure on lot: Dwelling ☒ Accessory bldgs. ☐ Vacant lot ☐ Other ☐

PROPOSED CONSTRUCTION:

Enclose Garage

USE: Fam. Rm.

MATERIALS OF CONSTRUCTION: Wood Frame ☒ Concrete Block ☐ Reinforced Concrete ☐ Steel Frame ☐

SQUARE FEET OF FLOOR AREAS: 1st 2nd 3rd Other TOTAL SQ. FT. 400

FIRE ZONE: 1 2 3 Occupancy Group A B C D E F G H I J-1-2-3-4-5

CONST. TYPE: I II III IV V

ARCHITECT:

ENGINEER:

NO. of UNITS

NO. of STORIES

Plans Submitted: Yes ☐ No ☐

Calculations Submitted: Yes ☐ No ☐

Sewer Fee Req'd: Yes ☐ No ☐


CONTRACTOR:

Owner

STATE
LICENSE #

CITY
LICENSE #

ADD'L. PERMITS REQ'D: Air Cond. ☐ Elec. ☒ Plumbing ☐ Signs ☐ Paving ☐ Fence ☐ Public Walks ☐ Curb-gutters ☐
Incinerators ☐ Fire Sprinkling System ☐

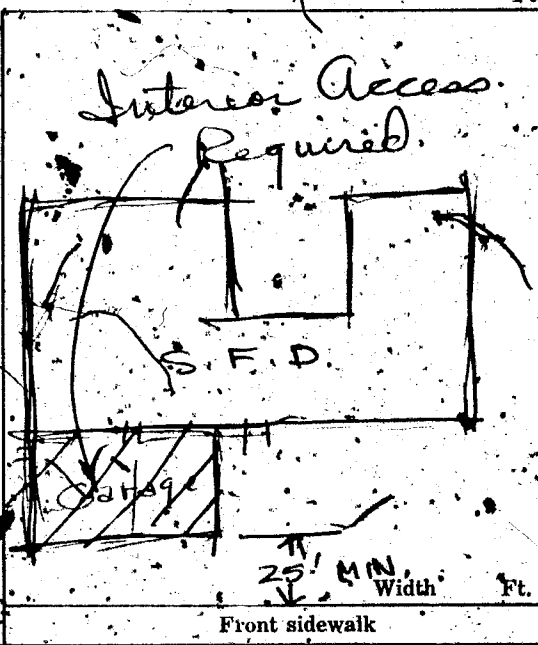

CONDITIONS OF THE PERMIT:

1. I agree to call the City Building Department for inspections before concrete is poured, before rough wiring, electrical, plumbing, framing is covered. Also for Air conditioning, sheet rock and sheathing inspection.
2. I agree that when the job is completed that I will call for final inspection before occupancy.
3. I agree to perform all construction in accordance with City Ordinances and Building Codes.
4. The Contractor's signature below denotes authority from the owner to sign in his behalf and that the owner is aware of all requirements of this application and permit. Separate permits must be taken out for work defined above this agreement.
5. I have read and understand the contents of this application and permit. I hereby state that the information I have supplied on this application is true and correct.

SIGNED:

Contractor

BY:

Phyllis Fuller

Agent or Owner

CLARK COUNTY HEALTH DEPT.

LAS VEGAS FIRE DEPARTMENT

RECEIPT

177. \$009.00 - 8

CITY OF LAS VEGAS
DEPT. OF
BUILDING & SAFETY

MUST BE MACHINE VALIDATED

- 8 AUG 67

PLANNING DEPT:

Date:

8-7-67

ENGINEERING DEPT:

Date:

8-7-67

BUILDING DEPT:

Date:

900

#1285

PERMIT NO:

38399

PERMIT FEE \$

900

Glenn National May 16, 1979

1967
CITY OF LAS VEGAS, NEVADA

LOG NO. & AREA

CONST. VAL. \$ 1,000.00

DEPARTMENT OF BUILDING & SAFETY

APPLICATION & BUILDING PERMIT — for:
Dwellings, Duplexes, Misc. Residential Const.

ADDRESS OF
CONSTRUCTION:

429 Falcon Lane

OWNER: Don & Phyllis Fuller

LOT(s)

BLOCK

SUBDIVISION

Char. Est. Tr. # 1

ZONE: R-1

Existing structure on lot: Dwelling ☒ Accessory bldgs. ☐ Vacant lot ☐ Other ☐

PROPOSED CONSTRUCTION:

Enclose Garage

USE: Fam. Rm.

MATERIALS OF CONSTRUCTION: Wood Frame ☒ Concrete Block ☐ Reinforced Concrete ☐ Steel Frame ☐

SQUARE FEET OF FLOOR AREAS: 1st 2nd 3rd Other TOTAL SQ. FT. 400

FIRE ZONE: 1 2 3 Occupancy Group A B C D E F G H I J-1-2-3-4-5 CONST. TYPE: I II III IV V

ARCHITECT:

ENGINEER:

NO. of UNITS

NO. of STORIES

Plans Submitted: Yes ☐ No ☐

Calculations Submitted: Yes ☐ No ☐

Sewer Fee Req'd: Yes ☐ No ☐

CONTRACTOR:

owner

STATE
LICENSE #

CITY
LICENSE #

ADD'L. PERMITS REQ'D: Air Cond. ☐ Elec. ☒ Plumbing ☐ Signs ☐ Paving ☐ Fence ☐ Public Walks ☐ Curb-gutters ☐
Incinerators ☐ Fire Sprinkling System ☐

CONDITIONS OF THE PERMIT:

1. I agree to call the City Building Department for inspections before concrete is poured, before rough wiring, electrical, plumbing, framing is covered. Also for Air conditioning, sheet rock and sheathing inspection.
2. I agree that when the job is completed that I will call for final inspection before occupancy.
3. I agree to perform all construction in accordance with City Ordinances and Building Codes.
4. The Contractor's signature below denotes authority from the owner to sign in his behalf that the owner is aware of all requirements of this application and permit. Separate permits must be taken out for work defined above this agreement.
5. I have read and understand the contents of this application and permit. I hereby state that the information I have supplied on this application is true and correct.

SIGNED:

Contractor

BY:

Phyllis Fuller

Agent or Owner

CLARK COUNTY HEALTH DEPT

Date

LAS VEGAS FIRE DEPARTMENT

Date

PLANNING DEPT:

Date:

8-7-67

ENGINEERING DEPT:

Date:

8-7-67

BUILDING DEPT:

Date:

9-00

#1285

PERMIT NO:

38399

PERMIT FEE \$

RECEIPT

177. \$009.00 - 8

CITY OF LAS VEGAS
DEPT. OF
BUILDING & SAFETY

MUST BE MACHINE VALIDATED

- 8 AUG 67

Gloria Gatoval May 14 1978

CITY OF LAS VEGAS, NEVADA

LOG NO. & AREA

DEPARTMENT OF BUILDING & SAFETY

CONST. VAL. \$

APPLICATION & BUILDING PERMIT — for:

Dwellings, Duplexes, Misc. Residential Const.

ADDRESS OF CONSTRUCTION:

OWNER:

LOT(s)

BLOCK

SUBDIVISION

ZONE:

Existing structure on lot: Dwelling



Accessory bldgs.



Vacant lot



Other



PROPOSED CONSTRUCTION:

USE:

MATERIALS OF CONSTRUCTION:

Wood Frame



Concrete Block



Reinforced Concrete



Steel Frame



SQ. FEET OF FLOOR AREAS:

1st

2nd

3rd

Other

TOTAL SQ. FT.

FIRE ZONE: 1 2 3

Occupancy Group 1 1-2

CONST. TYPE

I II III IV V

ARCHITECT:

ENGINEER:

NO. of UNITS

NO. of STORIES

Plans Submitted:

Yes



No

Calculations Submitted

Yes



No

Sewer Fee Req'd.

Yes



No



CONTRACTOR:

STATE LICENSE #

CITY LICENSE #

ADD'L. PERMITS REQ'D:

Air Cond.



Elec.



Plumbing



Signs



Paving




Fence



Public Walks



Curb gutters

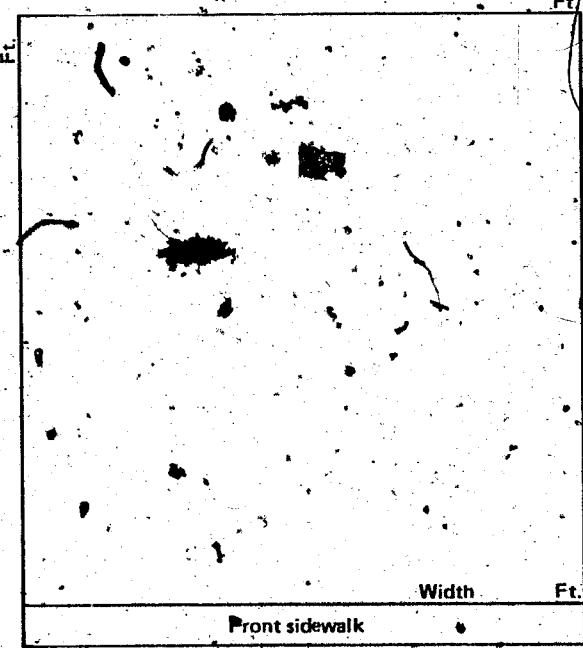

CONDITIONS OF THE PERMIT:

1. I agree to call the City Building Department for inspections before concrete is poured, before rough wiring, electrical, plumbing, framing is covered. Also for air conditioning, sheet-rock and sheathing inspection.
2. I agree that when the job is completed that I will call for final inspection before occupancy.
3. I agree to perform all construction in accordance with City Ordinances and Building Codes.
4. The Contractor's signature below denotes authority from the owner to sign in behalf and that the owner is aware of all requirements of this application and permit. Separate permits must be taken out for work outlined above this agreement.
5. I have read and understand the contents of this application and permit. I hereby state that the information I have supplied on this application is true and correct.

Approval for the work under this permit will be given only after refuse and debris have been removed from job site and public right of way.

SIGNED:

Contractor

BY:

Agent or Owner

CLARK COUNTY HEALTH DEPT.

Date:

LAS VEGAS FIRE DEPARTMENT

Date:

PLANNING DEPT.:

Date:

PUBLIC WORKS DEPT.:

Date:

BUILDING DEPT.:

Date:

12850

PERMIT NO.:

PERMIT FEE \$

RECEIPT

469 \$005.00

CITY OF LAS VEGAS

DEPT. OF BUILDING & SAFETY

MUST BE MACHINE VALIDATED

24 JAN 75

DEPT. of BLDG & SAFETY—CITY of LAS VEGAS, NEVADA
OWNER: CASADA RILEY ENTERPRISES ADDRESS: 429 Falcon Lane DATE: 12-28-61
GEN. CONT: Ken Riley TYPE OF STRUCTURE: conc blk fence
PERMIT NO. 7173 LEGAL DESCRIPTION:

BUILDING		MECHANICAL		ELECTRICAL	

APPROVED FOR OCCUPANCY
APPROVED FOR METER
PLEASE NOTE REMARKS ON REVERSE SIDE

429 Falcon Lane

DEPT. of BLDG & SAFETY—CITY of LAS VEGAS, NEVADA
OWNER: CASADA RILEY ENTERPRISES ADDRESS: 429 Falcon Lane DATE: 11-6-61
GEN. CONT: Kenneth E. Riley TYPE OF STRUCTURE: S.F. Dwl.
PERMIT NO. 6618 LEGAL DESCRIPTION: Lot 12 Block 1 Charleston Estates #1

BUILDING		MECHANICAL		ELECTRICAL	

APPROVED FOR OCCUPANCY
APPROVED FOR METER
PLEASE NOTE REMARKS ON REVERSE SIDE

429 Falcon Lane

T-56

DEPT. of BLDG & SAFETY—CITY of LAS VEGAS, NEVADA
OWNER: CANADA RILEY ENTERPRISES ADDRESS: 429 Falcon Lane DATE: 12-28-61
GEN. CONT. Ken Riley TYPE OF STRUCTURE: conc blk fence
PERMIT NO. 7173 LEGAL DESCRIPTION:

BUILDING		MECHANICAL		ELECTRICAL	
LOCATION	429-262	PLUMBING CONT.		TEMP. POLE CONT.	
FIREPLACE FTG.		PERMIT NO.	DATE	PERMIT NO.	DATE
FOOTINGS	O.B. 3/8	HEAT & VENT. AC CONT.		INSPECTION	DATE
FOUNDATION WALL		PERMIT NO.	DATE	ELECTRICAL CONT.	
STEM WALL		SEWER CONT.		PERMIT NO.	DATE
FLOOR FRAMING		PERMIT NO.	DATE	FIXTURES CONT.	
SLAB		ROUGH SOIL		PERMIT NO.	DATE
CHIMNEY STEEL (FIREPLACE)		ROUGH WATER		SLAB	
WALL STEEL		TOP-OUT		ROUGH	
COLUMN STEEL		ROUGH GAS		FINAL ROUGH	
BEAM STEEL		AC ROUGH DUCT		FINAL FIXTURE	
STEEL FABRICATION	O.B. 3/8	REF. ROUGH PIPING		TEMPORARY SERVICE	
FRAMING		FINAL PLUMBING		MISCELLANEOUS	
ROOF SHEATHING		FINAL GAS		URBAN REDEVELOPMENT APPROVAL	
INTERIOR		FINAL AIR COND.			
EXTERIOR		FINAL REFRIG.			
DRYWALL		FINAL SEWER			
LATHING		FINAL SEPTIC TANK			
BACKING (SIDING)					
PLASTER	SCRATCH				
BROWN	O.B. 3/8				
FINAL BLDG	DATE				

APPROVED FOR OCCUPANCY
APPROVED FOR METER
PLEASE NOTE REMARKS ON REVERSE SIDE

429 Falcon Lane

DEPT. of BLDG & SAFETY—CITY of LAS VEGAS, NEVADA
OWNER: CANADA RILEY ENTERPRISES ADDRESS: 429 Falcon Lane DATE: 11-6-61
GEN. CONT. Kenneth E. Riley TYPE OF STRUCTURE: S.F. Dwl.
PERMIT NO. 6618 LEGAL DESCRIPTION: Lot 10 Block 1 Charleston Estates #1

BUILDING		MECHANICAL		ELECTRICAL	
LOCATION	O.B. 1-4-62	PLUMBING CONT.		TEMP. POLE CONT.	
FIREPLACE FTG.	O.B. 1-26-62	PERMIT NO.	DATE	PERMIT NO.	DATE
FOOTINGS	O.B. 1-4-62	HEAT & VENT. AC CONT.		INSPECTION	DATE
FOUNDATION WALL	O.B. 1-4-62	PERMIT NO.	DATE	ELECTRICAL CONT.	
STEM WALL		SEWER CONT.		PERMIT NO.	DATE
FLOOR FRAMING		PERMIT NO.	DATE	FIXTURES CONT.	
SLAB	O.B. 1-4-62 - 1-10-62	ROUGH SOIL		PERMIT NO.	DATE
CHIMNEY STEEL (FIREPLACE)		ROUGH WATER		SLAB	
WALL STEEL		TOP-OUT		ROUGH	
COLUMN STEEL		ROUGH GAS		FINAL ROUGH	
BEAM STEEL		AC ROUGH DUCT		FINAL FIXTURE	
STEEL FABRICATION		REF. ROUGH PIPING		TEMPORARY SERVICE	
FRAMING		FINAL PLUMBING		MISCELLANEOUS	
ROOF SHEATHING	O.B. 1-30-62	FINAL GAS		URBAN REDEVELOPMENT APPROVAL	
INTERIOR		FINAL AIR COND.			
EXTERIOR		FINAL REFRIG.			
DRYWALL		FINAL SEWER			
LATHING		FINAL SEPTIC TANK			
BACKING (SIDING)					
PLASTER	SCRATCH				
BROWN	O.B. 1-26-62				
FINAL BLDG	DATE				

APPROVED FOR OCCUPANCY
APPROVED FOR METER
PLEASE NOTE REMARKS ON REVERSE SIDE

429 Falcon Lane

T-56

DEPT. of BLDG & SAFETY—CITY of LAS VEGAS, NEVADA

OWNER Don Fuller
GEN. CONT. Owner
PERMIT NO. 38399

ADDRESS 429 Falcon Lane

DATE 8/7/67

TYPE OF STRUCTURE Enc Garage

LEGAL DESCRIPTION L-10 B 1 Charleston Estates #1

BUILDING		MECHANICAL		ELECTRICAL	
LOCATION		PLUMBING CONT.		TEMP. POLE CONT.	
FIREPLACE FTS.		PERMIT NO.	DATE	PERMIT NO.	DATE
FOOTINGS		HEAT & VENT. AC CONT.		INSPECTION	DATE
FOUNDATION WALL		PERMIT NO.	DATE	ELECTRICAL CONT.	
FLOOR FRAMING		SEWER CONT.		PERMIT NO.	DATE
SLAB		PERMIT NO.	DATE	FIXTURES CONT.	
CHIMNEY STEEL (FIREPLACE)		ROUGH SOIL		PERMIT NO.	DATE
WALL STEEL		ROUGH WATER		SLAB	
COLUMN STEEL		TOP-OUT		ROUGH	
BEAM STEEL		ROUGH GAS		FINAL ROUGH	
FRAMING		AC ROUGH DUCT		FINAL FIXTURE	
ROOF SHEATHING		REF. ROUGH PIPING		FINAL ELECTRICAL	
INTERIOR		FINAL PLUMBING		TEMPORARY SERVICE	
EXTERIOR		FINAL GAS			
DRYWALL		FINAL AIR COND.		MISCELLANEOUS	
LATHING		FINAL REFRIG.		GRADING & DRAINAGE	
BACKING (SIDING)		FINAL SEWER		ON-SITE PARKING SPACES	
PLASTER		FINAL SEPTIC TANK		ENG. APPROVAL OF	
SCRATCH				OFF-SITE IMPROVEMENTS	
BROWN					
URBAN REDEVELOPMENT APPROVAL					
FINAL BLDG	DATE				

APPROVED FOR OCCUPANCY & METER
PLEASE NOTE REMARKS ON REVERSE SIDE 429 Falcon Lane

LOG #

AREA #

23.04

DEPT. of BLDG & SAFETY—CITY of LAS VEGAS, NEVADA

OWNER Don Fuller
GEN. CONT. Anthony Pools
PERMIT NO. 24663

ADDRESS 429 Falcon Lane

DATE 4-6-64

TYPE OF STRUCTURE pool

LEGAL DESCRIPTION

BUILDING		MECHANICAL		ELECTRICAL	
LOCATION		PLUMBING CONT.		TEMP. POLE CONT.	
FIREPLACE FTS.		PERMIT NO. <u>15396</u>	DATE <u>4-9-64</u>	PERMIT NO.	DATE
FOOTINGS		HEAT & VENT. AC CONT.		INSPECTION	DATE
FOUNDATION WALL		PERMIT NO.	DATE	ELECTRICAL CONT.	
FLOOR FRAMING		SEWER CONT.		PERMIT NO.	DATE
SLAB		PERMIT NO.	DATE	FIXTURES CONT.	
CHIMNEY STEEL (FIREPLACE)		ROUGH SOIL		PERMIT NO.	DATE
WALL STEEL <u># 11</u>	<u>4-14-64</u>	ROUGH WATER	<u>4-15-64</u>	SLAB	<u>4-13-64</u>
COLUMN STEEL		TOP-OUT		ROUGH	
BEAM STEEL		ROUGH GAS		FINAL ROUGH	
FRAMING		AC ROUGH DUCT		FINAL FIXTURE	
ROOF SHEATHING		REF. ROUGH PIPING		FINAL ELECTRICAL	<u>West 5-14-64</u>
INTERIOR		FINAL PLUMBING	<u>4-15-64</u>	TEMPORARY SERVICE	
EXTERIOR		FINAL GAS			
DRYWALL		FINAL AIR COND.		MISCELLANEOUS	
LATHING		FINAL REFRIG.		GRADING & DRAINAGE	
BACKING (SIDING)		FINAL SEWER		ON-SITE PARKING SPACES	
PLASTER		FINAL SEPTIC TANK		ENG. APPROVAL OF	
SCRATCH				OFF-SITE IMPROVEMENTS	
BROWN					
URBAN REDEVELOPMENT APPROVAL					
FINAL BLDG	DATE <u>7-22-67</u>				

APPROVED FOR OCCUPANCY & METER
PLEASE NOTE REMARKS ON REVERSE SIDE

LOG #

AREA #

23.04

429 Falcon Lane

M 291

4

DEPT. of BLDG. & SAFETY - CITY of LAS VEGAS, NEVADA

OWNER Jenny Ray
 GEN. CONT. Chief Roof
 PERMIT NO. 182

ADDRESS 429 Falcon

DATE 1-24-75

TYPE OF STRUCTURE Roofing

BUILDING	MECHANICAL	ELECTRICAL
Investigation	Plumbing Cont. _____ Date _____	Temp. pole cont. _____ Date _____
Location & Footing	Permit No. _____	Permit No. _____ Date _____
Stem Wall	Heat & Vent. A/C Cont. _____ Date _____	Inspection _____ Date _____
Concrete Slab Floor	Permit No. _____	Electrical Cont. _____ Date _____
Floor Framing	Sewer Cont. _____ Date _____	Permit No. _____
Fireplace Footing	Permit No. _____	Fixtures Cont. _____ Date _____
Chimney Steel	Rough Soil _____	Permit No. _____
Vert. Steel Reinf.	Rough Water _____	Slab _____
Horiz. Steel Reinf.	Top-Out _____	Rough _____
Roof Sheathing	Rough Gas _____	Final Rough _____
Framing	A/C Rough Duct _____	Final Fixture _____
Backing for siding	Ref. Rough Piping _____	Final Electrical _____
Ext. Lath	Final Plumbing _____	Temporary Service _____
Ext. Scratch	Final Gas _____	MISCELLANEOUS
Ext. Brown	Final Air Cond. _____	Grading & Drainage _____
Int. Lath	Final Refrig. _____	On-Site Parking Spaces _____ App. _____
Int. Brown	Final Sewer _____	Eng. Approval of _____
Drywall	Final Septic Tank _____	Off-Site Improvements _____
Permit No. _____		
Final Building		
Appr. for Occu. _____		

INSPECTOR: _____

DATE _____

APPROVED FOR OCCUPANCY & METER

PLEASE NOTE REMARKS ON REVERSE SIDE

429 Falcon

LOG # _____

AREA # _____