

5908 Eugene Ave.

L-283 B-3 SUB CHAR HGTS #50- C Zone R-1 S.F.D.

Sharon Pereira 4/19/79

CITY OF LAS VEGAS, NEVADA
DEPARTMENT OF BUILDING AND SAFETY
APPLICATION FOR FENCE, WALL OR
RETAINING WALL


LOG NO. _____
AREA: _____
KARDEX CARD: _____
TELEPHONE: _____
CONSTRUCTION VALUATION: 245
INSPECTION VALUATION: 195
PERMIT FEE: 4
PERMIT NUMBER: 33400
DATE: 4/18/66 19__

ADDRESS OF CONSTRUCTION: 3908 EUGENE
OWNER'S NAME: Glenn Dodd
OWNER'S ADDRESS: _____
Lot (s) 283 Block 3 Subdivision CHAS. HGTS # SOC Zone: R-1

Materials of Concrete Construction: Block () Concrete () Wire () Wood () Other ()
Total Square Feet: _____ Total Lineal Feet: 175

CONTRACTOR'S NAME: OWNER
STATE LICENSE # _____ CITY LICENSE # _____
Architect's Name: _____ PLANS SUBMITTED: Yes No
Engineer's Name: _____ CALCULATIONS: Yes No

Street Name: EUGENE AVE.
Front Yard: _____ Feet

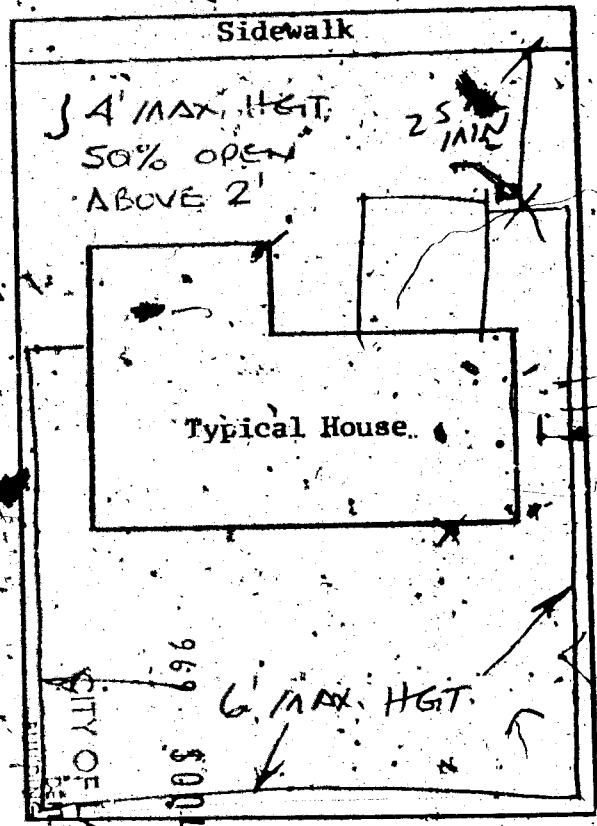

18 APR 66

Rear Yard Length: _____ Feet

I understand that any portion of this (fence) (wall) constructed or erected on City property or right-of-way will be removed from said location at my expense upon request received from the City of Las Vegas, Nevada. I understand that the (fence) (wall) shall not enclose water meter, light standard, fire alarm box and shall not come closer than two (2') feet in any direction from any fire hydrant. I further state that I am familiar with effective Ordinances of the City of Las Vegas, Nev. and effective Statutes of the State of Nevada covering construction and use of above type; I agree to perform said construction in conformity therewith. I further agree that issuance of a permit on above application will not excuse me from conforming with said Ordinances and Statutes, despite any errors on the part of the Building Inspector or Engineer in checking plans and applications herewith submitted.

I have read and understand the contents of above application; I hereby state that same are true and correct.

SIGN HERE: Glenn Dodd
By: _____

APPROVED BY: [Signature] DATE: 4/18/66
PLANNING DEPT. & CODE ASSISTANCE

FIRE DEPARTMENT DATE: _____

ENGINEERING DEPT. DATE: _____

BUILDING & SAFETY DEPT. DATE: 4/18/66

23.14

Note: Owner or Contractor must call for all inspections required.

Sharon Pereira 4/19/79

CITY OF LAS VEGAS, NEVADA
DEPARTMENT OF BUILDING AND SAFETY
APPLICATION FOR FENCE, WALL OR
RETAINING WALL

LOG NO. _____
AREA: _____
KARDEX CARD: _____
TELEPHONE: _____
CONSTRUCTION VALUATION: 245
INSPECTION VALUATION: 195
PERMIT FEE: 4
PERMIT NUMBER: 33406
DATE: 4/18/79

ADDRESS OF CONSTRUCTION: 3908 EUGENE
OWNER'S NAME: Glenn Dodd
OWNER'S ADDRESS: _____
Lot (s) 283 Block 3 Subdivision CHAS. HEAT # SOC Zone: R-1

Materials of Construction: Block () Concrete () Wire () Wood () Other ()
Total Square Feet: _____ Total Lineal Feet: 175

CONTRACTOR'S NAME: OWNER
STATE: _____ CITY: _____
LICENSE #: _____ LICENSE #: _____


Architect's Name: _____ PLANS SUBMITTED: Yes No
Engineer's Name: _____ CALCULATIONS: Yes No

Street Name: EUGENE AVE.
Front Yard: _____ Feet

I understand that any portion of this (fence) (wall) constructed or erected on City property or right-of-way will be removed from said location at my expense upon request received from the City of Las Vegas, Nevada. I understand that the (fence) (wall) shall not enclose water meter, light standard, fire alarm box and shall not come closer than two (2') feet in any direction from any fire hydrant. I further state that I am familiar with effective Ordinances of the City of Las Vegas, Nev. and effective Statutes of the State of Nevada covering construction and use of above type; I agree to perform said construction in conformity therewith. I further agree that issuance of a permit on above application will not excuse me from conforming with said Ordinances and Statutes, despite any errors on the part of the Building Inspector or Engineer in checking plans and applications herewith submitted.

I have read and understand the contents of above application; I hereby state that same are true and correct.

SIGN HERE: _____
By: _____

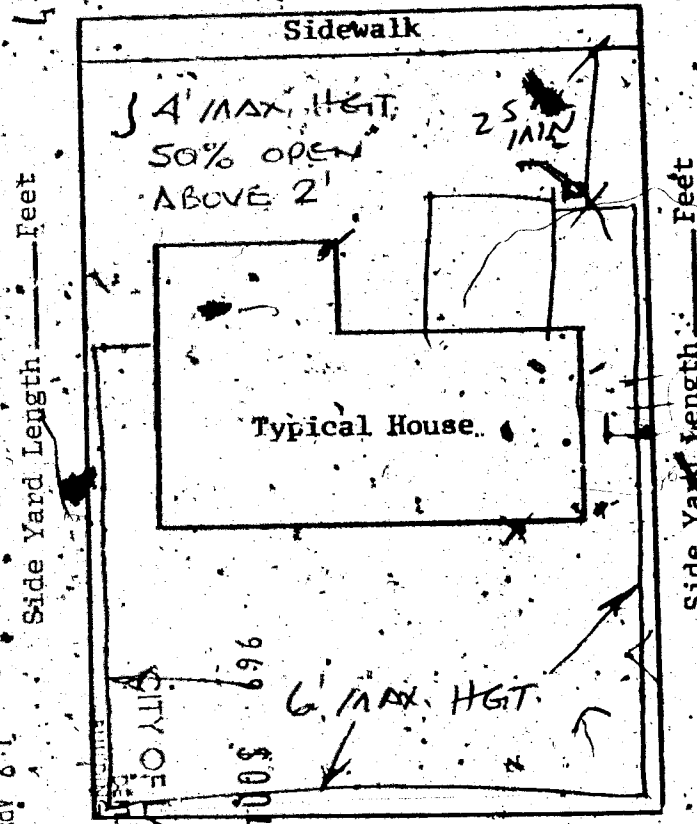

Side Yard Length: _____ Feet
Side Yard Length: _____ Feet
Rear Yard: _____ Feet

APPROVED BY: _____ DATE: 4/18/79
PLANNING DEPT. & CODE ASSISTANCE
FIRE DEPARTMENT DATE:
ENGINEERING DEPT. DATE:
BUILDING & SAFETY DEPT. DATE: 4/18/79

23.14 Note: Owner or Contractor must call for all inspections required.

Done 11-9-81

DEPT. of BLDG. & SAFETY - CITY of LAS VEGAS, NEVADA

OWNER Sproul Homes ADDRESS 5908 Eugene DATE 10-16-64
GEN. CONT. Same TYPE OF STRUCTURE SFD
PERMIT NO. 211 LEGAL DESCRIPTION Lot 283 Blk 3 Chas Hts. 50C

BUILDING	MECHANICAL	ELECTRICAL
LOCATION <u>283 70-15-64</u>	PLUMBING CONT. <u>10-15-64</u>	TEMP. POLE CONT. _____
FIREPLACE PTS. _____	PERMIT NO. <u>16845</u> DATE <u>10-15-64</u>	PERMIT NO. _____ DATE _____
FOOTINGS <u>10-15-64</u>	HEAT & VENT. AC CONT. <u>10-28-64</u>	INSPECTION _____ DATE _____
FOUNDATION WALL <u>10-28-64</u>	PERMIT NO. <u>12788</u> DATE <u>10-28-64</u>	ELECTRICAL CONT. <u>10-28-64</u>
FLOOR FRAMING _____	SEWER CONT. <u>10-28-64</u>	PERMIT NO. <u>1808</u> DATE <u>10-28-64</u>
SLAB <u>10-28-64</u>	PERMIT NO. <u>16845</u> DATE <u>10-15-64</u>	FIXTURES CONT. <u>10-28-64</u>
CHIMNEY STEEL (FIREPLACE) _____	ROUGH SOIL <u>10-28-64</u>	PERMIT NO. <u>1808</u> DATE <u>10-28-64</u>
WALL STEEL _____	ROUGH WATER <u>10-28-64</u>	SLAB _____
COLUMN STEEL _____	ROUGH GAS <u>10-28-64</u>	ROUGH _____
BEAM STEEL _____	AC ROUGH DUCT <u>10-28-64</u>	FINAL ROUGH _____
FRAMING _____	REF. ROUGH PIPING _____	FINAL FIXTURE _____
ROOF SHEATHING _____	FINAL PLUMBING <u>12-21-64</u>	FINAL ELECTRICAL _____
DRYWALL _____	FINAL GAS _____	TEMPORARY SERVICE _____
LATHING _____	FINAL AIR COND. <u>12-21-64</u>	
BACKING (SIDING) _____	FINAL REFRIG. _____	
PLASTER SCRATCH _____	FINAL SEWER <u>11-18-64</u>	
PLASTER BROWN _____	FINAL SEPTIC TANK _____	
URBAN REDEVELOPMENT APPROVAL _____		
FINAL BLDG _____ DATE _____		

APPROVED FOR OCCUPANCY METER _____ INSPECTOR _____ DATE _____
PLEASE NOTE REMARKS ON REVERSE SIDE 5908 Eugene LOG # 1 32 AREA # 23.04

DEPARTMENT OF BUILDING & SAFETY
CITY OF LAS VEGAS, NEVADA

KARDEX CARD
FENCE & RETAINING
WALLS

OWNER Glenn Dodd ADDRESS 5908 Eugene DATE 4/18/66

CONTRACTOR Owner PERMIT NO. 33400

LOT 283 BLOCK 3 SUBDIVISION Chas. Hts. #50C
Wood fence

Fence (wire, wood, etc.)	Walls (masonry, rock, etc.)
Location <u>283 4-23-66 5-23-66</u>	Location _____
Final Inspection <u>5-23-66</u>	Footings _____
	Wall Steel 1st _____ 2d _____ 3d _____
	Final Inspection _____
Retaining Wall (masonry)	Retaining Wall (concrete)
Location _____	Location _____
Footings _____	Footings _____
Wall Steel 1st _____ 2d _____ 3d _____	Wall Steel 1st _____ 2d _____ 3d _____
Bond Beam 1st _____ 2d _____ 3d _____	Final Inspection _____
Final Inspection _____	

23.14 B ADDRESS 5908 Eugene LOG NO. _____ AREA 4