

500 N. F. Street

Marion Leena April 27, 1979

Log No.

M-132

CITY OF LAS VEGAS, NEVADA

Cons. Valuation \$

5376.00

DEPARTMENT OF BUILDING & SAFETY - SIGN APPLICATION & PERMIT

ADDRESS OF CONSTRUCTION:

500 N. F STREET

SIGN OWNER:

DANREY OUTDOOR ADV. Co.

SIGN CONTRACTOR:

DANREY OUTDOOR ADV. Co.

STATE LICENSE #

7163

CITY LICENSE #

103

PROPERTY OWNER'S NAME:


Upland Industries Co. T. D. J.

ZONE:

M

TYPE	SIZE	HEIGHT ZONE			VALUATION	PERMIT FEE
		A Up to 30'	B Over 30' up to 50'	C Over 50'		
BILLBOARD - NON-ELECTRIFIED:						
Single faced freestanding	sq. ft. @	\$ 4.00	\$ 6.00	\$ 8.00	\$	\$
Single faced roof, marquee or projecting	sq. ft. @	\$ 5.00	\$ 7.00	\$ 9.00	\$	\$
Double faced or V-type freestanding	sq. ft. @	\$ 6.00	\$ 8.00	\$ 10.00	\$ 5376	\$ 39.00
Double faced or V-type on roof, marquee or projected	sq. ft. @	\$ 8.00	\$ 10.00	\$ 12.00	\$	\$
NEON OR OTHER ELECTRIFIED:						
Single faced	sq. ft. @	\$ 12.00	\$ 14.00	\$ 16.00	\$	\$
Double faced	sq. ft. @	\$ 16.00	\$ 18.00	\$ 20.00	\$	\$
For sign not included above use construction valuation						
Political Signs						\$ 25.00
Sign 25 sq. ft. or less						\$ 5.00

EXISTING SIGN

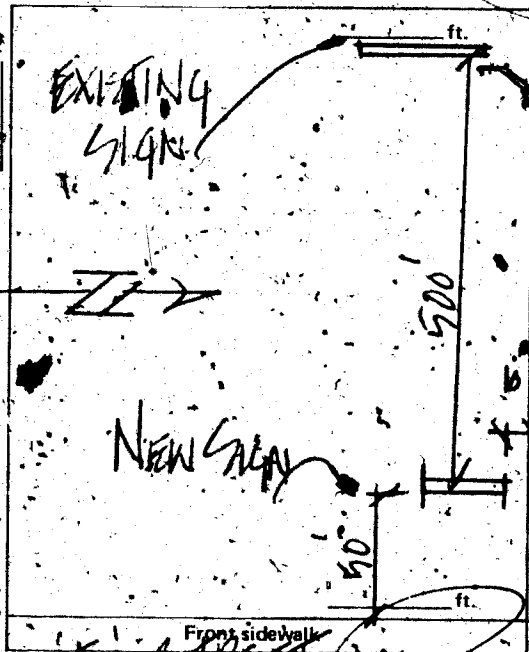

MATERIAL FOR SIGN:

Metal ☒ Wood ☐ Plastic ☐ Other ☐

TYPE OF PROJECT:

New Sign ☒ Replacement ☐ Relocation ☐

CONDITION OF THE PERMIT:

I hereby certify that I have carefully examined and read the above application; that the same is true and correct and that the work herein described is to be in accordance with all provisions of the applicable Ordinances of the City of Las Vegas and State Laws whether specified or not.

Master Neon Elec. Billboard Contractor

Date: 4/1/76

PLANNING DEPT.

Approved based on sign questionnaire attached

PUBLIC WORKS DEPT.

BUILDING DEPT.

Date:

Date:

Date:

PERMIT No.

1772

PERMIT FEE \$

39.00

9713 \$039.00 - 5

RECEIPT

CITY OF LAS VEGAS

DEPT. OF BUILDING & SAFETY

MUST BE MACHINE VALIDATED

7 APR 76

288

382-5000

various 4-31-76 to 55' up

Planner's Dept

Maion Greva April 27, 1979

CITY OF LAS VEGAS, NEVADA

DEPARTMENT OF BUILDING & SAFETY - ELECTRICAL APPLICATION & PERMIT

ADDRESS OF CONSTRUCTION: 500 No. F ST. (U.P. RAILROAD PROPERTY) OWNER'S NAME: DONREY OUTDOOR ADU, CO.

CIRCLE New Bldg.; Add'n.; Remodel; TYPE OF BLDG.: SFD. APT. PUBLIC COMM.

CONTRACTOR'S NAME: ACES FOUR ELECTRIC

STATE LICENSE # 12546

CITY LICENSE # 534-2-13531

NUMBER	FIXTURE OR INSTALLATION	UNIT PRICE	TOTAL
	Rm addition, carport or garage enclosure	4.00	
	Temporary power	4.00	
<u>8</u>	Light, receptacle or switch outlet	.20	<u>1.60</u>
	Wall or ceiling space heater	.35	
	Garbage grinder outlet	.35	
	Dishwasher outlet	.35	
	Clothes dryer outlet	.35	
	Automatic clothes washer	.35	
	Electric range outlet	.35	
	Electric water heater outlet	.35	
	Special purpose outlet	.35	
	X-ray unit and its appurtenances	5.00	
	Watts of festoon lighting (Watts) First 3,000 watts for each additional thousand watts	4.00 1.50	
	Horsepower each motor first horsepower or less for each additional horsepower	1.75 .35	
	Electric service (including any single meter socket) for each additional socket	3.00 .35	
	Air conditioning service	1.50	
	Each KW(KVA) Generator (Transformer, Welder) First 100 KVA for each additional KW(KVA)	2.00 .01	
	Speaker, signal or alarm outlet	.15	
	Amplifiers	.50	
	Control panels	.25	
	Main control racks	1.00	
	T.V. and radio antennas-master system only	.75	
	Minimum fee for any permit	4.00	<u>4.00</u>
	TOTAL FEE		<u>4.00</u>

Approval for the work under this permit will be given only after refuse and debris have been removed from job site and public right of way.

I hereby certify that I have carefully examined and read the above application; that the same is true and correct; and that the work herein described is to be done in accordance with all the provisions of the applicable Ordinances of the City of Las Vegas, Nevada and State laws whether herein specified or not.

SIGNED [Signature] MASTER (ELECTRICIAN) (TECHNICIAN) (OWNER)

DATE 8/24/76

BUILDING DEPARTMENT [Signature]

DATE 8-25-76

#12860

PERMIT NO. 2066

PERMIT FEE: \$ 4.00

RECEIPT

6708 \$004.00 - 6

CITY OF LAS VEGAS

DEPT. OF BUILDING & SAFETY
MUST BE MACHINE VALIDATED

25 AUG 76

DEPARTMENT OF BUILDING & SAFETY
CITY OF LAS VEGAS, NEVADA

KARDEX CARD
SIGN

OWNER Upland Industriel ADDRESS 500 N. "F" St. DATE 4-7-76

CONTRACTOR Donrey Outdoor PERMIT NO. 1772

LOT _____ BLOCK _____ SUBDIVISION _____

LOCATION _____	ELECT. ROUGH _____
SHOP (WIRING, CONST.) _____	ELECT. FINAL _____
SITE (BLDG., ETC.) _____	<i>electrical 2046</i>
INST. (SERV: STRUCT.) _____	<i>August 8/25/76</i>
BILLBOARD _____	
ELECTRIFIED _____	
FINAL _____	

23.07 D ADDRESS 500 N. "F" St. LOC NO. _____ AREA M 132