

2013-15 ELM AVE.

L29 & 30 B5 Boulder Dam Homesite Tr #2 Zone R-1

H. Gatewood 4-9-79

CITY OF LAS VEGAS, NEVADA

CONST. VAL. \$ 1200⁰⁰

LOG NO. & AREA

DEPARTMENT OF BUILDING & SAFETY

APPLICATION & BUILDING PERMIT - For: Dwellings, Duplexes, Misc. Residential Const.

ADDRESS OF CONSTRUCTION: 2013 Elin

OWNER: Lee Smith

LOT(S): 29 & 30

BLOCK 5

SUBDIVISION

Bouldin Dam Site 2-#2

NE: R-1

Existing structure on lot: Dwelling Accessory, bldgs. Vacant lot Other

PROPOSED CONSTRUCTION: Car Port

USE: Same

MATERIALS OF CONSTRUCTION: Wood Frame Concrete Block Reinforced Concrete Steel Frame

SQUARE FEET OF FLOOR AREAS: 1st 2nd 3rd Other TOTAL SQ. FT. 800


FIRE ZONE: 1 2 3 Occupancy Group A B C D E F G H I J-1-2-3-4-5 CONST. TYPE: I II III IV V

ARCHITECT: ENGINEER: NO. of UNITS: NO. of STORIES:

Plans Submitted: Yes No Calculations Submitted: Yes No Sewer Fee Req'd: Yes No

CONTRACTOR: OWNER STATE LICENSE # CITY LICENSE #

ADD'L. PERMITS REQ'D: Air Cond. Elec. Plumbing Signs Paving Fence Public Walks Curb-gutters Incinerators Fire Sprinkling System

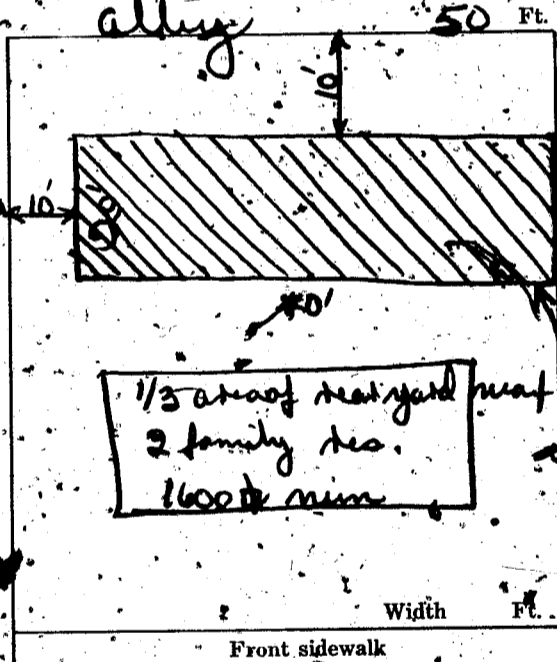

CONDITIONS OF THE PERMIT:

- I agree to call the City Building Department for inspections before concrete is poured, before rough wiring, electrical, plumbing, framing is covered. Also for Air conditioning, sheet-rock and sheathing inspection.
- I agree that when the job is completed that I will call for final inspection before occupancy.
- I agree to perform all construction in accordance with City Ordinances and Building Codes.
- The Contractor's signature below denotes authority from the owner to sign in his behalf and that the owner is aware of all requirements of this application and permit. Separate permits must be taken out for work outlined above this agreement.
- I have read and understand the contents of this application and permit; I hereby state that the information I have supplied on this application is true and correct.

SIGNED: Lee Smith Contractor

BY: Carl V. Youngberg Agent or

CLARK COUNTY HEALTH DEPT. Date LAS VEGAS FIRE DEPARTMENT Date

Note: Must be checked by Bldg. to go to property line

PLANNING DEPT: Date: 6-20-68

ENGINEERING DEPT: Date:

BUILDING DEPT: Date: 6-20-68

#1285 PERMIT NO: 43312 PERMIT FEE \$ 12⁰⁰

RECEIPT

1223 \$012.00 - 8

CITY OF LAS VEGAS

DEPT. OF BUILDING & SAFETY

MUST BE MACHINE VALIDATED.

20 JUN 68