

1204 EXLEY

W. Watwood 17-25-79

CITY OF LAS VEGAS, NEVADA
DEPARTMENT OF BUILDING & SAFETY

PERMIT FEE \$
APPLICATION & PERMIT FOR

JOB ADDRESS: 1204 Exley

OWNER'S NAME: Francisco Park Rentals

LQT BLOCK SUBDIVISION Bldg. type: SFD APT COMM

Circle: New bldg; ~~old bldg~~; Add'n; Remodel; Pool; Wtr. Sftner; Lawn Sprkr; Other

CONTRACTOR: Sterling Plumbing

State Lic. #7119 City Lic. #910

QUANTITY	FIXTURE OR INSTALLATION	Unit Price	AMOUNT
	Bathtub	1.00	
	Clothes dryer (gas)	1.00	
	Clothes washer	1.00	
	Dental unit	1.00	
	Dishwasher	1.00	
	Drinking fountain	1.00	
	Fire sprinkling - underground piping	5.00	
	Fire sprinkling - distribution piping per each foot	.01	
	Fire sprinkling heads - per each head	.10	
	Floor drain \$1.00 Floor sink	1.00	
	Gas appliance (any type)	1.00	
1	Gas piping system - single family dwelling	3.00	3.00
	Gas piping system - multiple family \$3 per each unit plus	1.00	
	Gas piping system - commercial bldg. per each floor	3.00	
	Grease trap	1.00	
	Irrigation system	4.00	
	Lavatory	1.00	
	Minimum fee for any permit	4.00	
	Piping, Drainage	4.00	
	Sewer replacement	4.00	
	Septic disposal system - Health Dept. approval required	4.00	
	Shower	1.00	
	Sink - kitchen type	1.00	
	Swimming pool - private - wading pool	8.00	
	Swimming pool - public - semi-public	12.00	
	Toilet	1.00	
	Urinal	1.00	
	Water distribution system - single family dwelling	4.00	
	Water distribution system - multiple dwg. \$4 + each unit	1.00	
	Water distribution system - Group "A" thru "G" per each floor	4.00	
	Water distribution system - Group "H" (hotel) \$4 + per bath	.50	
	Water heater (gas) (electric)	1.00	
	Water rising equipment	1.00	
	Water softener nonpermanent type	4.00	
	Water softener permanent (connected to drainage)	5.00	
	Wash tray	1.00	

I hereby certify that I have carefully examined & read the above application; that the same is true & correct; and the work herein described is to be done in accordance with the provisions of City of Las Vegas Ordinance & State Laws, whether herein specified or not. As defined in City Code and Ordinances.

SIGNED: *[Signature]* Date: 6/6/68
Registered Plumber Spec. Cont'r Owner

Engineering Dept. Date

Sewer Conn. Fees

Paid in Engr. Dept.

23.10

Building Department Date

PERMIT NO. 24009

PERMIT FEE \$400

#12870

TOTAL FEE \$ 4.00

RECEIPT

603 \$004.00 - 7

CITY OF LAS VEGAS

DEPT. OF
BUILDING & SAFETY

Must be machine validated

- 6 JUN 68

L. Collins 11-8-81

Department of Building & Safety
City of Las Vegas, Nevada

Special Kardex
Elec. only, Plbg. only, A.C. only

Owner Francisco Park Rentals Address 1204 Exley Date: 6/5/68
Contractor _____ Permit No. _____
Lot _____ Block _____ Subdivision _____

Electric Only	Plumbing Only	Heat & Vent. A. C. Only
Contractor _____	Contractor <u>Sterling Plumb</u>	Contractor _____
Permit No. _____	Permit No. <u>24009</u>	Permit No. _____
Slab _____	Rough Soil _____	A.C. Rough Duct _____
Rough Elect _____	Rough Water _____	Ref. Rø. Piping _____
Final Rough _____	Top Out _____	Rough Gas _____
Final Fixture _____	Rough Gas _____	Final Refrig _____
Final Elec _____	Final Plbg. <u>for 6-68</u>	Final Air Cond _____
Temp. Service _____	Final Gas _____	Final Gas _____
	Final Sewer _____	
	Final Septic Tank _____	

23.06 D Address 1204 Exley

Log No. _____

Area _____

Done: Hovak

11-29-83

CITY OF LAS VEGAS, NEVADA

050-481-092

9.68.02

LOG NO. & AREA

DATE

CONST. VAL. \$

DEPARTMENT OF BUILDING AND SAFETY

PHONE 386-6251

BUILDING PERMIT

FOR Remodel, Additions, Misc. Residential Const.

ADDRESS OF
CONSTRUCTION

1204-06 EXLEY AVE

OWNER

Jasamillo

CONTRACTOR

Owner

STATE
LICENSE NO.CITY
LICENSE NO.

LOT(s)

2

BLOCK

4

SUBDIVISION

FRANCISCO PARK #1

ZONE

R2

PROPOSED CONSTRUCTION:

BUILDING
PERMIT NO.

4404

ELECTRIC
PERMIT NO.

4404-1

PLUMBING
PERMIT NO.

4404-2

USE

AIR COND.
PERMIT NO.

ADD'L. PERMITS REQ'D:

Air Cond. ☐Elec. ☒Plumbing ☒Signs ☐Paving ☐Fence ☐Incinerators ☐Fire Sprinkling System ☐Off-Site Permit ☐

MATERIALS OF CONSTRUCTION:

Wood Frame ☐Concrete Block ☐Reinforced Concrete ☐Steel Frame ☐

SQUARE FEET OF FLOOR AREAS:

1st

2nd

3rd

Other

TOTAL SQ. FT.

480

ARCHITECT

ENGINEER

NO. OF UNITS

NO. OF STORIES

OTHER INSPECTIONS AND FEES

1. Inspections outside of normal business hours = \$25.00 per hour (minimum charge three hours).
2. Re-inspection fee during normal business hours assessed under provisions of TABLE 3-A of the Uniform Building Code = \$15.00 per hour.
3. Inspections during normal business hours for which no fee is specifically indicated = \$15.00 per hour (minimum charge one half hour).
4. Additional plan review required by changes, additions or revisions to approved plans, = \$25.00 per hour (minimum charge two hours).

CONDITIONS OF THE PERMIT:

1. I agree to call the City Building Department for inspections before concrete is poured, before rough wiring, electrical, plumbing, framing is covered. Also for air conditioning, drywall and sheetrock inspection.
2. I agree that when the job is completed that I will call for final inspection before occupancy.
3. I agree to perform all construction in accordance with City Ordinances and Building Codes.
4. The Contractor's signature below denotes authority from the owner to sign in his behalf and that the owner is aware of all requirements of this application and permit. Separate permits must be taken out for work outlined above this agreement.
5. I have read and understand the contents of this application and permit, I hereby state that the information I have supplied on this application is true and correct.

Approval for the work under this permit will be given only after release and debris have been removed from job site and public right of way.

BY

AGENT/OWNER

PLANNING DEPT.

BUILDING DEPT.

PLUMBING	FEE	ELECTRICAL	FEE
WATER DISTRIBUTION	6.00	RECEPTACLE 10 SWITCH 9	7.00
SEWER SYSTEM - NEW OR MODIFICATION		EACH LIGHT FIXTURE OR SOCKET 5	1.50
FIXTURES - WATER SOFTENER, H.W. HEATER 8	16.00	SPECIAL OUTLET, APPLIANCE ETC. 3	2.10
GARBAGE DISPOSAL - WASHER, (DISH OR CLOTHES)		ELECTRICAL SERVICE OR PANEL 1	3.20
FUEL PIPING	6.00	A.C. UNIT OR MOTORS	
GAS APPLIANCE OR A.C. UNIT. 2	4.00	TOTAL	14.20
IRRIGATION SYSTEM		MISC.	
TOTAL	45.00		
AIR CONDITIONING	FEE		
NEW UNIT			
HEATERS - WALL, CEILING OR FLOOR			
EVAPORATIVE COOLER			
TOTAL			

PLAN REVIEW FEE

BLDG.


PERMIT

FEE

17.50

TOTAL

FEES

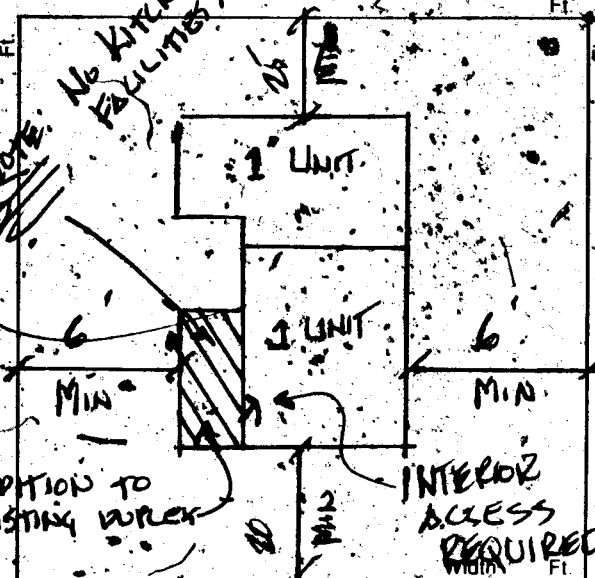

Front property line

RECEIPT

11/21/83 \$ 00.00
 17.50
 PLMB 42.50
 ELEC 14.20
 STL 73.70
 TOTL 73.70
 CHECK 73.70

A#4404 SR#001/01
 CITY - LAS VEGAS
 BLDG. & SAFETY
 11/21/83

MUST BE MACHINE VALIDATED

Permit Expires 180 Days After Abandonment of Work

CITY OF LAS VEGAS, NEVADA

050-481-002

CONST. VAL. \$ 6,240.00

LOG NO. & AREA

DATE

DEPARTMENT OF BUILDING AND SAFETY
PHONE 386-6251

BUILDING PERMIT

FOR: Remodel, Additions, Misc. Residential Const.

ADDRESS OF CONSTRUCTION

1204

EXLEX

OWNER

WRAILLO, Emigdio

CONTRACTOR

QIVNER

STATE LICENSE NO.

CITY LICENSE NO.

LOT(S)

2

BLOCK

4

SUBDIVISION

FRANCISCO PARK

ZONE

22

PROPOSED CONSTRUCTION:

BUILDING PERMIT NO.

1076

ELECTRIC PERMIT NO.

PLUMBING PERMIT NO.

AIR COND. PERMIT NO.

ADD'L. PERMITS REQ'D.:

Air Cond. ☐

Elec. ☒

Plumbing ☒

Signs ☐

Paving ☐

Fence ☐

Incinerators ☐

Fire Sprinkling System ☐

Off-Site Permit ☐

MATERIALS OF CONSTRUCTION:

Wood Frame ☒

Concrete Block ☐

Reinforced Concrete ☐

Steel Frame ☐

SQUARE FEET OF FLOOR AREAS:

1st

2nd

3rd

Other

TOTAL SQ. FT.

480

ARCHITECT:

ENGINEER:

NO. of UNITS

NO. of STORIES

OTHER INSPECTIONS AND FEES

1. Inspections outside of normal business hours = \$25.00 per hour (minimum charge three hours)
2. Re-inspection fee during normal business hours assessed under provisions of TABLE 3-A of the Uniform Building Code = \$15.00 per hour
3. Inspections during normal business hours for which no fee is specifically indicated = \$15.00 per hour (minimum charge one half hour)
4. Additional plan review required by changes, additions or revisions to approved plans = \$25.00 per hour (minimum charge two hours)

CONDITIONS OF THE PERMIT:

1. I agree to call the City Building Department for inspections before concrete is poured, before rough wiring, electrical, plumbing, framing is covered. Also for air conditioning, drywall and sheathing inspection.
2. I agree that when the job is completed that I will call for final inspection before occupancy.
3. I agree to perform all construction in accordance with City Ordinances and Building Codes.
4. The Contractor's signature below denotes authority from the owner to sign in his behalf and that the owner is aware of all requirements of this application and permit. Separate permits must be taken out for work outlined above this agreement.
5. I have read and understand the contents of this application and permit; I hereby state that the information I have supplied on this application is true and correct.

Approval for the work under this permit will be given only after refuse and debris have been removed from job site and public right of way.

BY:

[Signature]

OWNER

BY:

[Signature]

AGENT

PLANNING DEPT.

BUILDING DEPT.


PLUMBING	FEE	ELECTRICAL	FEE
WATER DISTRIBUTION		RECEPTACLE _____ SWITCH	
SEWER SYSTEM - NEW OR MODIFICATION		EACH LIGHT FIXTURE OR SOCKET	
FIXTURES - WATER SOFTENER, H.W. HEATER		SPECIAL OUTLET, APPLIANCE ETC.	
GARBAGE DISPOSAL - WASHER, (DISH OR CLOTHES)		ELECTRICAL SERVICE OR PANEL	
FUEL PIPING		A.C. UNIT OR MOTORS	
GAS APPLIANCE OR A.C. UNIT		2310 - 2402 TOTAL	
IRRIGATION SYSTEM		MISC	
2310 - 2403 TOTAL			
AIR CONDITIONING	FEE		
NEW UNIT			
HEATERS - WALL, CEILING OR FLOOR			
EVAPORATIVE COOLER			
2340 - 2405 TOTAL			

PLAN REVIEW FEE

BLDG. PERMIT FEE

TOTAL FEES

52.50

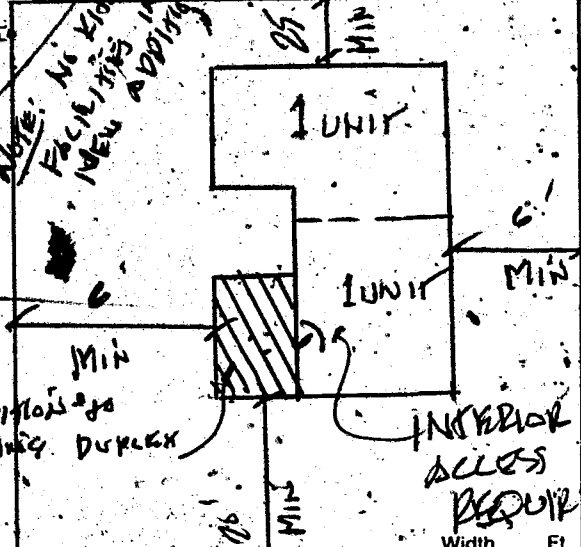

VAL Front property 0.00

11 SFD

RECEIPT

52.50

52.50

PERMIT EXPIRES 180 DAYS AFTER ABANDONMENT OF WORK

MUST BE MACHINE VALIDATED

Marianna Francis 6-5-84

OWNER	Enigdio Jaramillo	ADDRESS	1204 Exley
DATE	5-25-84	GEN. CONT.	owner
TYPE OF STRUCTURE	addn. to duplex	PERMIT No.	1076
LEGAL DESCRIPTION	2, 4, Francisco pk	LOG No.	
APPROVED FOR OCCUPANCY & METER			
BUILDING		MECHANICAL	
Location & Footing		Plumbing Cont.	
Concrete Slab Floor		Permit No.	Date
Fireplace Footing		Htg./Vt./A.C. Cont.	
Chimney Steel		Permit No.	Date
Vert. Steel Reinf.		Sewer Cont.	
Horiz. Steel Reinf.		Permit No.	Date
Framing		Rough Soil	
Ext. Lath		Rough Water	
*Roof Sheathing		Top-Out	
Ext. Brown		Rough Gas	
Insulation		A/C Rough Duct	
Drywall		Final Plumbing	
Final Building	KD5-25-84	Final Gas	
Appr. for Occu.	ele. to 2506	Final Air Cond.	
ELECTRICAL		Final Sewer	
Temp. Pole cont.		REMARKS	
Permit No.	Date		
Inspection	Date		
Electrical Cont.			
Permit No.	Date		
Rough		PLEASE NOTE ADDITIONAL REMARKS ON REVERSE SIDE	
Final Electrical		DEPT. OF BLDG. & SAFETY CITY OF LAS VEGAS REV. 82-3-29	
Temporary Service			

OWNER	Jaramillo	ADDRESS	1204-06 Exley Ave.
DATE	11-21-83	GEN. CONT.	Owner
TYPE OF STRUCTURE	Duplex (slab only)	PERMIT NO.	4404
LEGAL DESCRIPTION	2, 4, Francisco Park	LOG NO.	
APPROVED FOR OCCUPANCY & METER			
BUILDING		MECHANICAL	
Investigation		Plumbing Cont.	Owner
Location & Footing	KD1-28-83	Permit No.	4404-2
Concrete Slab Floor	KD1-30-83	Htg./Vt./A.C. Cont.	
Fireplace Footing		Permit No.	Date
Chimney Steel		Sewer Cont.	
Vert. Steel Reinf.		Permit No.	Date
Horiz. Steel Reinf.		Rough Soil	
Framing	KD2-29-84	Rough Water	
Ext. Lath		Top-Out	
Ext. Brown		Rough Gas	
Drywall	KD4-27-84	A/C Rough Duct	
Final Building	KD5-25-84	Final Plumbing	JH5-25-84
Appr. for Occu.		Final Gas	JH5-25-84
ELECTRICAL		Final Air Cond.	
Temp. Pole Cont.		Final Sewer	
Permit No.	Date	REMARKS	
Inspection	Date		
Electrical Cont.	Owner		
Permit No.	4404-1	Date	11-21-83
Rough	KD2-26-84	PLEASE NOTE ADDITIONAL REMARKS ON REVERSE SIDE	
Final Rough		DEPT. OF BLDG. & SAFETY CITY OF LAS VEGAS REV. 82-3-29	
Final Electrical	KPS-14-84		
Temporary Service			

Marianna Francis 6-5-84

Ref: 102-27-84
Circulation KD 4-16-84